




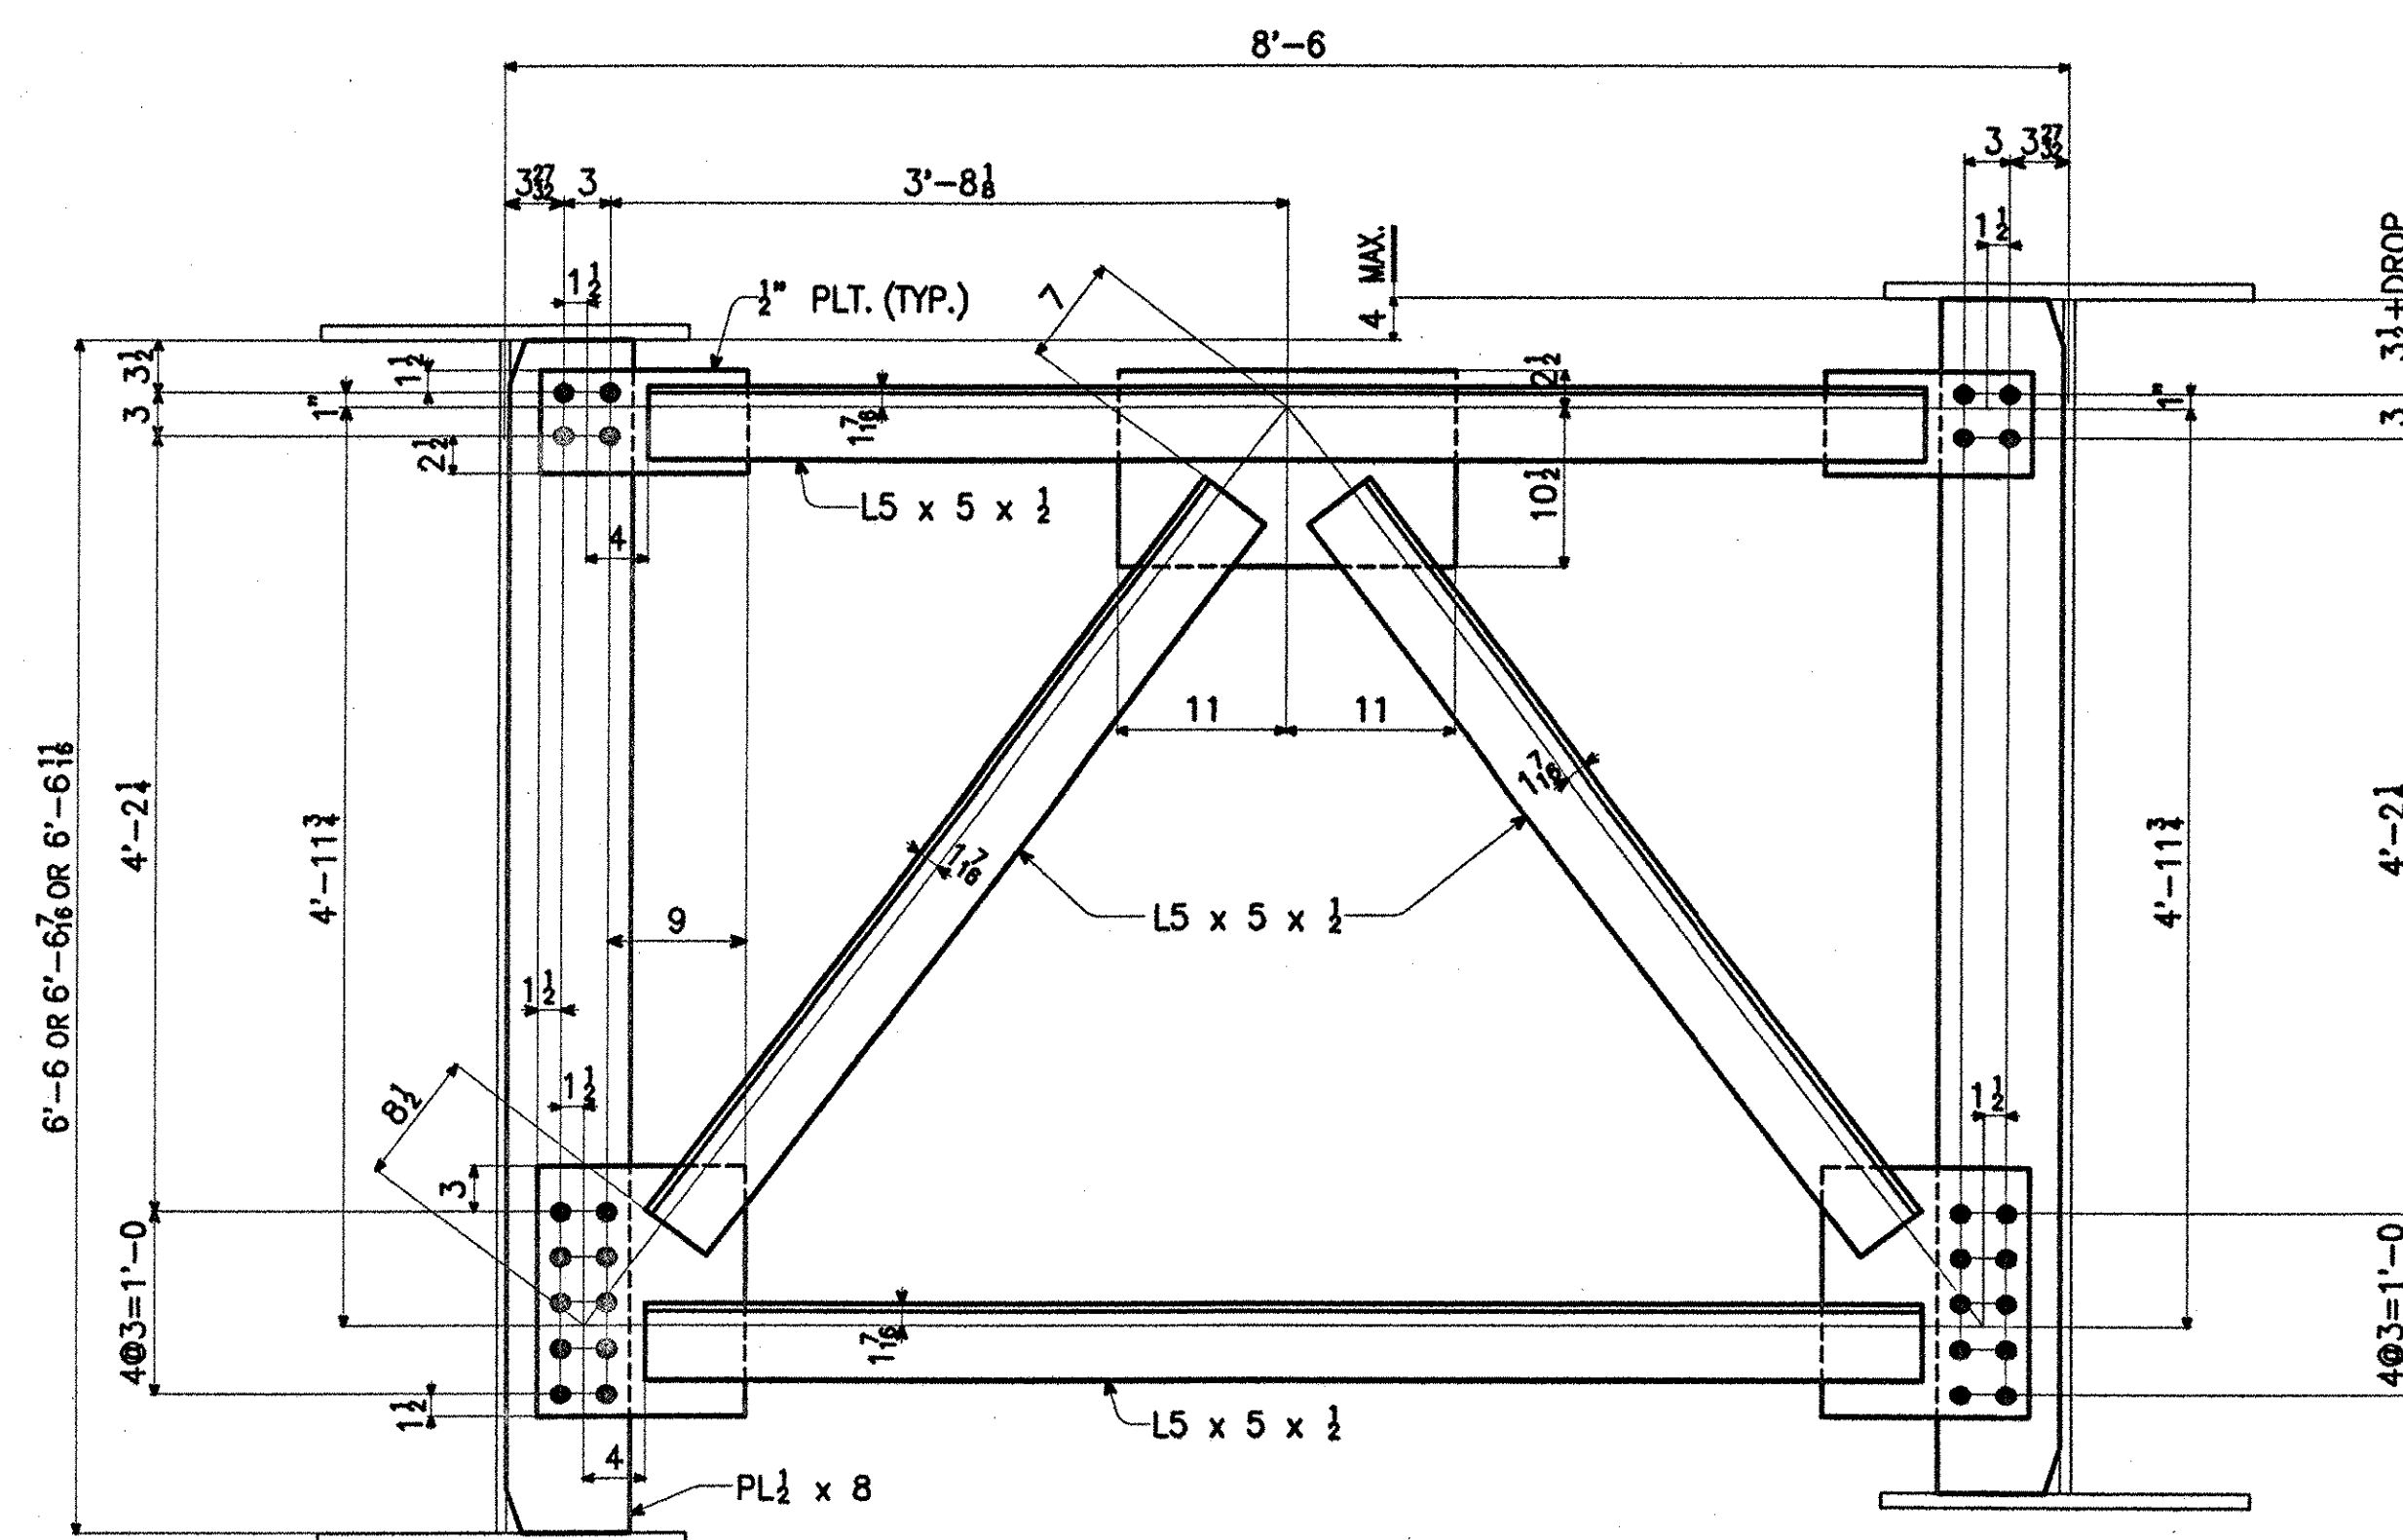


INT. CROSSFRAME LAYOUT

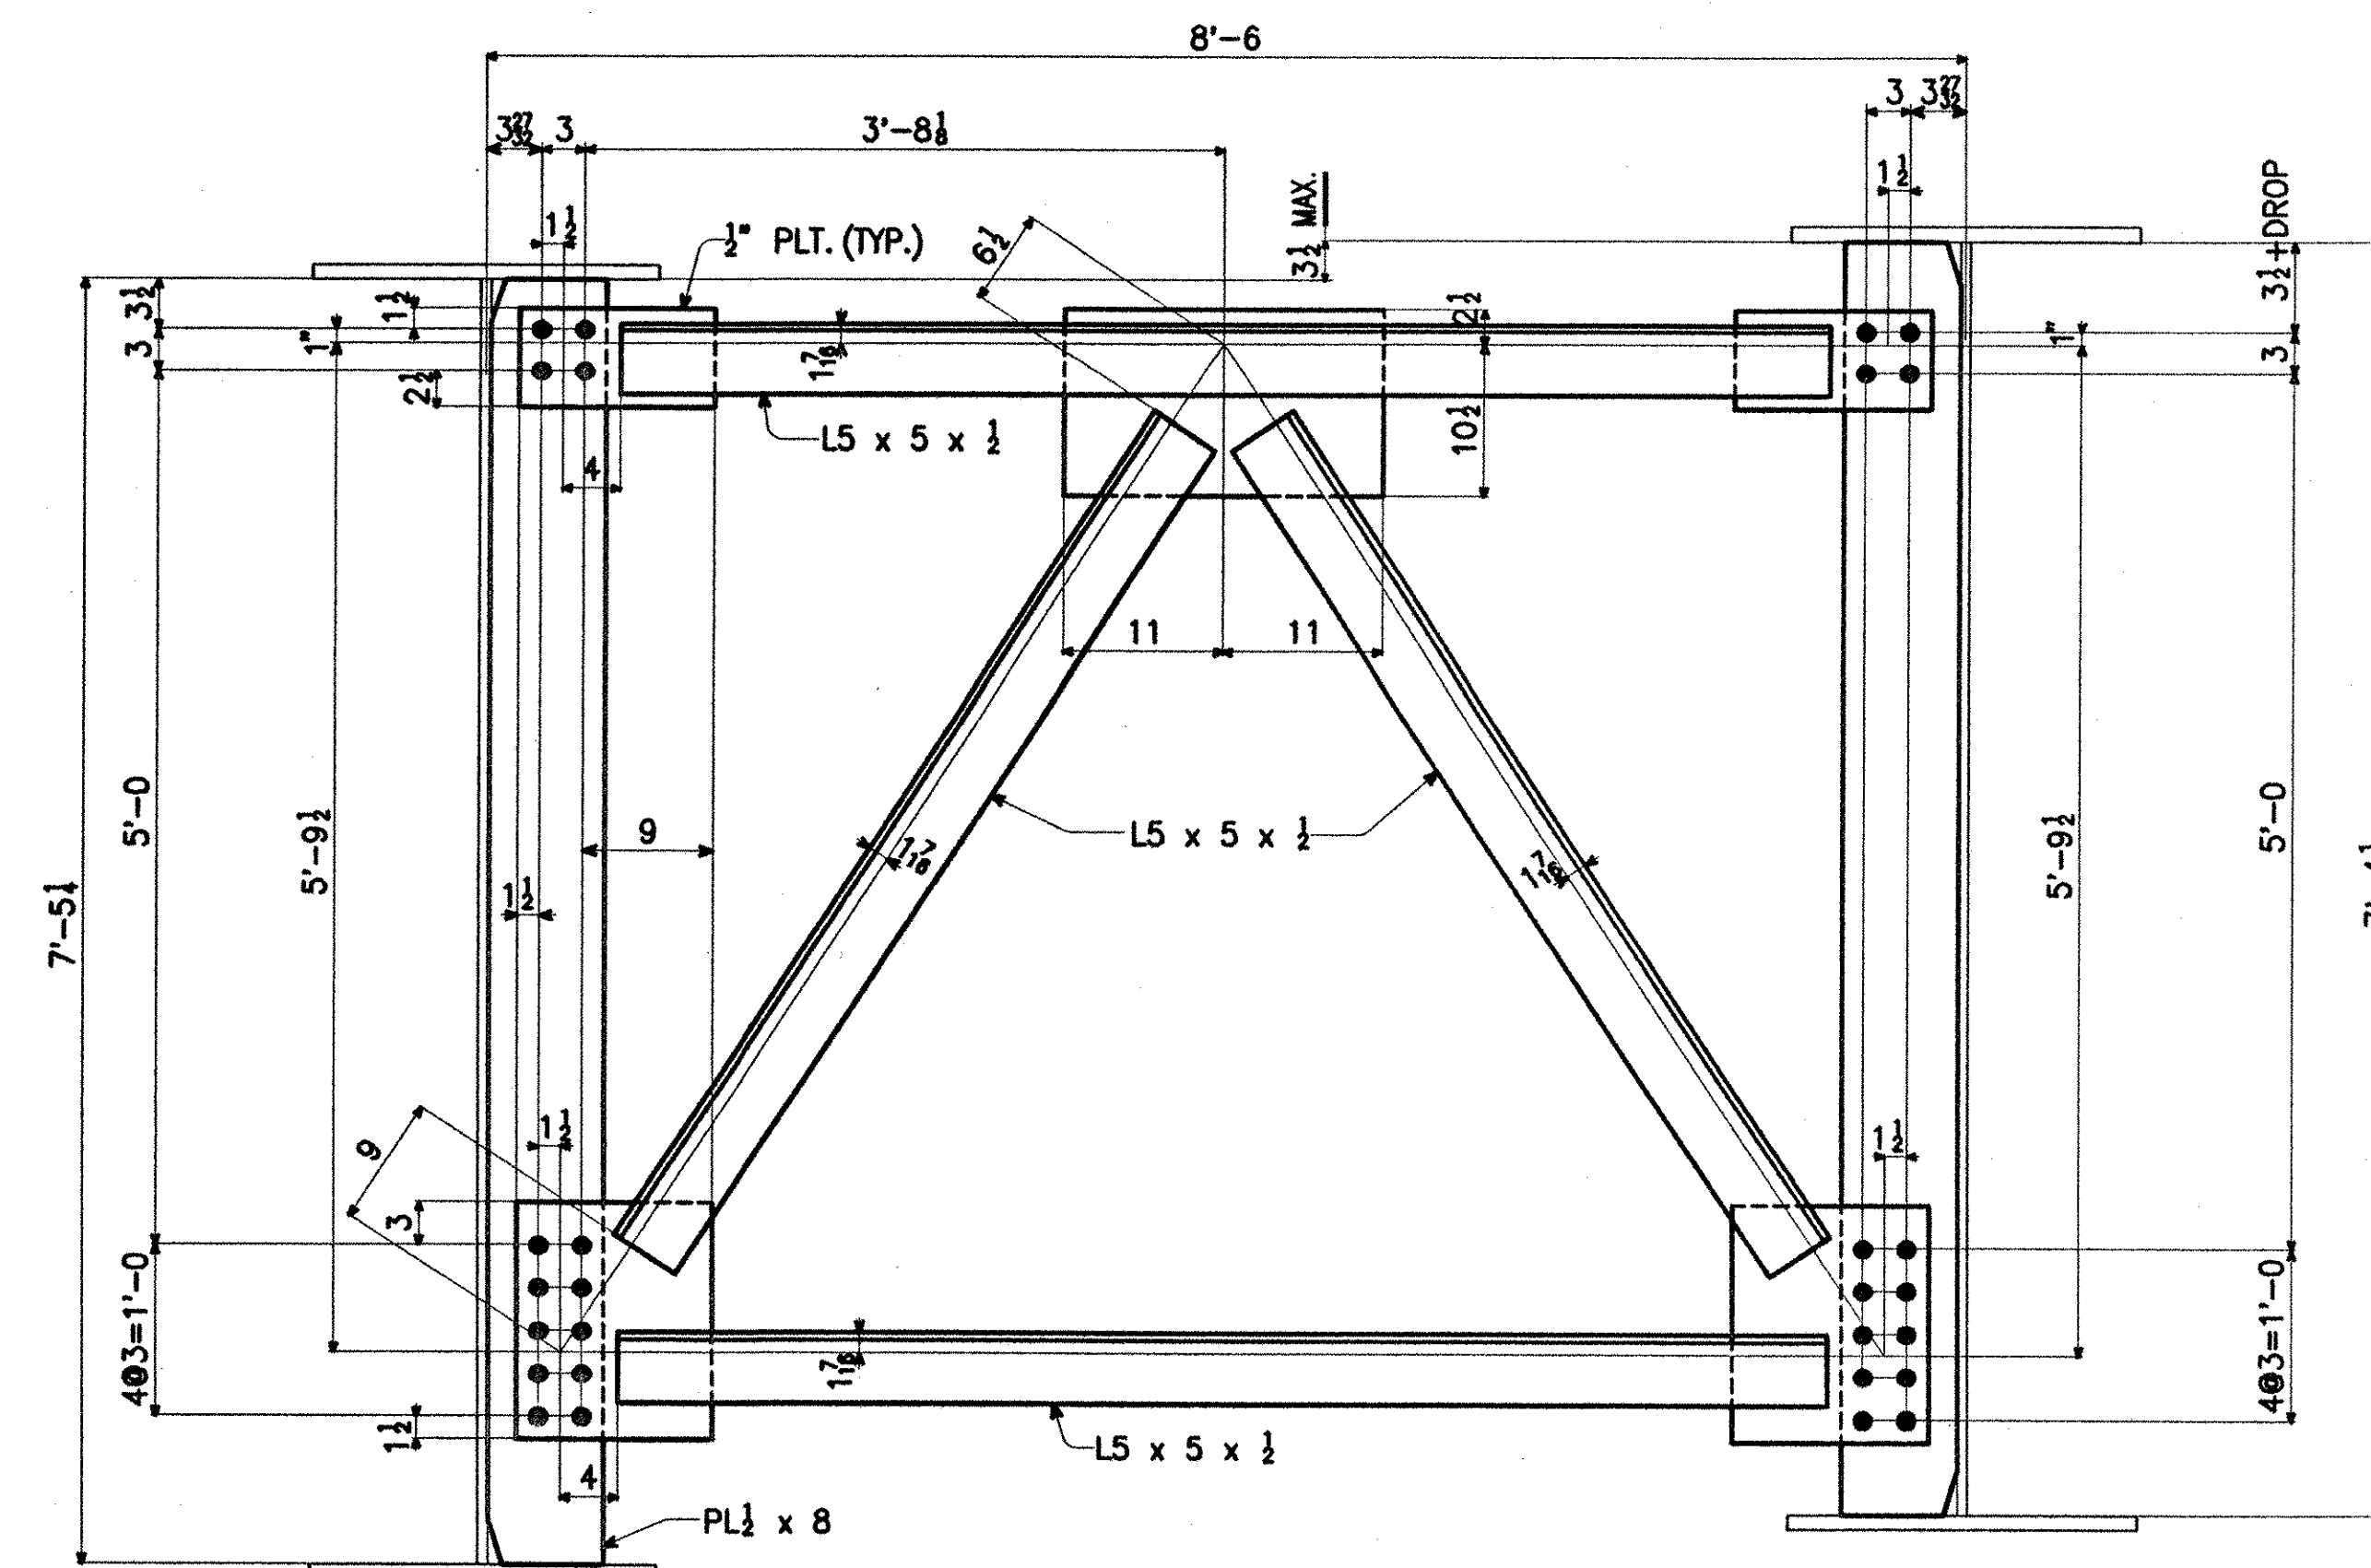

INT. CROSSFRAME LAYOUT

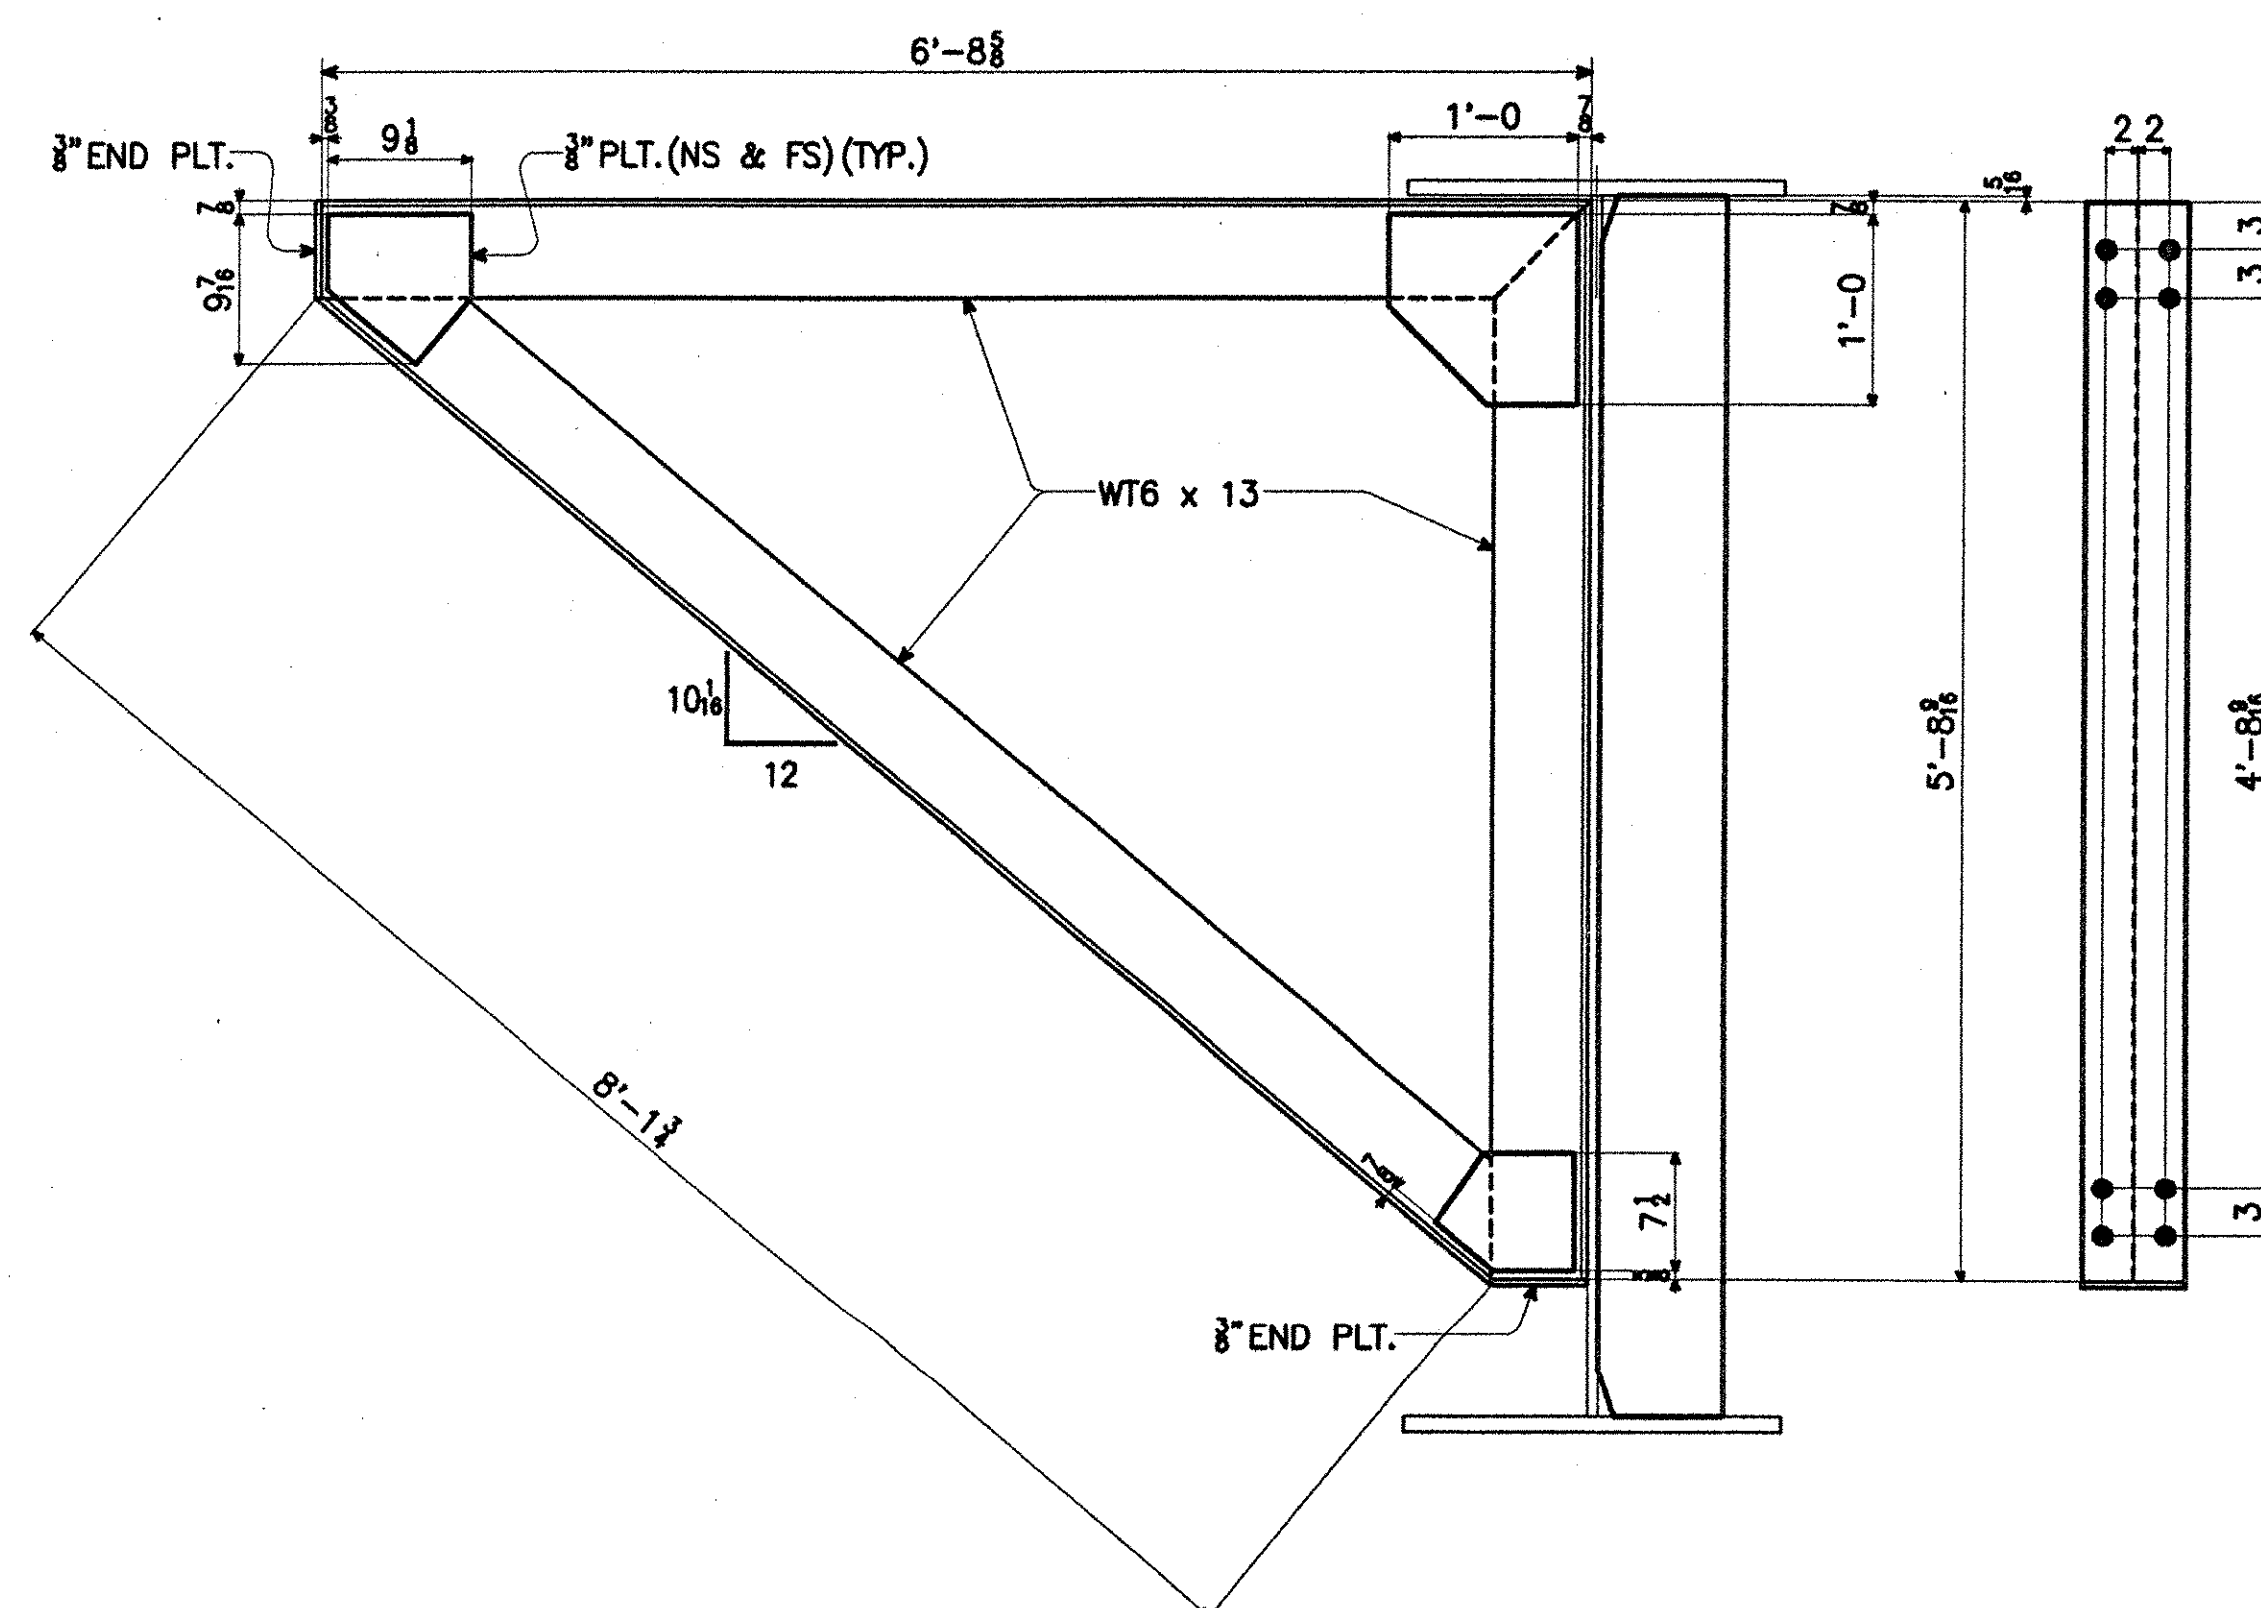

SIDEWALK BRACKET LAYOUT
(NEAREST BEARING POINTS)

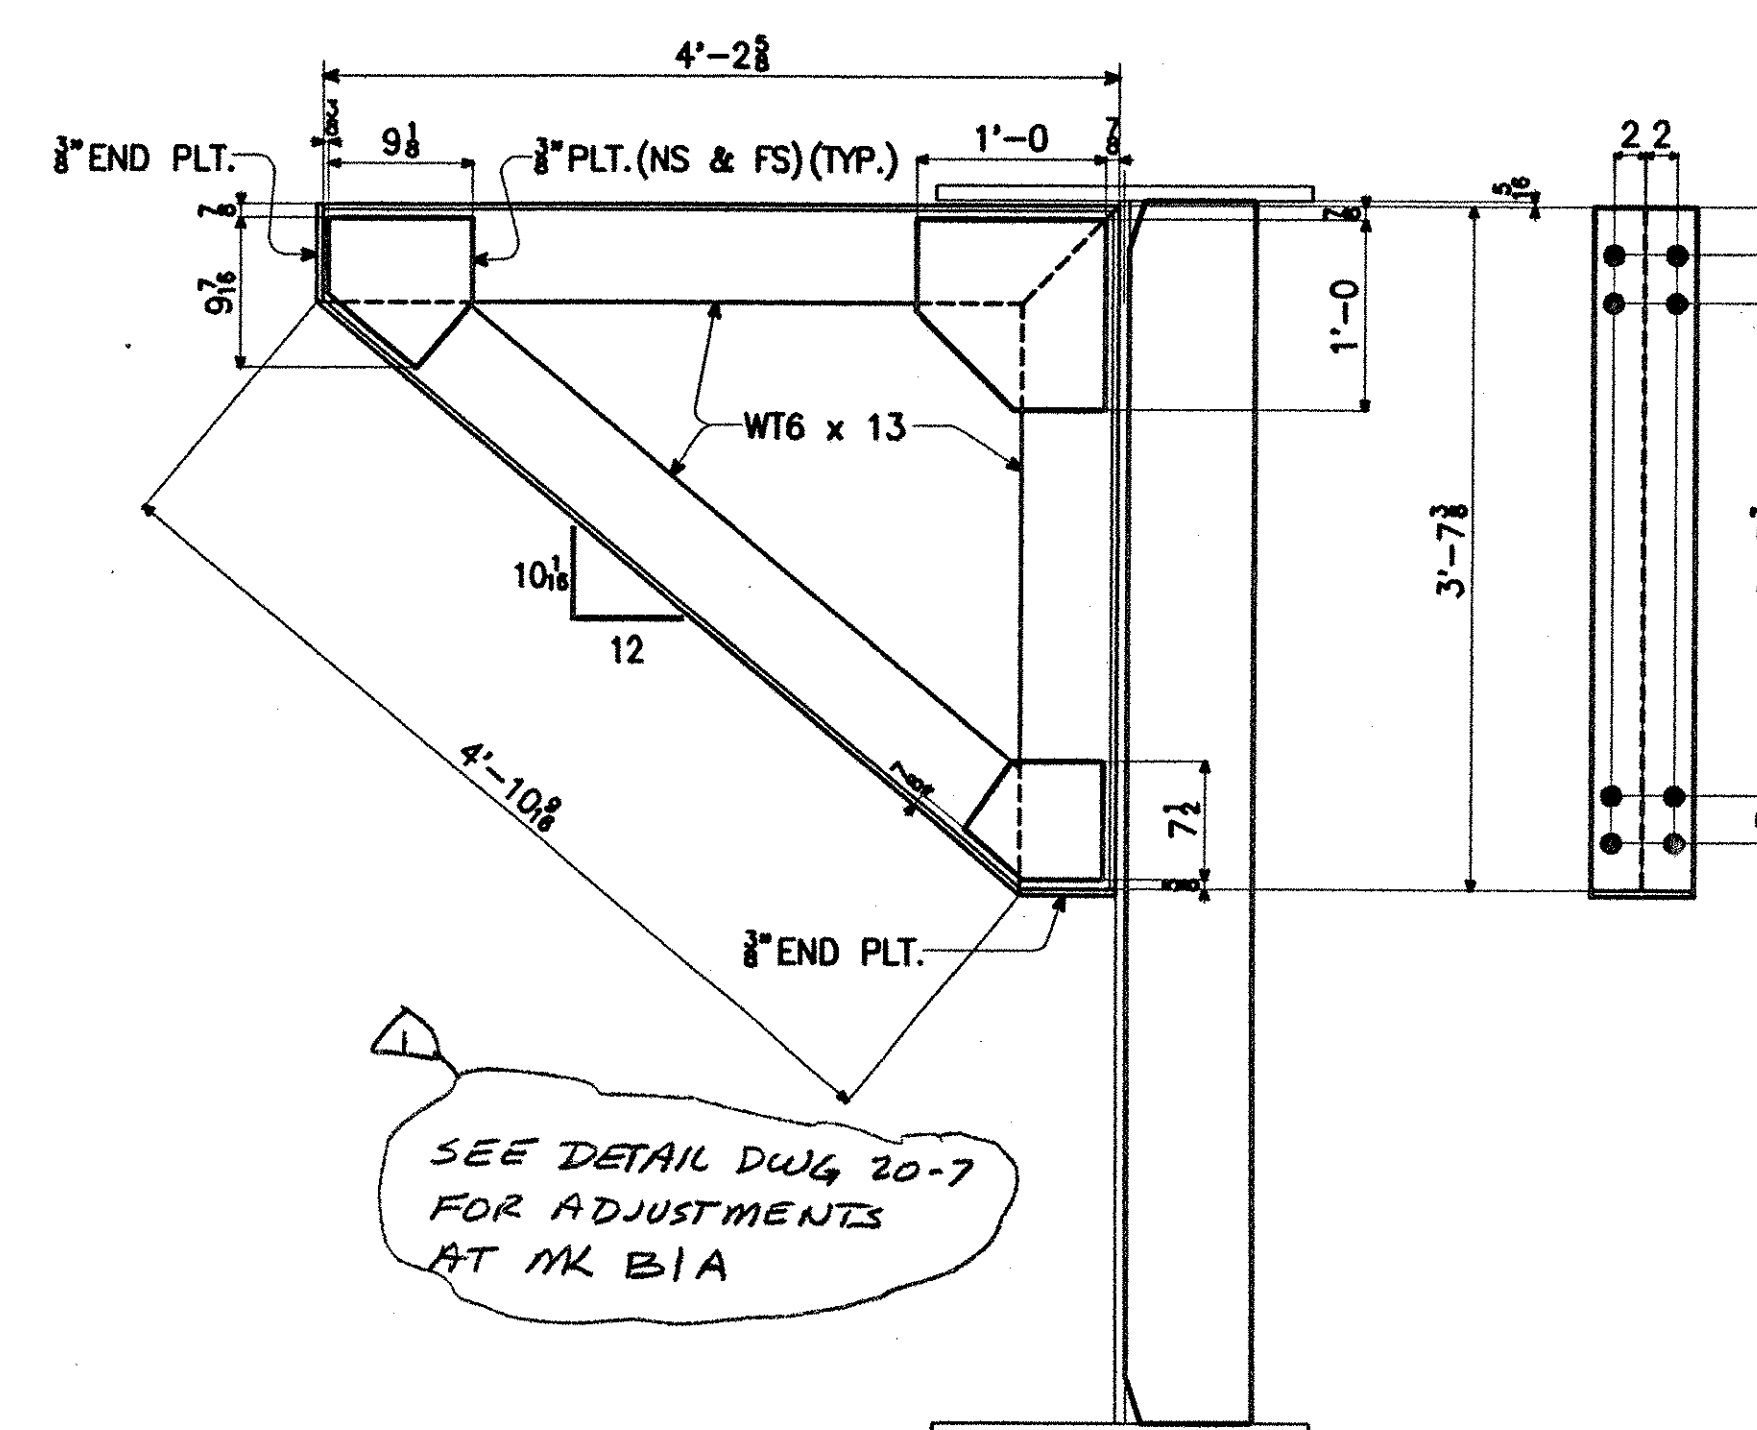

SIDEWALK BRACKET LAYOUT
(INTERMEDIATE POINTS)

RECEIVED
CHK'D BY *CPW* OK'D BY _____
JAN 30 2002
RESUBMIT _____ APPROVED *X*
BY *CPW* DATE 2/11/02

Δ MK BIA 1-28-02 JCM

ITEM NO. 506.55			BR. NO. 3		PROJ. NO. BRZ 1444(22)	
TITLE: LAYOUTS						
APPROVED: 9-5-01			REVISED  National Eastern Corporation Plainville, Connecticut			
PRINT DIST.						
5	4-7-01	APPR.				
ORIG.	9-5-01	FAB.				
5	7-13-01	APP				
5	8-24-01	APP	JOB: T.H. 1 OVER THE WHITE RIVER ROYALTON, VERMONT			
5	1-28-02	APP				
11	1-28-02	FAB				
			CUSTOMER: BECK & BELLUCCI, INC.			
			DESIGNER: VERMONT AGENCY OF TRANSPORTATION			
			WORK ORDER NO.		DRAWING NO.	REV.
CHECKED	TS	3/01	15873		WS4	1
DRAWN	AV	3/01				