




WORK ORDER NO.	DRAWING NO.	REV.
15873	12-1	△

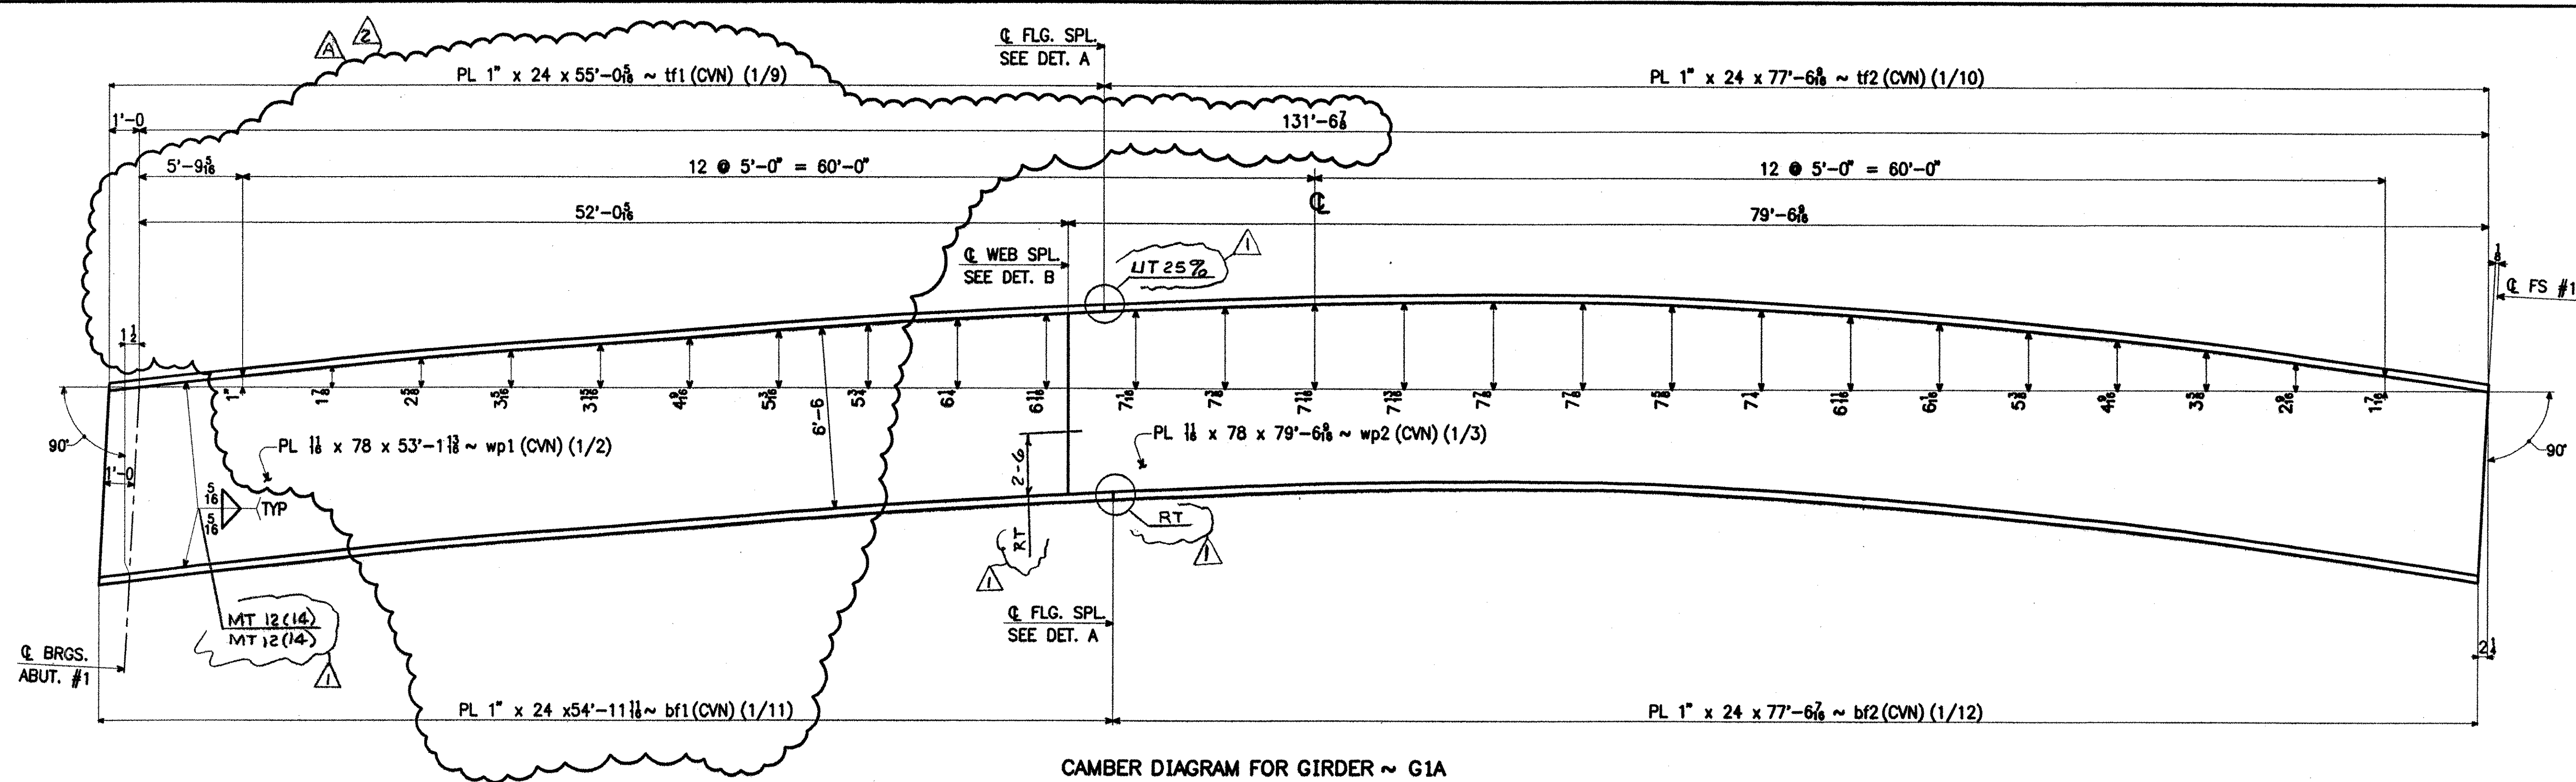


CAMBER DIAGRAM FOR GIRDER ~ G1A

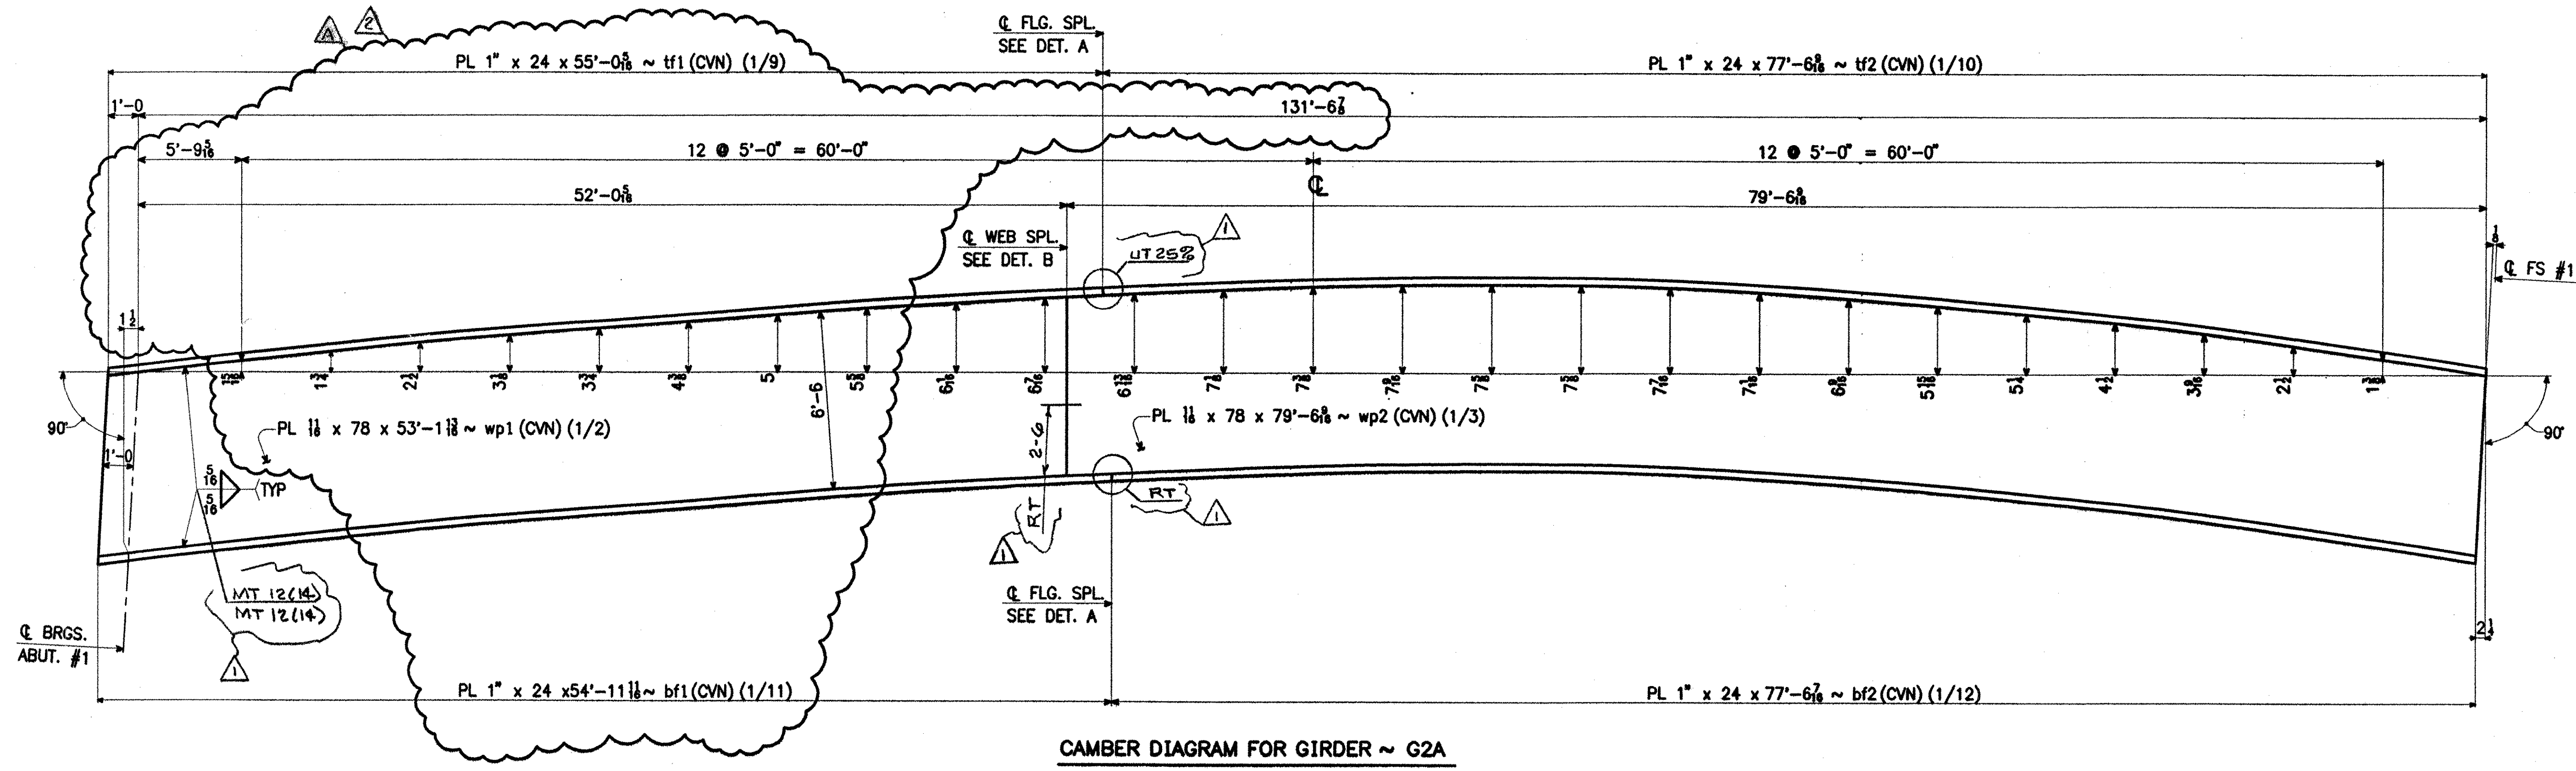

CAMBER DIAGRAM FOR GIRDER ~ G2A

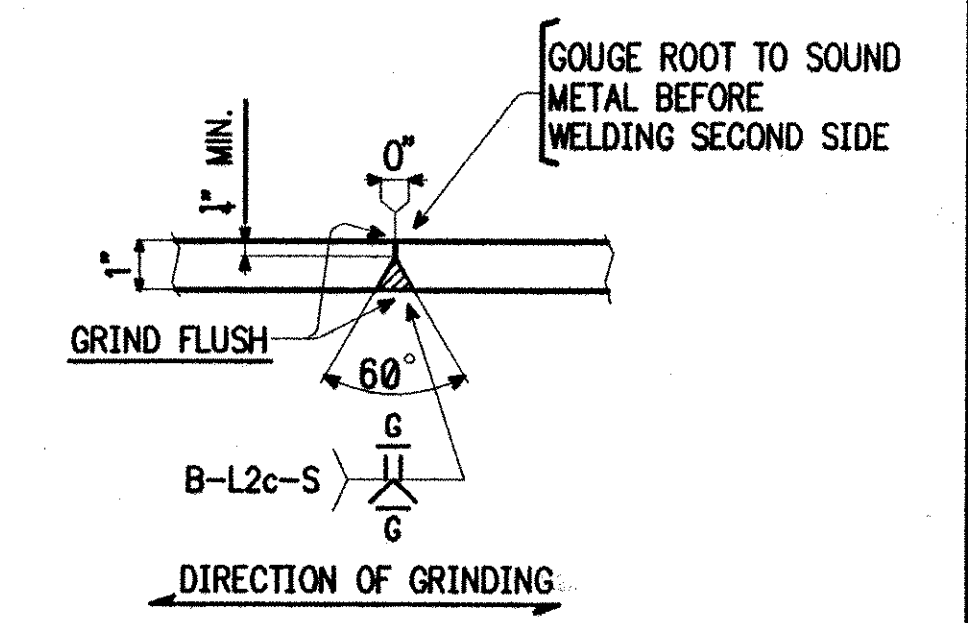

FLANGE SPLICE DETAIL A

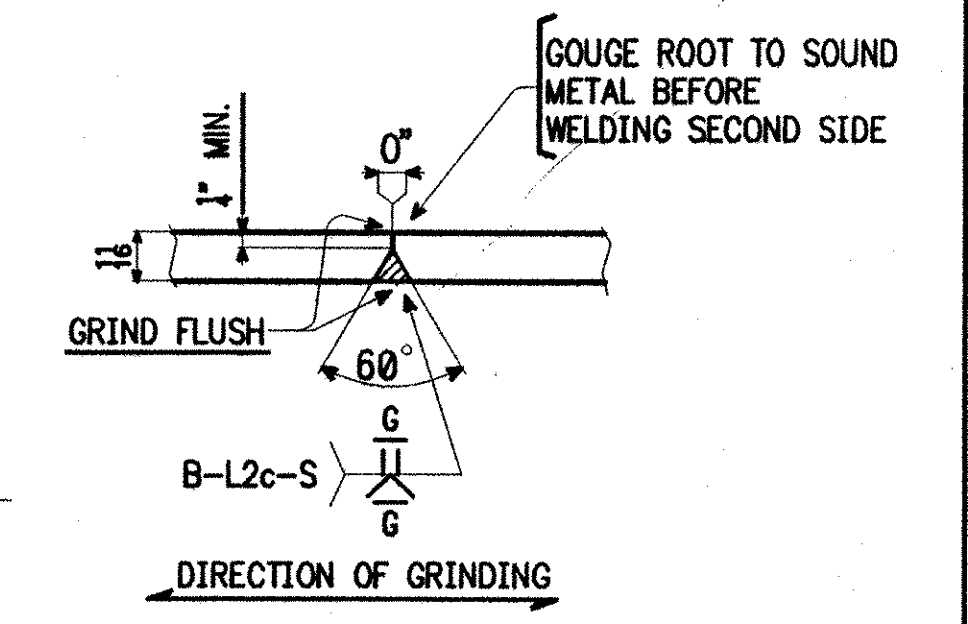

WEB SPLICE DETAIL B

- NOTES:
1. MATERIAL: ASTM A709-50W
 2. CVN DENOTES CHARPY V-NOTCH TESTING REQUIRED.

- △ FLG & WEB 12-17-01 AV
 △ NDT 8-23-01 JCM
 △ APPL COMMENTS 6-21-01 AV

ITEM NO. 506.55	BR. NO. 3	PROJ. NO. BRZ 1444(22)
TITLE: CAMBER DIAGRAMS		
APPROVED: 9-5-01		
PRINT DIST.		
5	4-7-01	APPR.
ORIG.	6-21-01	FAB.
5	7-13-01	APP
5	8-24-01	APP
12	8-24-01	FAB
5	12-13-01	APP
11	12-13-01	FAB
National Eastern Corporation Plainville, Connecticut JOB: T.H. 1 OVER THE WHITE RIVER ROYALTON, VERMONT		
CUSTOMER: BECK & BELLUCCI, INC. DESIGNER: VERMONT AGENCY OF TRANSPORTATION		
CHECKED	TS	3/01
DRAWN	AV	3/01
15873	12-1	△

FOR APPROVAL
 REVISED

RECEIVED
 CND BY WAS OK'D BY
 DEC 27 2001
 RESUBMIT APPROVED
 BY opw DATE 1/4/02