



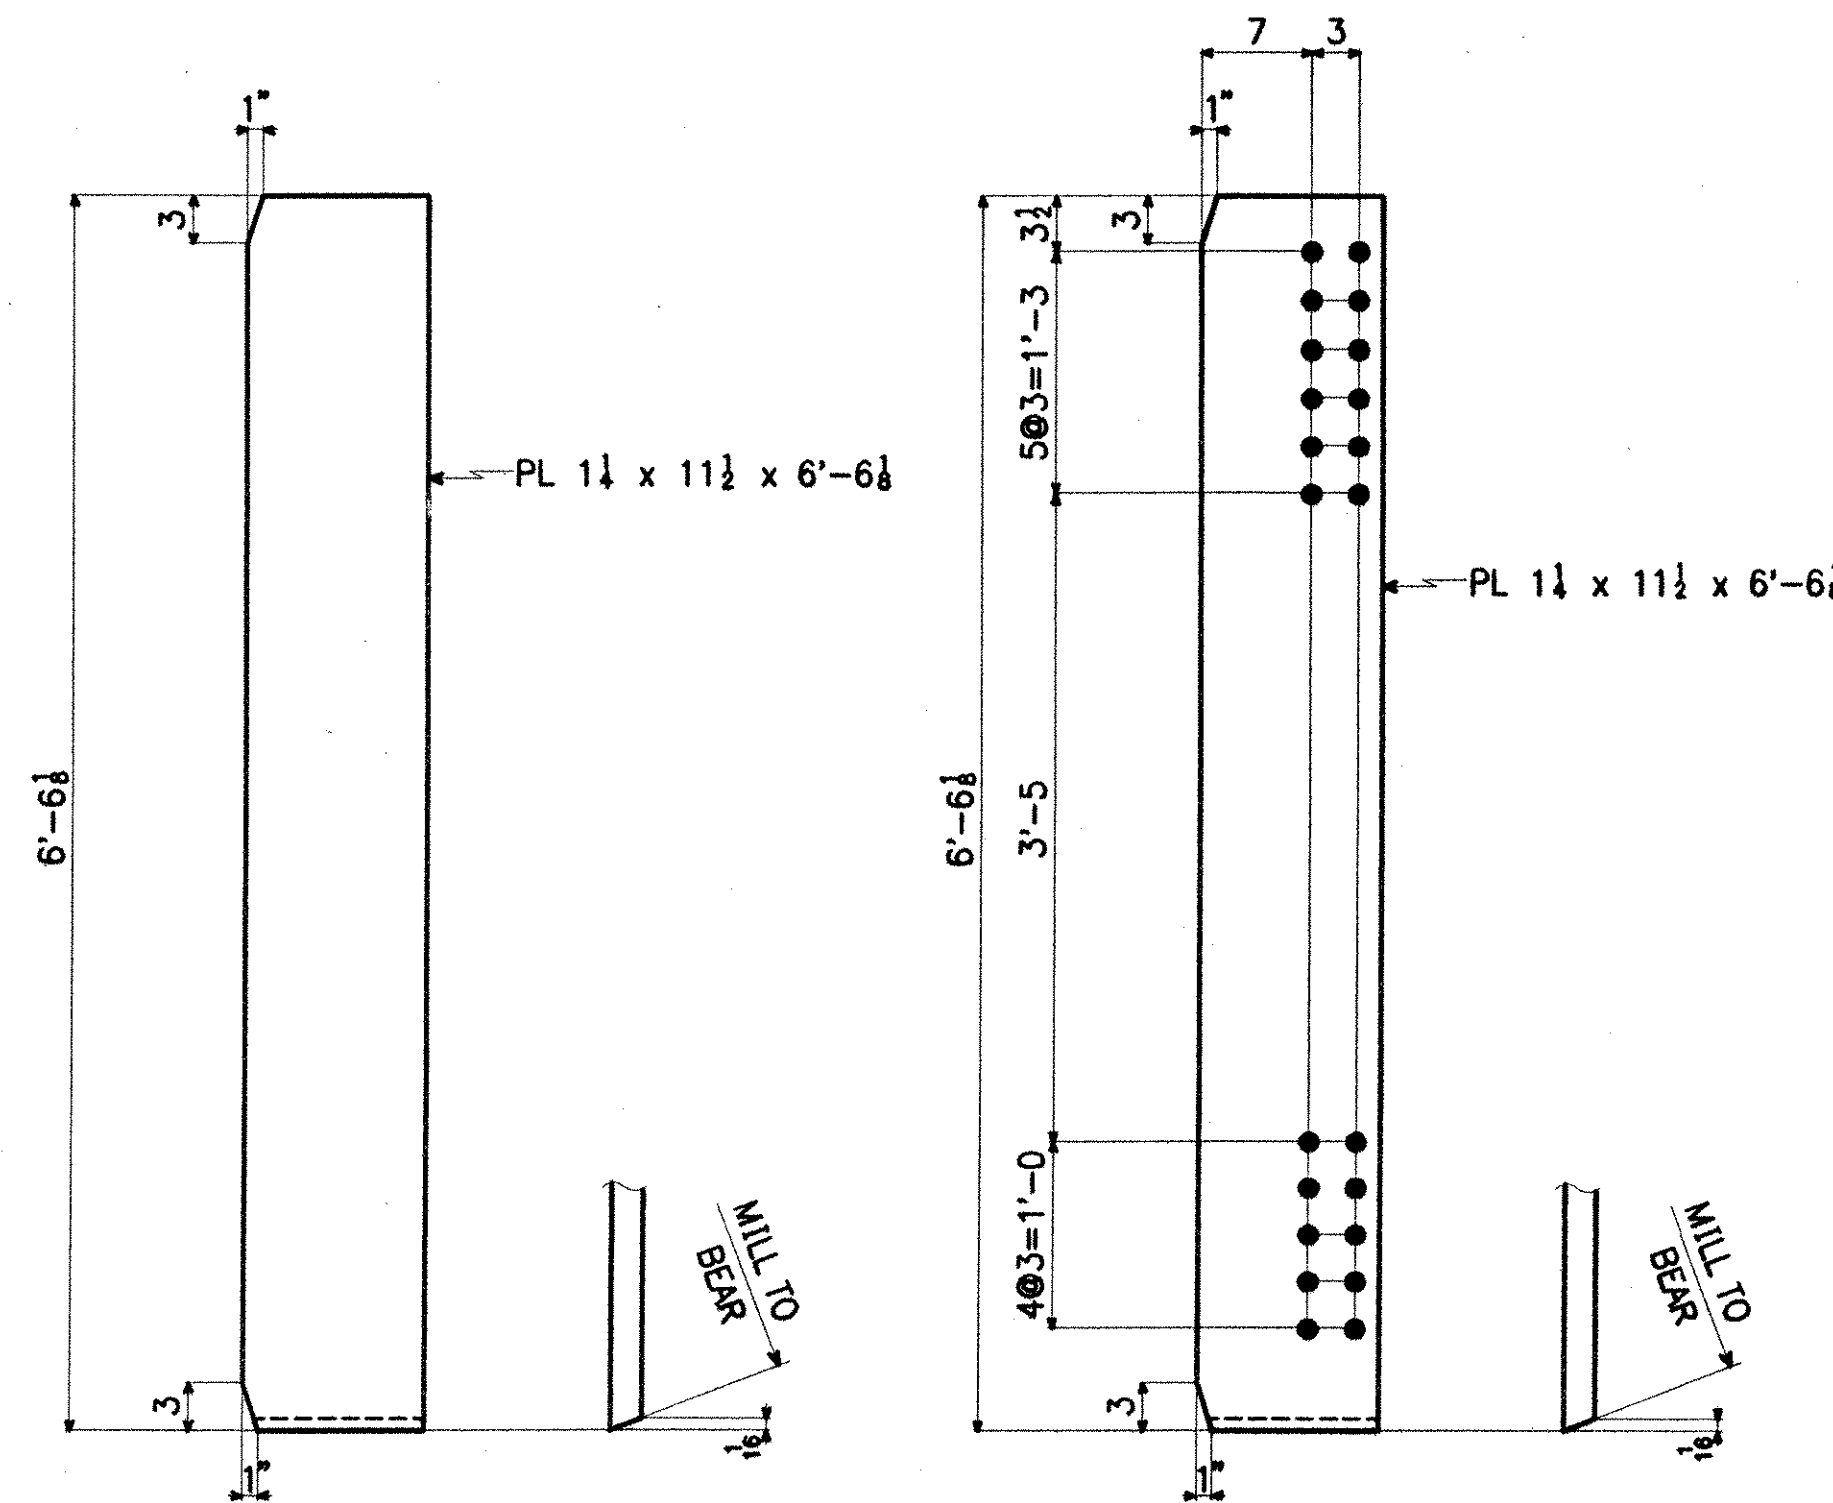


2 ~ BEARING STFS. ~ bs1^R 3/2 s_{1/11}

2 ~ BEARING STFS. ~ bs1^L

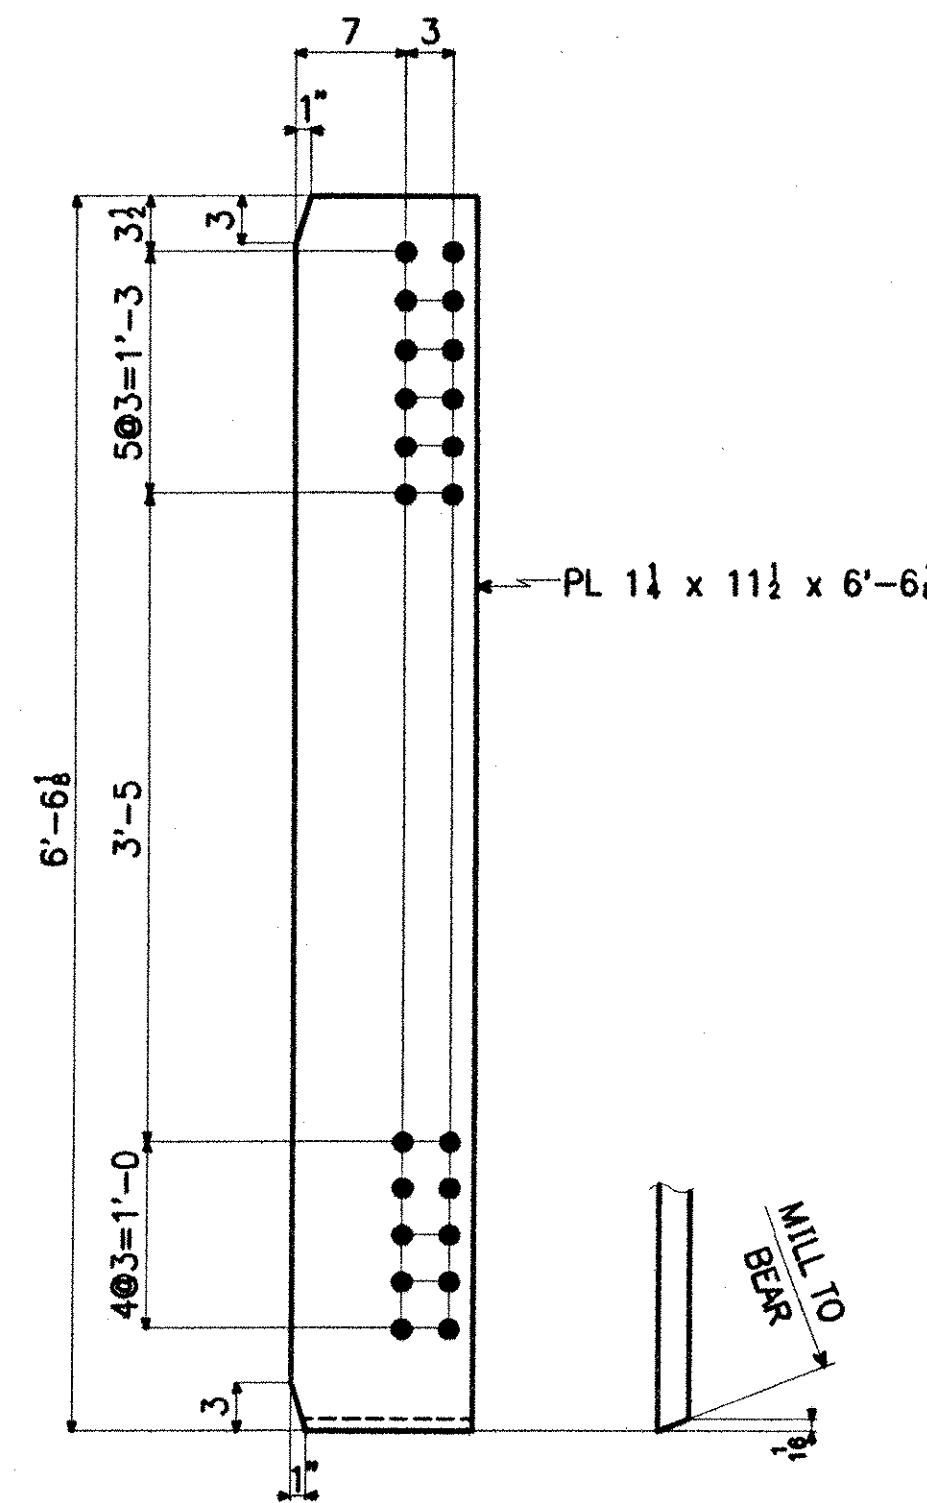


8 ~ BEARING STFS. ~ bs2^R 3/2 s_{1/11}


8 ~ BEARING STFS. ~ bs2^L

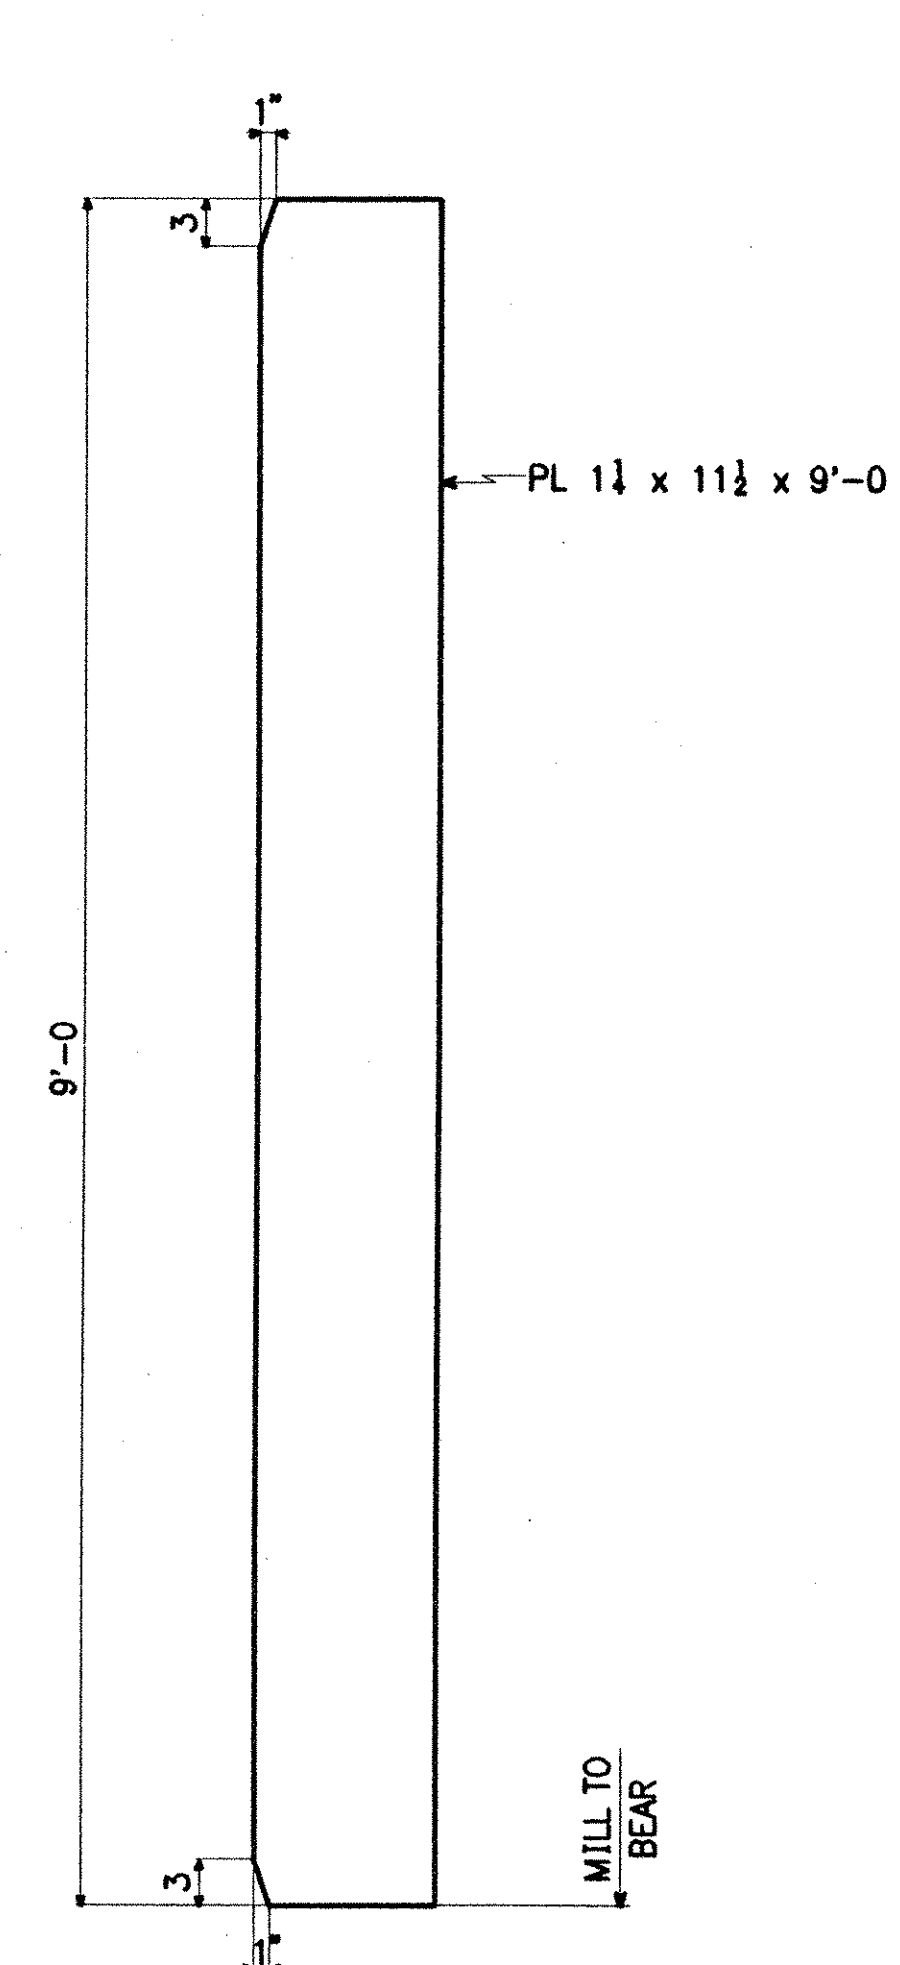

2 ~ BEARING STFS. ~ bs3 3/2 s_{1/11}

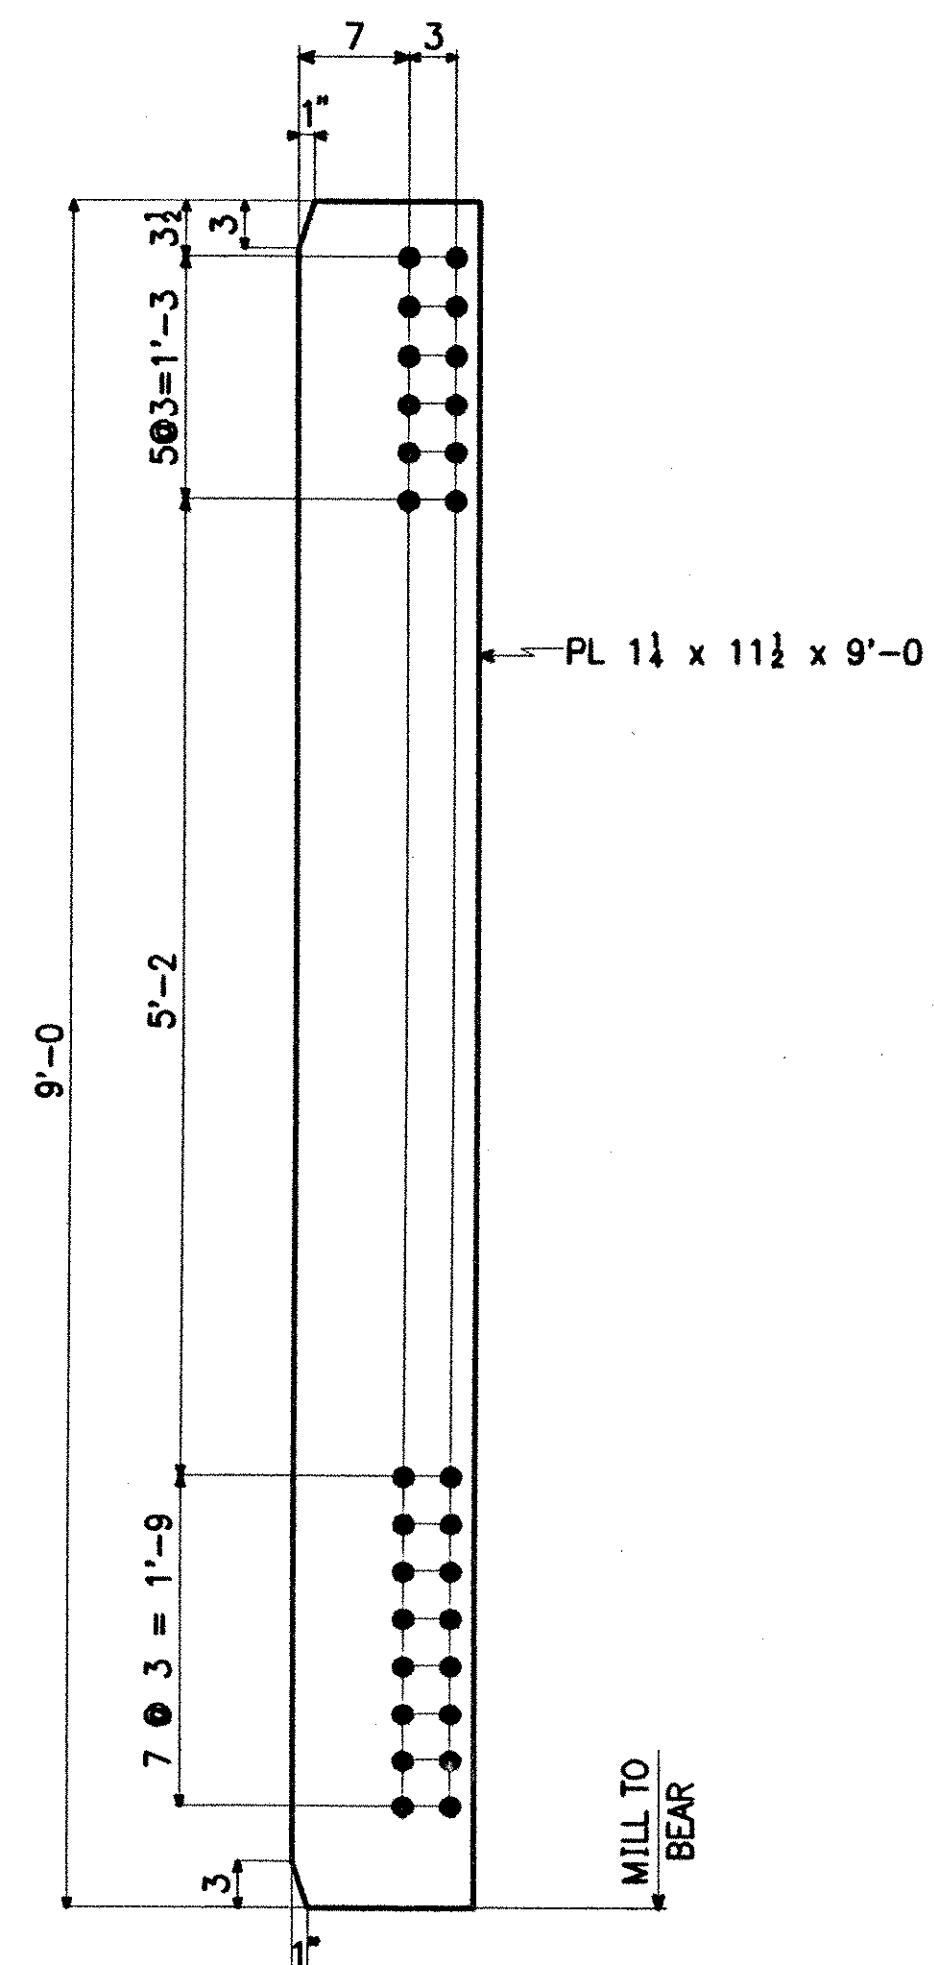


8 ~ BEARING STFS. ~ bs3 3/2 s_{1/11}

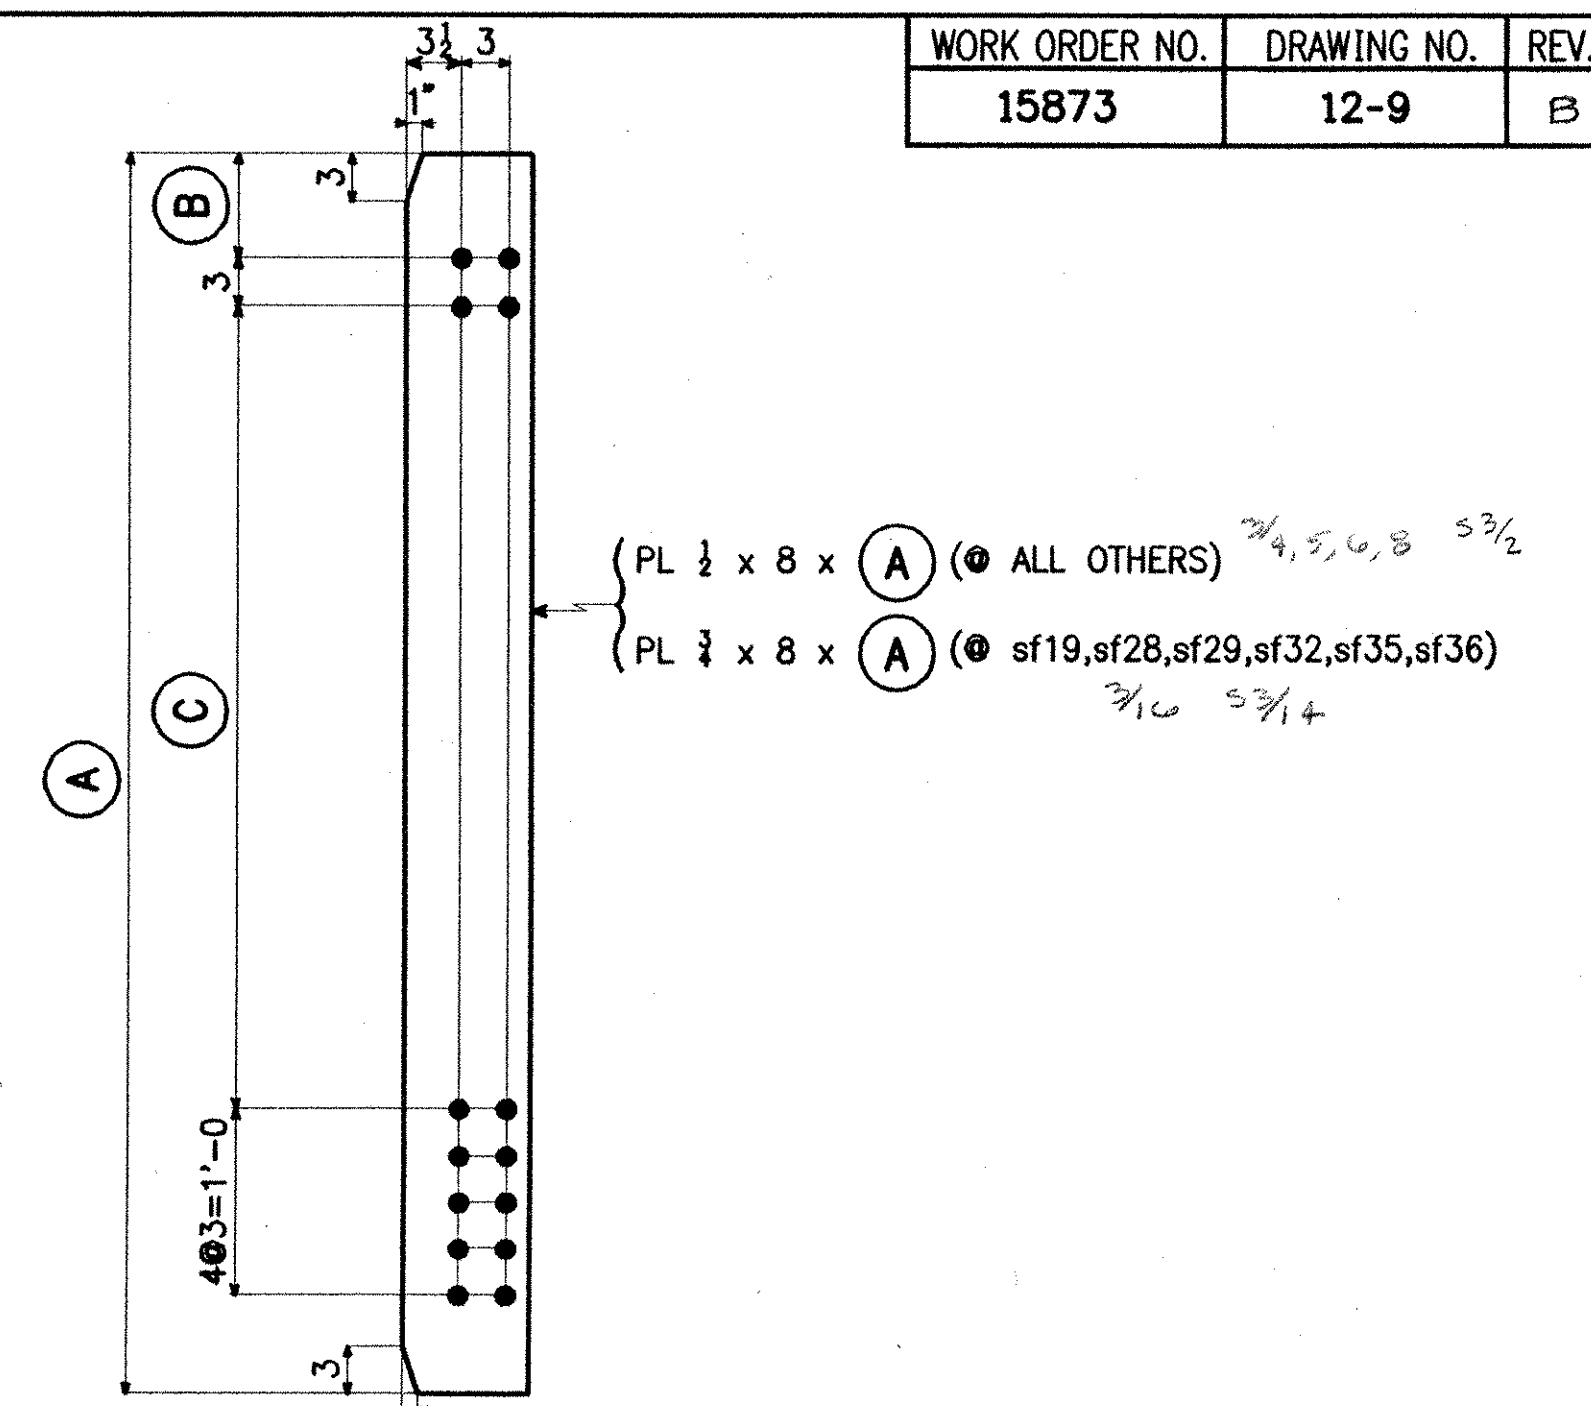

INT. CONN. PLTS.


MARK	No. REQ'D.	(A)	(B)	(C)
sf1	40	6'-6	3 1/2	4'-2 1/2
sf2	5	6'-6	4 1/2	4'-2 1/2
sf3	5	6'-6	4 1/2	4'-2 1/2
sf4	10	6'-6	5 1/2	4'-2 1/2
sf5	10	6'-6	6	4'-2 1/2
sf6	3	6'-6	7 1/2	4'-2 1/2
sf7	4	6'-6 1/2	3 1/2	4'-2 1/2
sf8	7	6'-6	7 1/2	4'-2 1/2
sf9	1	6'-6 1/2	4 1/2	4'-2 1/2
sf10	1	6'-6 1/2	5 1/2	4'-2 1/2
sf11	4	6'-6 1/2	3 1/2	4'-2 1/2
sf12	1	6'-6 1/2	6	4'-2 1/2
sf13	1	6'-6 1/2	7	5'-0
sf14	2	7'-4 1/2	3 1/2	5'-0
sf15	1	6'-6 1/2	5 1/2	5'-0

MARK	No. REQ'D.	(A)	(B)	(C)
sf16	1	6'-6 1/2	6	5'-0
sf17	1	6'-6 1/2	7	5'-0
sf18	2	7'-5 1/2	3 1/2	5'-0
sf19	1	7'-4 1/2	4 1/2	5'-0
sf20	1	7'-4 1/2	5 1/2	5'-0
sf27	1	7'-4 1/2	6	5'-0
sf28	1	7'-4 1/2	7	5'-0
sf29	1	7'-5 1/2	4 1/2	5'-0
sf30	1	7'-5 1/2	5 1/2	5'-0
sf31	1	7'-5 1/2	6	5'-0
sf32	1	7'-5 1/2	7	5'-0
sf33	1	6'-6 1/2	4 1/2	5'-0
sf35	2	7'-4 1/2	3 1/2	5'-0
sf36	2	7'-5 1/2	3 1/2	5'-0

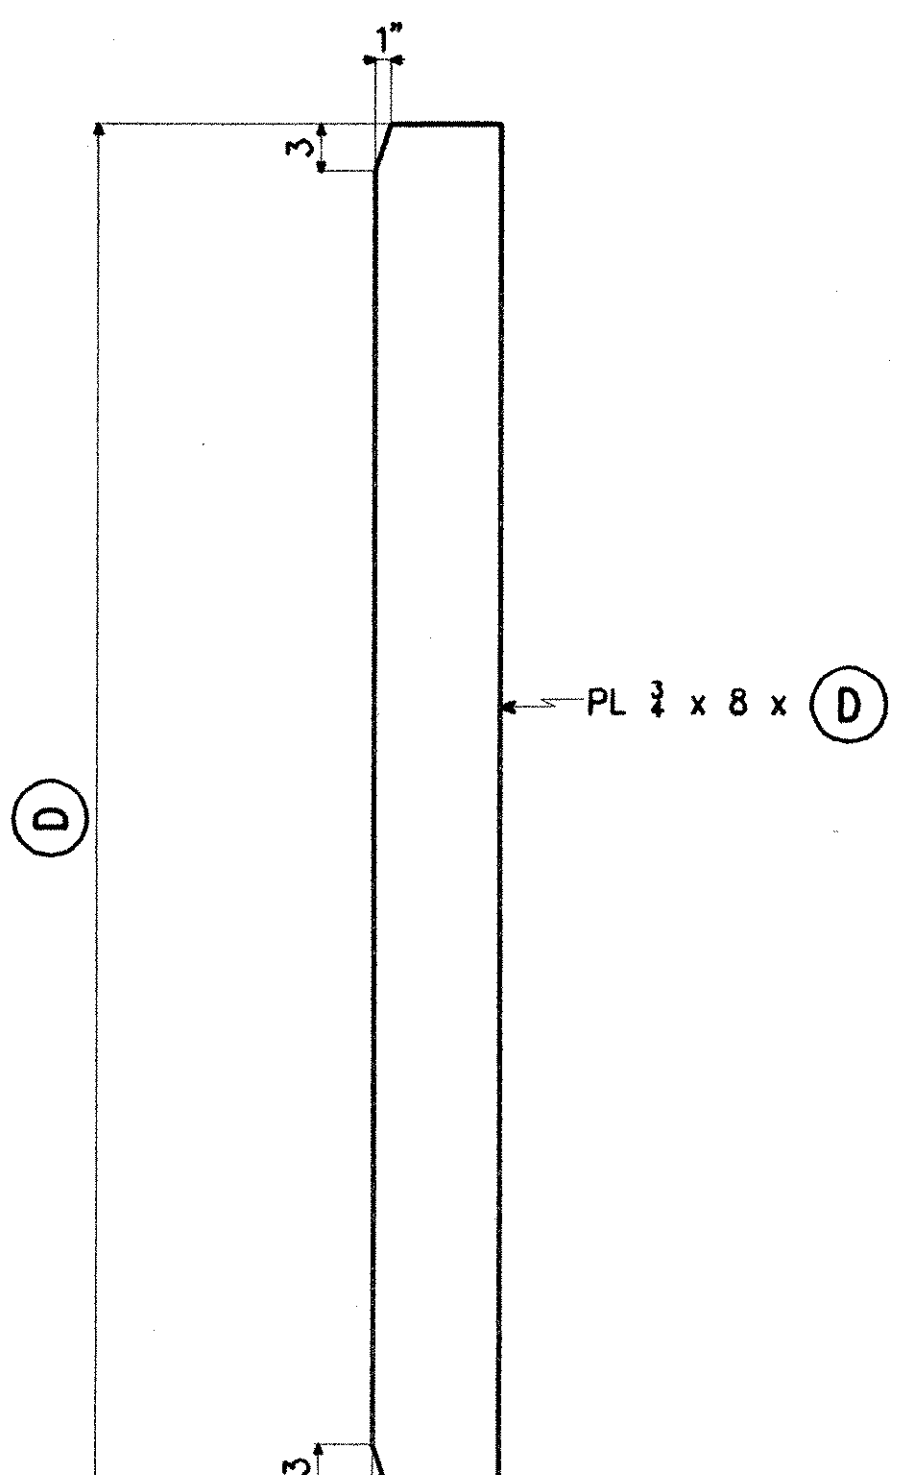


INT. STIFFS.

MARK	No. REQ'D.	(D)
s1	5	8'-1 1/2
s2	5	8'-3 1/2
s3	1	7'-4 1/2
s4	1	7'-5 1/2

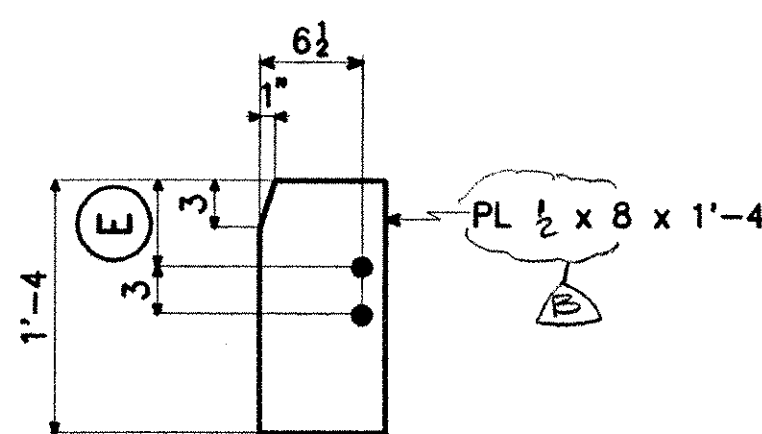


UTILITY CONN. PLTS.

MARK	No. REQ'D.	(E)
sf21	34	8
sf22	17	6 1/2
sf23	17	6 1/2
sf24	10	9 1/2
sf25	14	9 1/2
sf26	102	5 1/2
sf34	10	9

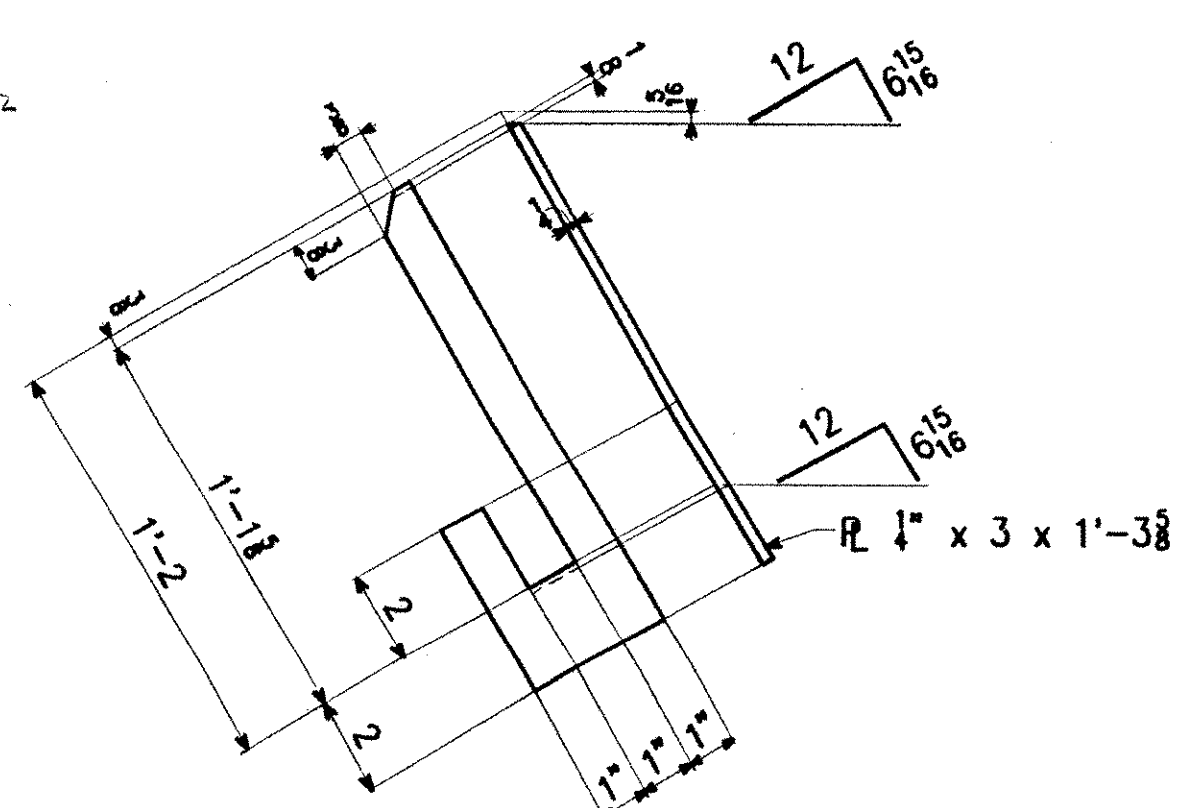

2 ~ dp1^R 3/11 s_{3/10}

2 ~ dp1^L

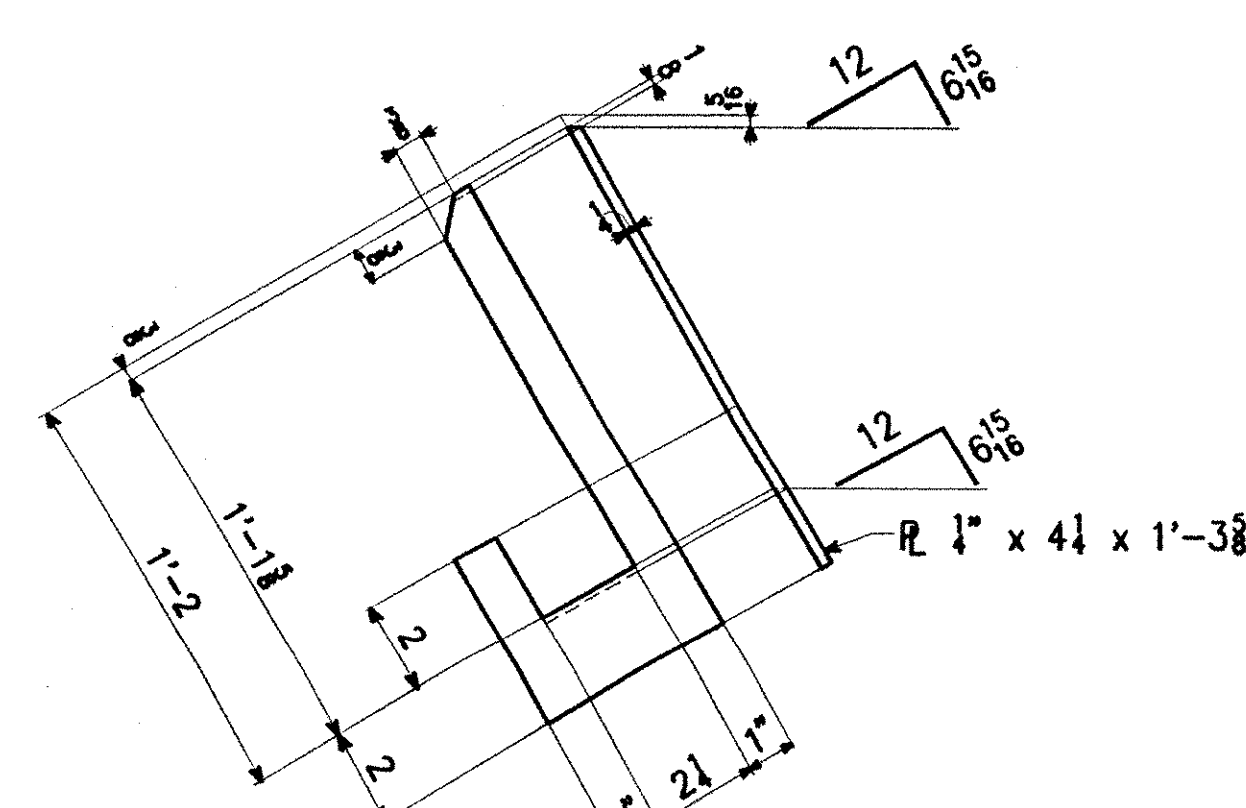

2 ~ dp2^R 3/11 s_{3/10}

2 ~ dp2^L

RECEIVED
 OK'D BY WGS OK'D BY AS
 AUG 27 2001
 RESUBMIT AS APPROVED AS
 BY Opw DATE 8/30/01

STEEL: ASTM ☐ A709-36 ☐ A709-50 ☒ A709-50W ☐ Unless Noted

WELDING ELECTRODE: ☒ E70 ☐ See Welding Proc. ☐ None

HOLES: ☐ 13/16 ☒ 15/16 ☐ 1 1/16 ☐ Unless Noted ☐ As Noted ☐ None

PAINT: ☒ None ☐ Galv. After Fab. ☐ As Noted

SPECIAL PAINT: ☐ Blast Clean ☒ SSPC SP 10 ☐ None

SPECIAL CLEANING: ☒ Blast Clean ☐ SSPC SP 10 ☐ None

ITEM NO. 506.55 BR. NO. 3 PROJ. NO. BRZ 1444(22)

TITLE: GIRDER STANDARD PARTS FOR APPROVAL

APPROVED: 5 4-7-01 APPR. 5 7-13-01 FAB. 5 8-24-01

ORIG. 5 7-13-01 APPR. 5 8-24-01

National Eastern Corporation
 Plainville, Connecticut

JOB: T.H. 1 OVER THE WHITE RIVER
 ROYALTON, VERMONT

CUSTOMER: BECK & BELLUCCI, INC.

DESIGNER: VERMONT AGENCY OF TRANSPORTATION

WORK ORDER NO. 15873 DRAWING NO. 12-9 REV. B