
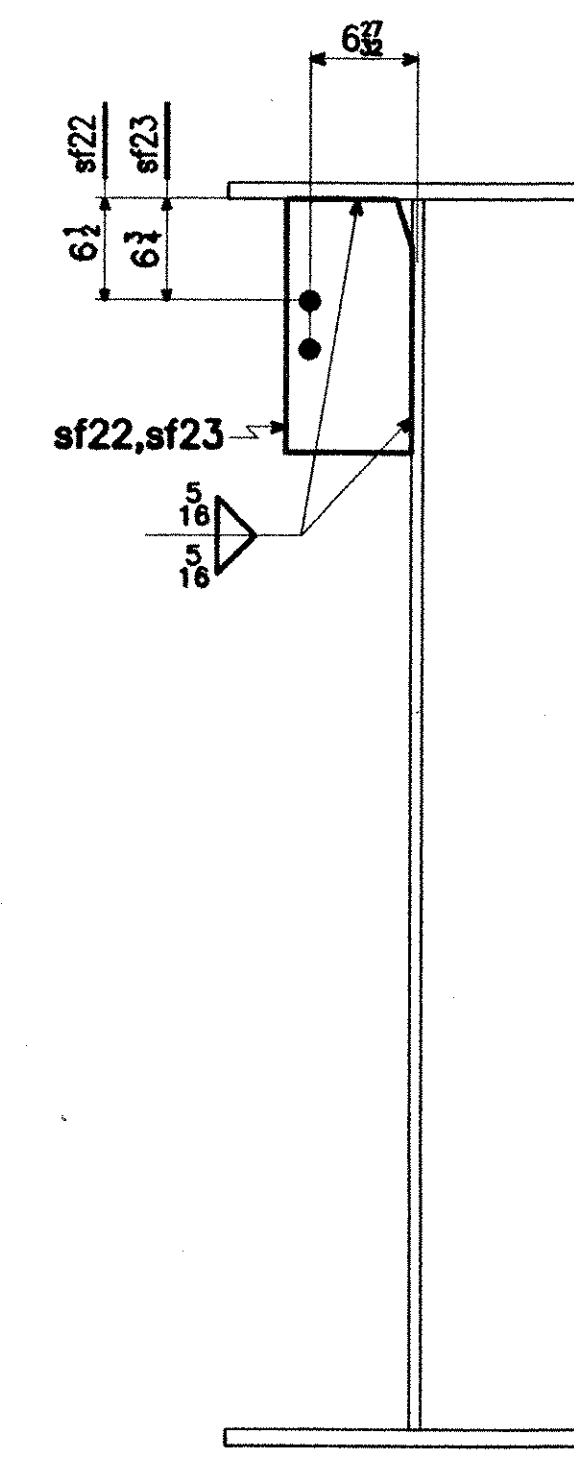
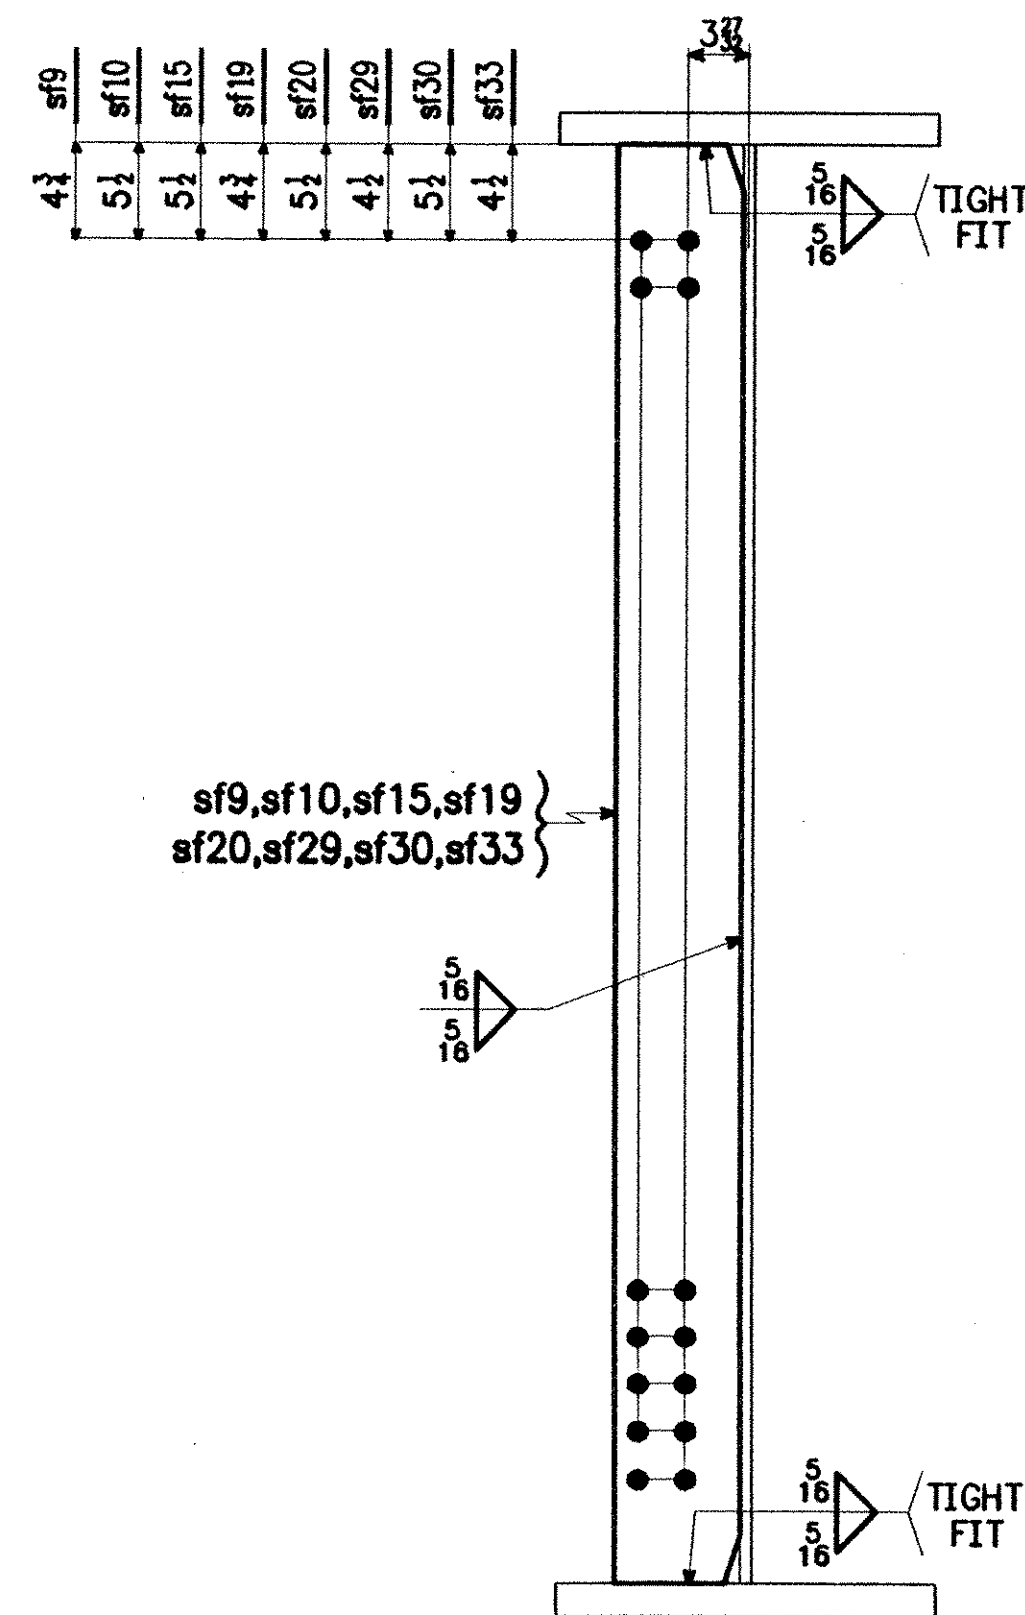
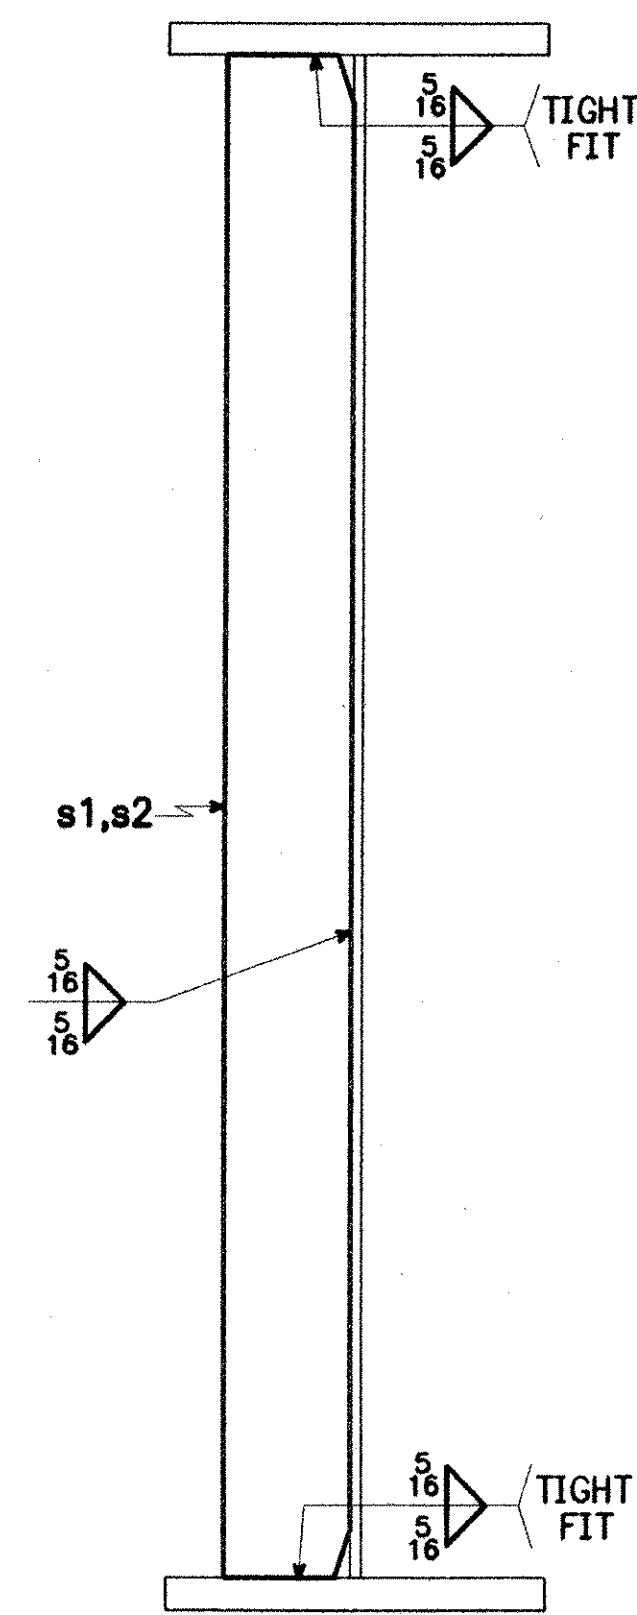
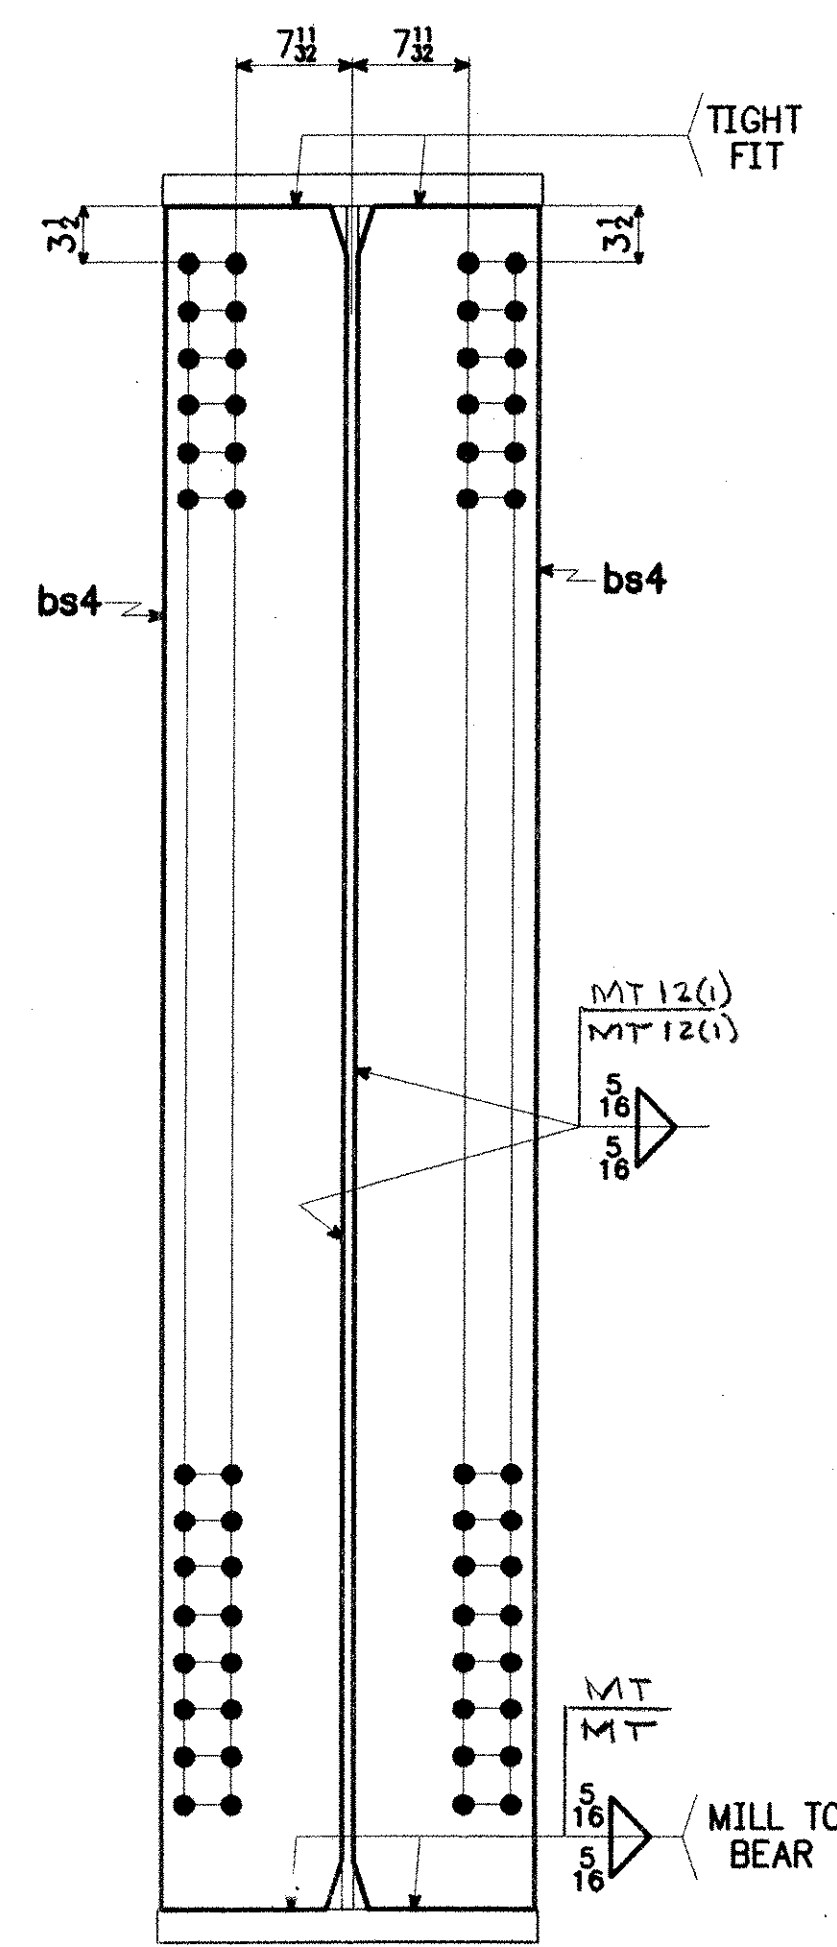


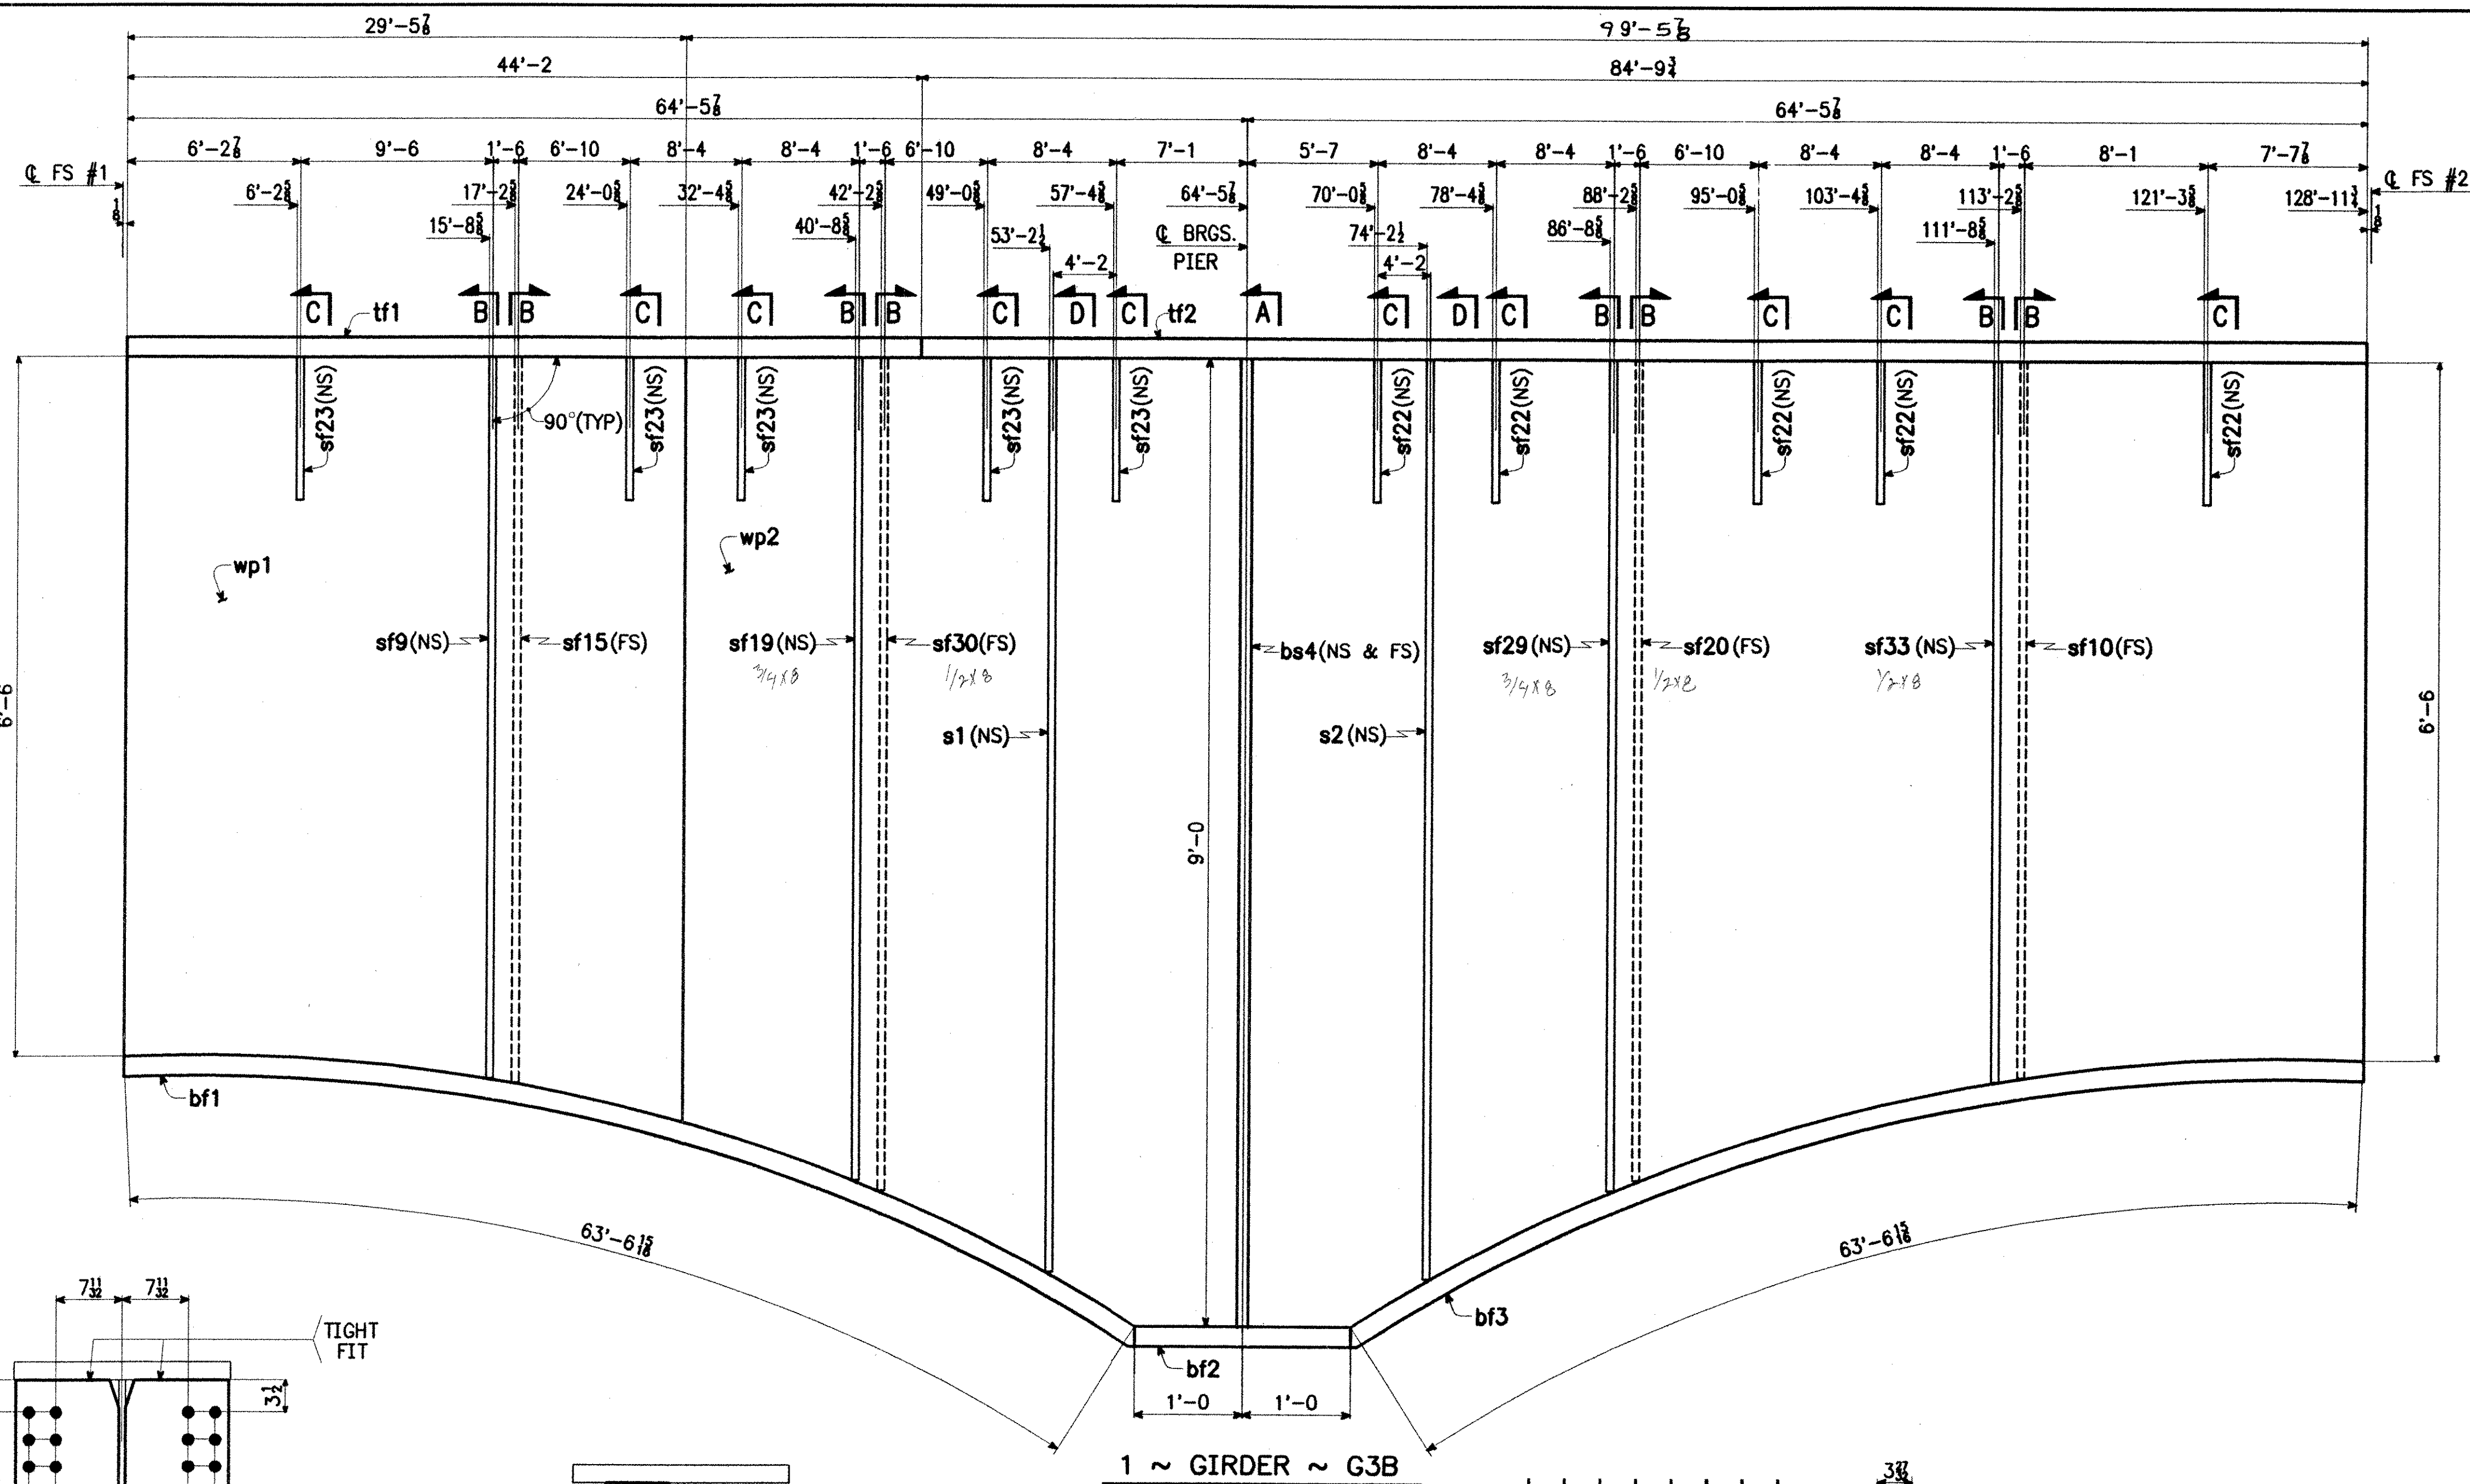

SHIP MARK	BILL OF MATERIAL				WORK ORDER NO.		DRAWING NO.		REV.
	NO.	MARK	SHAPE	LENGTH		ITEM NO.	WT.	REMARKS	
G3B	1		GIRDER						
	1	tf1	PL 2½ x 24	44'-2	5/16	2	8116	CVN	
	1	tf2	PL 2½ x 24	84'-9½	5/16	3	15584	CVN	
	1	bf1	PL 2½ x 24	63'-6½	5/16	2	11682	CVN	
	1	bf2	PL 2½ x 24	2'-0	5/16	2	368	CVN	
	1	bf3	PL 2½ x 24	63'-6½	5/16	2	11682	CVN	
	1	wp1	PL 1½ x 82½	29'-5½	5/16	1		CVN	
	1	wp2	PL 1½ x 108	99'-5½	5/16	1	26440	CVN	
	2	bs4	PL 1½ x 11½	9'-0	5/16	3	880	M1E	
	1	sf9	PL ½ x 8	6'-6⅞	53/16	3	89		
	1	sf10	PL ½ x 8	6'-6⅞	53/16	3	89		
	1	sf15	PL ½ x 8	6'-6⅞	53/16	3	89		
	1	sf19	PL ½ x 8	7'-4¼	53/16	3	150		
	1	sf20	PL ½ x 8	7'-4¼	53/16	3	100		
	1	sf29	PL ½ x 8	7'-5¼	53/16	3	152		
	1	sf30	PL ½ x 8	7'-5¼	53/16	3	101		
	1	sf33	PL ½ x 8	6'-6⅞	53/16	3	89		
	5	sf22	PL ½ x 8	1'-4	53/16	3	91		
	5	sf23	PL ½ x 8	1'-4	53/16	3	91		
	1	s1	PL ¾ x 8	8'-1½	53/16	3	167		
	1	s2	PL ¾ x 8	8'-3¼	53/16	3	169		
				</					

NOTES:

- FOR GENERAL NOTES, SEE SHT. GN1.
- FOR GIRDER CAMBER DIAGRAM, SEE DWG. 12-7.
- FOR GIRDER STANDARD DETAILS, SEE DWG. 12-9.
- FOR FIELD SPICE DETAIL, SEE DWG. 12-10.

RECEIVED
 CK'D BY WBS OK'D BY _____
 AUG 27 2001
 RESUBMIT _____
 BY CPW DATE 8/20/01

STEEL: ASTM	☐ A709-36	☐ A709-50	☒ A709-50W	☐ Unless Noted
WELDING ELECTRODE:	☒ E70	☐ See Welding Proc.	☐ None	☐
HOLES:	☐ 13/16	☒ 15/16	☐ 1 1/16	☐ Unless Noted ☐ As Noted ☐ None
PAIN:	☒ None	☐ Galv. After Fab.	☐ As Noted	☐
SPECIAL PAINT:				
SPECIAL CLEANING:	☒ Blast Clean SSPEC SP10	☐ None		
ITEM NO. 506.55	BR. NO. 3	PROJ. NO. BRZ 1444(22)		
TITLE: GIRDER ~ G3B				
APPROVED:				
PRINT DIST.				
5	4-7-01	APPR.		
ORIG.		FAB.		
5	7-13-01	APP		
5	8-24-01	APP		
National Eastern Corporation Plainville, Connecticut JOB: T.H. 1 OVER THE WHITE RIVER ROYALTON, VERMONT				
CUSTOMER: BECK & BELLUCCI, INC.				
DESIGNER: VERMONT AGENCY OF TRANSPORTATION				
WORK ORDER NO. 15873				
DRAWING NO. 12-18				
REV. B				