



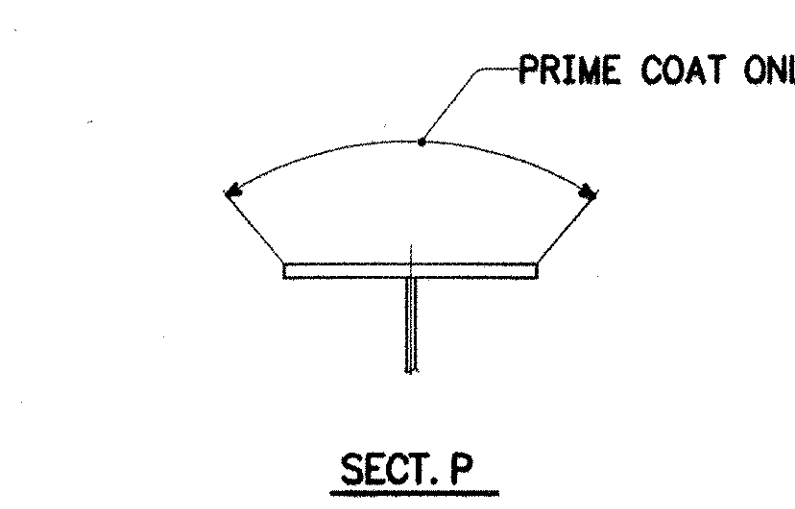

SECT. D

*PRIME COAT ONLY BOTT.
OF BOTT. FLG. AND EDGES

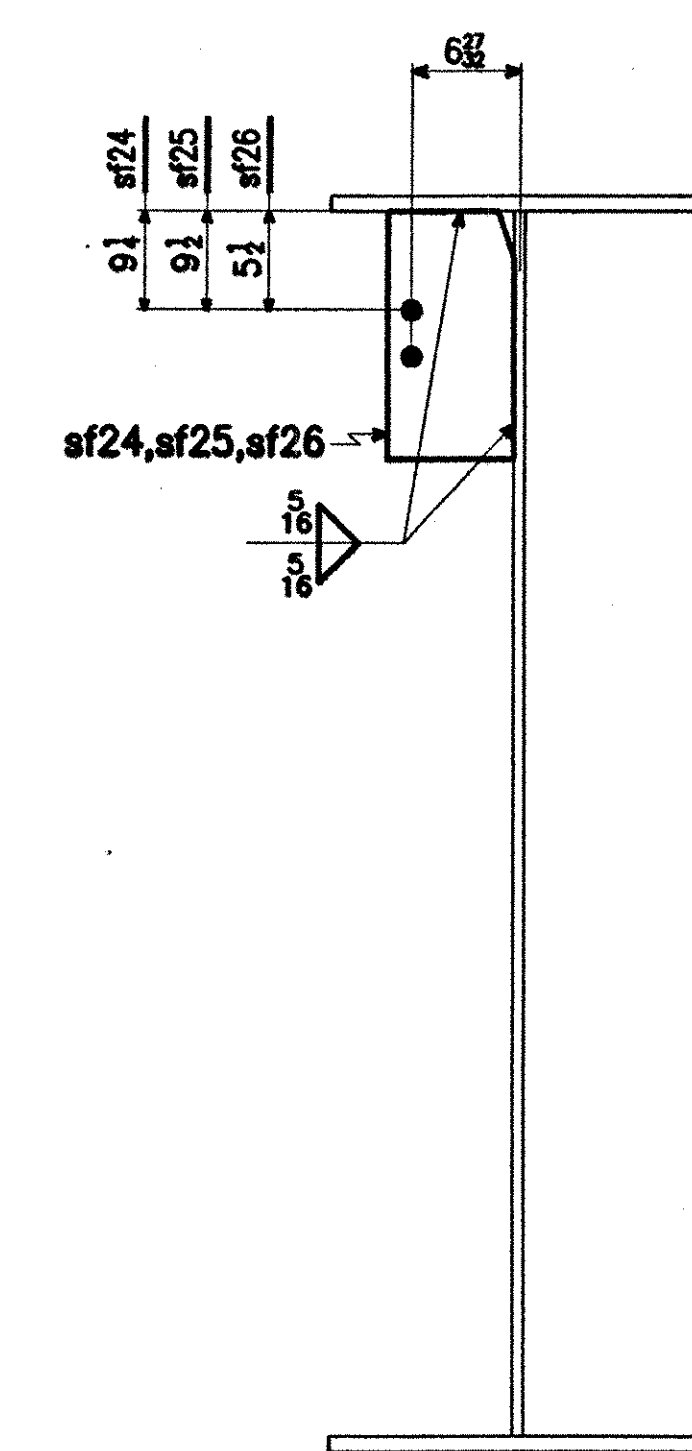

SECT. C

- NOTES:**
1. FOR GENERAL NOTES, SEE SHT. GN1.
 2. FOR GIRDER CAMBER DIAGRAM, SEE DWG. 12-5.
 3. FOR GIRDER STANDARD DETAILS, SEE DWG. 12-9.
 4. FOR FIELD SPLICE DETAIL, SEE DWG. 12-10.

RECEIVED
CK'D BY WGS CK'D BY _____
DEC 27 2001
RESUBMIT _____ APPROVED As WGS
BY gpn DATE 1/4/02

3 FLG, WEB & EXT DIM 12-17-01 AV
2 PAINT NOTE 11-19-01 JCM
1 SECT H 9-11-01 JCM

SHIP MARK	BILL OF MATERIAL					WORK ORDER NO.	DRAWING NO.	REV.
	NO.	MARK	SHAPE	LENGTH		15873	12-24	3
						ITEM NO.	WT.	REMARKS
G4C	1		GIRDER					
	1	tf1	PL 1" x 24	77'-6 ⁷ / ₁₆		S-1/4 1	6332	CVN
	1	tf2	PL 1" x 24	55'-0 ⁸ / ₁₆		S-1/5 1	4494	CVN
	1	bf1	PL 1" x 24	77'-6 ¹ / ₁₆		S-1/4 1	6332	CVN
	1	bf2	PL 1" x 24	54'-11 ¹¹ / ₁₆		S-1/5 1	4490	CVN
	1	wp1	PL 1 1/8 x 78	79'-6 ¹ / ₁₆		S-3/2 1	X	CVN
	1	wp2	PL 1 1/8 x 78	53'-1 ¹ / ₁₆		S-3/2 1	2494	CVN
	1	bs2 ^L	PL 1 1/4 x 11 1/2	6'-6 1/2		S-1/11 3	318	M1E
	1	bs2 ^R	PL 1 1/4 x 11 1/2	6'-6 1/2		L 3	318	M1E
	5	sf1	PL 1 1/2 x 8	6'-6		S-3/2 3	442	
	1	sf6	PL 1 1/2 x 8	6'-6		S-3/2 3	88	
	4	sf8	PL 1 1/2 x 8	6'-6		L 3	354	
	3	sf24	PL 1 1/2 x 8	1'-4		S-3/2 3	54	
	9	sf25	PL 1 1/2 x 8	1'-4		S 3	163	
	12	sf26	PL 1 1/2 x 8	1'-4		L 3	218	
	2	f1	PL 3/8 x 24	3'-4 1/2		S-3/5 2	345	CVN
	4	f2	PL 3/8 x 10	3'-4 1/2		L 2	287	CVN
	2	f3	PL 1 1/4 x 24	1'-9 3/8		S-1/10 2	368	
	2	ws1	PL 3/8 x 72 1/2	1'-7 1/2		S-3/5 2	501	CVN
							49288	*

STEEL: ASTM	☐ A709-36	☐ A709-50	☒ A709-50W	☐ Unless Noted	☐	
WELDING ELECTRODE:	☒ E70	☐ See Welding Proc.	☐ None	☐	☐	
HOLES:	☐ 13/16	☒ 15/16	☐ 1 1/16	☐ Unless Noted	☐ As Noted	☐ None
PAIN: 	☐ None	☐ Galv. After Fab.	☐ As Noted	☒ SEE SHT & N1	☐	
SPECIAL PAINT:						
SPECIAL CLEANING:	☒ Blast Clean SSPC SP10	☐ None				
ITEM NO.506.55	BR. NO. 3		PROJ. NO. BRZ 1444(22)			

TITLE: GIRDER ~ G4C

APPROVED: 9-5-01
PRINT DIST.

NE National Eastern Corporation
Plainville, Connecticut

JOB: T.H. 1 OVER THE WHITE RIVER
ROYALTON, VERMONT

CUSTOMER: BECK & BELLUCCI, INC.

DESIGNER: VERMONT AGENCY OF TRANSPORTATION

3	WORK ORDER NO.	DRAWING NO.	REV.
	15873	12-24	3