


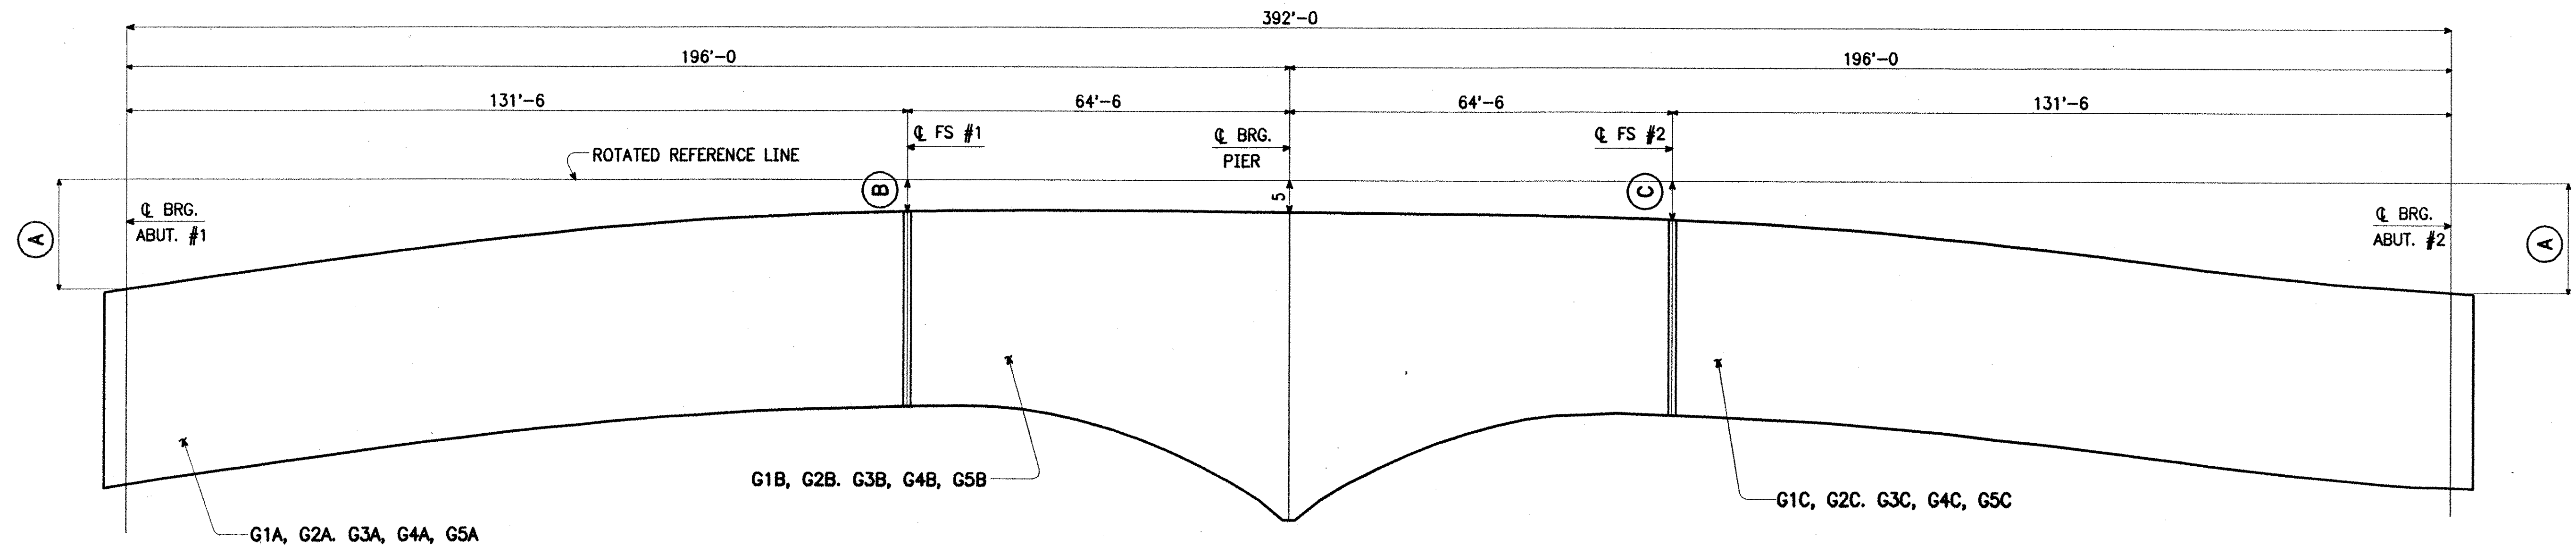

VERTICAL BLOCKING DIAGRAM FOR GIRDER LINES 1 THRU 5

LINE	(A)	(B)	(C)
1	4'-2 1/8	5 1/8	9 1/8
2	4'-2 1/8	6 1/8	9 1/8
3	4'-2 1/8	6 1/2	9 5/8
4	4'-2 1/8	6 3/8	9 1/8
5	4'-3 3/8	7 1/2	9 3/8

- NOTES:
- FOR GENERAL NOTES, SEE SHT. GN1.
 - ALL HOLES FOR SPLICES SHALL BE SUBPUNCHED OR SUBDRILLED 1 1/8" AND REAMED TO 1 3/8" WITH ALL PARTS ASSEMBLED OR DRILLED TO 1 3/8" FROM SOLID.
 - ALL LONGITUDINAL DIMENSIONS IN THE VERTICAL BLOCKING DIAGRAM ARE DEVELOPED ALONG THE ROTATED REFERENCE LINE.
 - ALL GIRDERS MUST BE ASSEMBLED AS PER THE DIAGRAM SHOWN PRIOR TO REAMING OR DRILLING. FOR FIELD SPLICE DETAILS, SEE DWG. 12-10.

RECEIVED
CHK'D BY *WES* OK'D BY
AUG 27 2001
RESUBMIT BY *CPW* APPROVED *✓* DATE 8/28/01

ITEM NO. 506.55	BR. NO. 3	PROJ. NO. BRZ 1444(22)
TITLE: BLOCKING DIAGRAMS		
APPROVED:		
PRINT DIST.		
5	4-7-01	APPR.
ORIG.		FAB.
5	7-13-01	APP
5	8-24-01	APP
JOB: T.H. 1 OVER THE WHITE RIVER ROYALTON, VERMONT		
CUSTOMER: BECK & BELLUCCI, INC.		
DESIGNER: VERMONT AGENCY OF TRANSPORTATION		
CHECKED DRAWN	TS AV	3/01 3/01
WORK ORDER NO. 15873		DRAWING NO. 70-1
		REV. A

OK