




NOTE: SEE SHEET NO. 8 FOR CURB ASSEMBLY ON THIS SIDE.

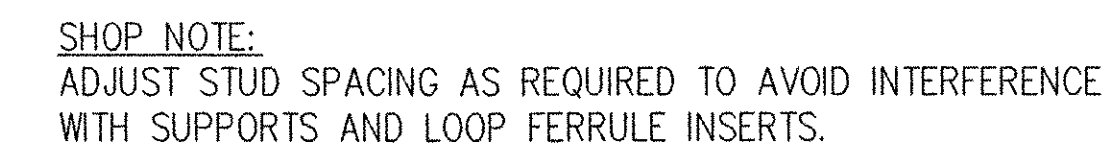

PLAN VIEW
1 - EXPANSION JOINT - 1A

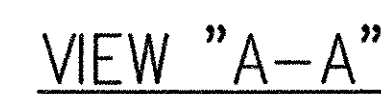

VIEW "B-B"

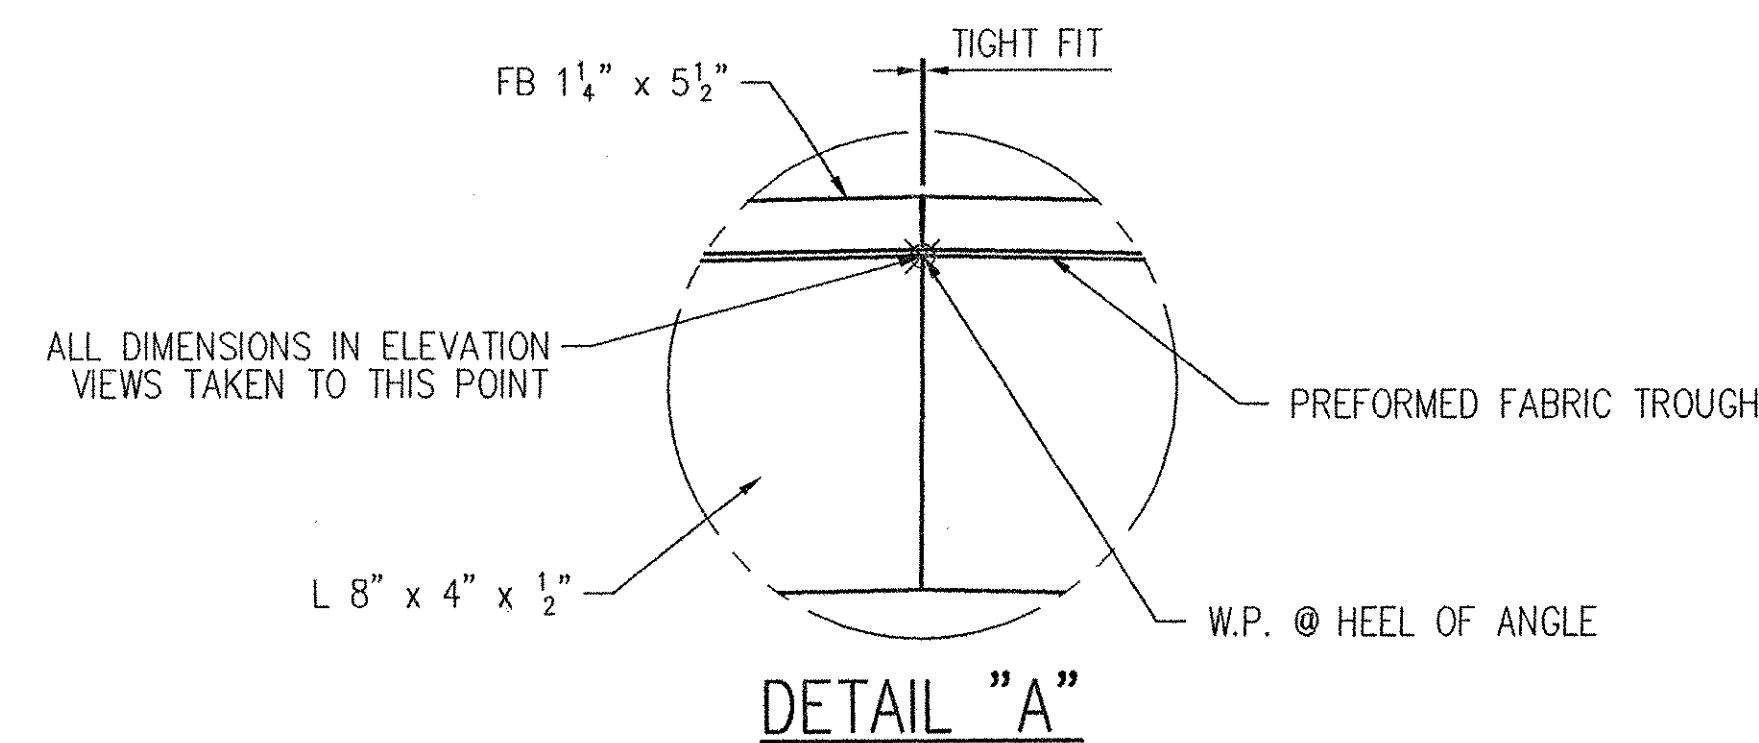

SHOP NOTE:
ALL WELDS SHOWN IN VIEW "B-B"
ARE TYP. IN VIEW "A-A". ALL MITER
CUTS IN VIEW "A-A" ARE ALSO TYP.
IN VIEW "B-B". IN ADDITION, ALL
DIMENSIONS FOR "SUPPORT PLATES"
SHOWN IN VIEW "A-A" ARE TYPICAL
IN VIEW "B-B" ALSO. SEAL ALL
ACCESSIBLE JOINTS FOR GALVANIZING.

-SEE SHEET NO. 15 FOR GENERAL NOTES.
 -HIDDEN LINES REMOVED FOR CLARITY.
 -SHIPPING ANGLES REMOVED FOR CLARITY.
 -CURB ASSEMBLY NOT SHOWN FOR CLARITY.
 -ALL DIMENSIONS SHOWN IN THE ELEVATION
 VIEWS ARE MEASURED ALONG THE HEEL OF
 THE 8" x 4" x 1/2".
 -FOR SECTION "A-A" AND SECTION "B-B"
 SEE SHEET NO. 2.

RECEIVED
BY WBS OK'D BY _____
JAN 11 2002
SUBMIT _____ APPROVED ☒
CPW DATE 1/11/02

	SHOP	
	APPROVAL	
	DIST.	
	CUST.	
	FOR	DATE
	PRINTS	ISSUED

 GENERAL REVISION PER APPROVAL		1/2/02 JMB	
REV.	DESCRIPTION	DATE	INT.
ANY AND ALL BACKCHARGES WILL BE REJECTED UNLESS WRITTEN CONSENT IS GIVEN BY LEWIS ENGINEERING COMPANY PRIOR TO ANY WORK PERFORMED FOR OUR ACCOUNT. SUCH REJECTION MEANS THAT INVOICES WILL NOT BE HONORED OR DEDUCTIONS FROM PAYMENT WILL BE CHARGED BACK.			
 LEWIS ENGINEERING COMPANY 4201 NOREX DRIVE - CHASKA, MINNESOTA 55318 - (952) 388-3000			
PROJECT	— ROYALTON / RTE. NO. TH 1, CL 1 BRIDGE NO. 3		
STATE PROJECT	— AC BRZ 1444(22)		
FEDERAL PROJECT	—		
CUSTOMER	— BECK & BELLUCCI, INC.		
LOCATION	— WINDSOR COUNTY, VT		
DESCRIPTION	— EXPANSION JOINT DETAILS ABUTMENT NO. 2		
L.E.C. 1 OF 30		SHEET NO. 1 OF 15	
		Job. No. : 2034.1042.1	