
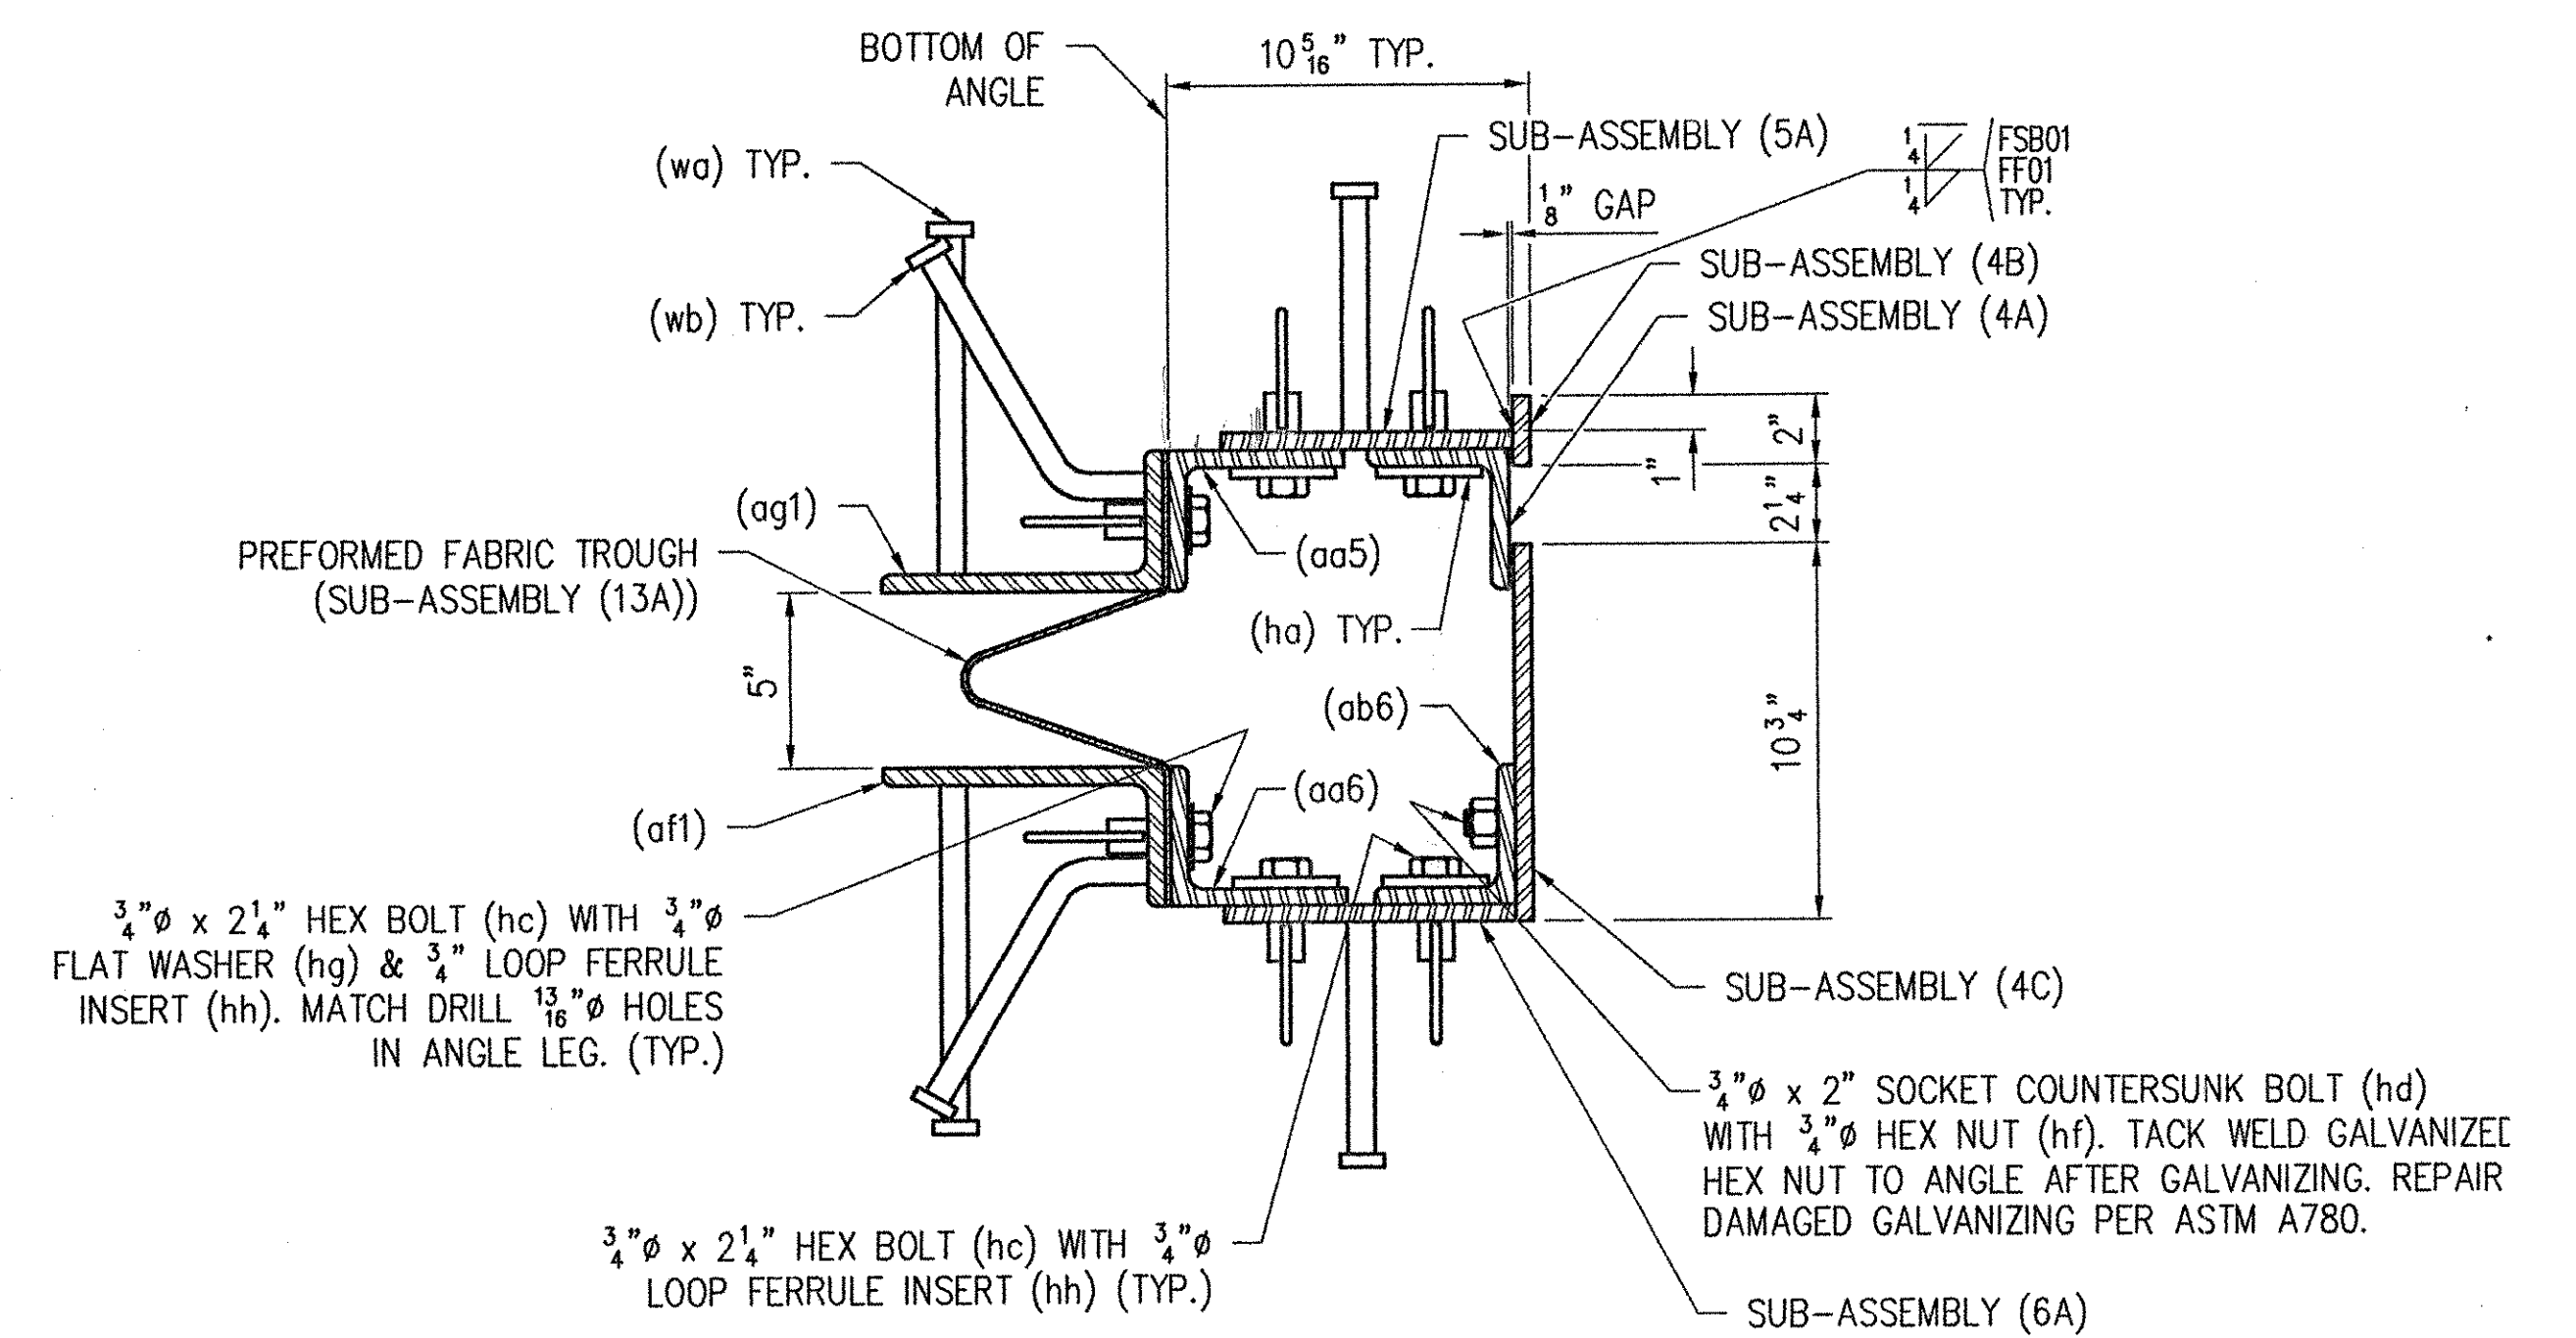
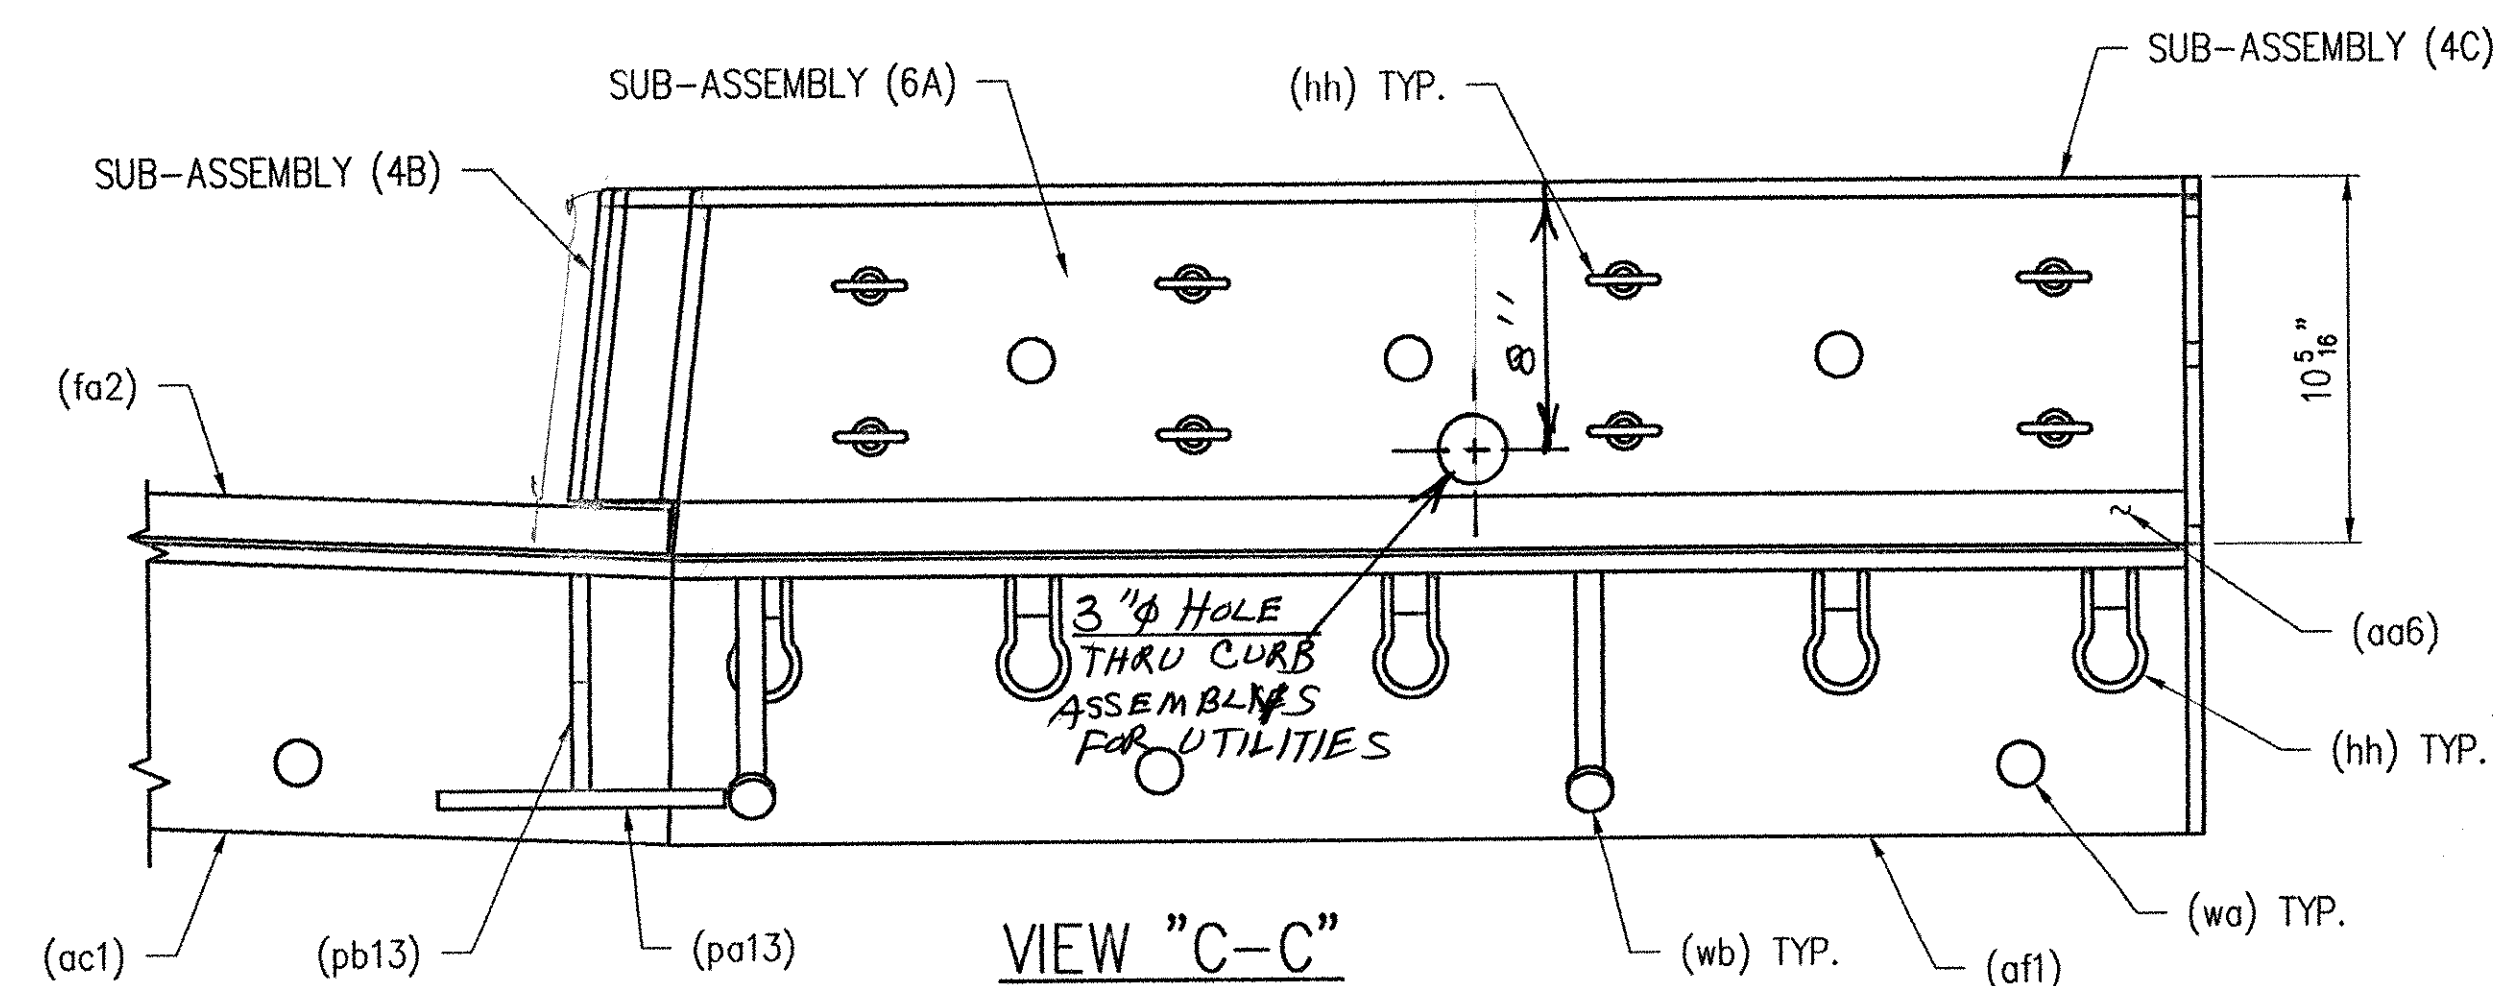
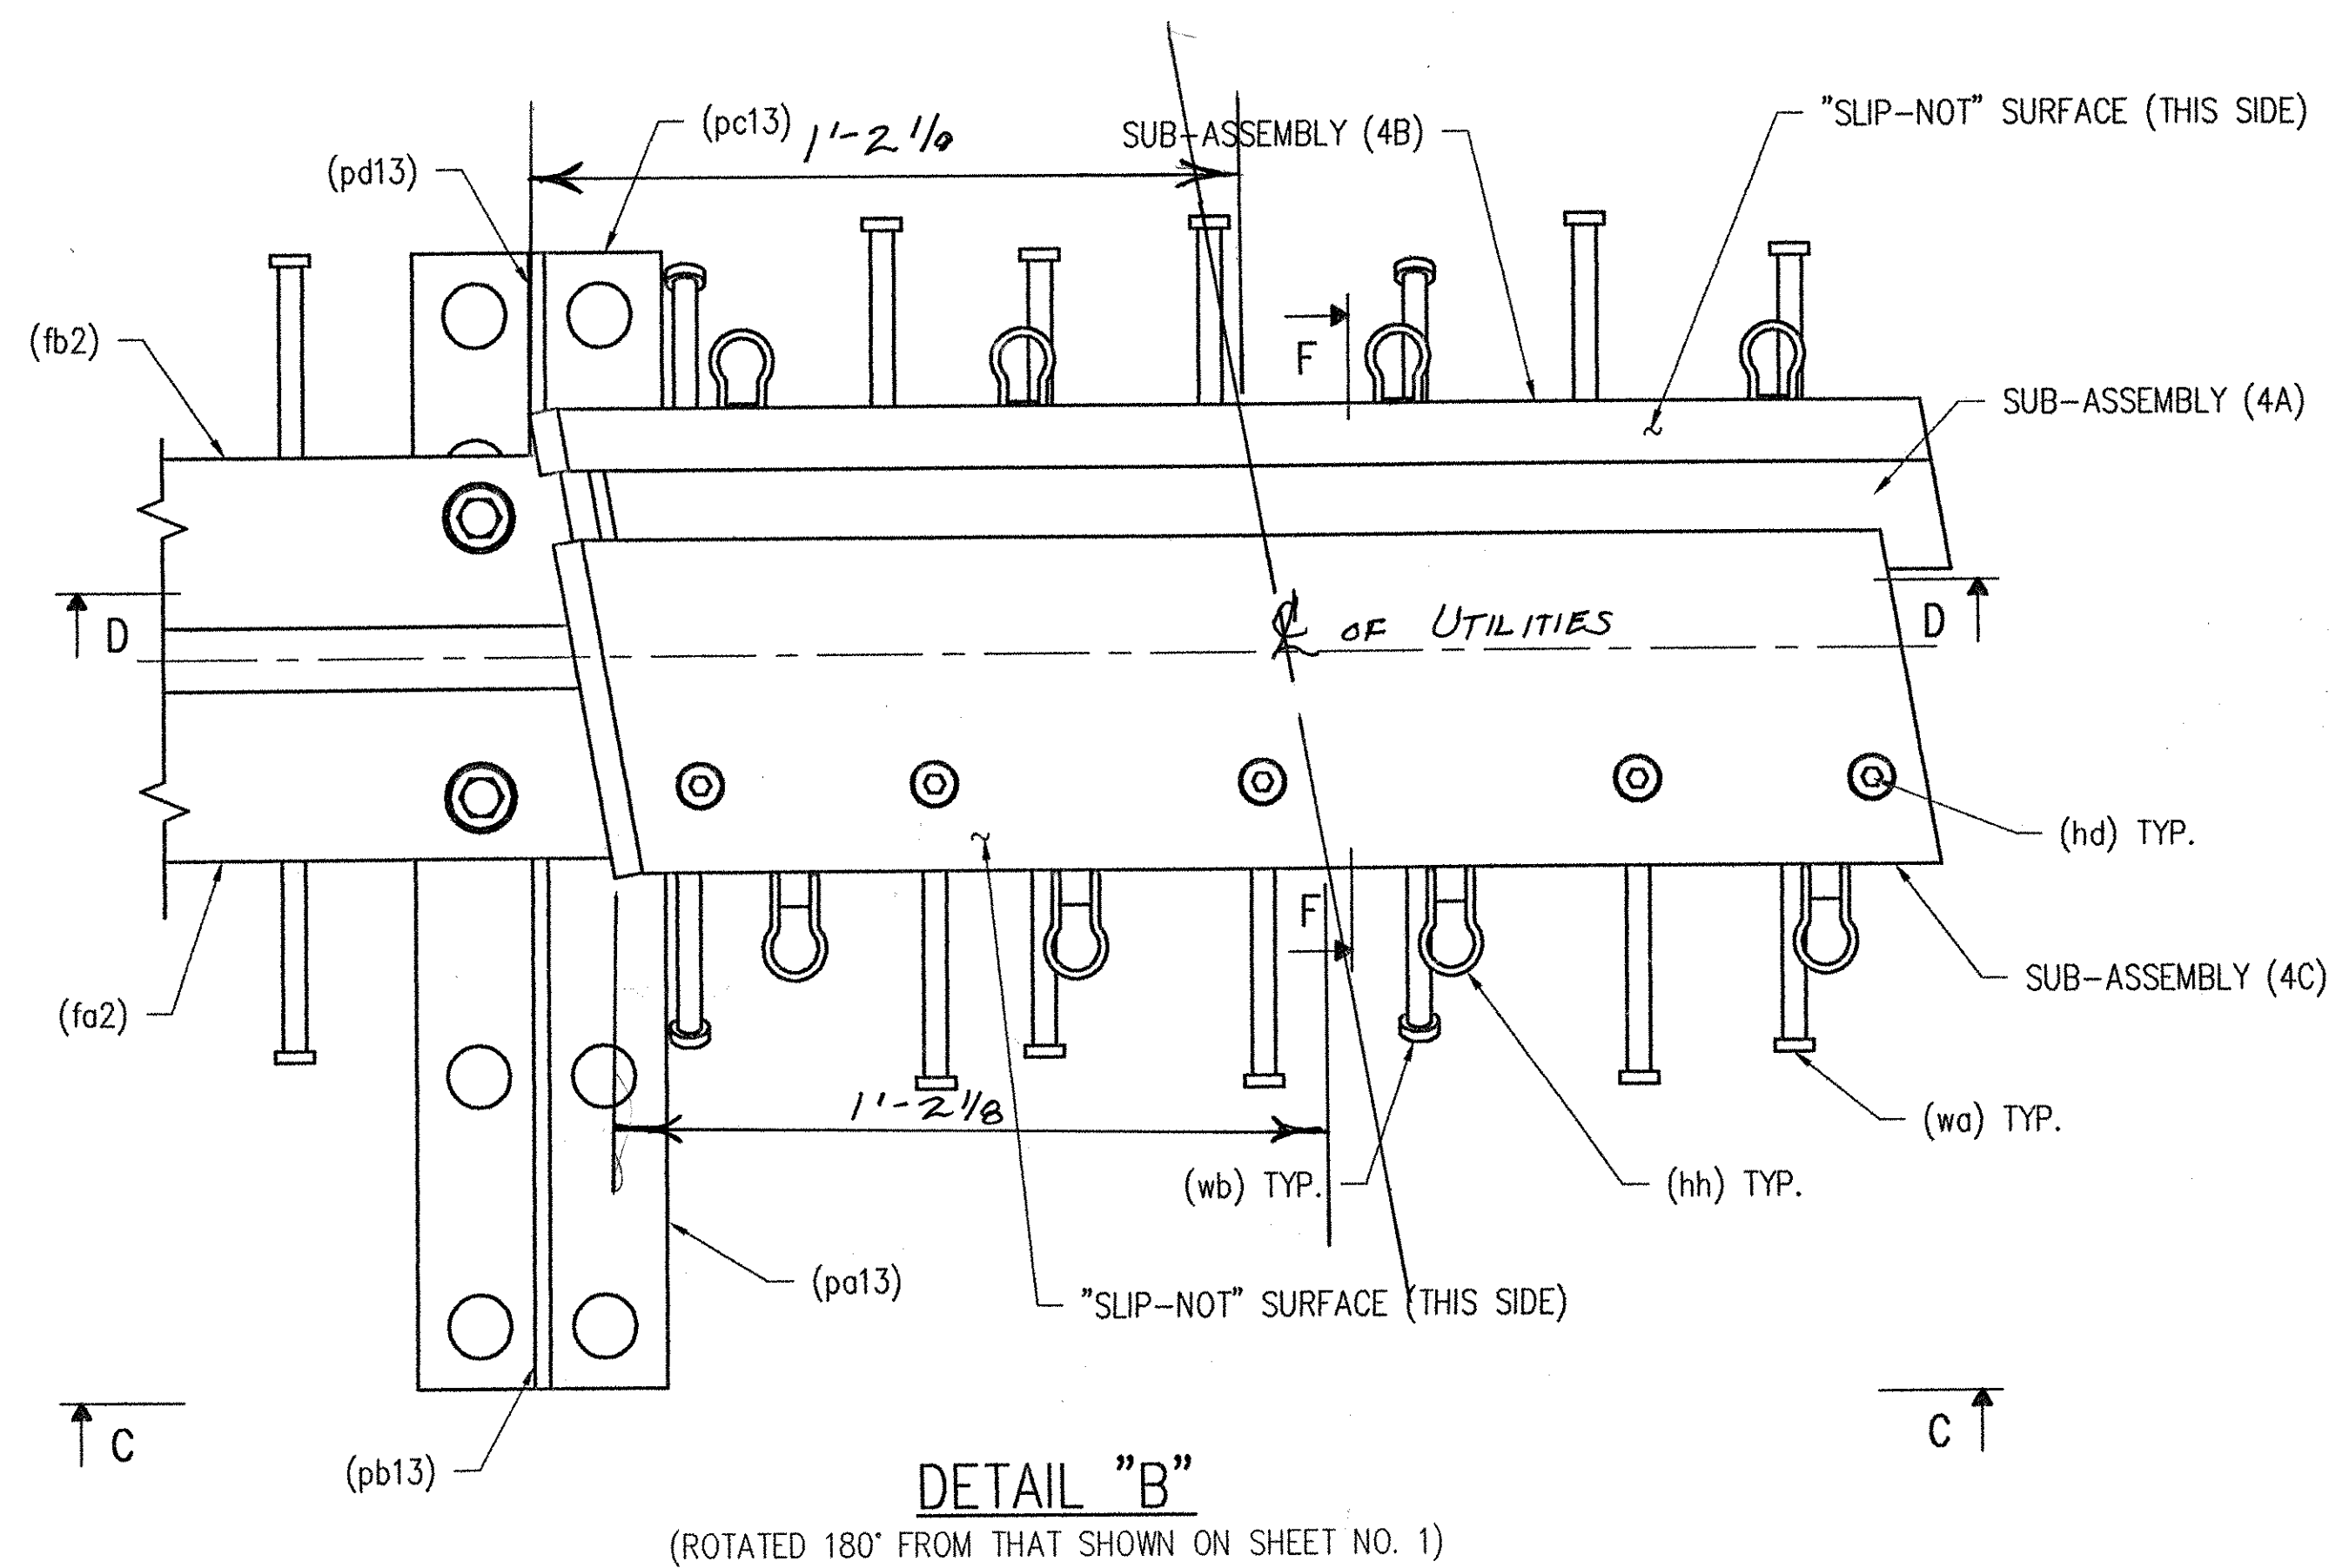


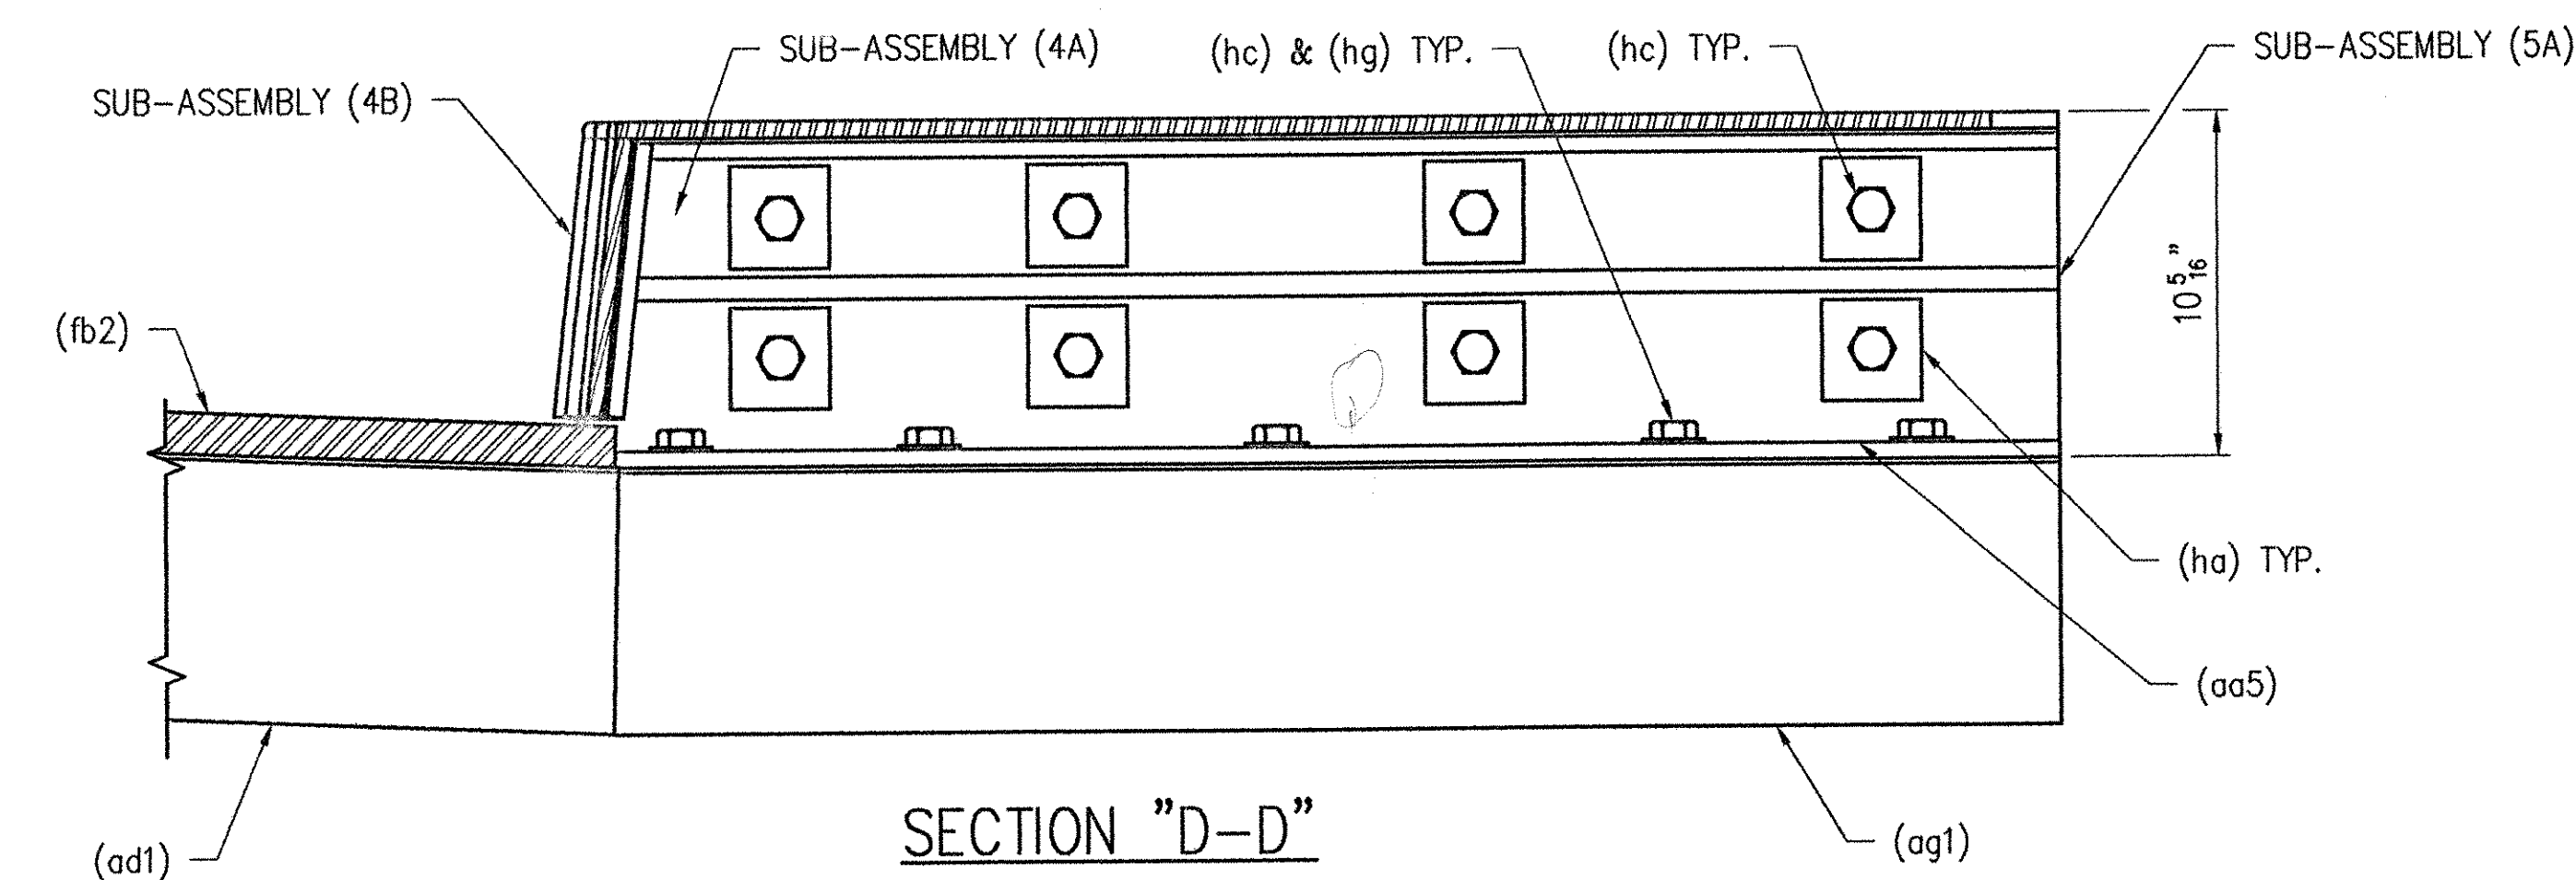

SECTION "F-F"

SEE SHEET NO. 15 FOR GENERAL NOTES.
WORK THIS SHEET WITH SHEET NO. 1, 4, 5, 6 & 7.

REV.	DESCRIPTION	DATE	INT.
1	GENERAL REVISION PER APPROVAL.	1/2/02	JME
ANY AND ALL BACKCHARGES WILL BE REJECTED UNLESS WRITTEN CONSENT IS GIVEN BY LEWIS ENGINEERING COMPANY PRIOR TO ANY WORK PERFORMED FOR OUR ACCOUNT. SUCH REJECTION MEANS THAT INVOICES WILL NOT BE HONORED OR DEDUCTIONS FROM PAYMENT WILL BE CHARGED BACK.			
LEWIS ENGINEERING COMPANY 4201 NOREX DRIVE - CHASKA, MINNESOTA 55318 - (952) 368-3000 PROJECT STATE PROJECT FEDERAL PROJECT CUSTOMER LOCATION DESCRIPTION ROYALTON / RTE. NO. TH 1, CL 1 BRIDGE NO. 3 AC BRZ 1444(22) BECK & BELLUCCI, INC. WINDSOR COUNTY, VT EXPANSION JOINT DETAILS			
W.P. chkd Drawn By JMB Chkd. By TSF Date: 12/5/01		L.E.C. 3 OF 30 SHEET NO. 3 OF 15 Job. No. : 2034.1042.1	

RECEIVED
OK'D BY WBS OK'D BY _____
JAN 11 2002
RESUBMIT BY CPW APPROVED DATE 1/11/02