




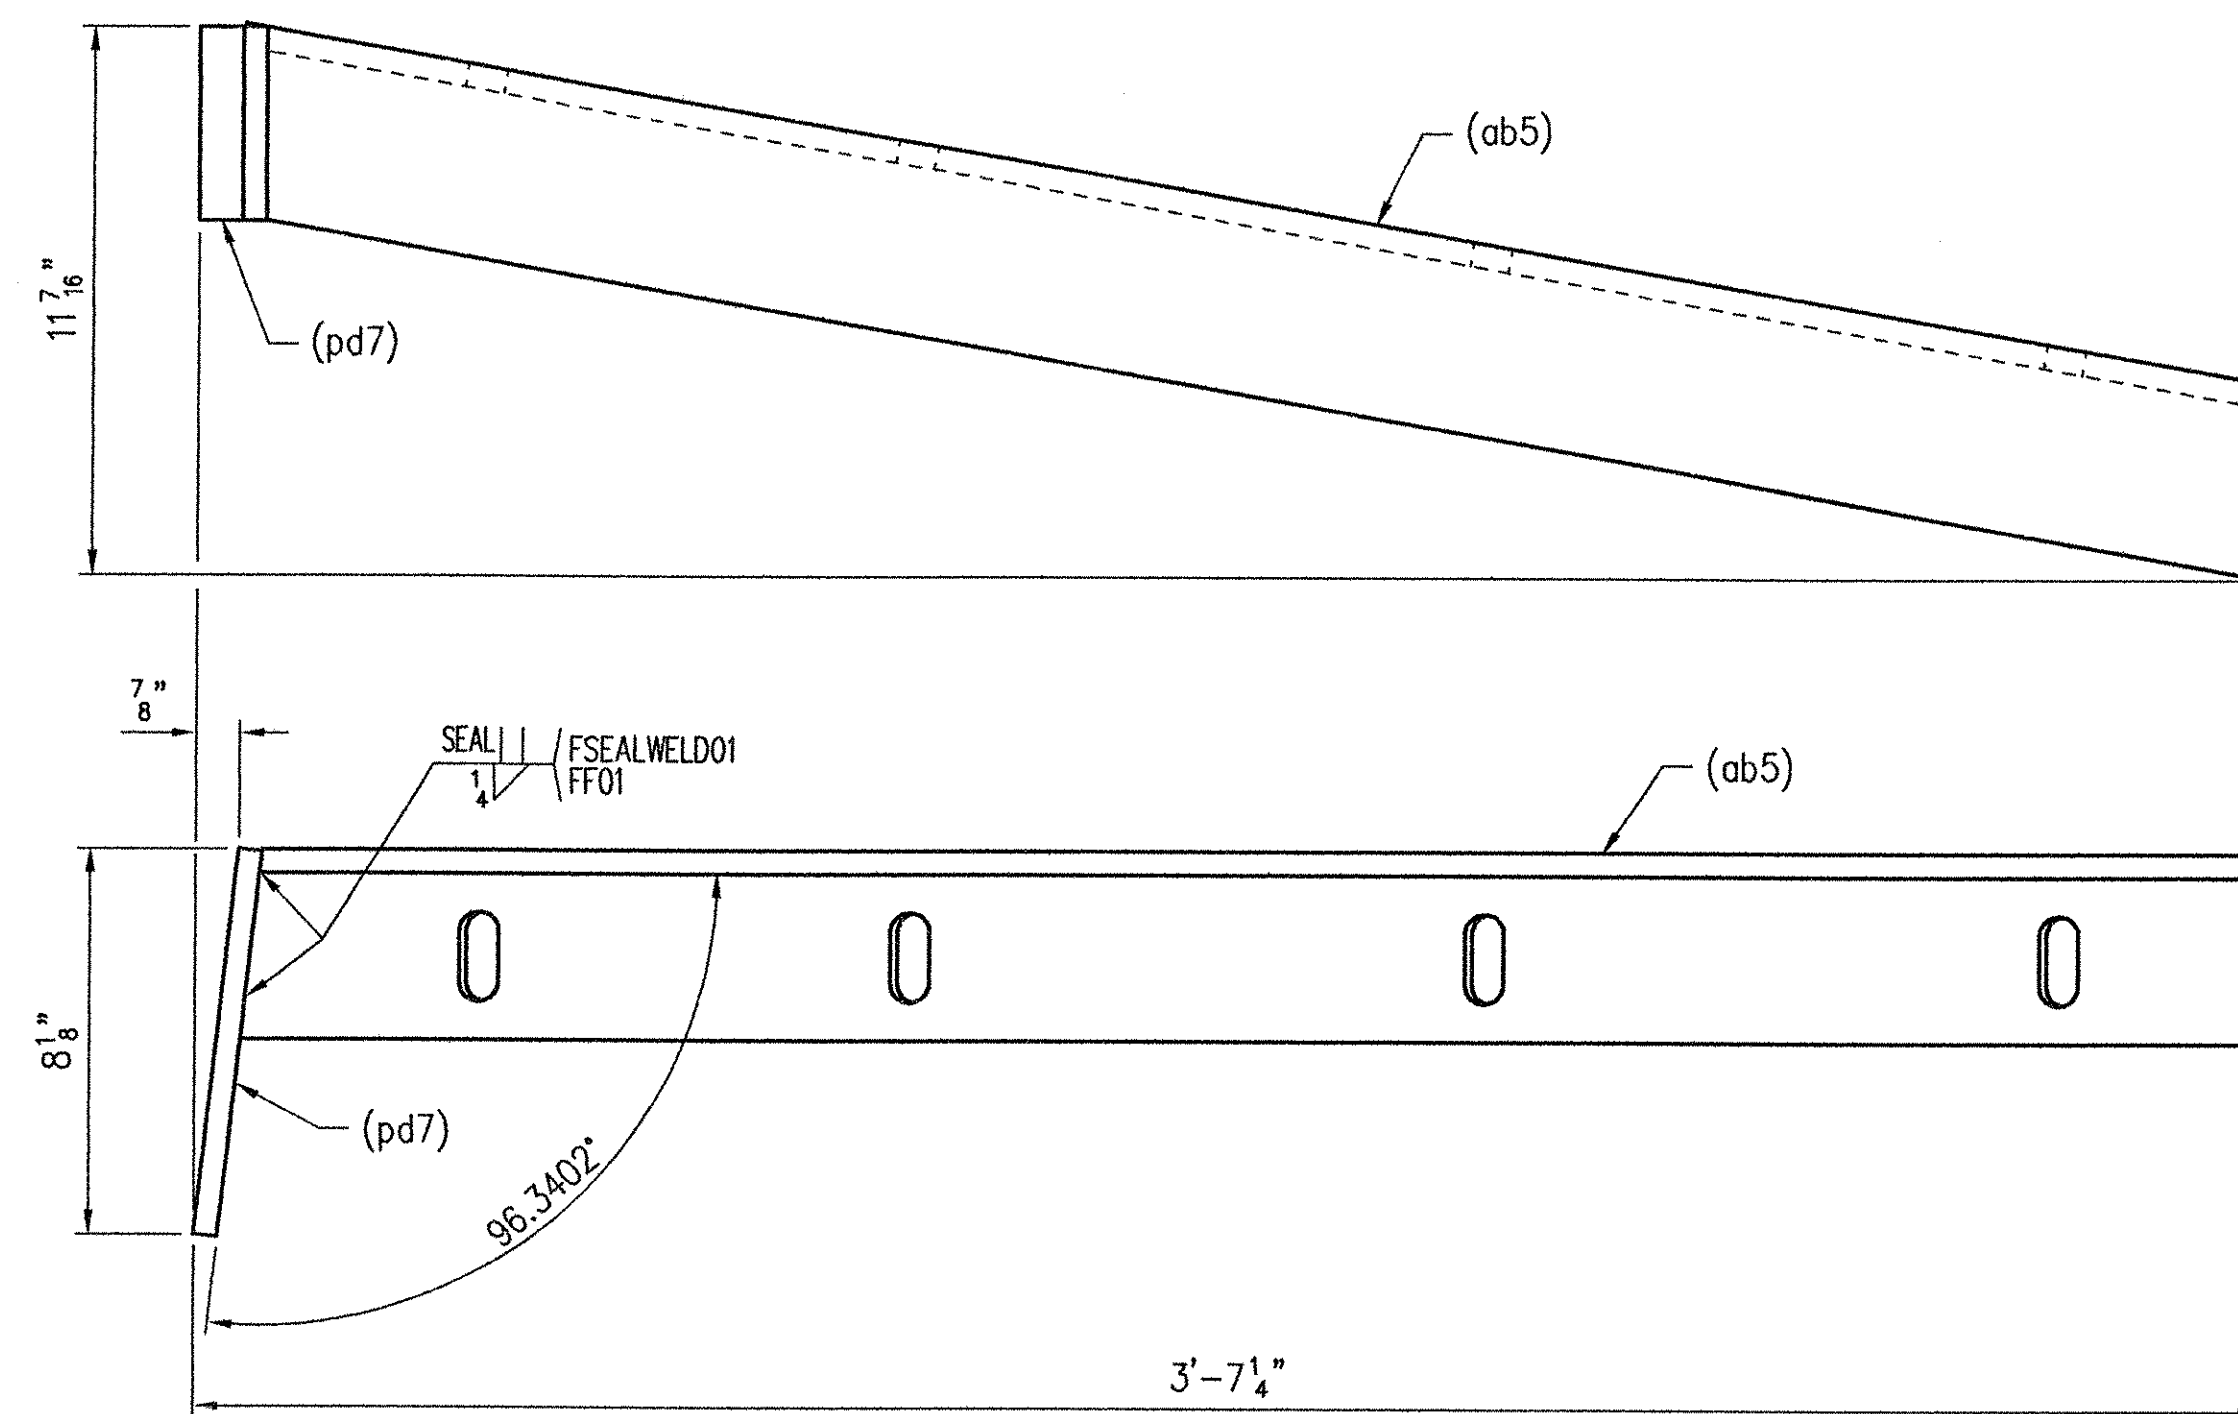

1 - SUB-ASSEMBLY - 4A
(SOME HIDDEN LINES REMOVED FOR CLARITY)

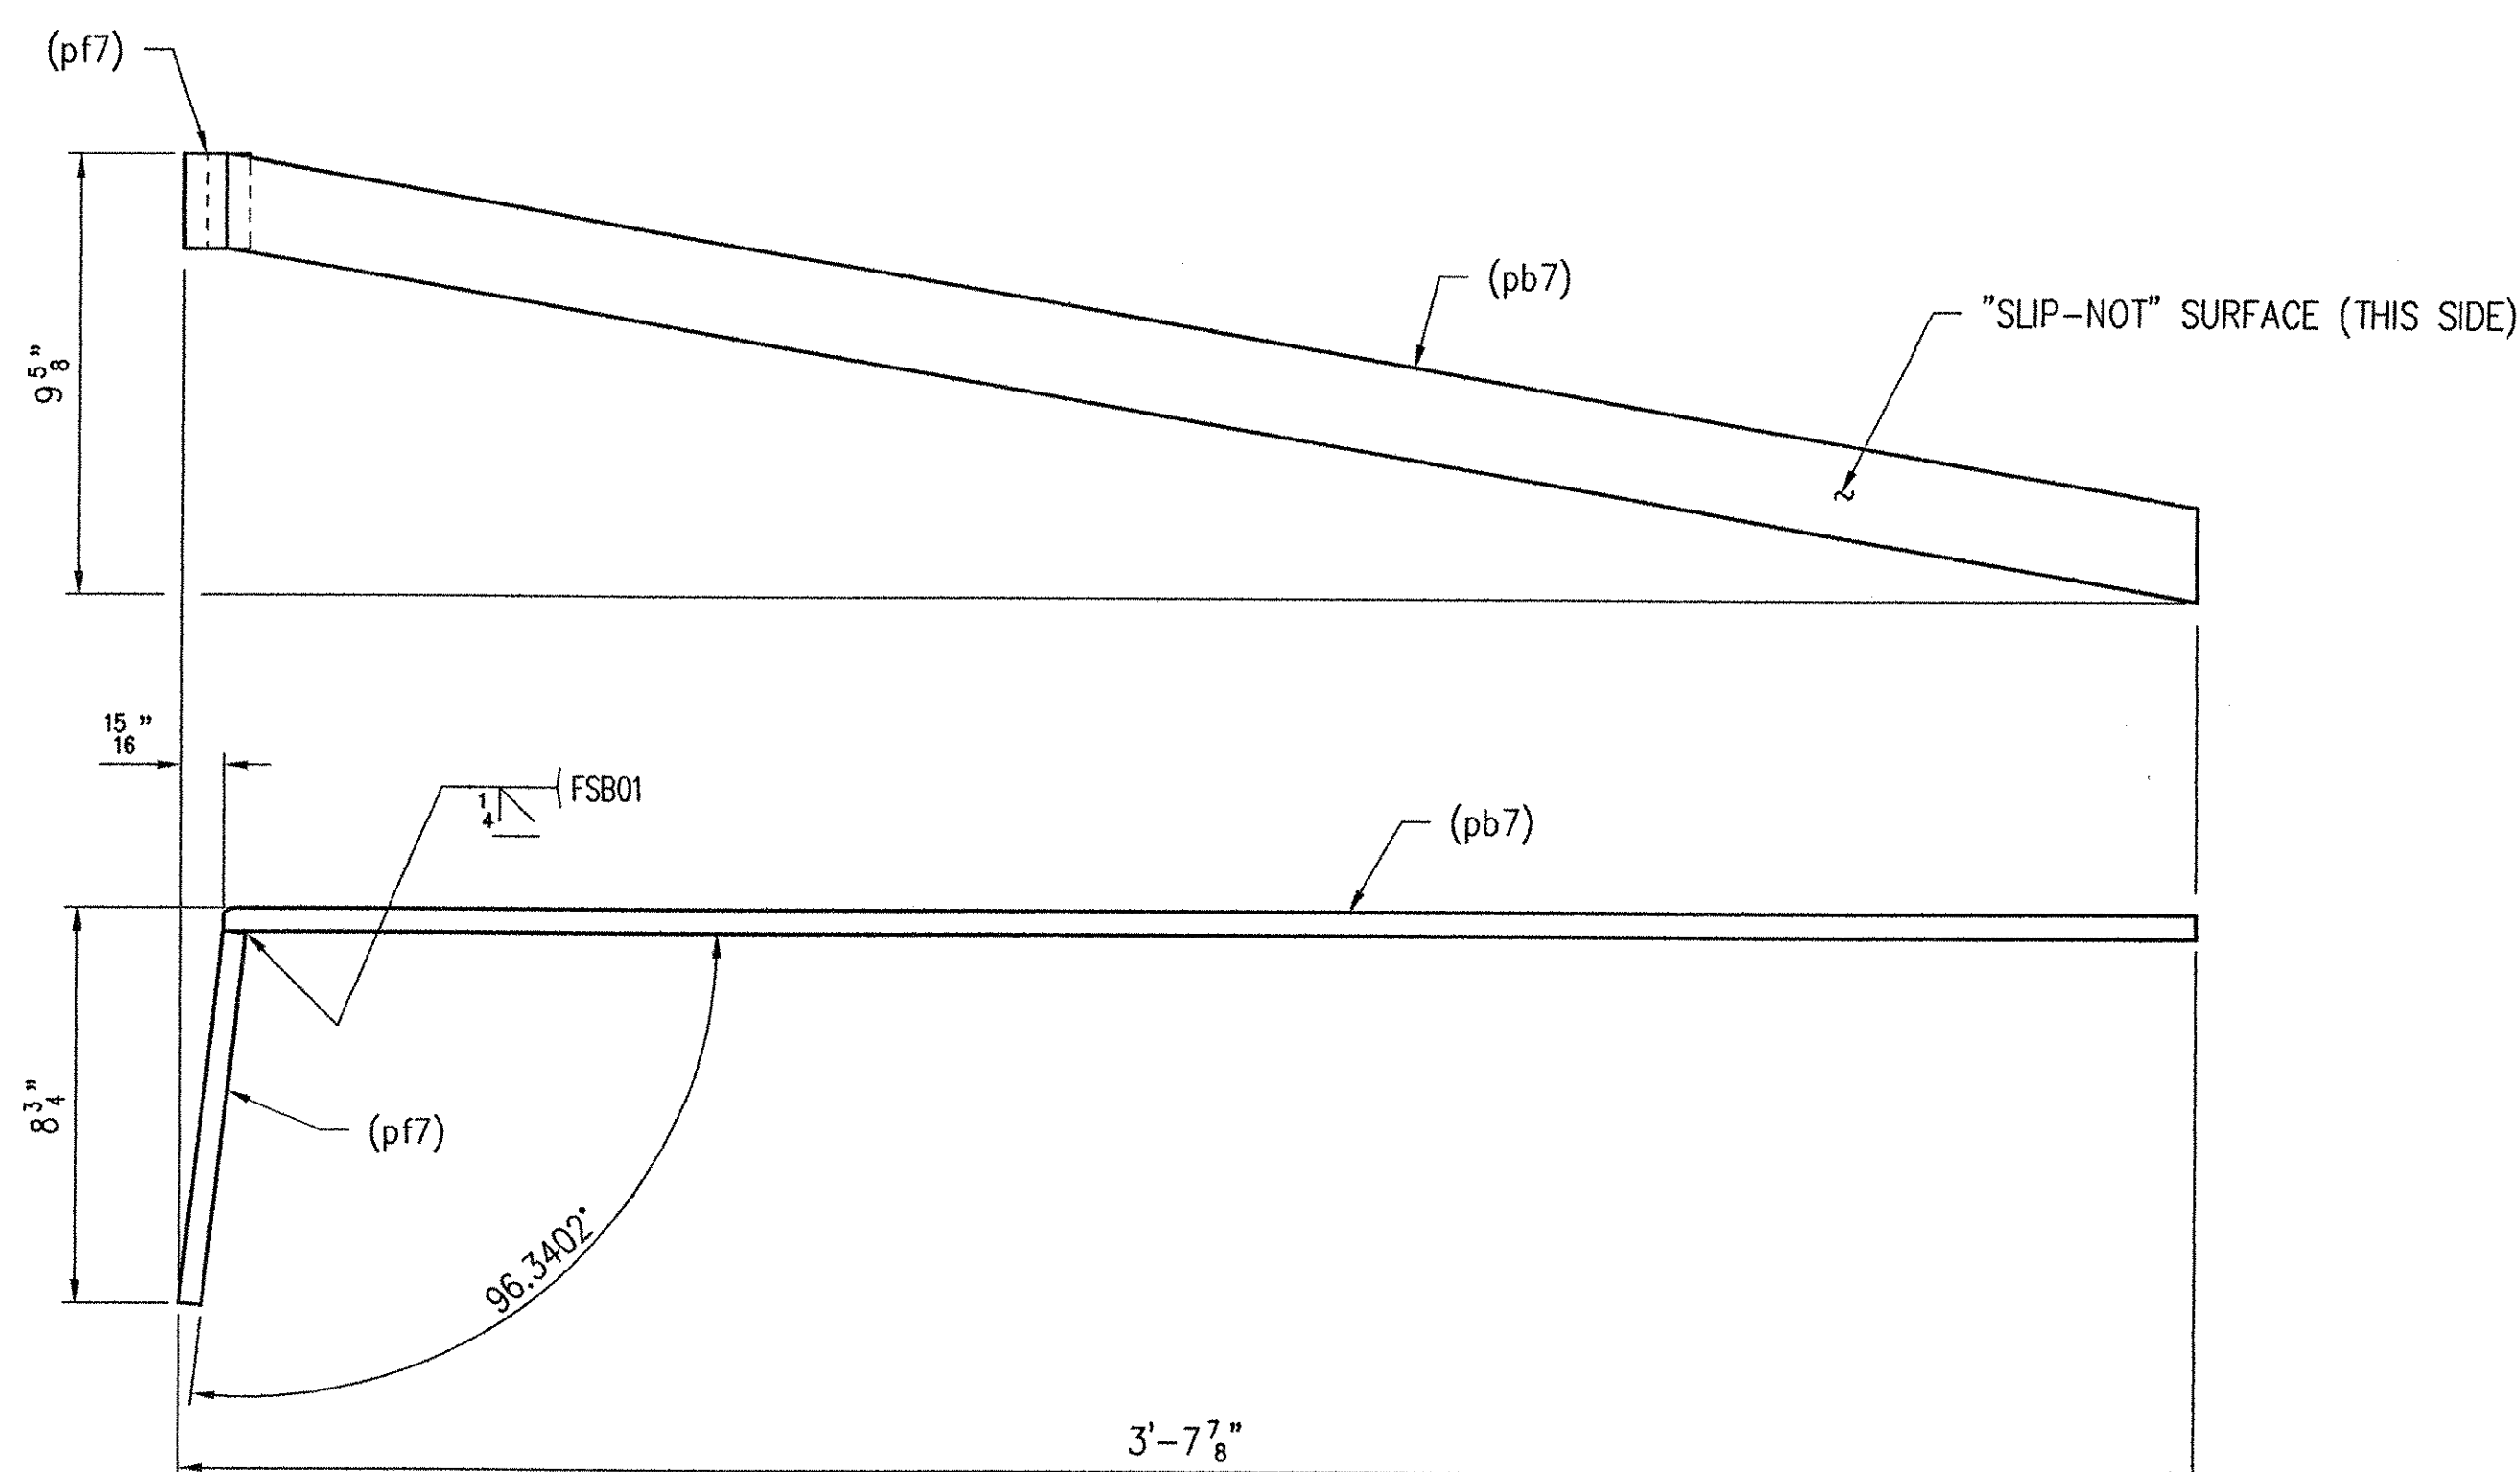

1 - SUB-ASSEMBLY - 4B

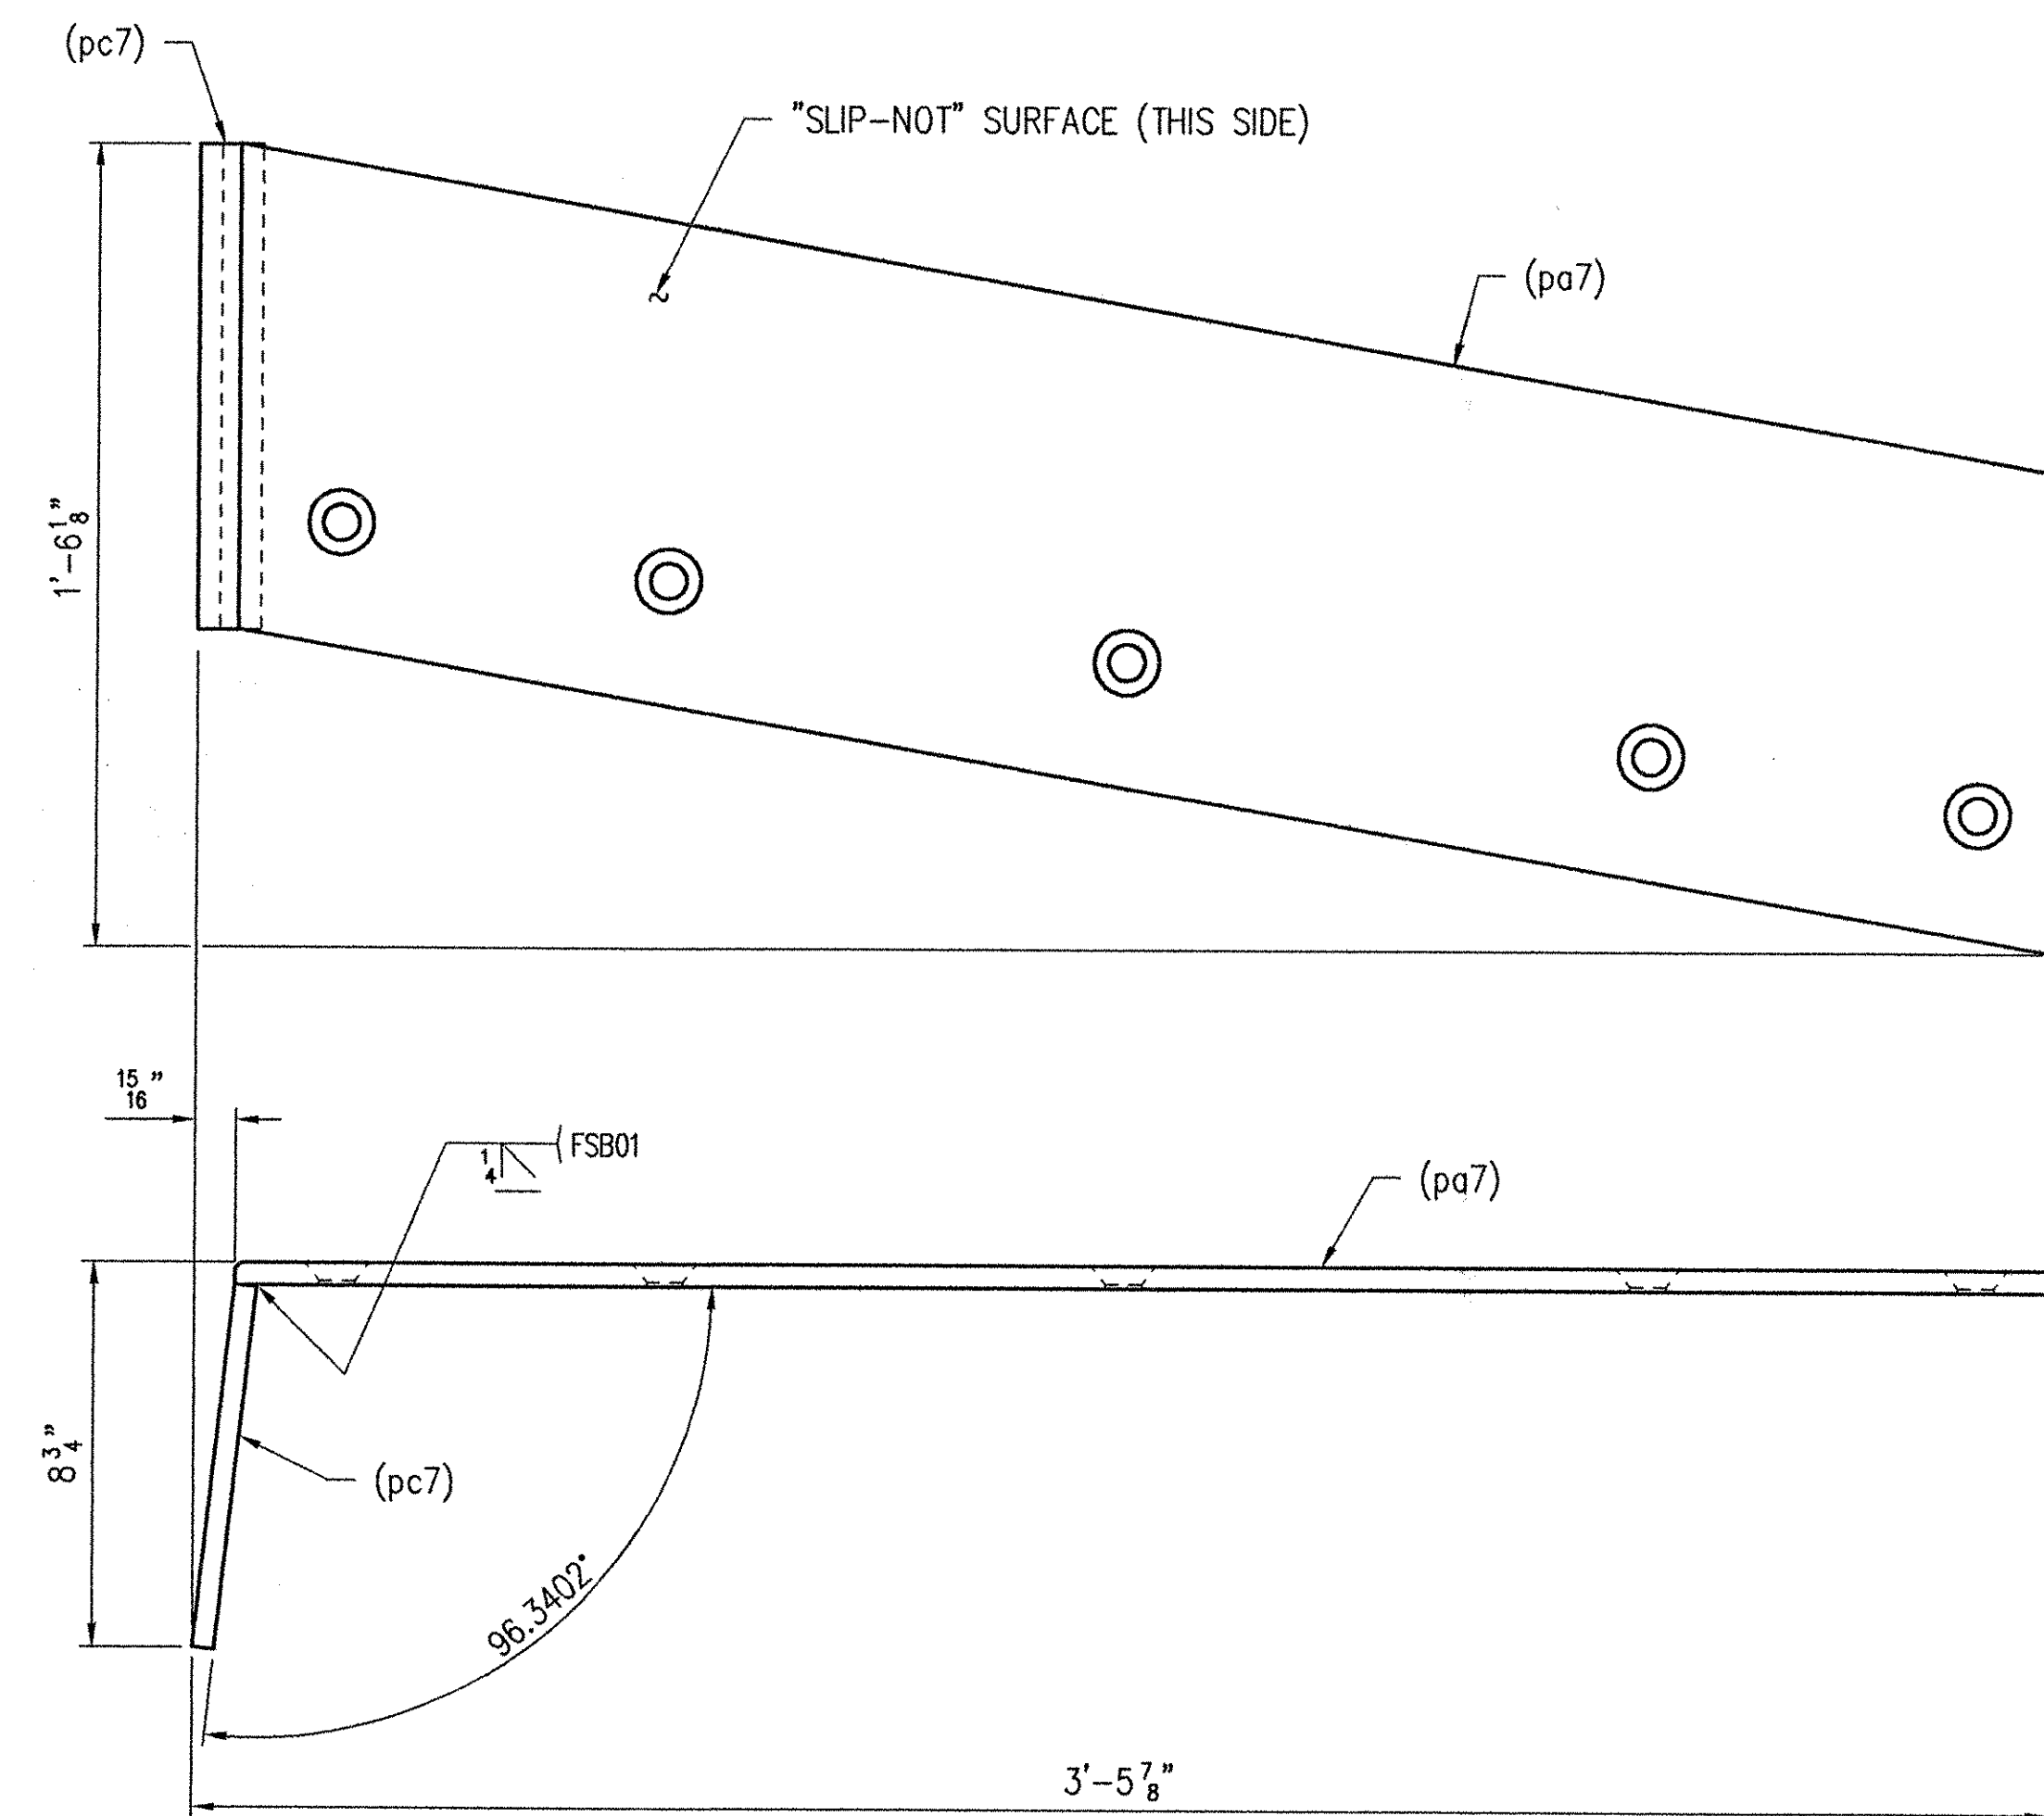

1 - SUB-ASSEMBLY - 4C

SEE SHEET NO. 15 FOR GENERAL NOTES.
WORK THIS SHEET WITH SHEET NO. 3, 5, 6 & 7.

RECEIVED		1/2/02 JMB	
CK'D BY	OK'D BY	DATE	INT.
ANY AND ALL BACKCHARGES WILL BE REJECTED UNLESS WRITTEN CONSENT IS GIVEN BY LEWIS ENGINEERING COMPANY PRIOR TO ANY WORK PERFORMED FOR OUR ACCOUNT. SUCH REJECTION MEANS THAT INVOICES WILL NOT BE HONORED OR DEDUCTIONS FROM PAYMENT WILL BE CHARGED BACK.			
LEWIS ENGINEERING COMPANY 4201 NOREX DRIVE - CHASKA, MINNESOTA 55318 - (952) 368-3000			
PROJECT	ROYALTON / RTE. NO. TH 1, CL 1 BRIDGE NO. 3		
STATE PROJECT	AC BRZ 1444(22)		
FEDERAL PROJECT	-		
CUSTOMER	BECK & BELLUCCI, INC.		
LOCATION	WINDSOR COUNTY, VT		
DESCRIPTION	EXPANSION JOINT DETAILS		
ABUTMENT NO.	2		
W.P. chk'd	Orig.		
Drawn By	JMB		
Chk'd. By	TSF		
Date:	12/5/01		
LE.C. 4 OF 30	SHEET NO. 4 OF 15	Job. No. : 2034.1042.1	

RECEIVED
CK'D BY WDS OK'D BY
JAN 11 2002
RESUBMIT APPROVED
BY apw DATE 1/11/02