




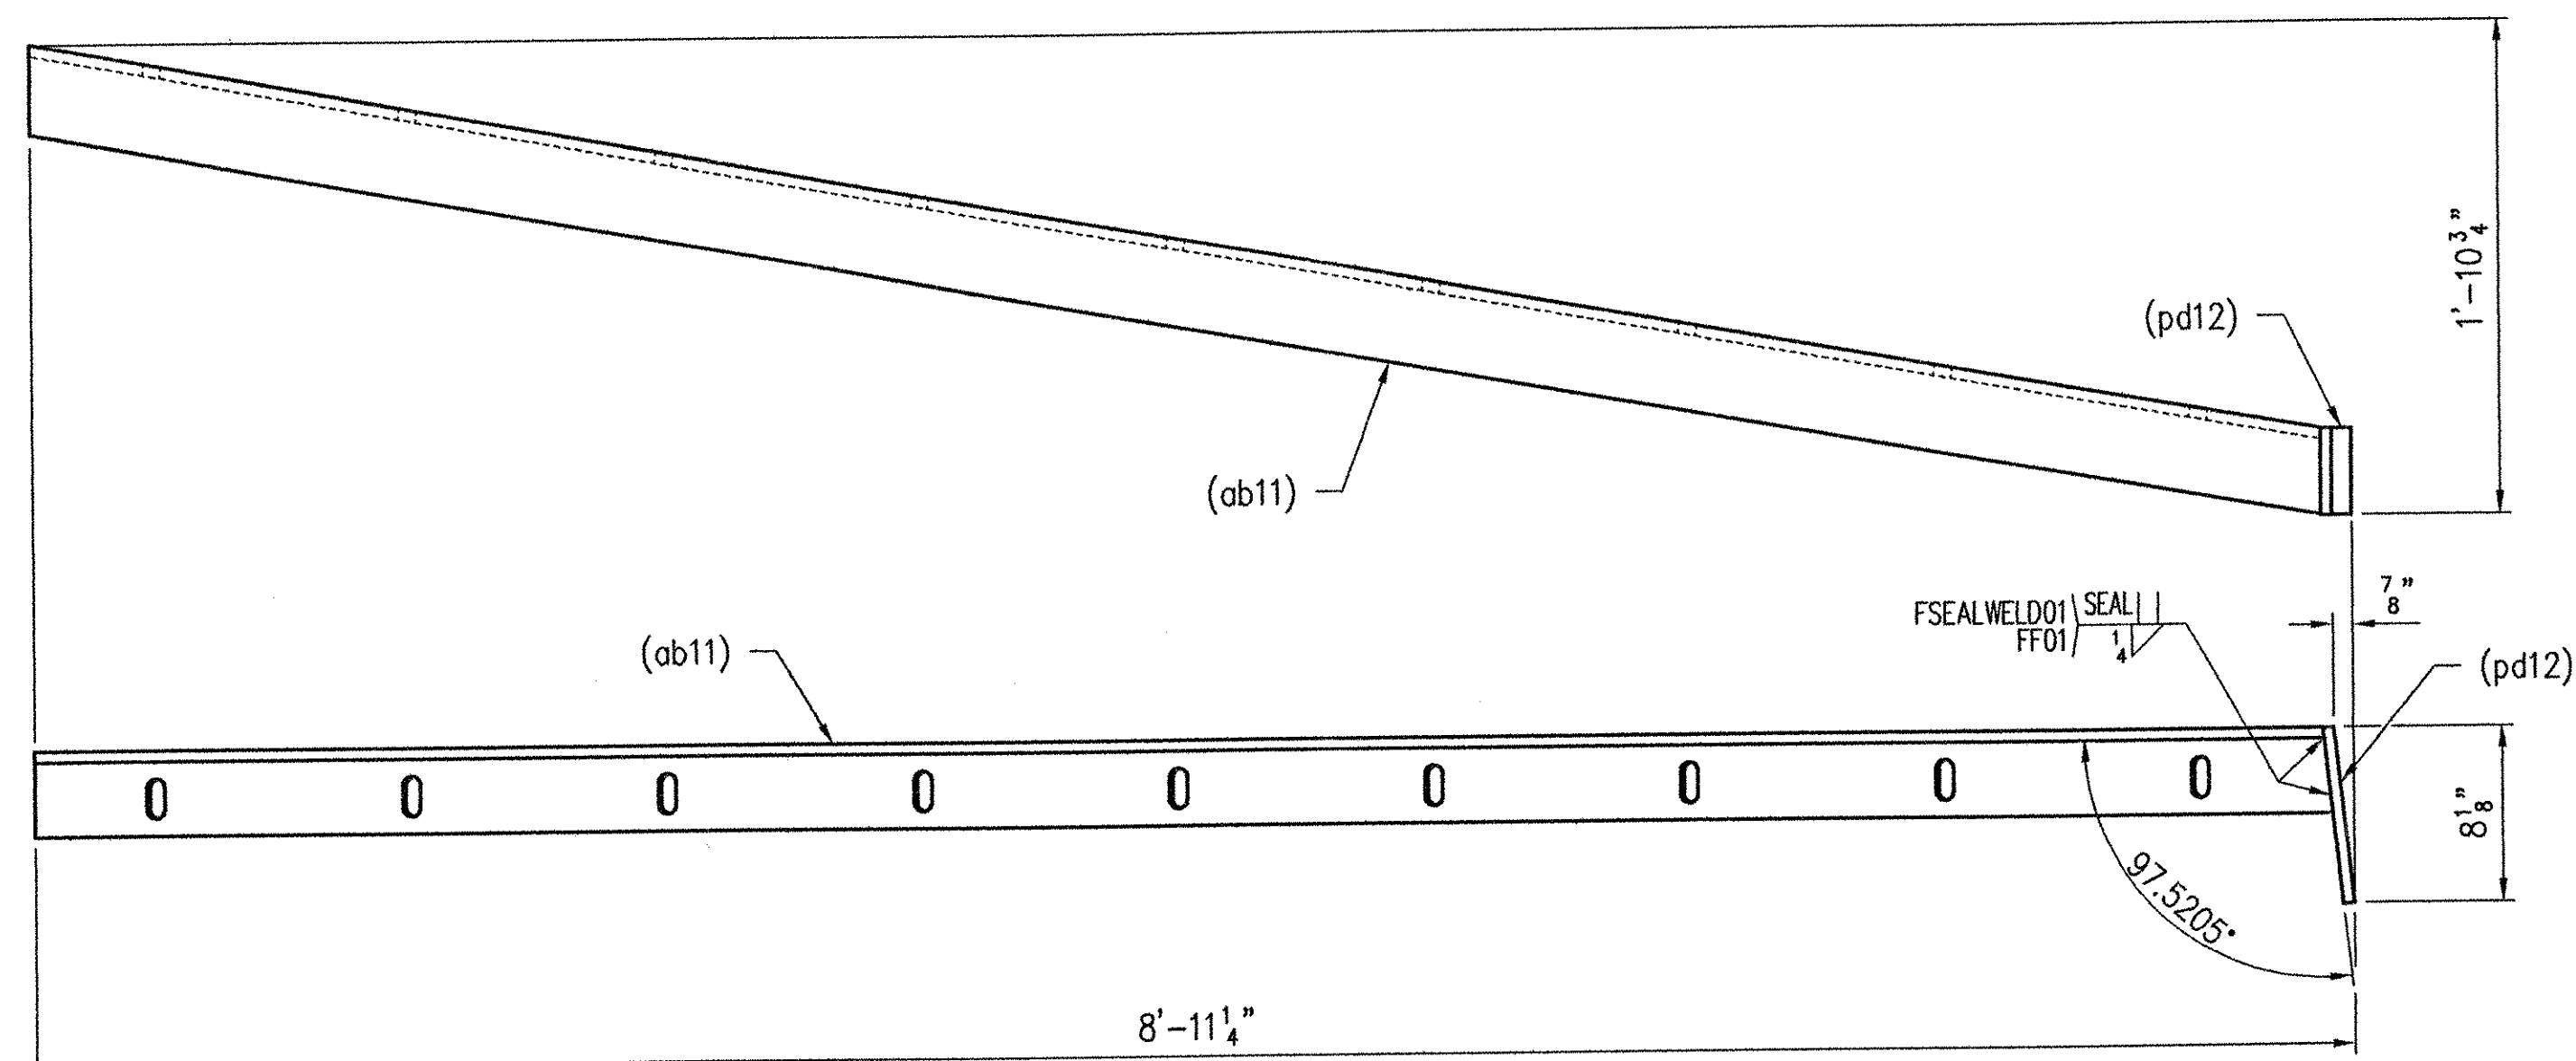

1 - SUB-ASSEMBLY - 9A
(SOME HIDDEN LINES REMOVED FOR CLARITY)

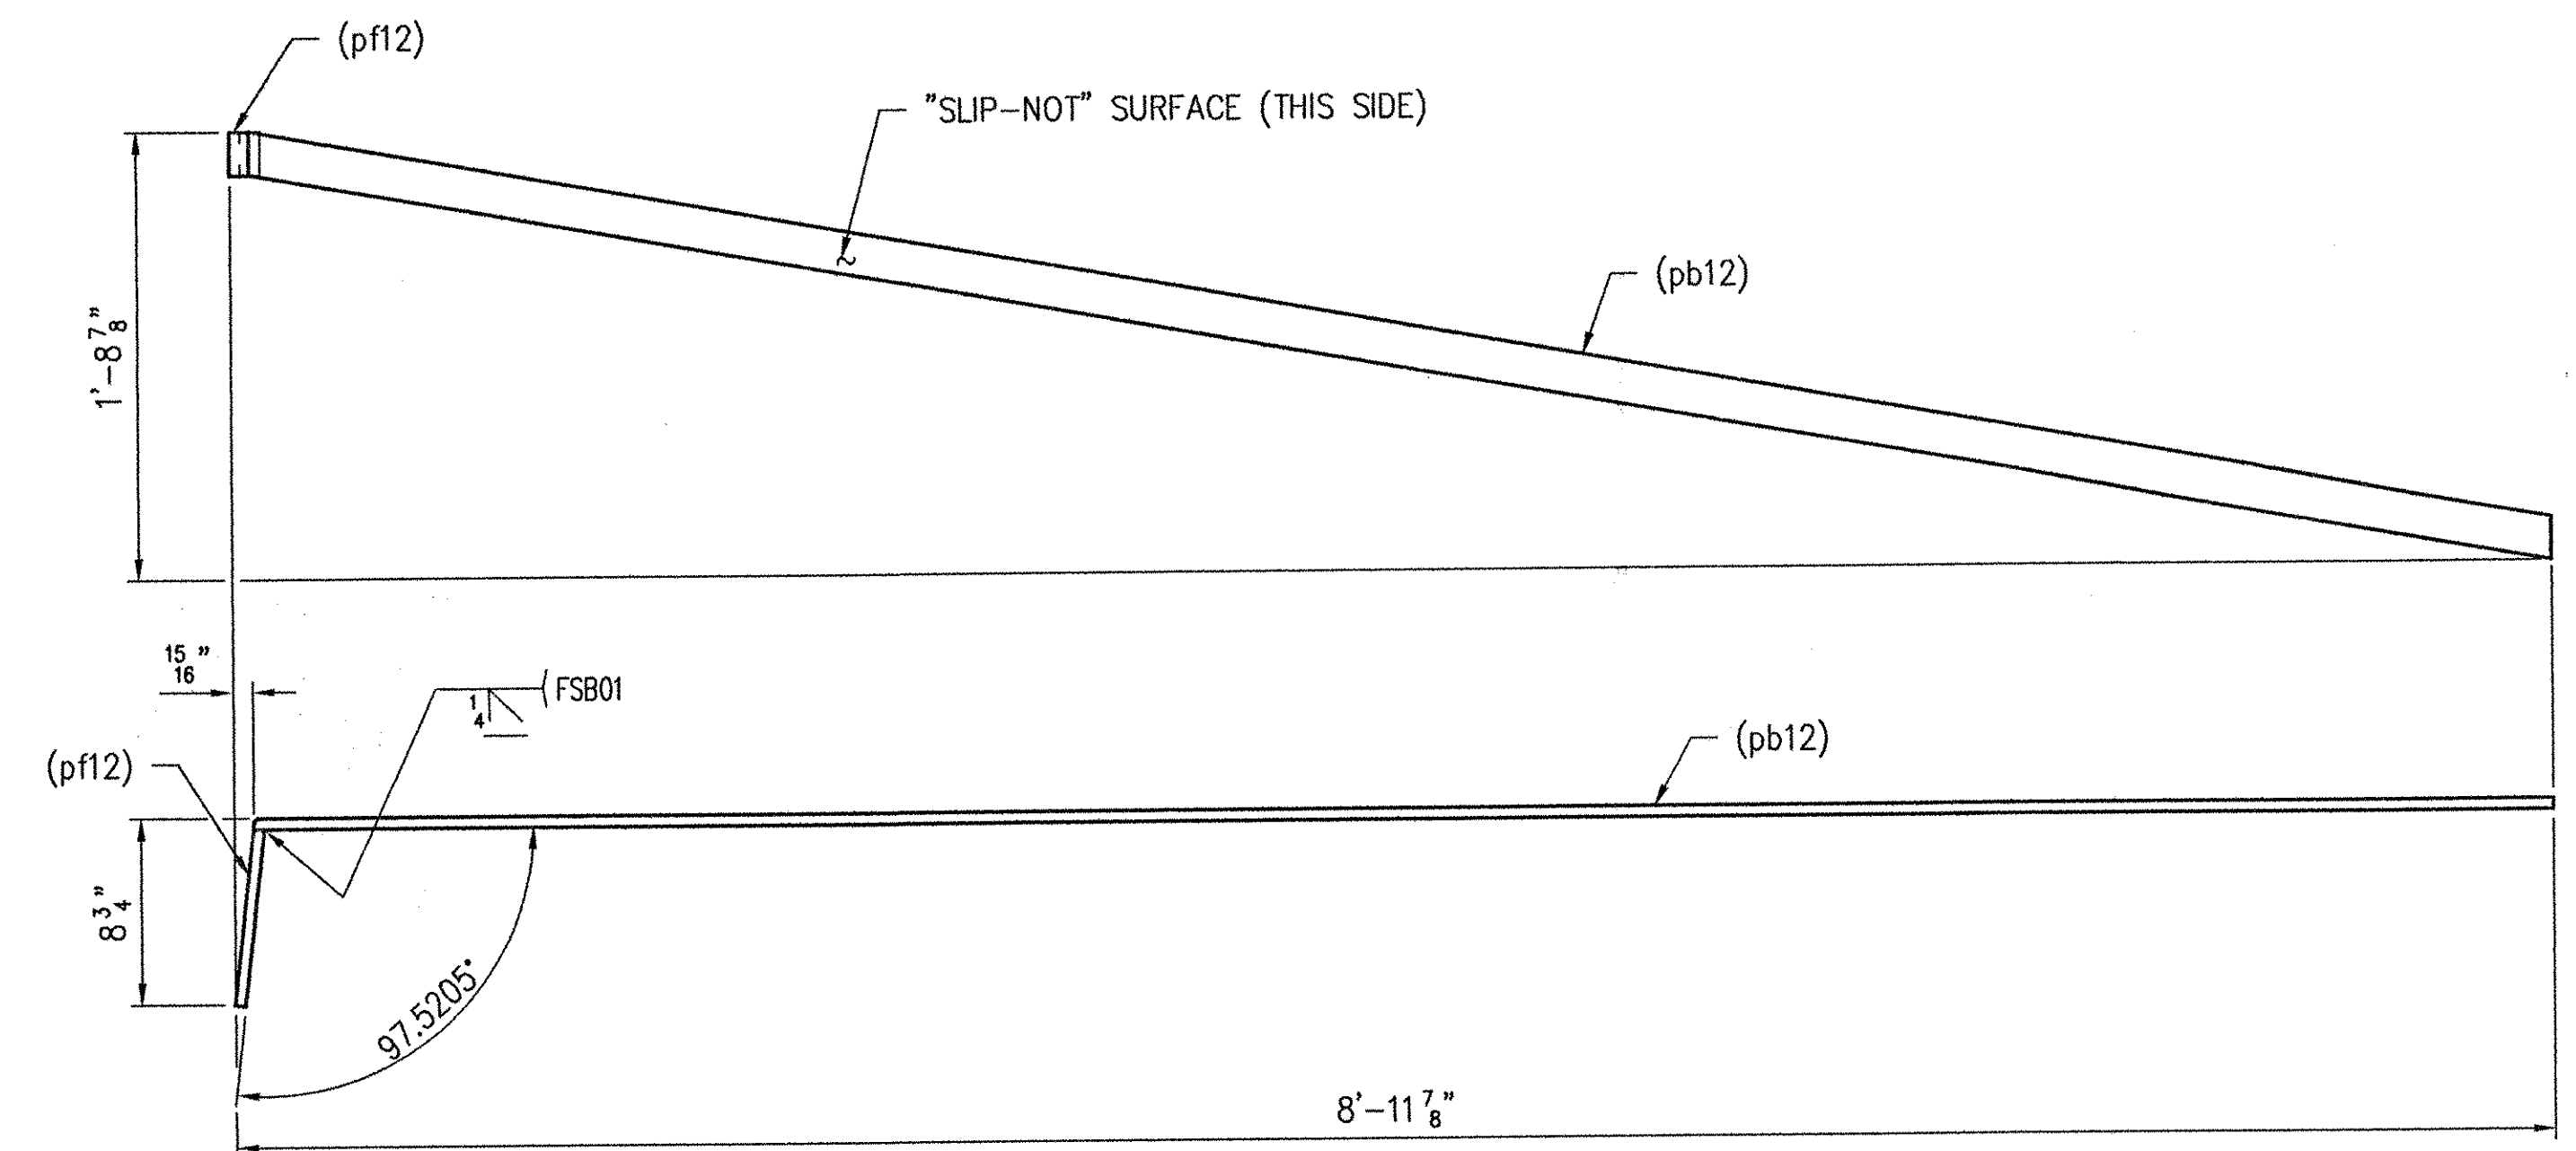

1 - SUB-ASSEMBLY - 9C

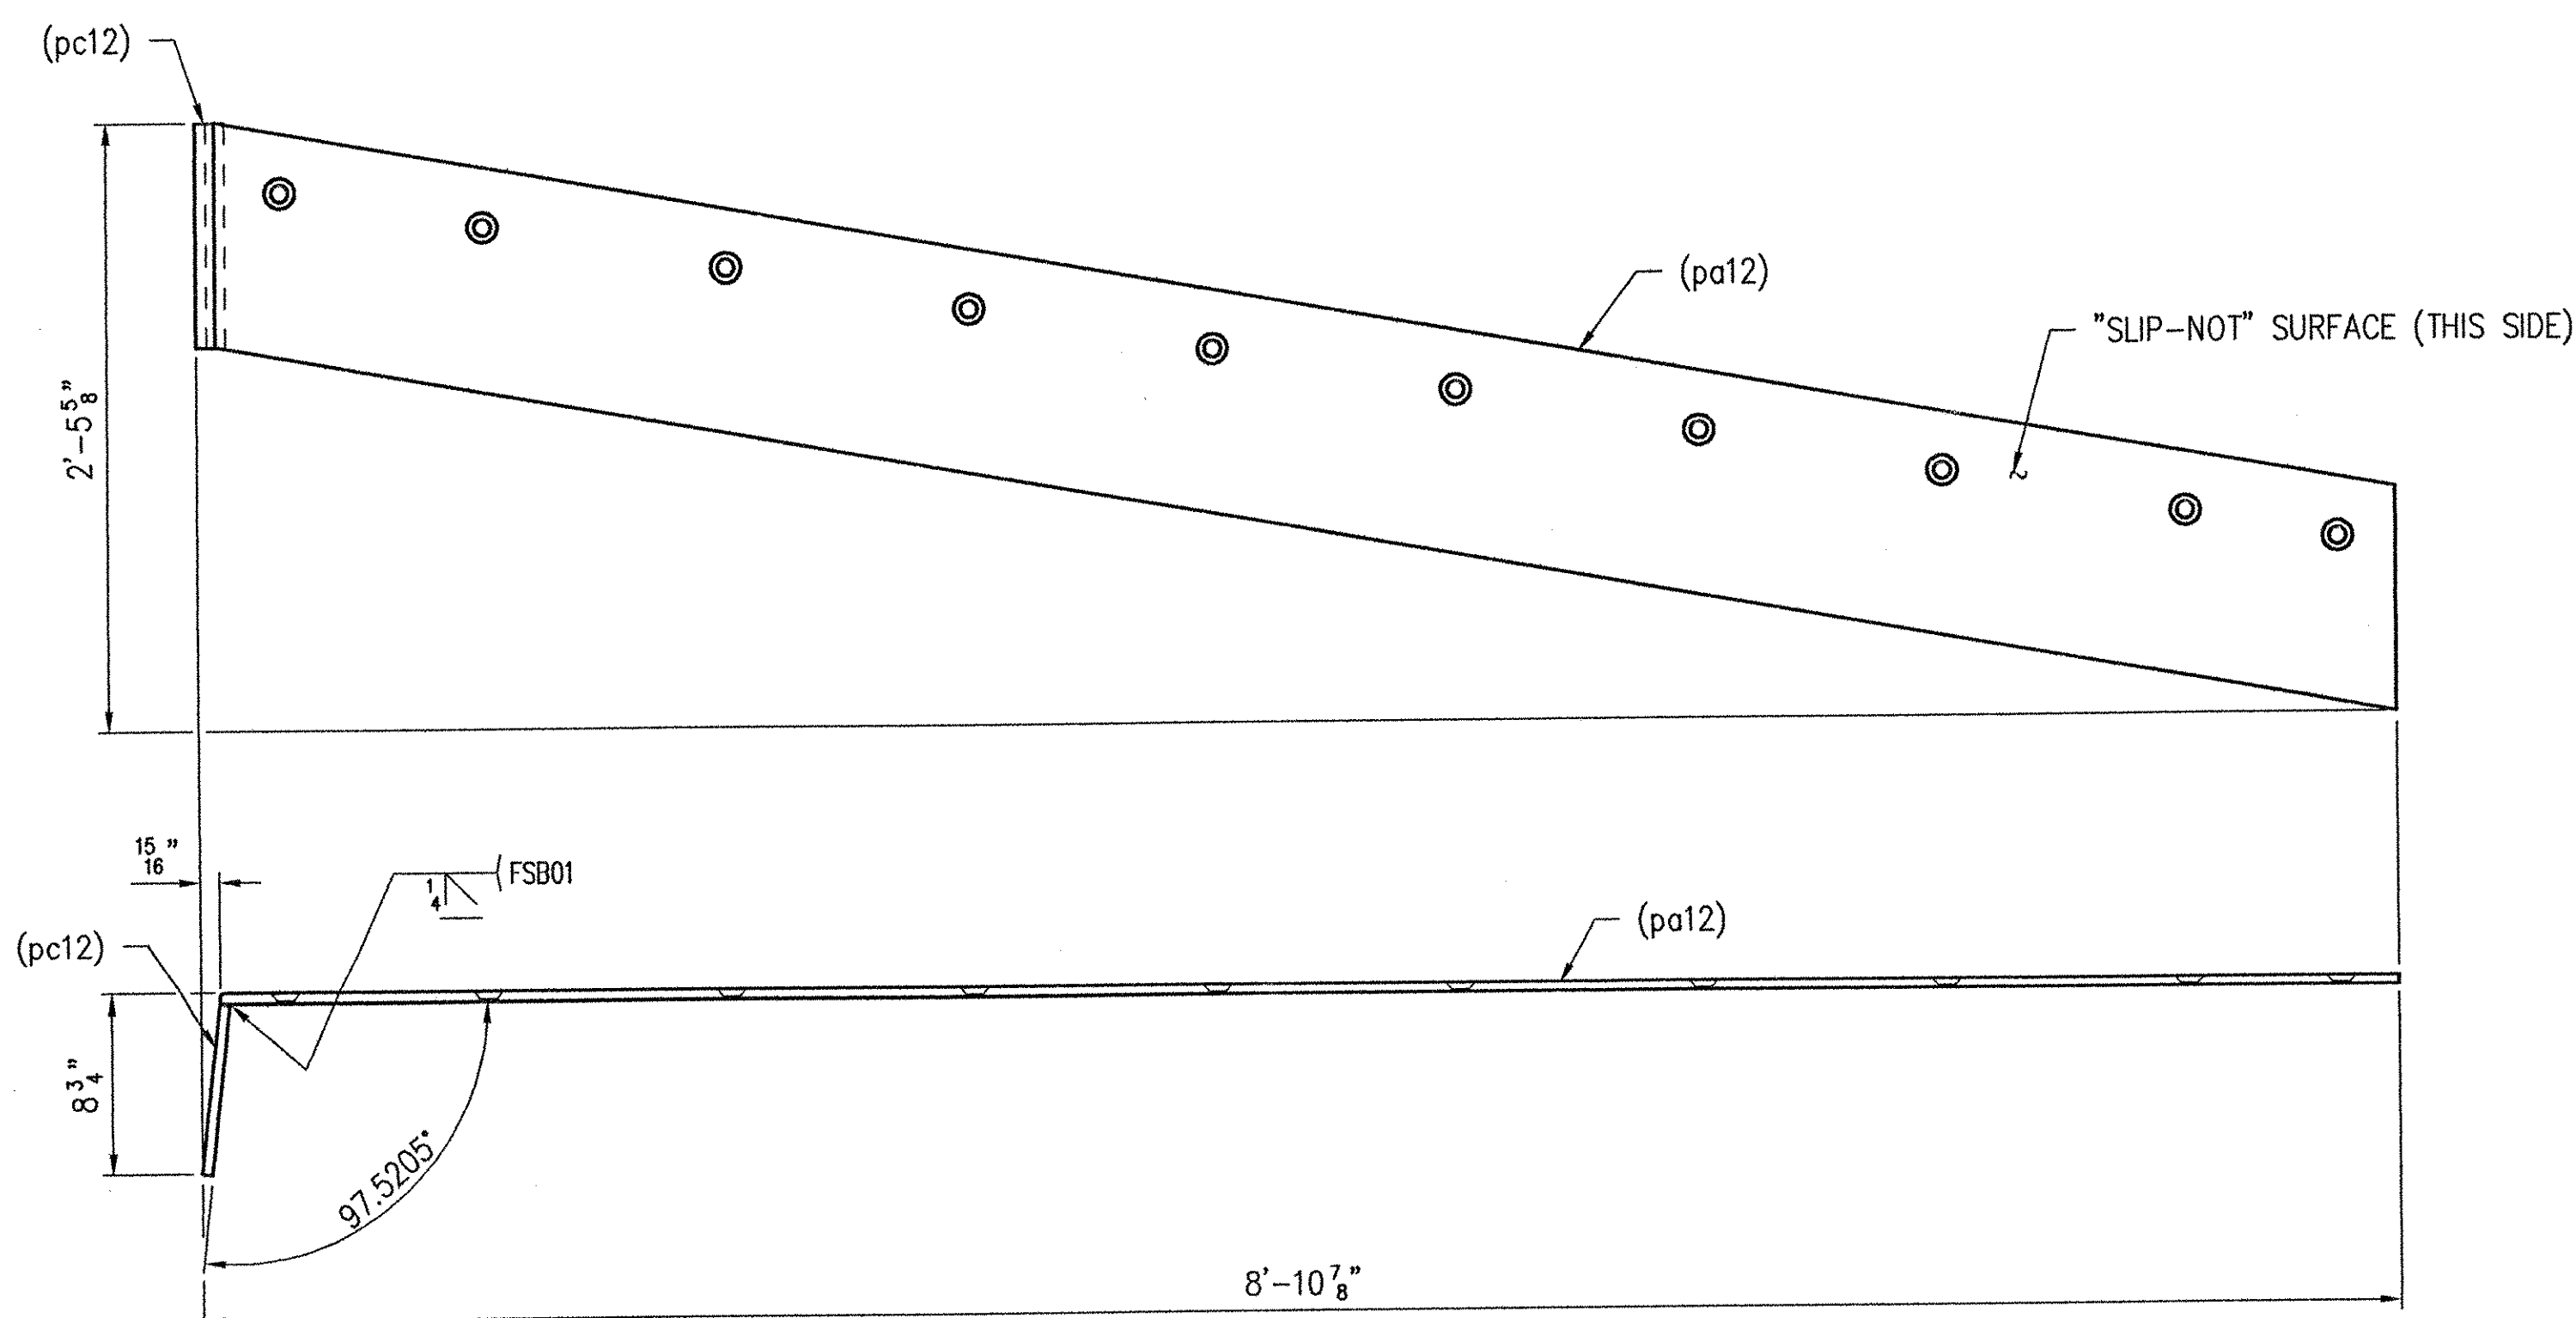

1 - SUB-ASSEMBLY - 9B

SEE SHEET NO. 15 FOR GENERAL NOTES.
WORK THIS SHEET WITH SHEET NO. 8, 10, 11 & 12.

RECEIVED
CHK'D BY WGS OK'D BY
JAN 11 2002
RESUBMIT APPROVED
BY OPW DATE 1/11/02

		GENERAL REVISION PER APPROVAL.		1/3/02	JMB
REV.		DESCRIPTION			DATE INT.
ANY AND ALL BACKCHARGES WILL BE REJECTED UNLESS WRITTEN CONSENT IS GIVEN BY LEWIS ENGINEERING COMPANY PRIOR TO ANY WORK PERFORMED FOR OUR ACCOUNT. SUCH REJECTION MEANS THAT INVOICES WILL NOT BE HONORED OR DEDUCTIONS FROM PAYMENT WILL BE CHARGED BACK.					
					
		LEWIS ENGINEERING COMPANY			
		4201 NOREX DRIVE - CHASKA, MINNESOTA 55318 - (952) 368-3000			
SHOP		PROJECT — ROYALTON / RTE. NO. TH 1, CL 1 BRIDGE NO. 3			
		STATE PROJECT — AC BRZ 1444(22)			
		FEDERAL PROJECT —			
APPROVAL		CUSTOMER — BECK & BELLUCCI, INC.			
		LOCATION — WINDSOR COUNTY, VT			
DIST.		DESCRIPTION — EXPANSION JOINT DETAILS			
		ABUTMENT NO. 2			
CUST.		W.P. chkd Drawn By JMB Chk'd. By TSF Date: 12/5/01			
FOR DATE					
PRINTS ISSUED					
		L.E.C. 9 OF 30		SHEET NO. 9 OF 15	
		Job. No. : 2034.1042.1			

W.P. chkd
Drawn By JMB
Chkd. By TSF
Date: 12/5/01