


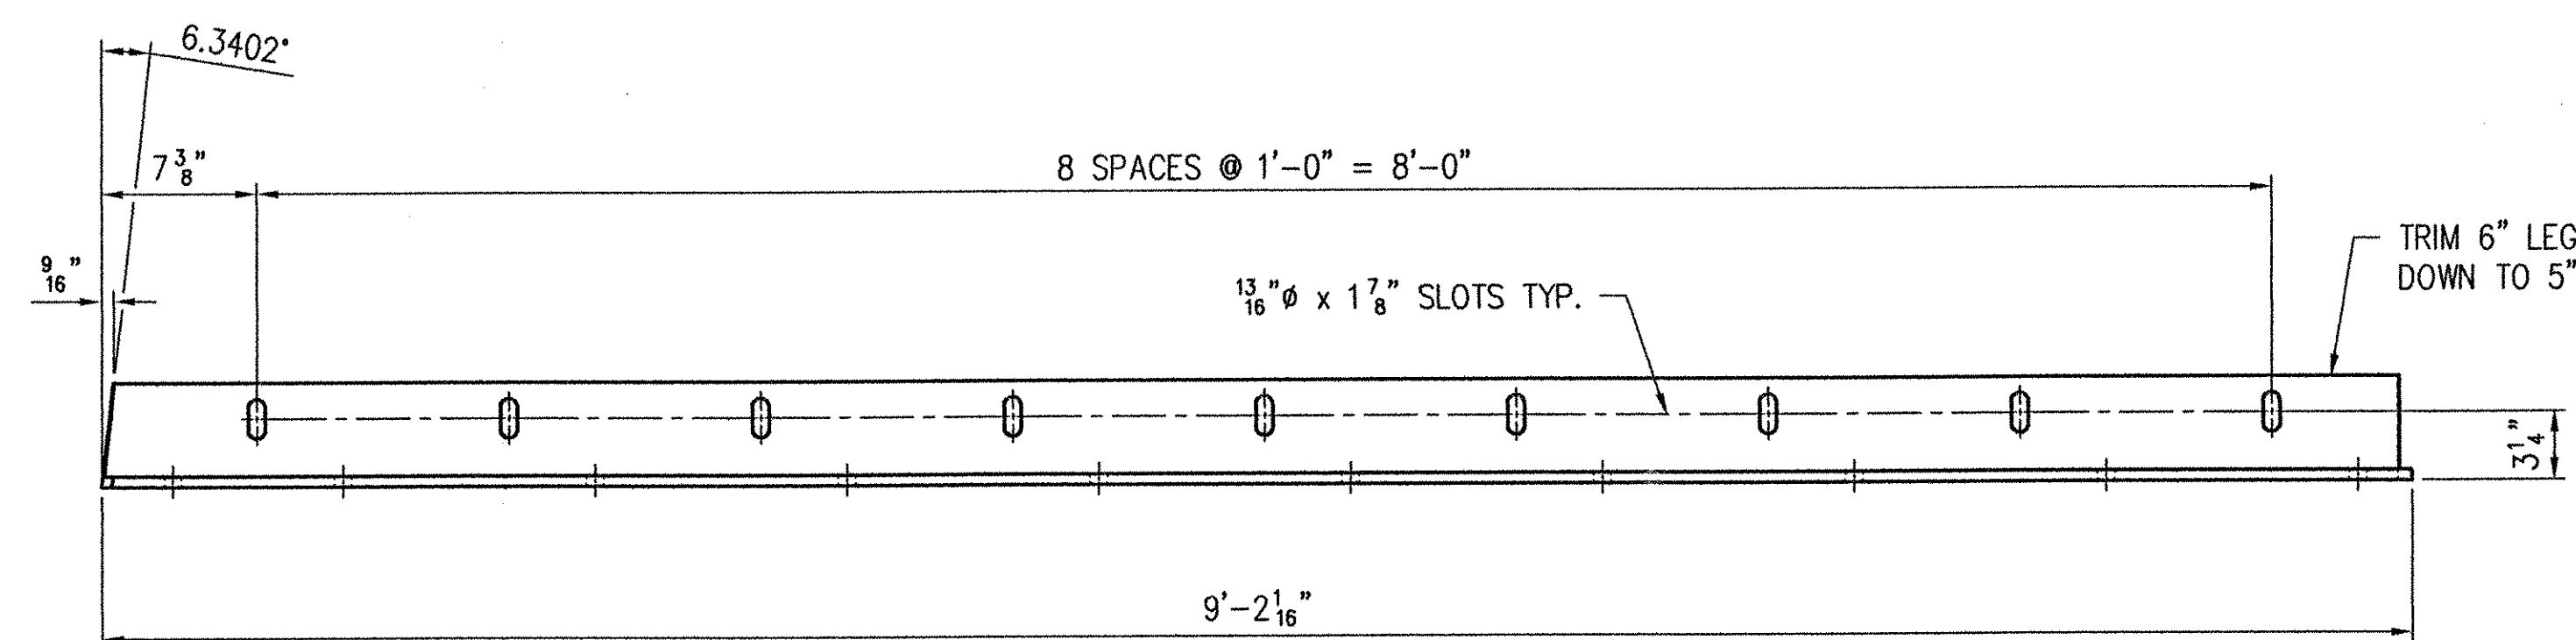
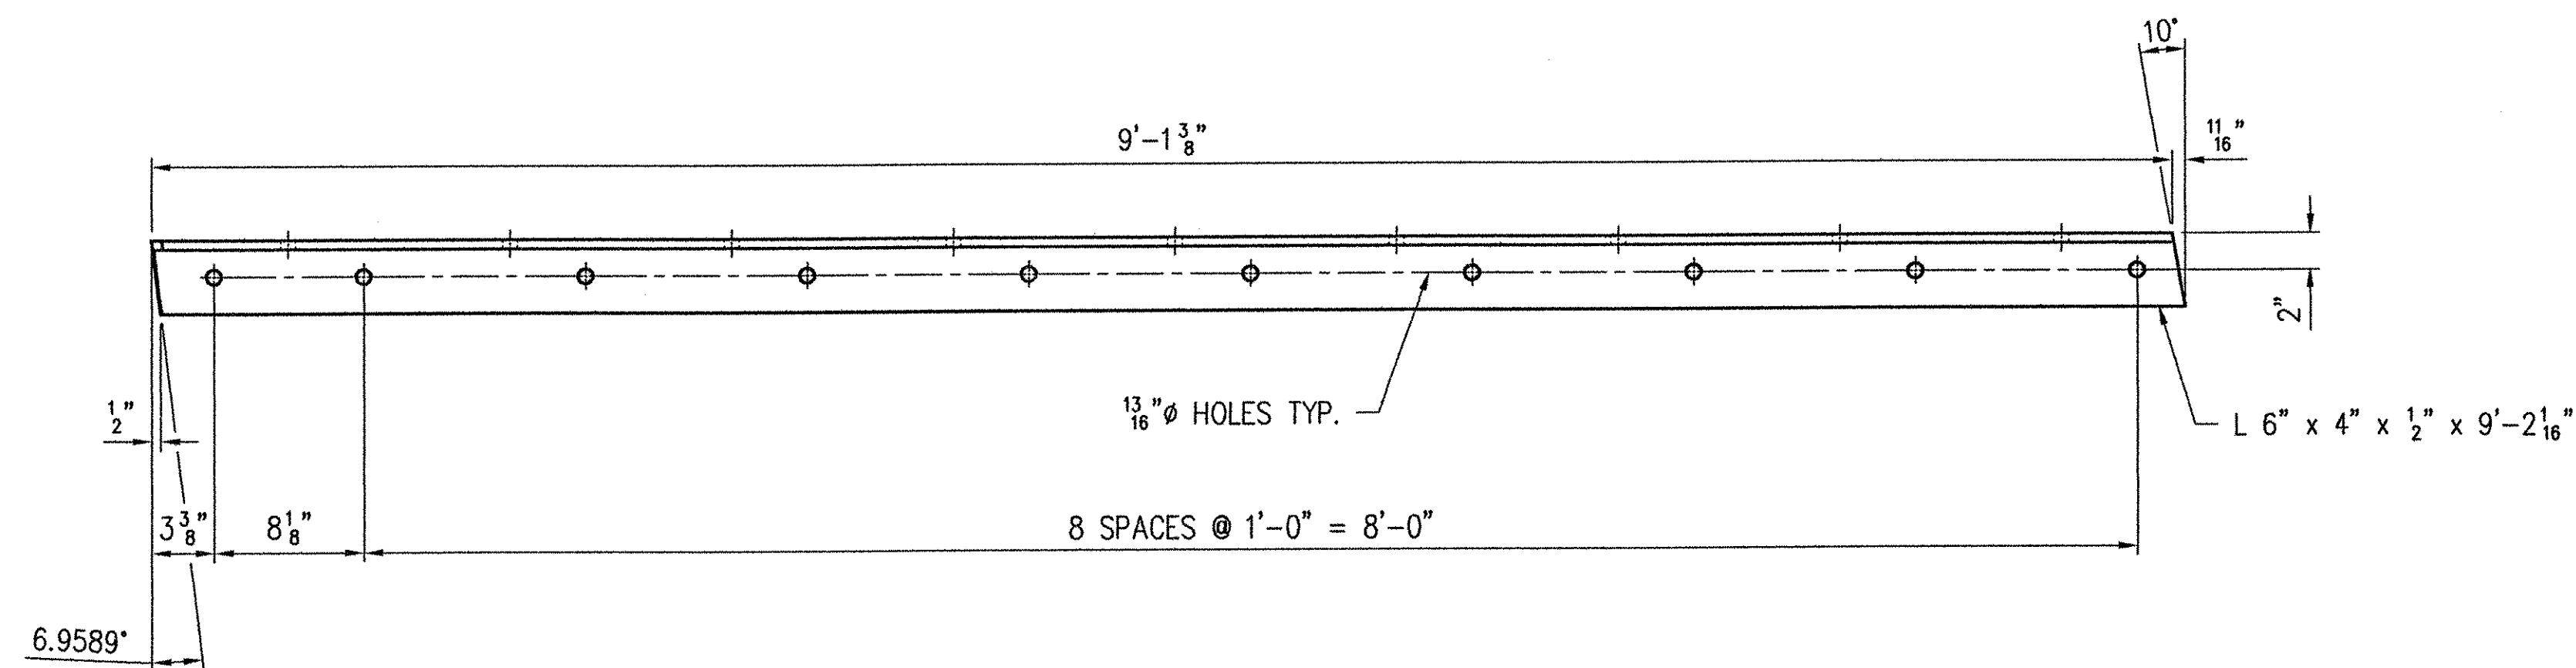
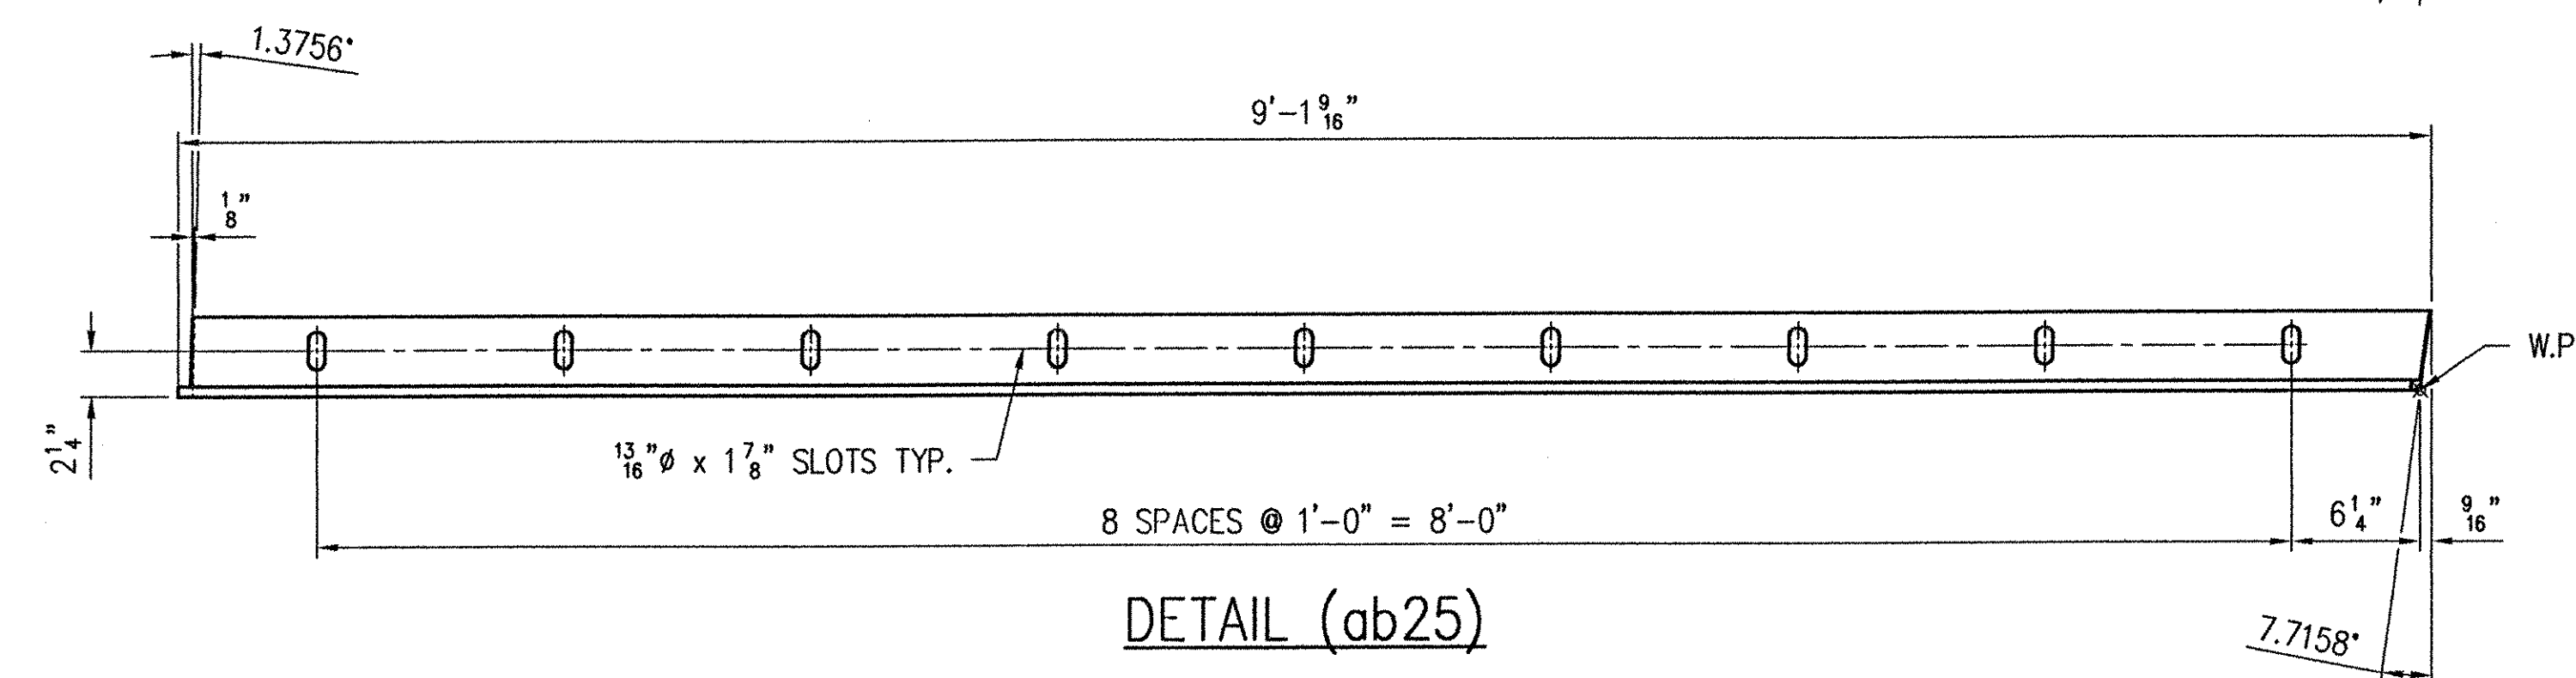


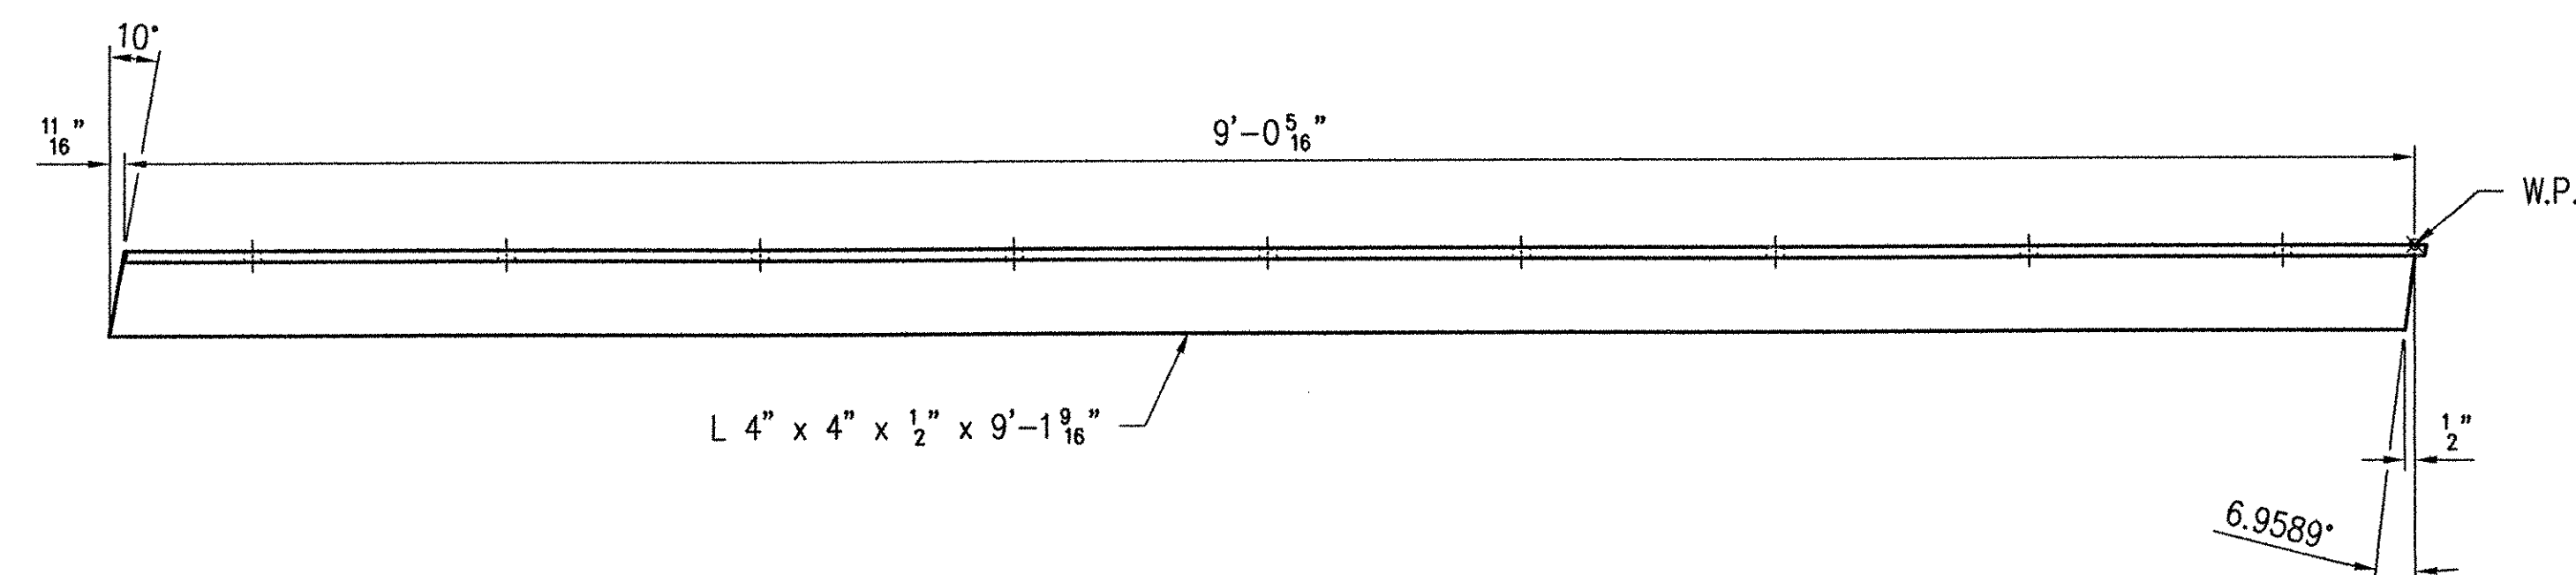

DETAIL (aa25)

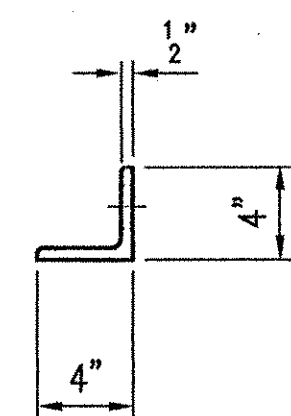


DETAIL (ab25)

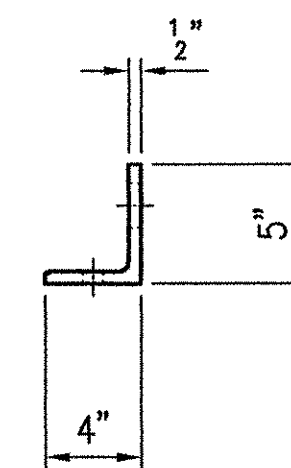

RECEIVED
CHK'D BY LJS OK'D BY
JAN 21 2002
RESUBMIT APPROVED
BY CPW DATE 1/24/02

SEE SHEET NO. 30 FOR GENERAL NOTES.
WORK THIS SHEET WITH SHEET NO. 23, 24, 26 & 27.

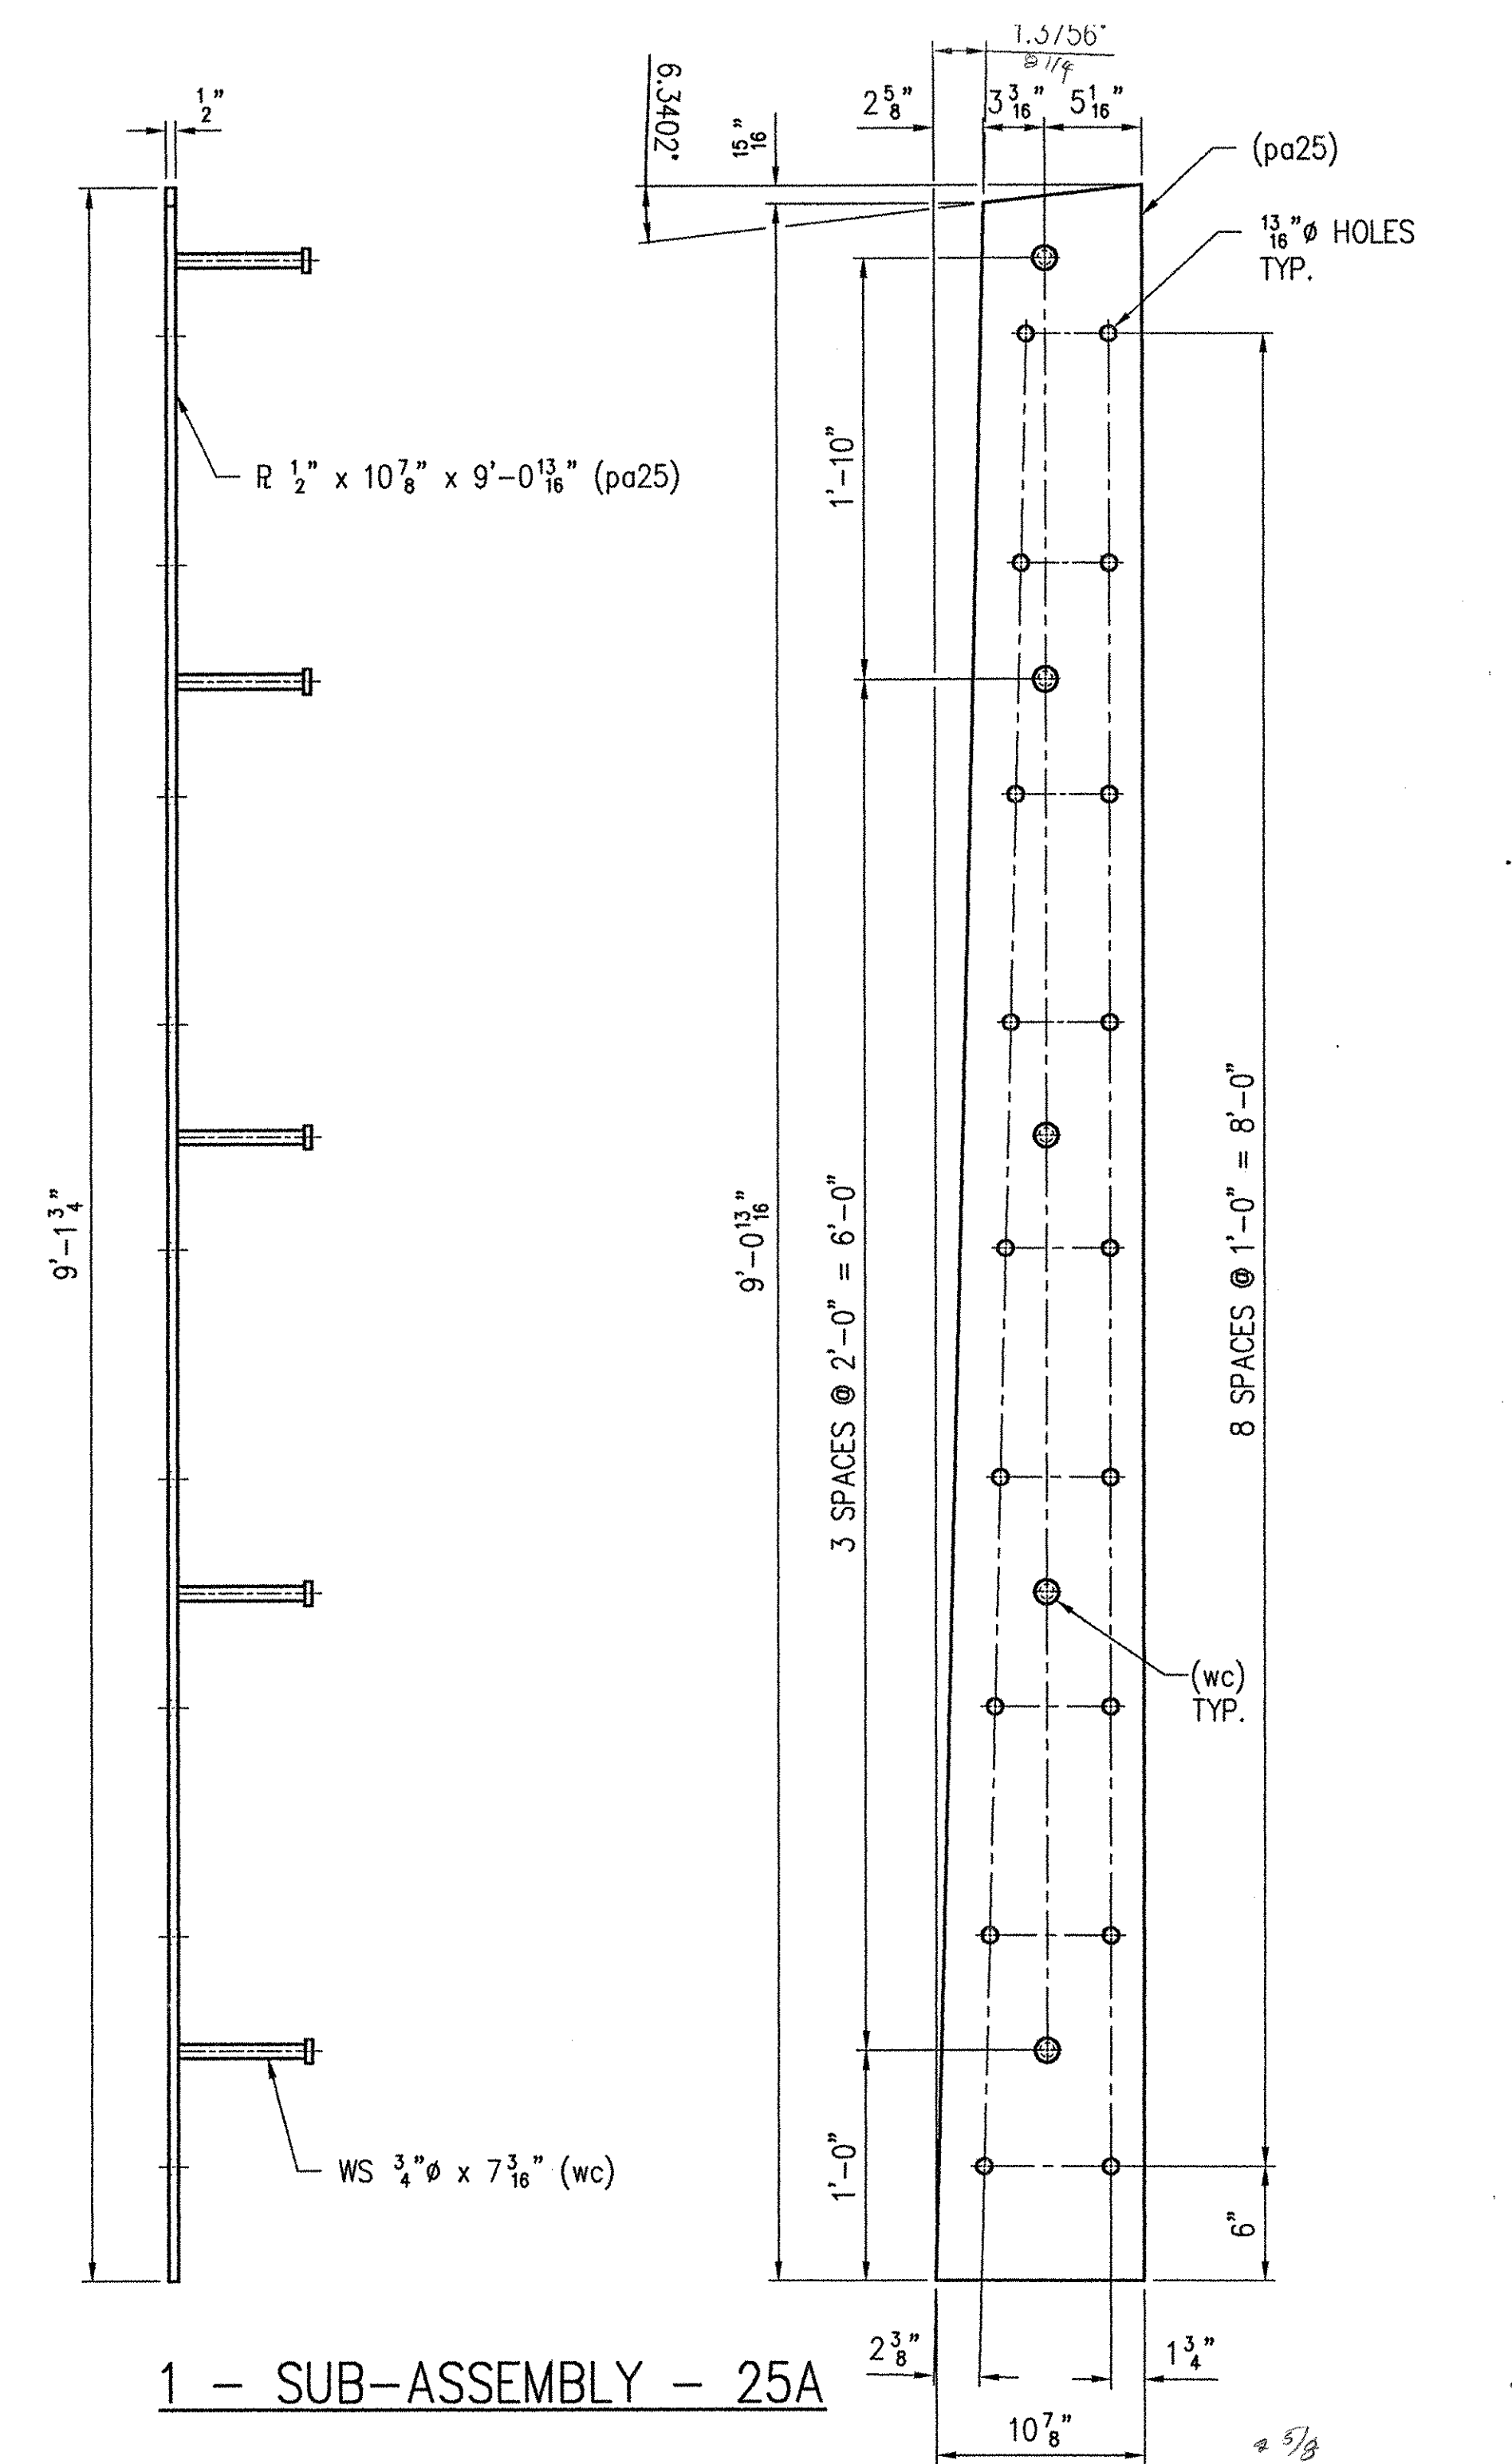

REV.	DESCRIPTION	DATE
	ANY AND ALL BACKCHARGES WILL BE REJECTED UNLESS WRITTEN CONSENT IS GIVEN BY LEWIS ENGINEERING COMPANY PRIOR TO ANY WORK PERFORMED FOR OUR ACCOUNT. SUCH REJECTION MEANS THAT INVOICES WILL NOT BE HONORED OR DEDUCTIONS FROM PAYMENT WILL BE CHARGED BACK	
LEWIS ENGINEERING COMPANY 4201 NOREX DRIVE - CHASKA, MINNESOTA 55318 - (952) 368-3000		
SHOP	PROJECT - ROYALTON / RTE. NO. TH 1, CL 1 BRIDGE NO. 3	
	STATE PROJECT - AC BRZ 1444(22)	
	FEDERAL PROJECT -	
APPROVAL	CUSTOMER - BECK & BELLUCCI, INC.	
	LOCATION - WINDSOR COUNTY, VT	
DIST.	DESCRIPTION - EXPANSION JOINT DETAILS	
CUST.	ABUTMENT NO. 1	
FOR DATE		
PRINTS ISSUED		
L.E.C. 25 OF 30	SHEET NO. 10 OF 15	Job. No. : 2034.1042

Orig
W.P. chk'd
Drawn By JMB
Chk'd. By TSF
Date: 12/20/01