


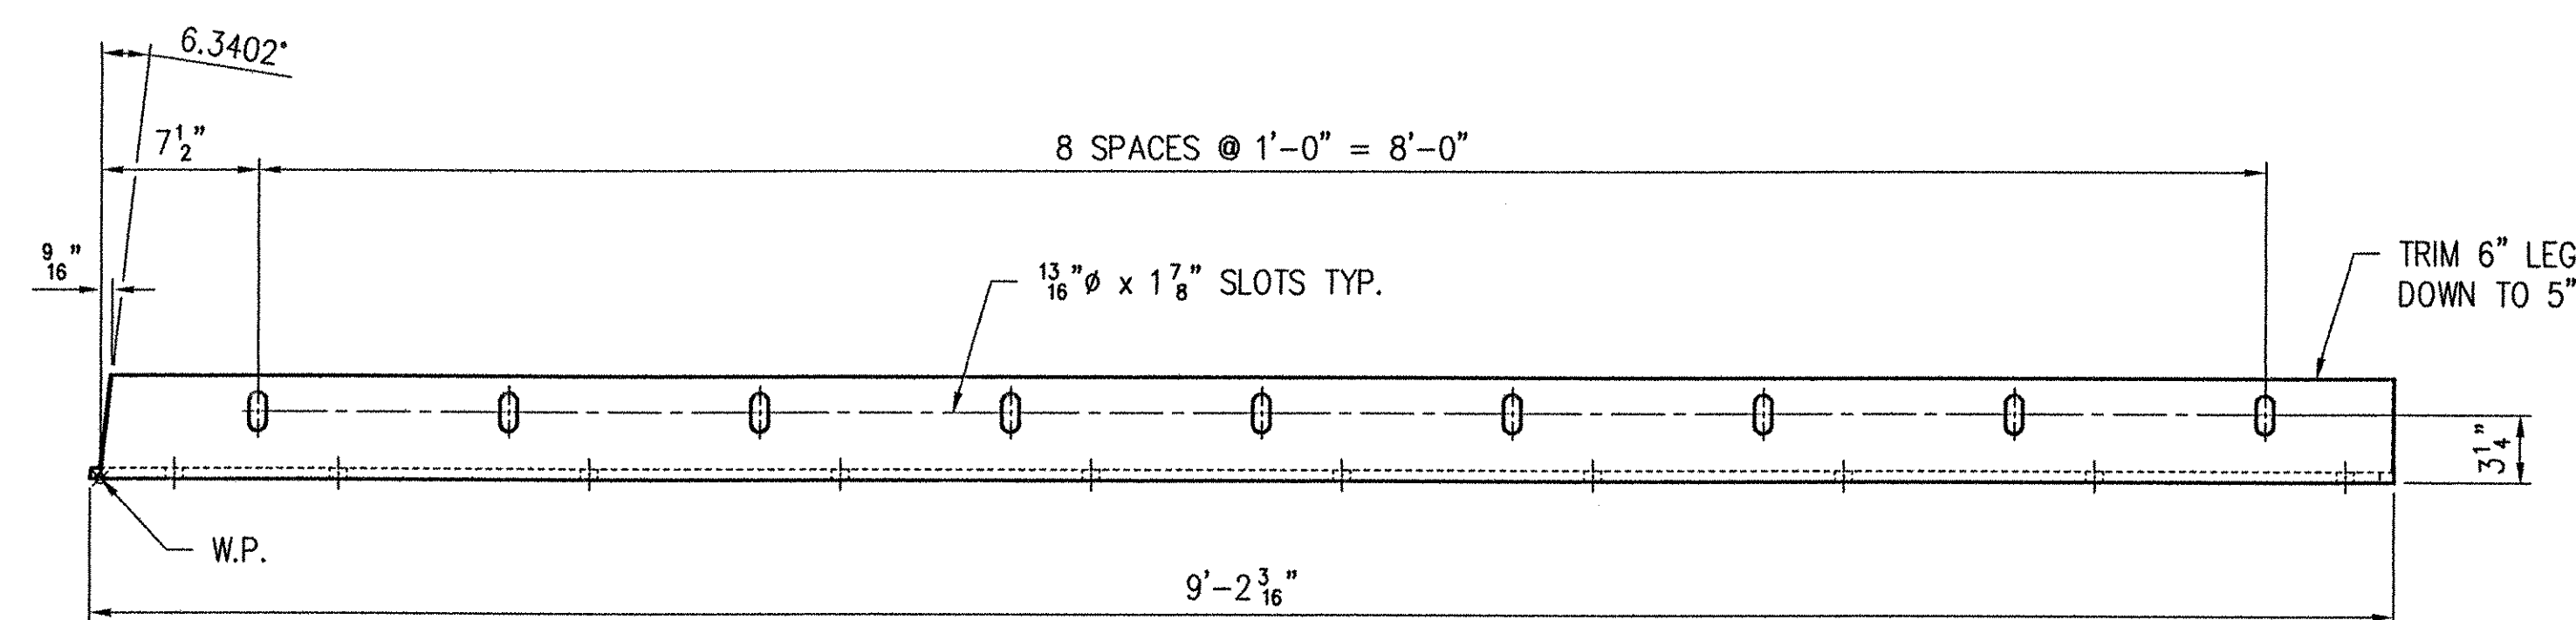
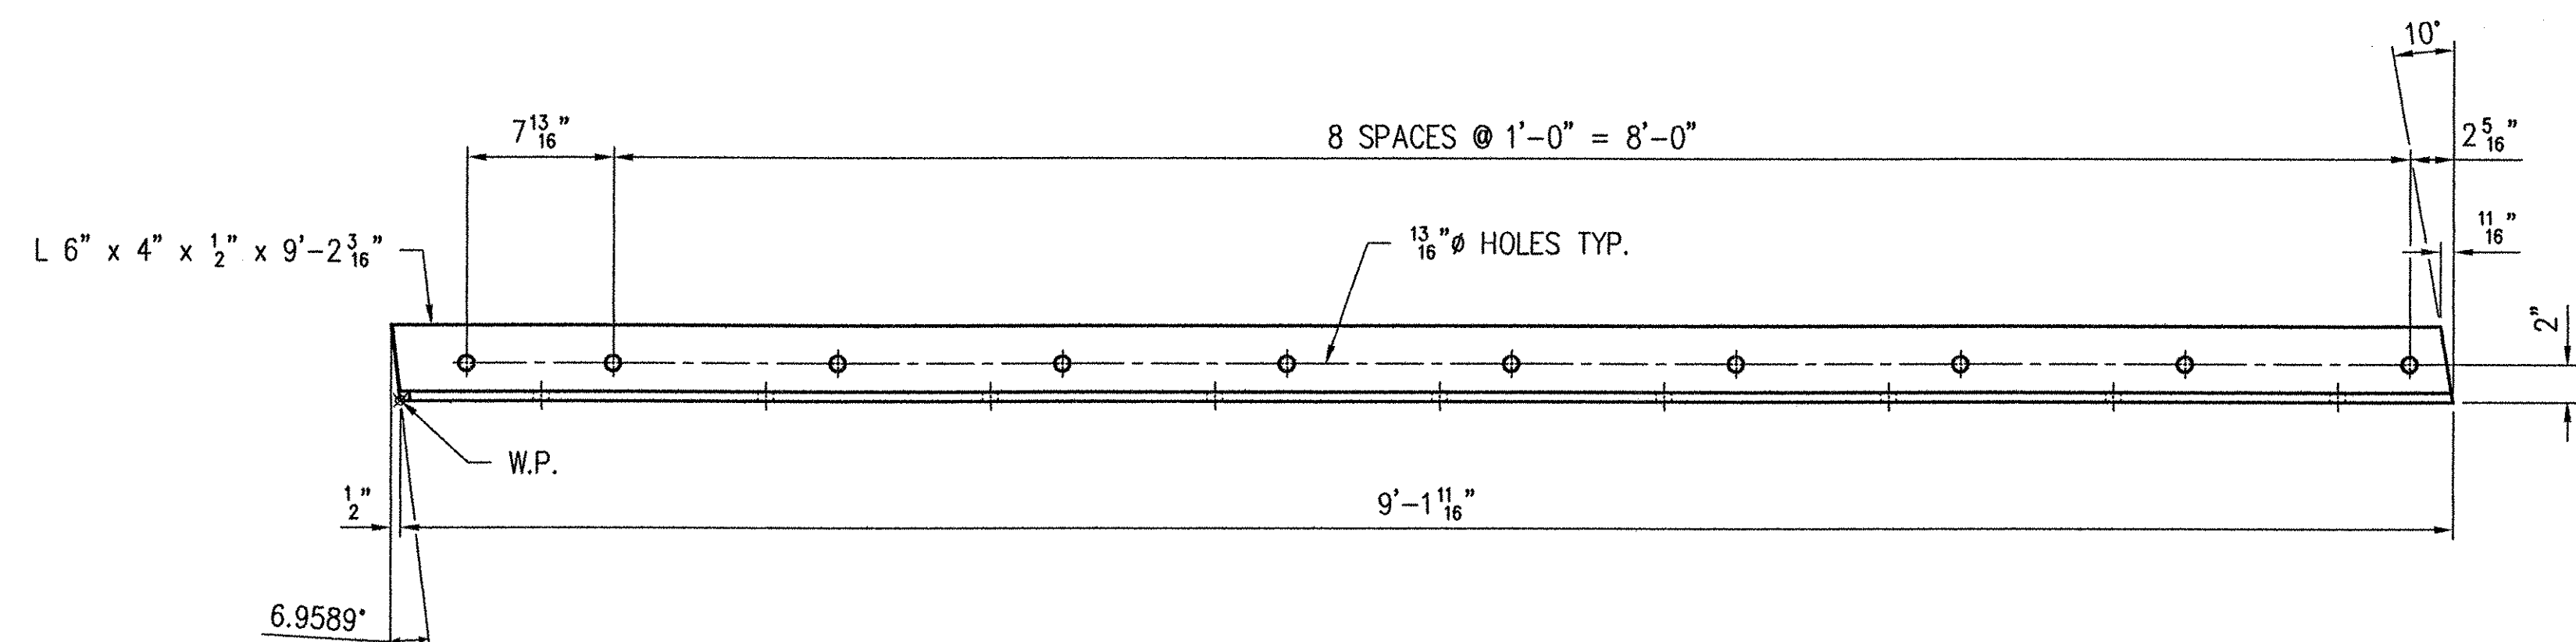
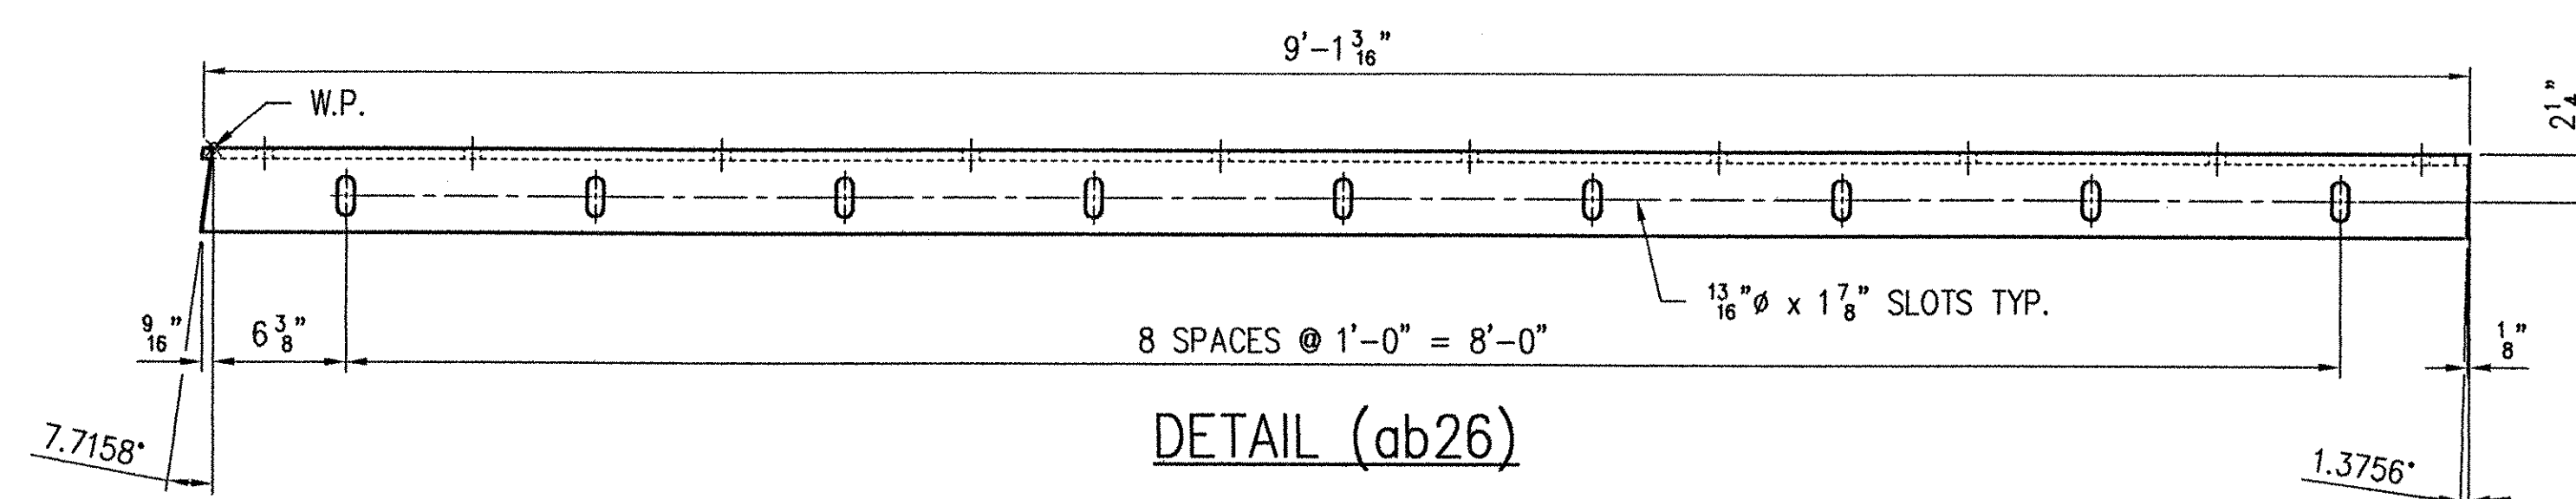


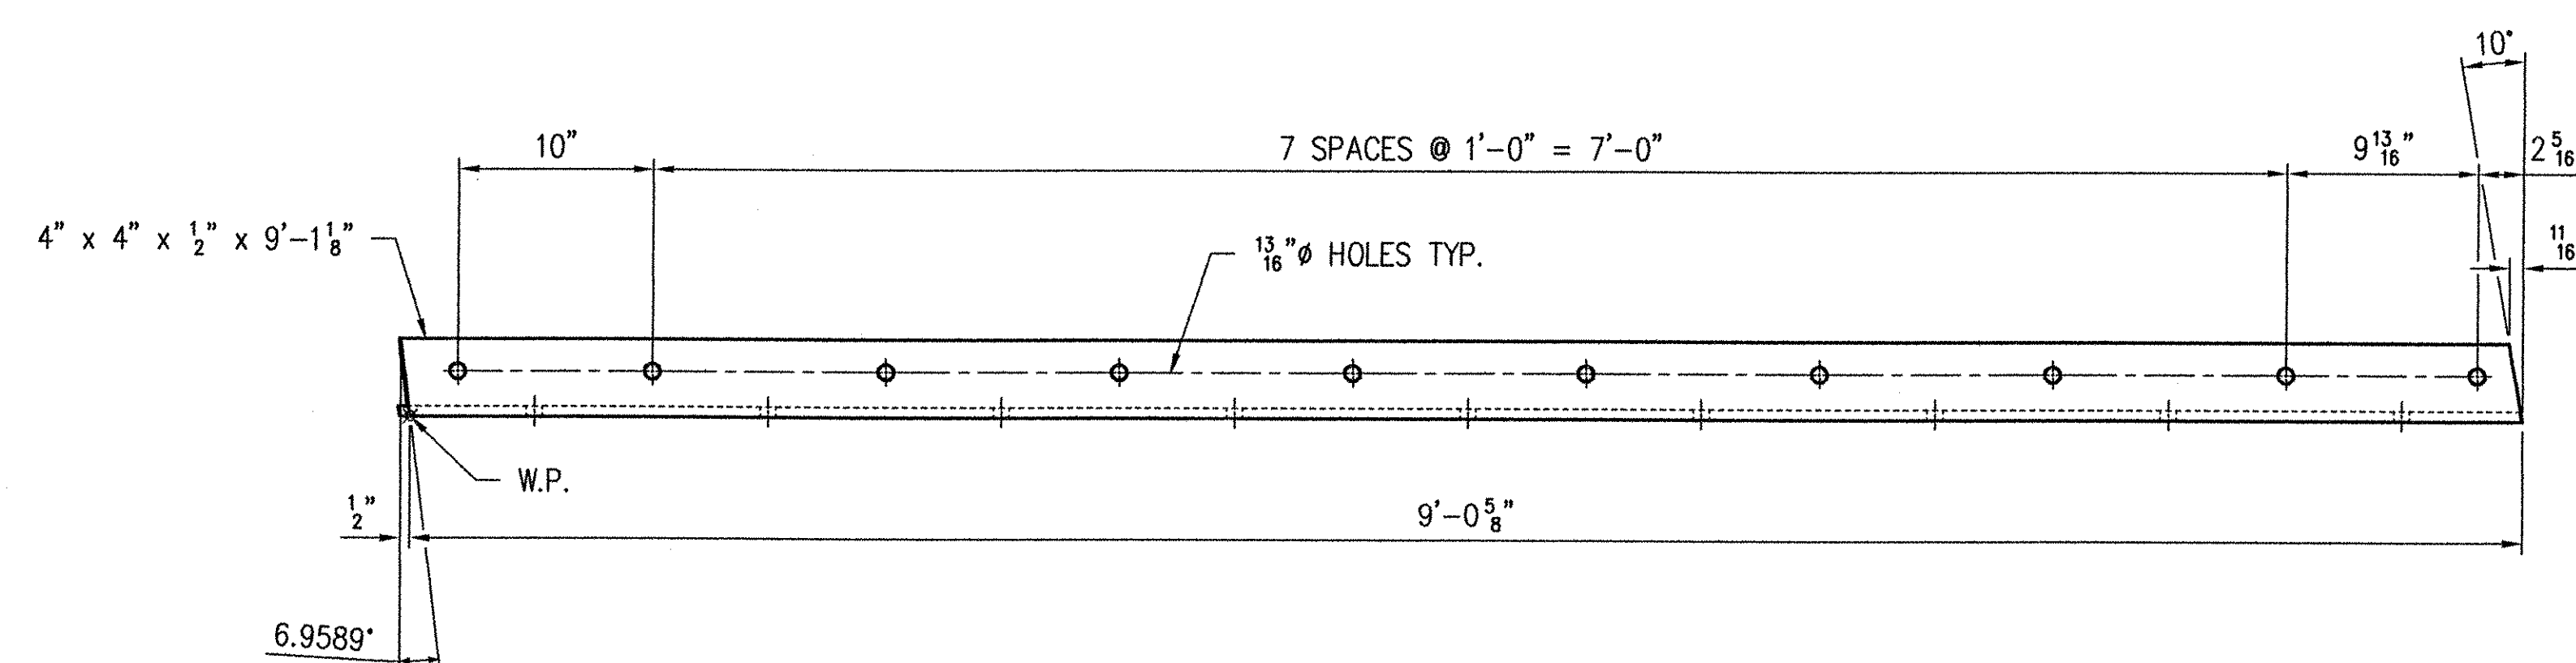

DETAIL (aa26)

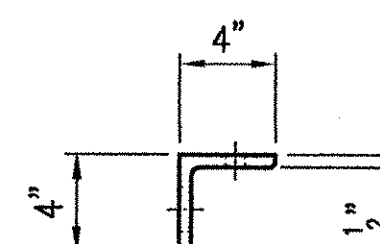


DETAIL (ab26)

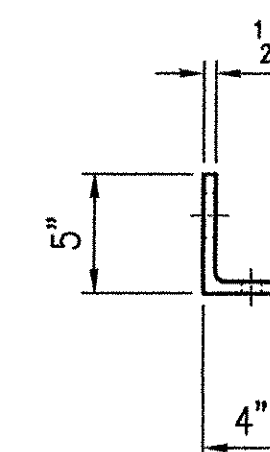

RECEIVED
OK'D BY LDJ OK'D BY _____
JAN 21 2002
RESUBMIT _____ APPROVED _____
BY CPW DATE 1/24/12

SEE SHEET NO. 30 FOR GENERAL NOTES.
WORK THIS SHEET WITH SHEET NO. 23, 24, 25 & 27.

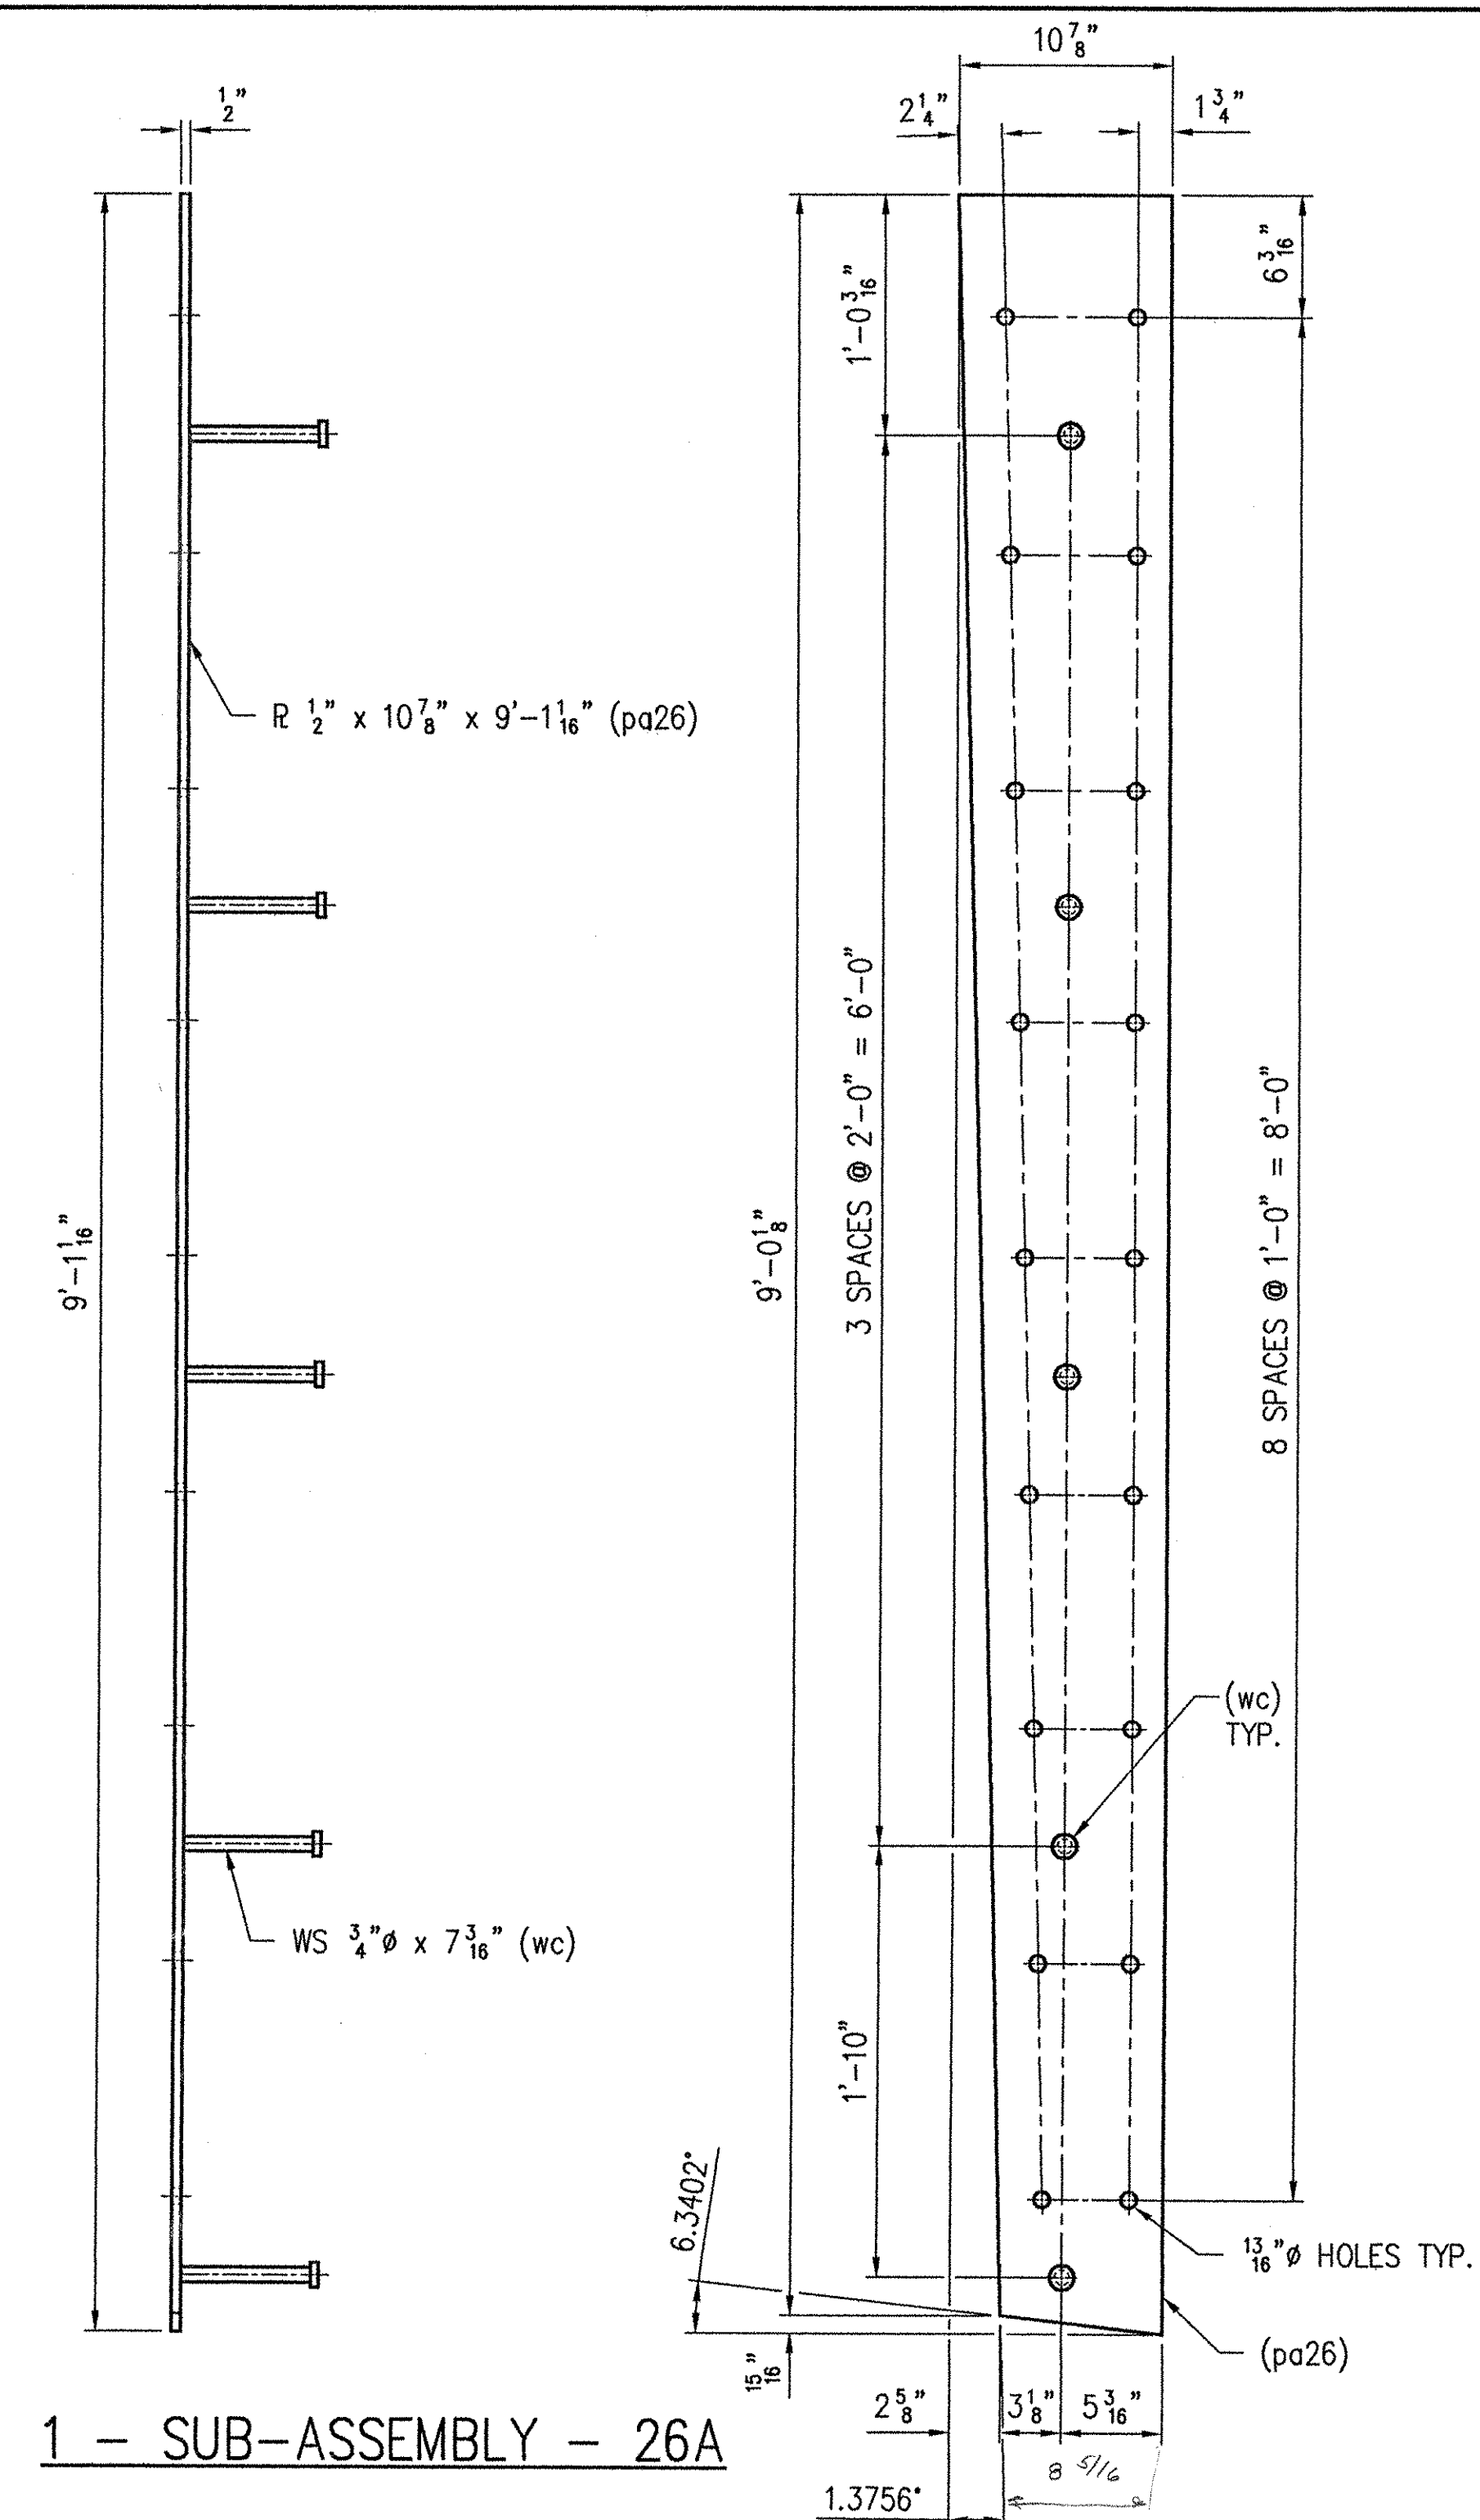

1 - SUB-ASSEMBLY - 26A

REV.	DESCRIPTION	DATE	INT.
	ANY AND ALL BACKCHARGES WILL BE REJECTED UNLESS WRITTEN CONSENT IS GIVEN BY LEWIS ENGINEERING COMPANY PRIOR TO ANY WORK PERFORMED FOR OUR ACCOUNT. SUCH REJECTION MEANS THAT INVOICES WILL NOT BE HONORED OR DEDUCTIONS FROM PAYMENT WILL BE CHARGED BACK.		
	LEWIS ENGINEERING COMPANY 4201 NOREX DRIVE - CHASKA, MINNESOTA 55318 - (952) 368-3000		
SHOP	PROJECT - ROYALTON / RTE. NO. TH 1, CL 1 BRIDGE NO. 3		
	STATE PROJECT - AC BRZ 1444(22)		
	FEDERAL PROJECT -		
APPROVAL	CUSTOMER - BECK & BELLUCCI, INC.		
	LOCATION - WINDSOR COUNTY, VT		
DIST.	DESCRIPTION - EXPANSION JOINT DETAILS		
CUST. FOR	ABUTMENT NO. 1		
DATE			
PRINTS ISSUED			
L.E.C. 26 OF 30	SHEET NO. 11 OF 15	Job. No. : 2034.1042.1	

Orig.
W.P. ch'k'd
Drawn By JMB
Ch'k'd. By TSF
Date: 12/20/01