


TUBE RADII UNDER 50' RAD. REQUIRE CUT & WELD TUBE FABRICATION

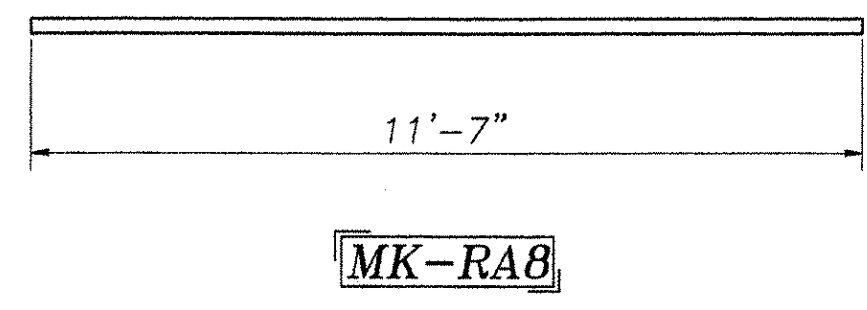

REVISIONS		
No.	Remarks	Date
0	Initial submittal	10/16/01
	Second submittal	3/18/02
	Third submittal	4/17/02
	Fourth submittal	5/8/02

RECEIVED
 CK'D BY: *LWS* CK'D BY: _____
 MAY 15 2002
 RESUBMIT APPROVED: *As noted*
 BY: *OPW* DATE: *5/20/02*

HIGHWAY SAFETY CORP.
 GLASTONBURY, CT

ITEM 525.32 PEDESTRIAN RAIL (MOD)
 PROJECT No. AC BRZ 1444(22)
 TOWN OF ROYALTON
 TH1 OVER THE WHITE RIVER
 (BRIDGE No. 3) WINDSOR COUNTY

DRAWN: J. Ruiz
 CHECKED: *[Signature]*
 DATE: 4/15/02
 SCALE: NONE
 HSC REFERENCE NO.: 1242
 GENERAL CONTRACTOR: _____
 SUB CONTRACTOR: F.R. LAFAYETTE, INC.
 SHEET NO.: 3 of 5

