


DATE: \_\_\_\_\_  
 BY: \_\_\_\_\_  
 SUPERVISOR: \_\_\_\_\_  
 PROJECT: \_\_\_\_\_  
 NOTE BOOK: \_\_\_\_\_  
 No. \_\_\_\_\_  
 ENGINEER: \_\_\_\_\_  
 CHECKER: \_\_\_\_\_



DATE: \_\_\_\_\_  
 BY: \_\_\_\_\_  
 SUPERVISOR: \_\_\_\_\_  
 PROJECT: \_\_\_\_\_  
 NOTE BOOK: \_\_\_\_\_  
 No. \_\_\_\_\_  
 ENGINEER: \_\_\_\_\_  
 CHECKER: \_\_\_\_\_

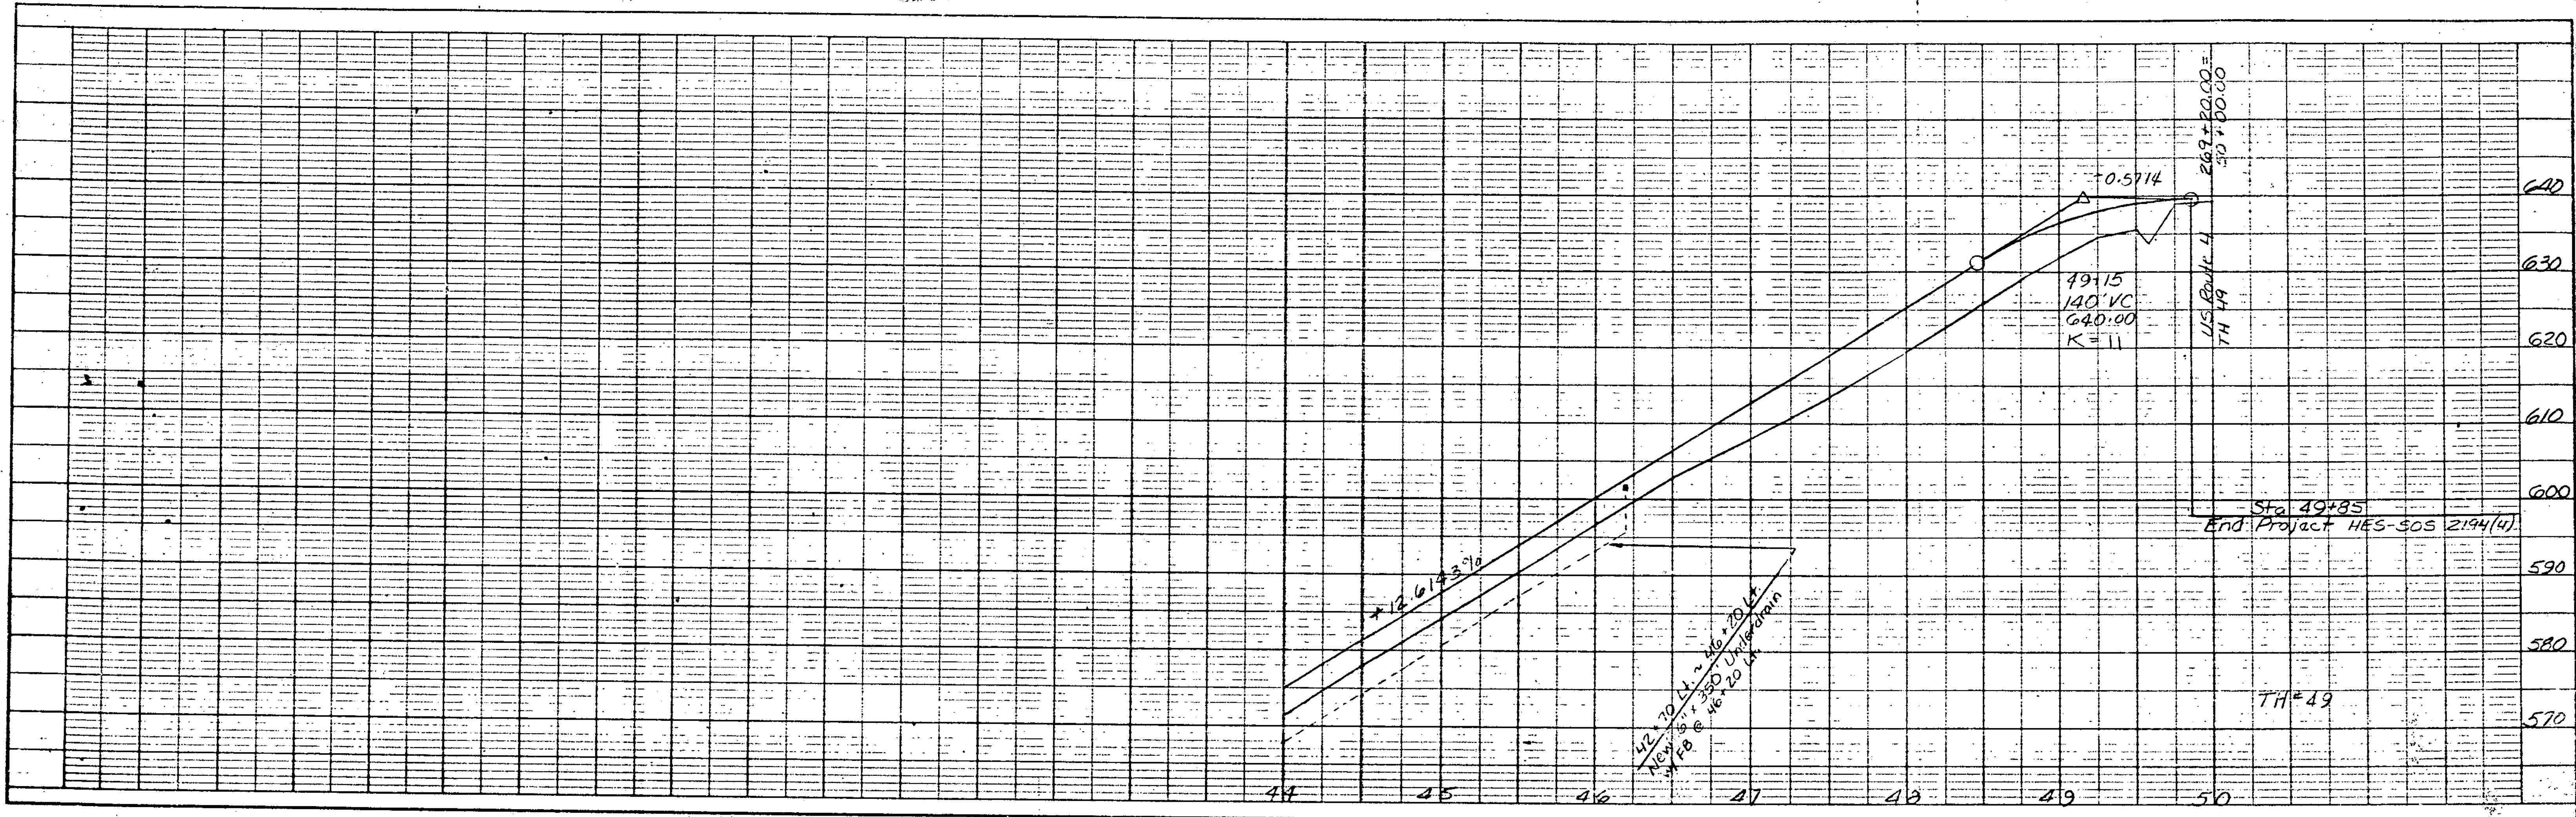