

40+75 Lt
Begin Special Ditch
w/ Stone Fill, Type I
(Item 203.15)

40+75 Rt
Begin Rock Fill
(Encountered On Project)

40+41 Lt
(Interpolated Section)
40+15 Lt
Construct Drive (16' wide)

40+03 Rt ~ 40+41 Lt
New 12" ACCGMP 064
New 18" M&S for ACCGMP 064
Construct Inlet & Outlet Ditches w/ Stone Fill, Type I

39+40 Lt
End New 6" Underdrain w/ New Flushing Basin


39+80 Lt
End Special Ditch
w/ Stone Fill, Type I

39+90 Rt
End Special Ditch w/ Stone Fill, Type I
(Excavation to be Paid as Item 203.15)

39+40 Rt
Begin Treated Timber Curb

39+30 Rt
Begin Guard Rail, Standard Steel Beams
w/ Wood Posts, Type II

39+00 Rt ~ 39+42 Rt
New 12" ACCGMP 064 or CACCP 060
1-30° ELBOW

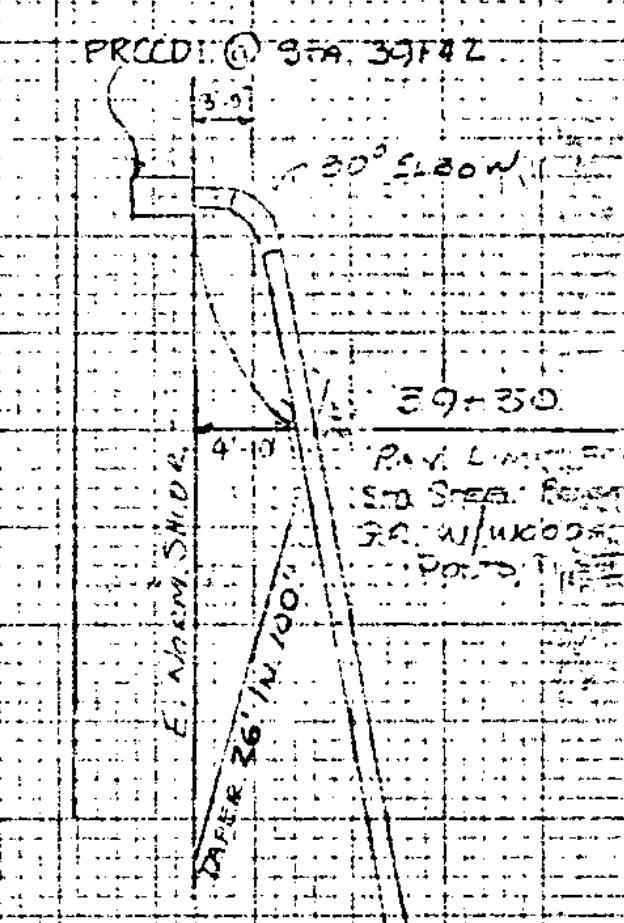

FROM STA. 39+00	TO STA. 41+00
PROJECT NAME	HARTFORD 32+0
NO.	052194(4)
SURVEYED BY	FANTONI
SHEET 47 OF 60	SHEETS
	PLOTTED 04/13/78
	APRIL 1978

SCALE 1" = 10 FEET