

43+35 ~ 43+75
Scarifying Existing Pavement

PC 43+42.47
D = 6'00" L_T
FB = 0.0221/F_T

43+17.24
Begin Guard Rail, Standard Steel Beam
W/ Wood Posts, Type II

43+08.21
Construct Drive (18' Wide)
New 24" x 40" ACCGMP 964
Remove Existing 15" ACCGMP



42+10.14
Begin New 6" x 350 Underdrain

42+99.21
End Guard Rail, Standard Steel Beam
W/ Wood Posts, Type II

42+50.21 ~ 42+10.14
New 6" x 350 Underdrain w/ Carrier Pipe

42+80.21
End Treated Timber Curb

PT 41+85.59
D = 9'00" R_T

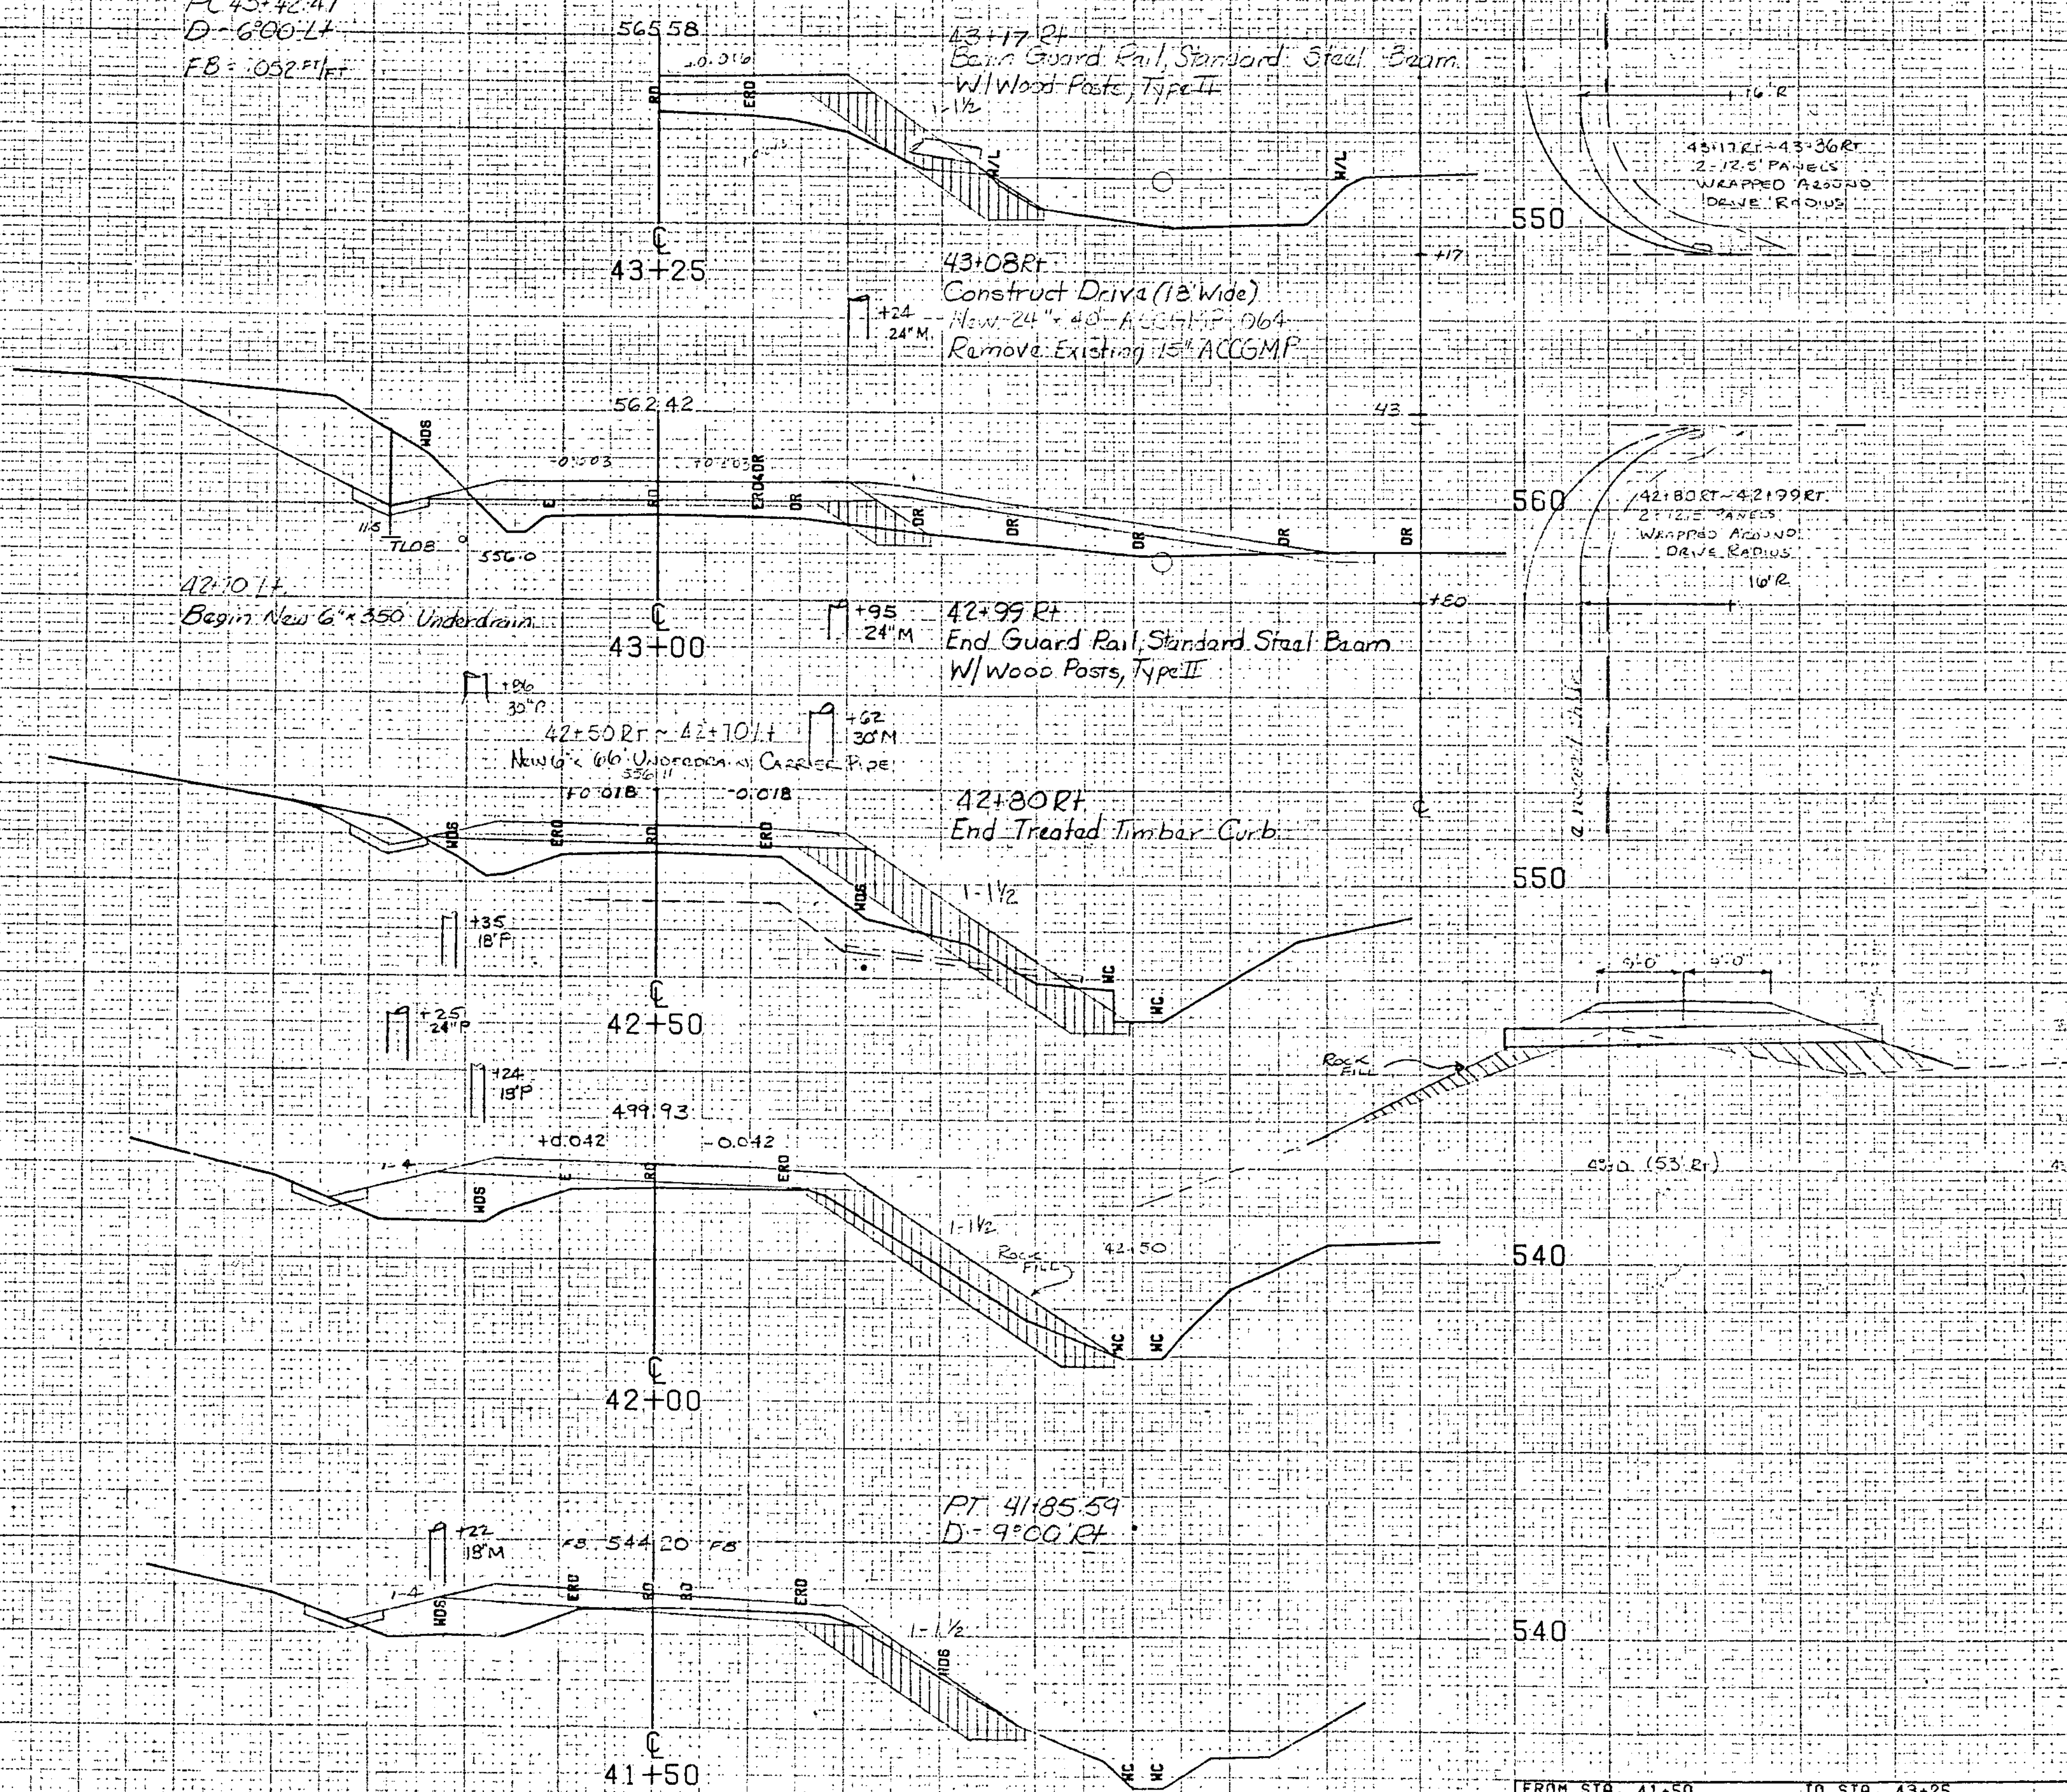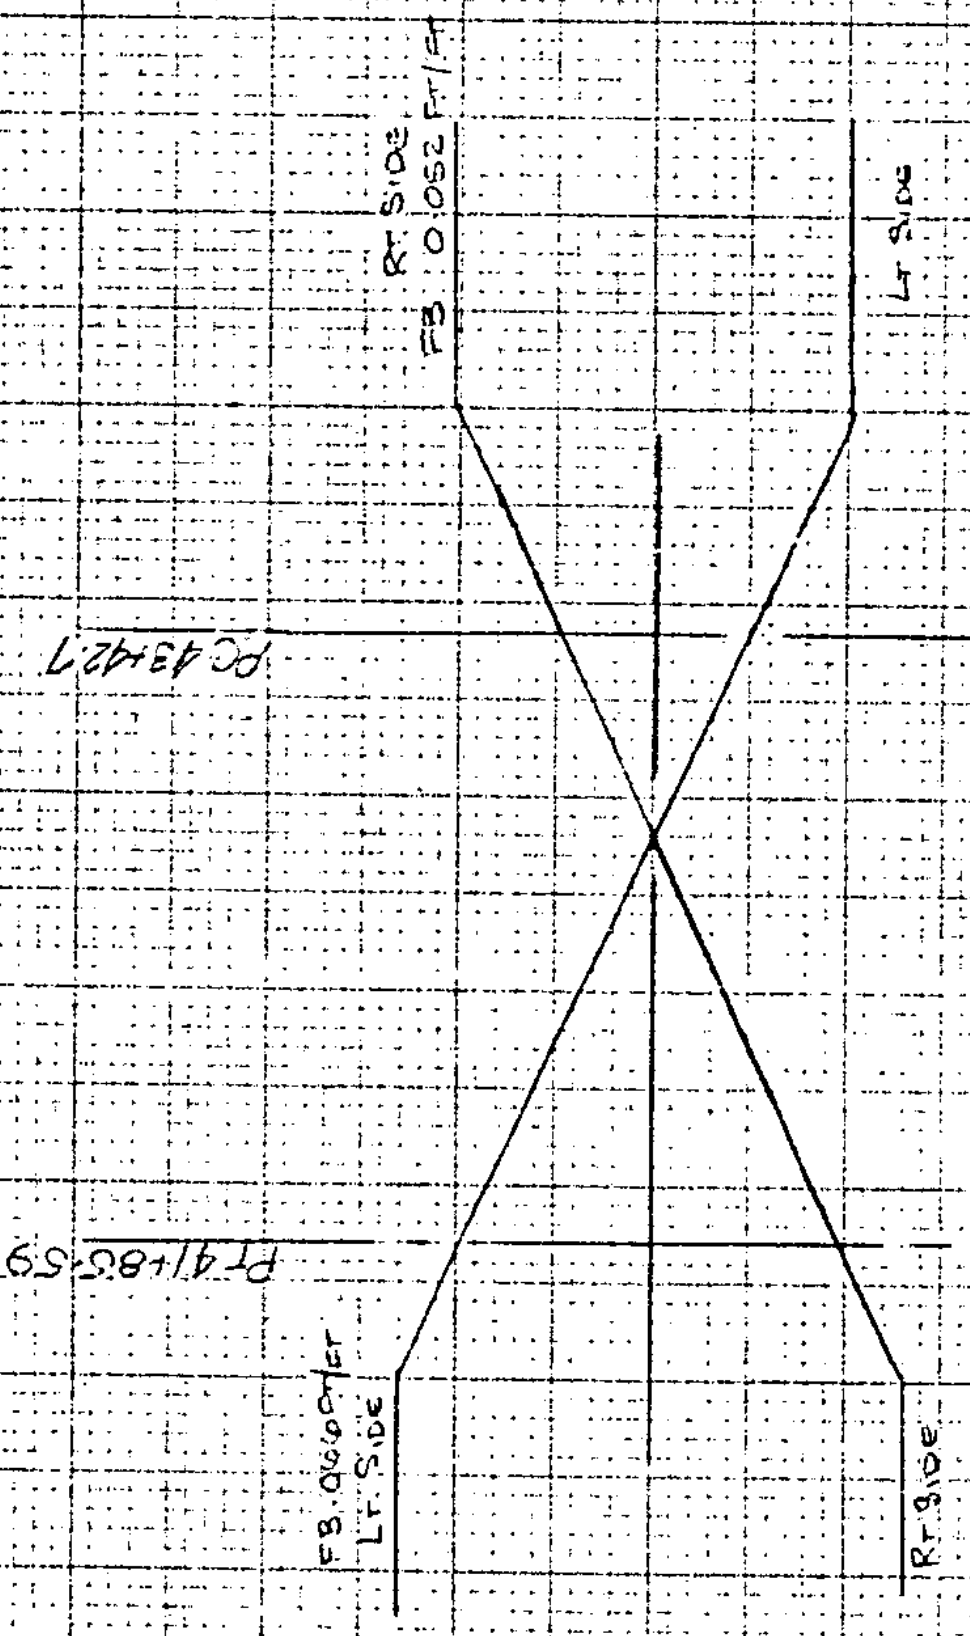

FROM STA. 41+50	TO STA. 43+25
PROJECT NAME	HARTFORD 32+0
NO.	052194(4)
SURVEYED BY	FANTONI
SHEET 48 OF 60	SHEETS
	PLOTTED 04/13/78
	APRIL 1978

SCALE 1" = 10 FEET