

INDEX OF SHEETS

- 1 TITLE SHEET
- 2 PRELIMINARY INFORMATION
- 3-4 QUANTITY SHEETS
- 5 TIE SHEET
- 6-7 LAYOUT SHEET 1 & 2
- 8 PROFILE
- 9-12 BORING SHEET
- 13 PLAN AND ELEVATION
- 14 GENERAL NOTES
- 15 DECK REINFORCING
- 16 FRAMING PLAN
- 17 BEARING DETAILS
- 18 MISCELLANEOUS STEEL AND CONCRETE DETAILS
- 19 MISCELLANEOUS DETAILS
- 20 ABUTMENT #1 DETAILS
- 21 ABUTMENT #2 DETAILS
- 22 WINGWALL #1 DETAILS
- 23 WINGWALL #2 DETAILS
- 24 WINGWALL #3 DETAILS
- 25 WINGWALL #4 DETAILS
- 26 FOOTING REINFORCING DETAILS
- 27 TRAFFIC SIGN SUMMARY SHEET
- 28 ROW PLAN
- 29 ROW DETAILS
- 30 REINFORCING STEEL SCHEDULE
- 31 EROSION CONTROL NARRATIVE SHEET
- 32 EXISTING CONDITIONS SITE PLAN
- 33 EROSION PREVENTION AND SEDIMENT CONTROL PLAN
- 34 FINAL CONDITIONS SITE PLAN
- 35 EROSION CONTROL DETAIL SHEET #1
- 36 EROSION CONTROL DETAIL SHEET #2
- 37 EROSION CONTROL DETAIL SHEET #3
- 38-43 MAIN LINE CROSS SECTIONS
- 44-49 CHANNEL CROSS SECTIONS

STATE OF VERMONT AGENCY OF TRANSPORTATION




PROPOSED IMPROVEMENT BRIDGE PROJECT TOWN OF READING COUNTY OF WINDSOR

ROUTE NO : TH 8, CL.3 BRIDGE NO : B25

PROJECT LOCATION : BEGINNING AT A POINT ON TH 8 APPROXIMATELY 0.11 MILE FROM THE INTERSECTION OF TH 8 AND VT 106 AND PROCEEDING NORTHWESTERLY ALONG TH 8 0.08 MILES.


PROJECT DESCRIPTION : THE PROJECT SHALL CONSIST OF THE CONSTRUCTION OF A NEW STRUCTURE ALONG WITH RELATED ROADWAY APPROACH AND CHANNEL WORK.

LENGTH OF STRUCTURE : 65.66 FEET.
LENGTH OF PARTICIPATION ROADWAY : 334.34 FEET.
LENGTH OF PROJECT : 400.00 FEET.

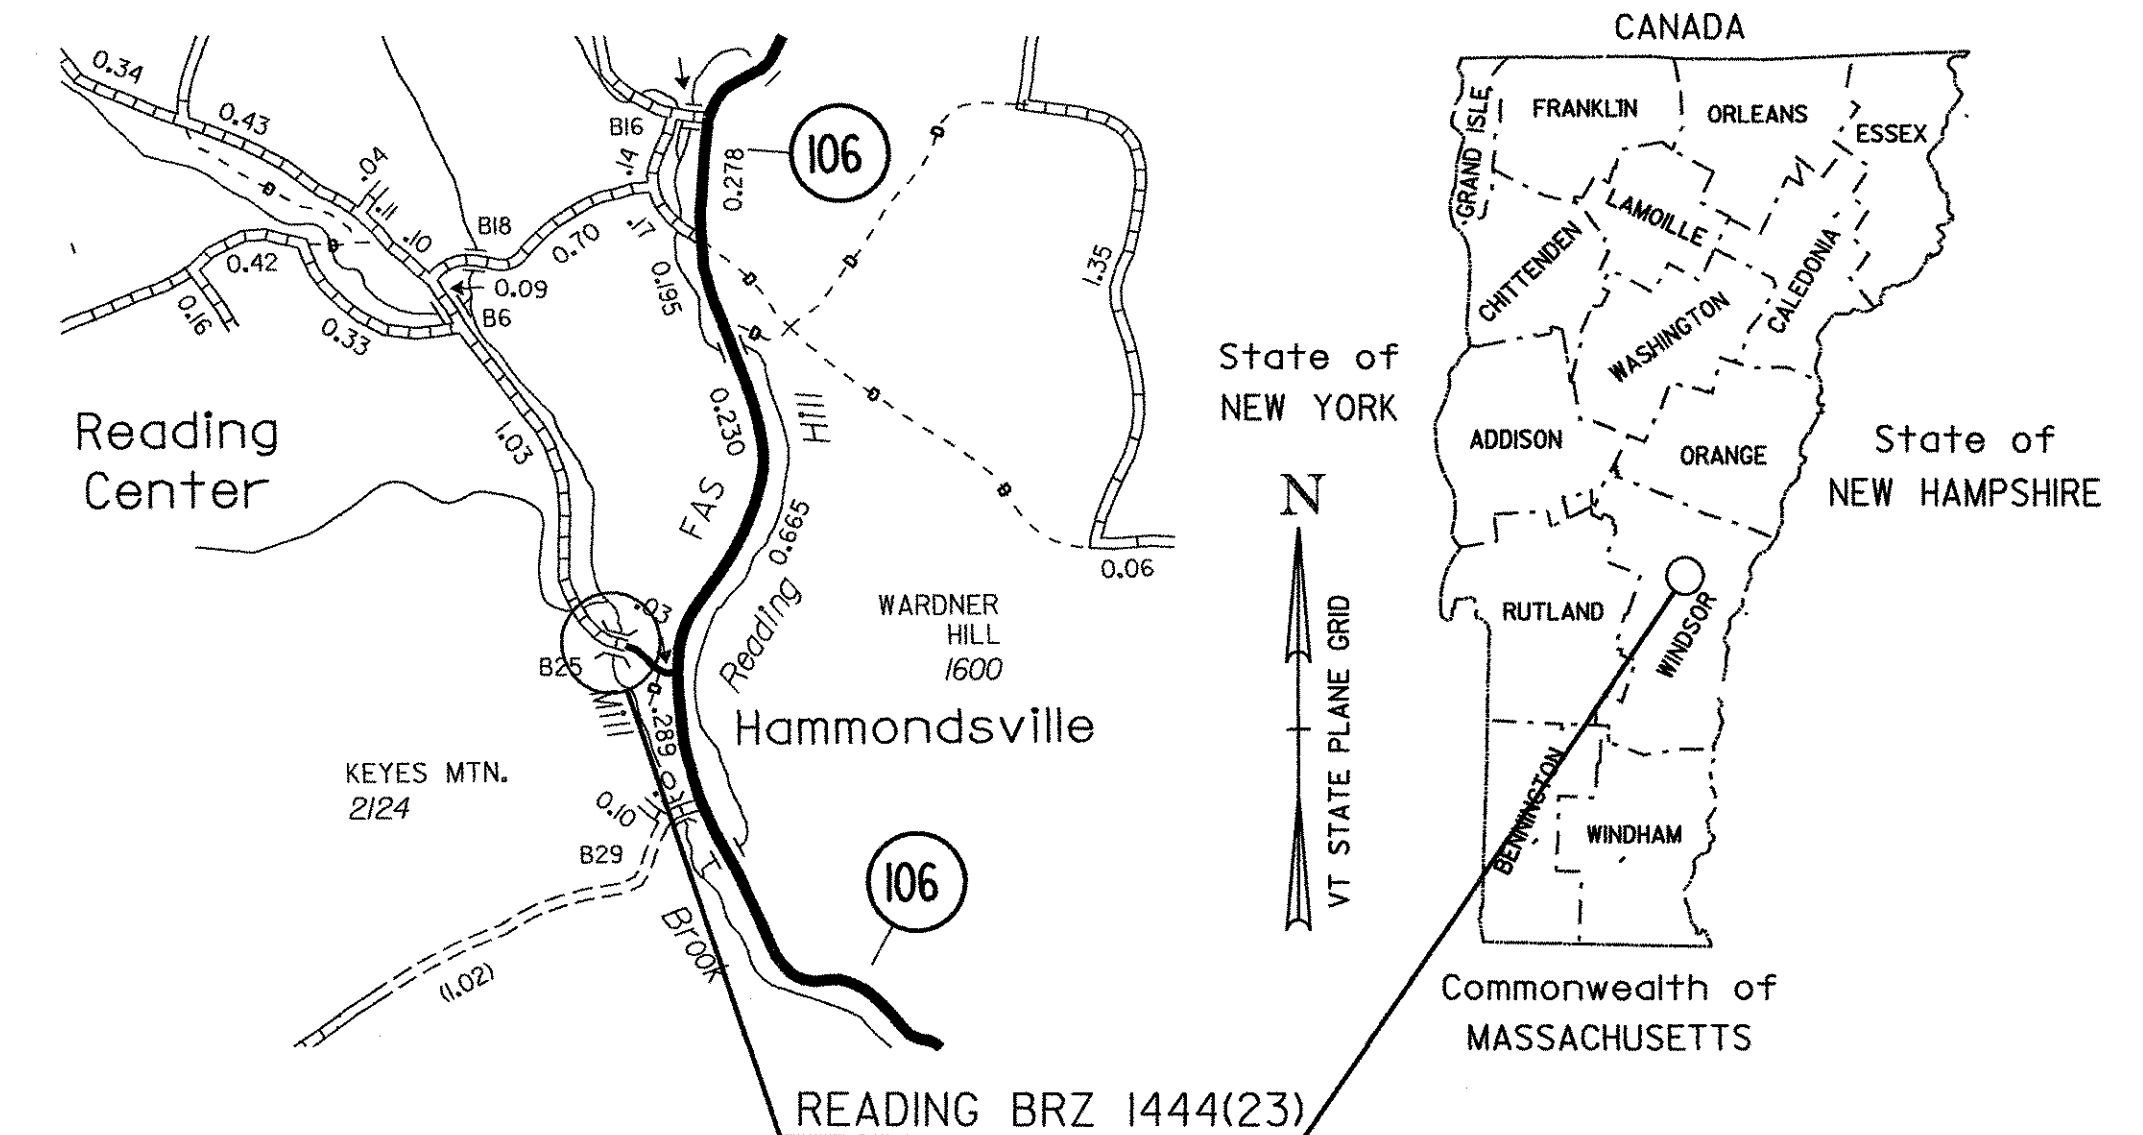

LIST OF STANDARDS

B-5	6/1/94
B-71	7/8/05
E-100	1/2/04
E-101	5/30/03
E-102	6/30/03
E-102a	5/1/04
E-107	6/30/03
E-107a	8/8/95
E-121	8/8/95
E-142	9/20/95
E-151	5/1/04
E-160	5/20/99
F-1	6/1/94
G-1	1/3/00
G-1d	1/3/00
SB-R6-82	1/6/95

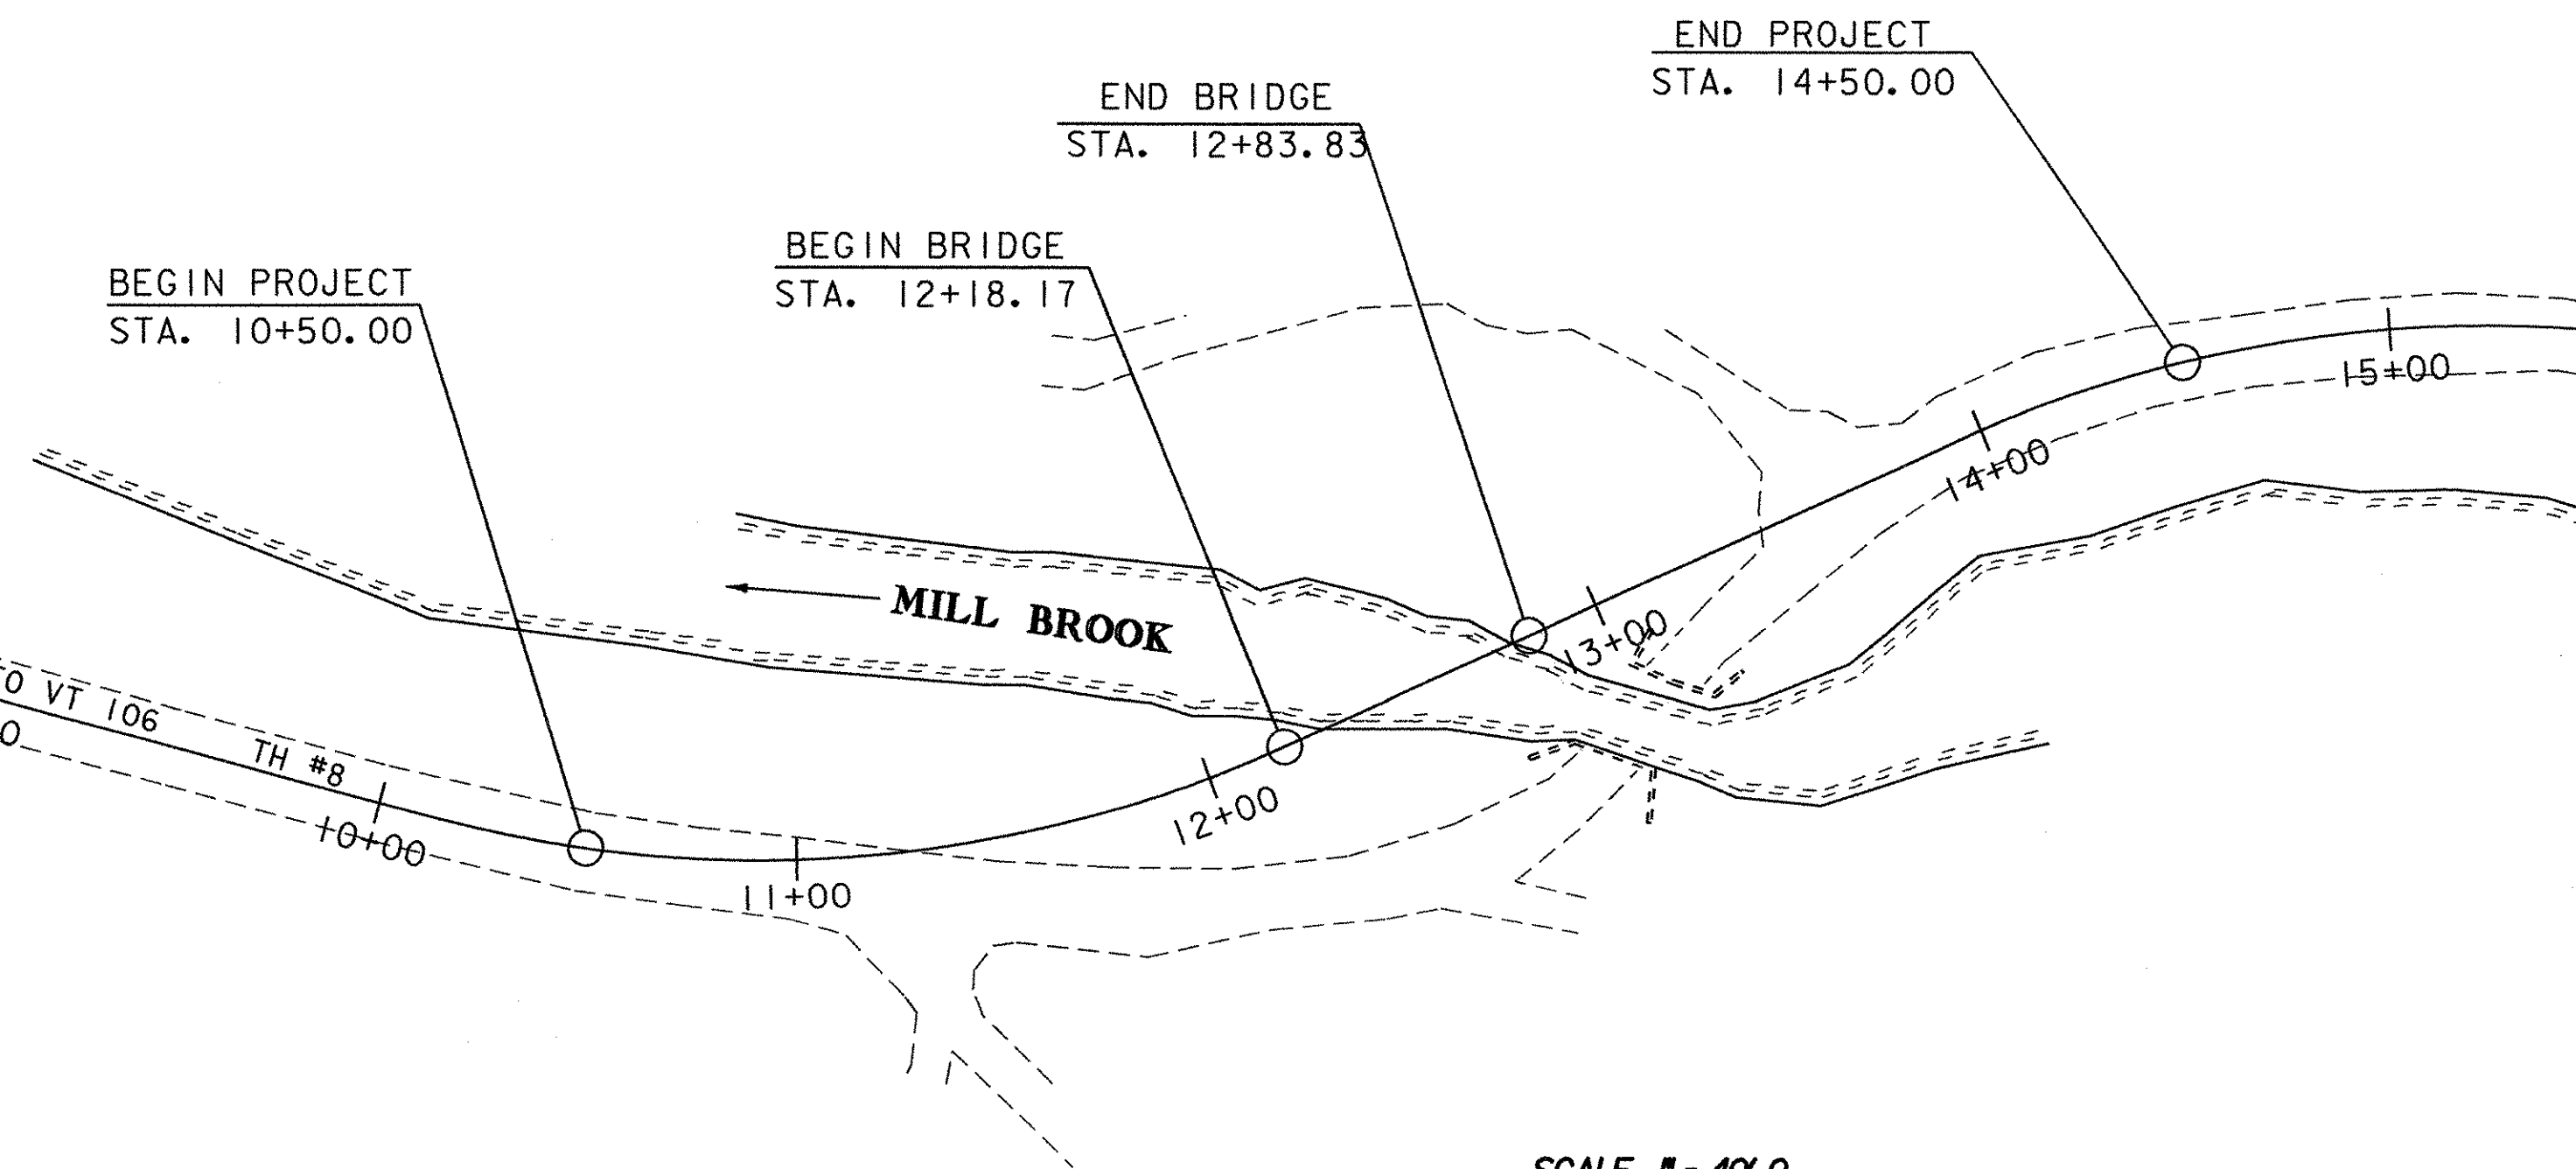

SCALE 1" = 40'-0"

CONVENTIONAL SYMBOLS

COUNTY LINE	— — — — —
TOWN LINE	— — — — —
LIMITS OF ACCESS	— — — — —
POINT OF ACCESS	X
FENCE LINE	— X — X — X —
STONE WALL	— ○ ○ ○ ○ ○ —
TRAVELED WAY	— — — — —
GUARD RAIL	— ○ ○ ○ ○ ○ —
RAILROAD	— — — — —
SURVEY LINE	— — — — —
CULVERT	— — — — —
POWER POLE	⊕
TELEPHONE POLE	⊕
TREES	⊕
CONTROL OF ACCESS	— — — — —
PROPERTY LINE	— — — — —
R.O.W. TAKING LINE	— SR — SR — SR —
SLOPE RIGHTS	— ○ — △ — ○ — △ —
TOP OF CUT	— △ — △ — △ —
TOE OF SLOPE	— ○ — ○ — ○ —

SURVEYED BY : R. GILMAN
SURVEYED DATE : 3/92

DATUM
VERTICAL USGS 1928
HORIZONTAL ASSUMED

RECORD PLANS

CONTRACTOR: MILLER CONSTRUCTION, WINDSOR VT.

RESIDENT ENGINEER: JEREMY REED

CONSTRUCTION BEGAN: MAY 7, 2008

CONSTRUCTION COMPLETE: NOVEMBER 11, 2008

RECORD PLANS BY: JEREMY REED

I HEREBY CERTIFY THAT ALL THE CONSTRUCTION REQUIRED BY THIS SET OF DRAWINGS HAS BEEN ACCOMPLISHED AS INDICATED HEREIN.

BY *Jeremy Reed* RESIDENT ENGINEER
DATE March 31, 2009

NOTE: Any further information concerning final quantities, amounts or other details relative to this project may be found at Central Files in the electronic archives.

THESE PLANS ARE SUBJECT TO SUCH ENGINEERING CHANGES AS MAY BE REQUIRED BY THE FEDERAL HIGHWAY ADMINISTRATION OR THE DIRECTOR OF PROGRAM DEVELOPMENT.

CONSTRUCTION IS TO BE CARRIED ON IN ACCORDANCE WITH THESE PLANS AND THE STANDARD SPECIFICATIONS FOR CONSTRUCTION DATED 2006, AS APPROVED BY THE FEDERAL HIGHWAY ADMINISTRATION ON JUNE 15, 2006 FOR USE ON THIS PROJECT, INCLUDING ALL SUBSEQUENT REVISIONS AND SUCH REVISED SPECIFICATIONS AND SPECIAL PROVISIONS AS ARE INCORPORATED IN THESE PLANS.

DIRECTOR OF PROGRAM DEVELOPMENT

APPROVED: *Ruth Felton* DATE 1/29/08

PROJECT MANAGER : C.P. WILLIAMS

PROJECT NAME : READING
PROJECT NUMBER : BRZ 1444 (23)

PLOTTED 29-JAN-2008 SHEET 1 OF 49 SHEETS