



TH 8 PROFILE

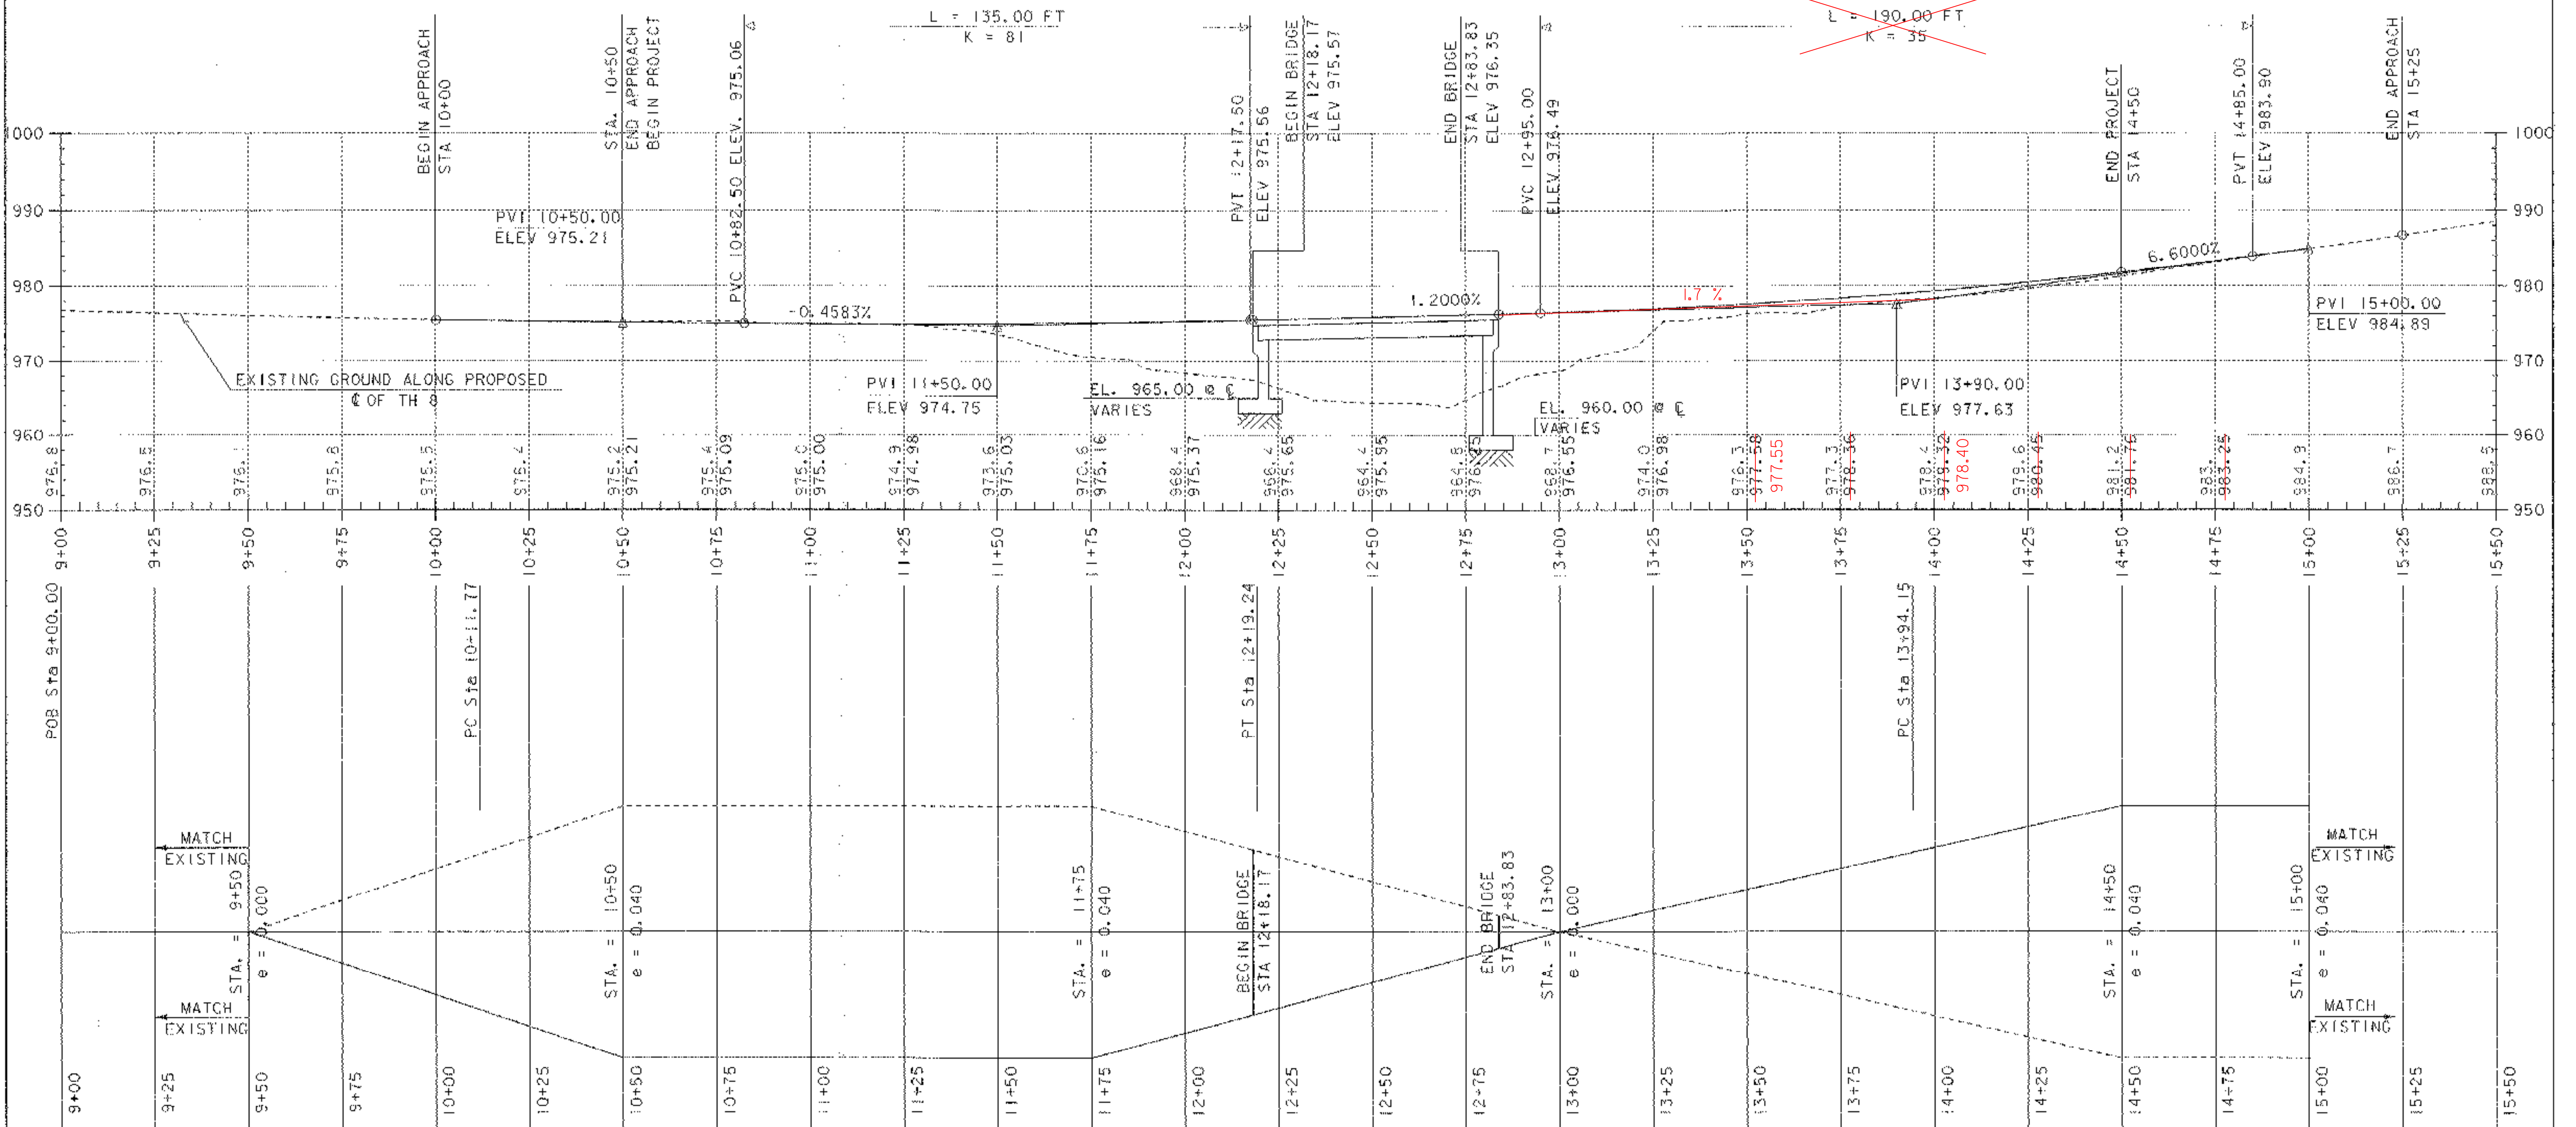

BANKING DIAGRAM
 HORIZONTAL SCALE: 1"=20'
 VERTICAL SCALE: 1"= 0.024 ft/ft

- - - - - RIGHT BANKING RATE
 - - - - - LEFT BANKING RATE

NOTE: EXISTING CENTERLINE ELEVATIONS ARE SHOWN TO THE TENTH.
 PROPOSED CENTERLINE ELEVATIONS ARE SHOWN TO THE HUNDREDTH.

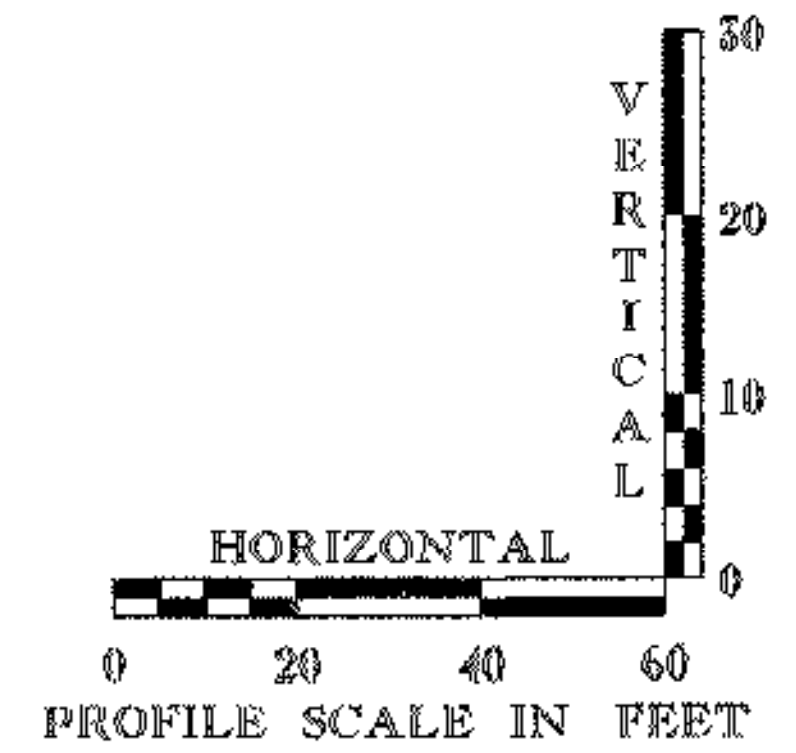

PROJECT: READING	PROJECT NO.: BRZ 1444(23)
DESIGN FILE NAME: /usr/str4/90j058/sj058pr1.dgn	PLOT DATE: 13-FEB-2008
IPARM FILE NAME: /str4/90j058/sj058pr1	SURVEY DATE: 3/92
SURVEYED BY: R. GILMAN	DRAWN BY: W.B. SYMONDS
SQUAD LEADER: C.P. WILLIAMS	SHEET: 8 OF 49
PROFILE SHEET	