
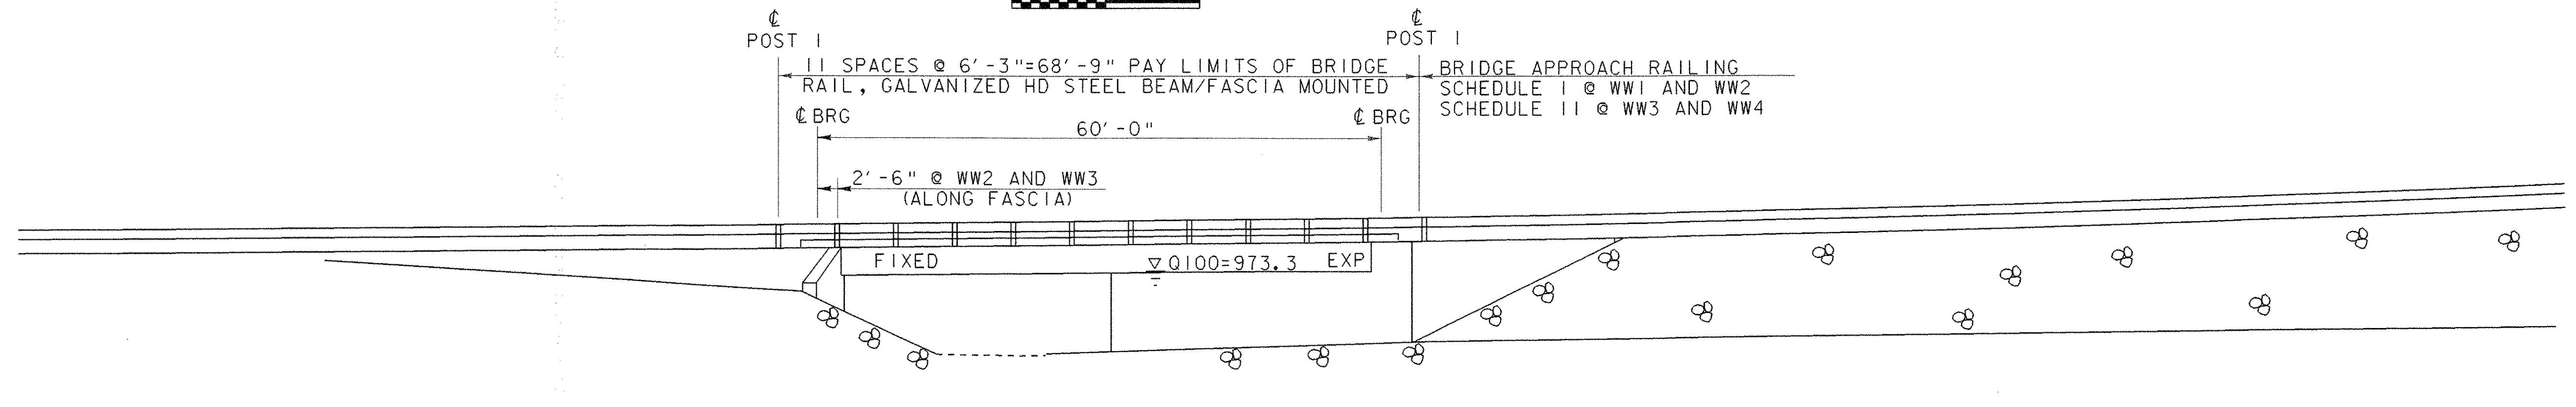


PLAN

SCALE 1" = 10'-0"

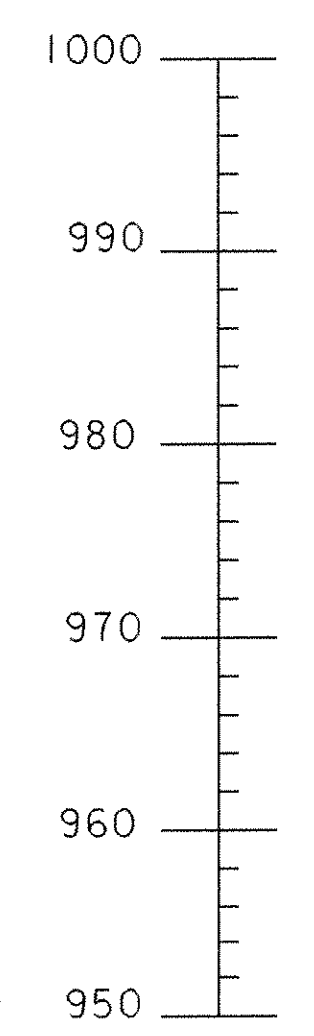

ELEVATION AT UPSTREAM FASCIA

SCALE 1" = 10'-0"

PROJECT: READING	PROJECT NO.: BRZ 1444(23)
DESIGN FILE NAME: /usr/str4/90j058/sj058el.dgn	PLOT DATE: 13-FEB-2008
IPARM FILE NAME: /str4/90j058/sj058el.l	SURVEY DATE: 3/92
SURVEYED BY: R. GILMAN	DRAWN BY: W.B. SYMONDS
SQUAD LEADER: C.P. WILLIAMS	SHEET: 13 OF 49
PLAN AND ELEVATION	