



ABUTMENT DIAPHRAGM AND BEARING STIFFENERS

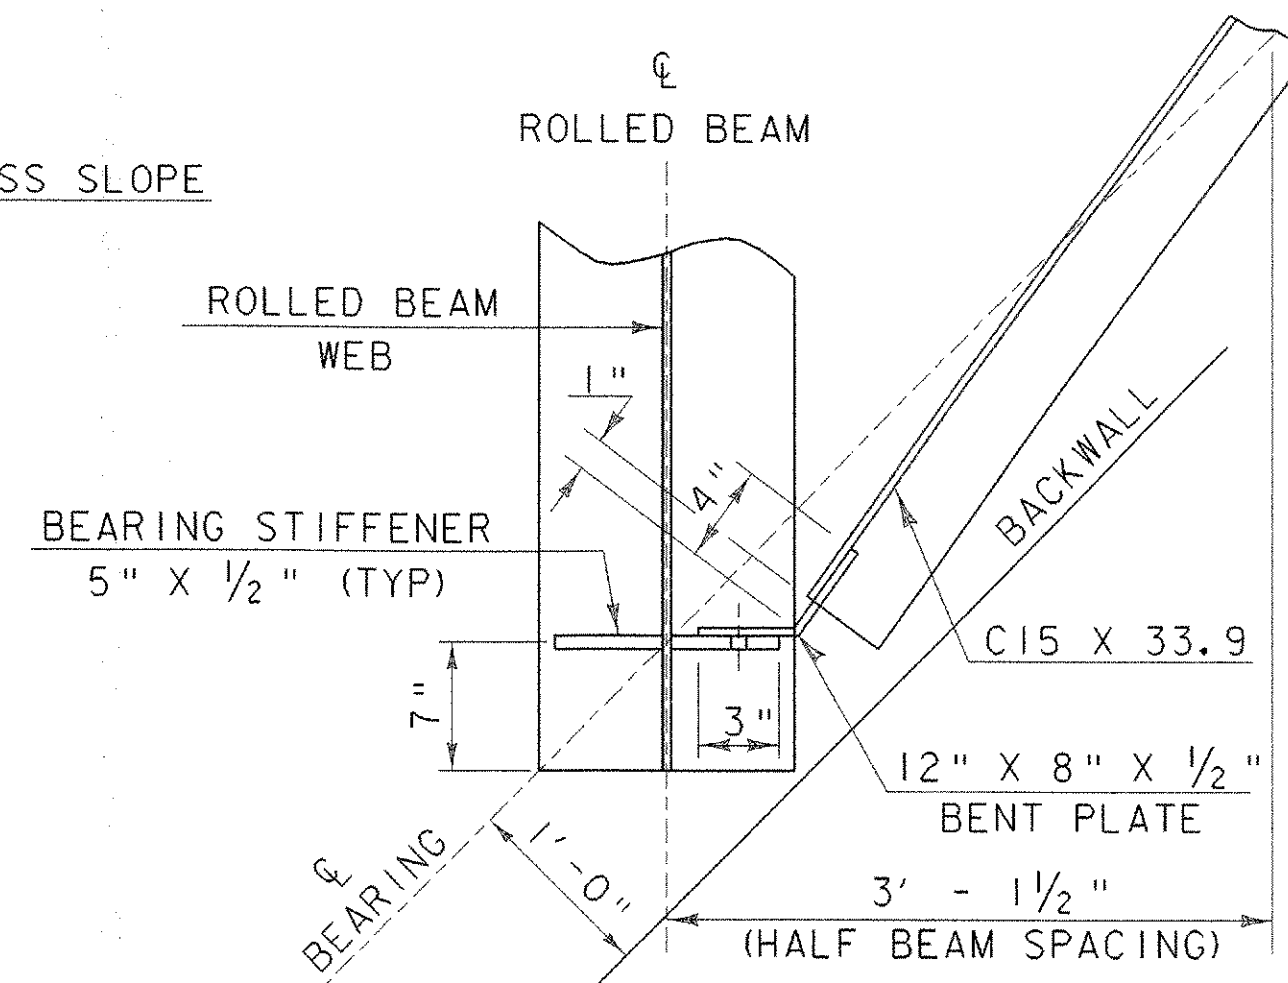


SECTION A - A


ALL DETAILS NOT TO SCALE

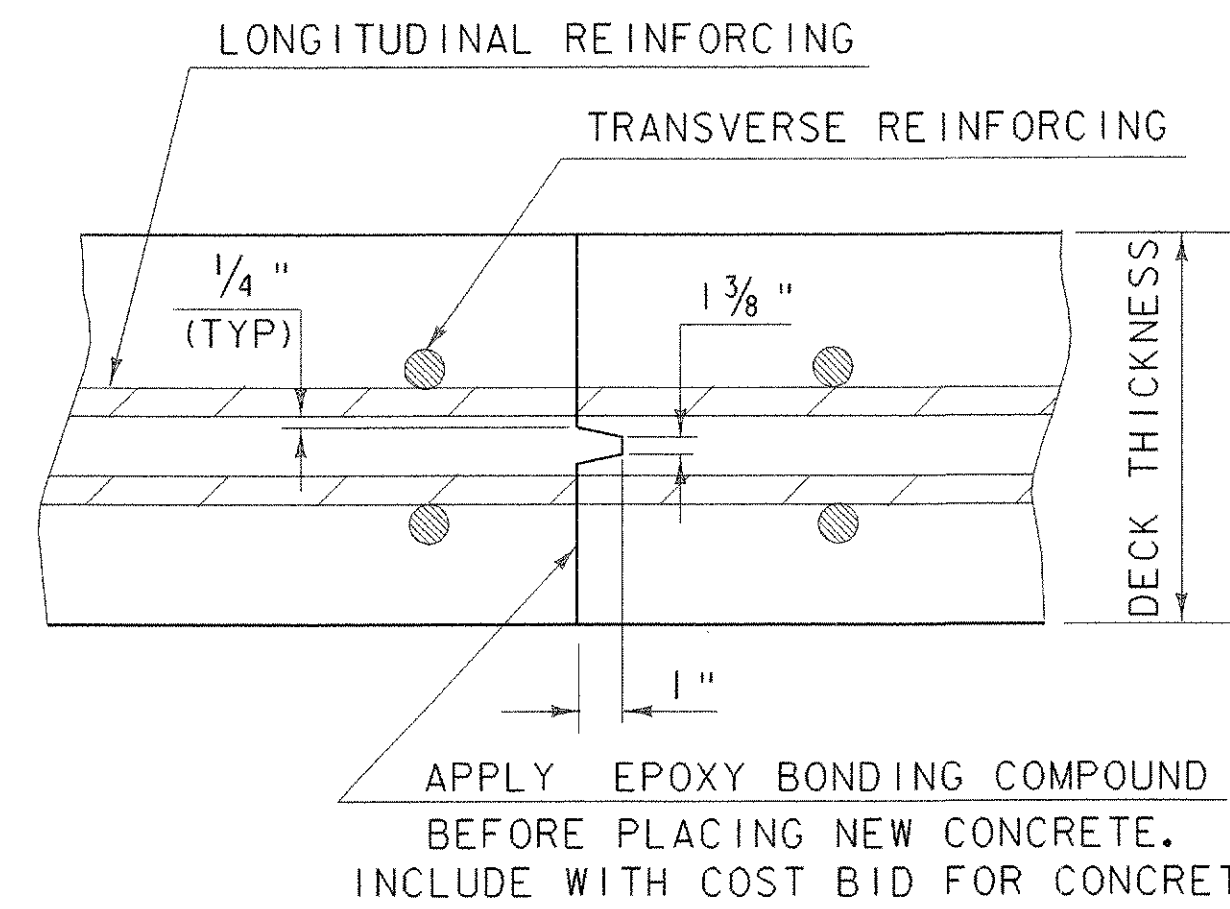

TRANSVERSE BRIDGE DECK CONSTRUCTION JOINT DETAILS

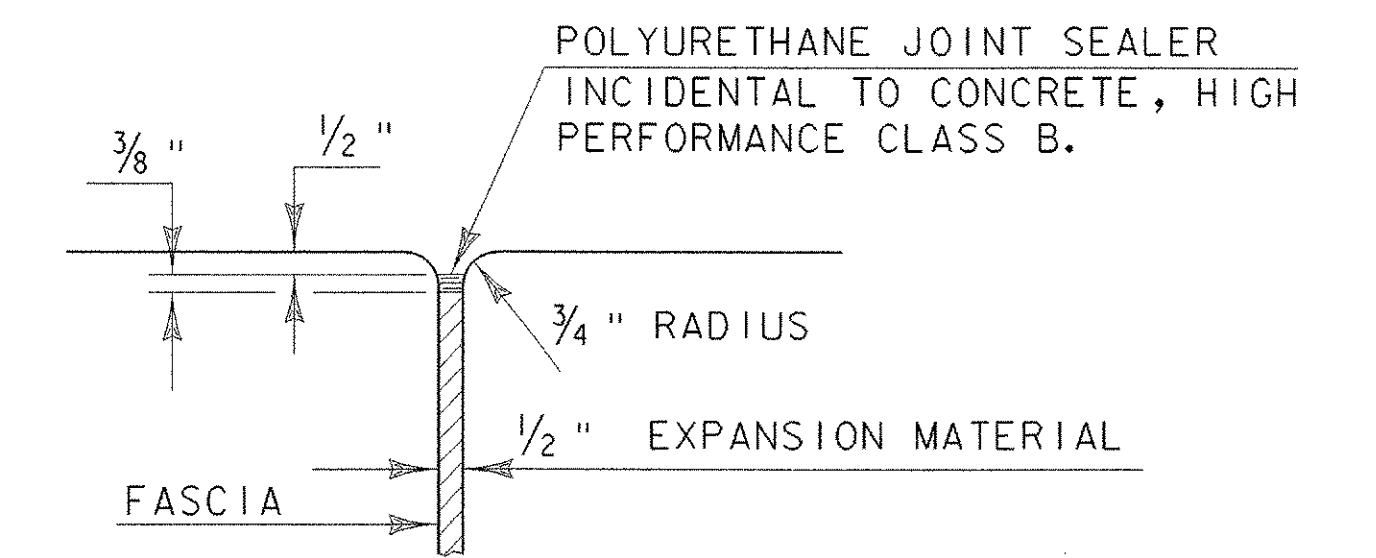


JOINT BETWEEN FASCIA AND WINGWALL

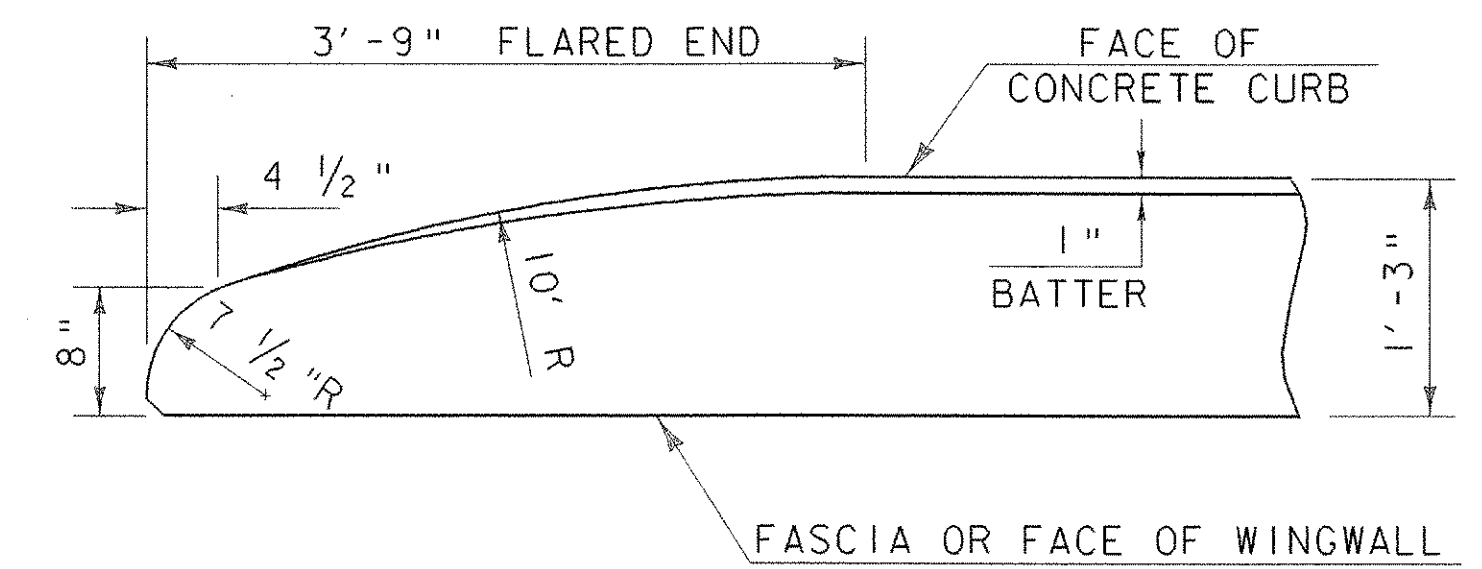


FLARED END DETAIL FOR 1'-3\"/>


CURB REINFORCING STIRRUP BARS SHALL BE TURNED AS REQUIRED TO FIT FLARED ENDS.

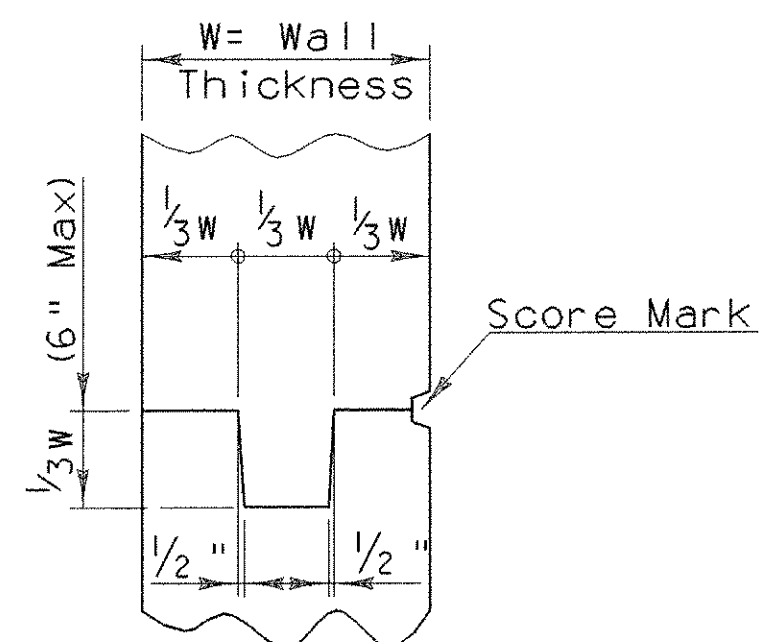

TYPICAL CONCRETE CONSTRUCTION JOINT

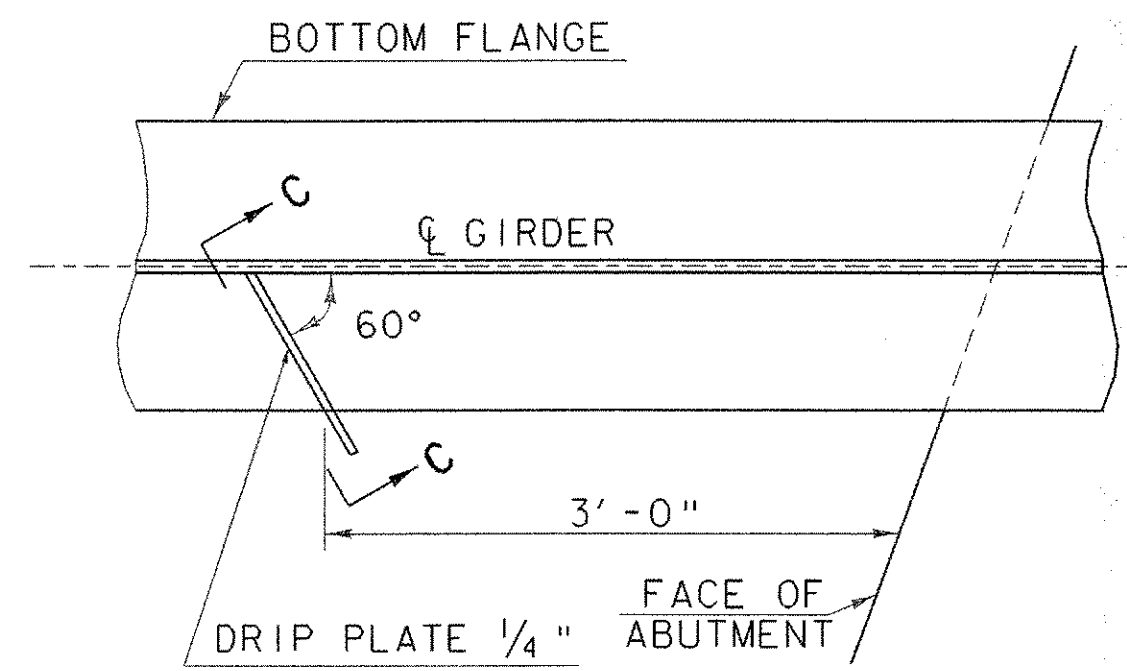


PLAN DRIP PLATE

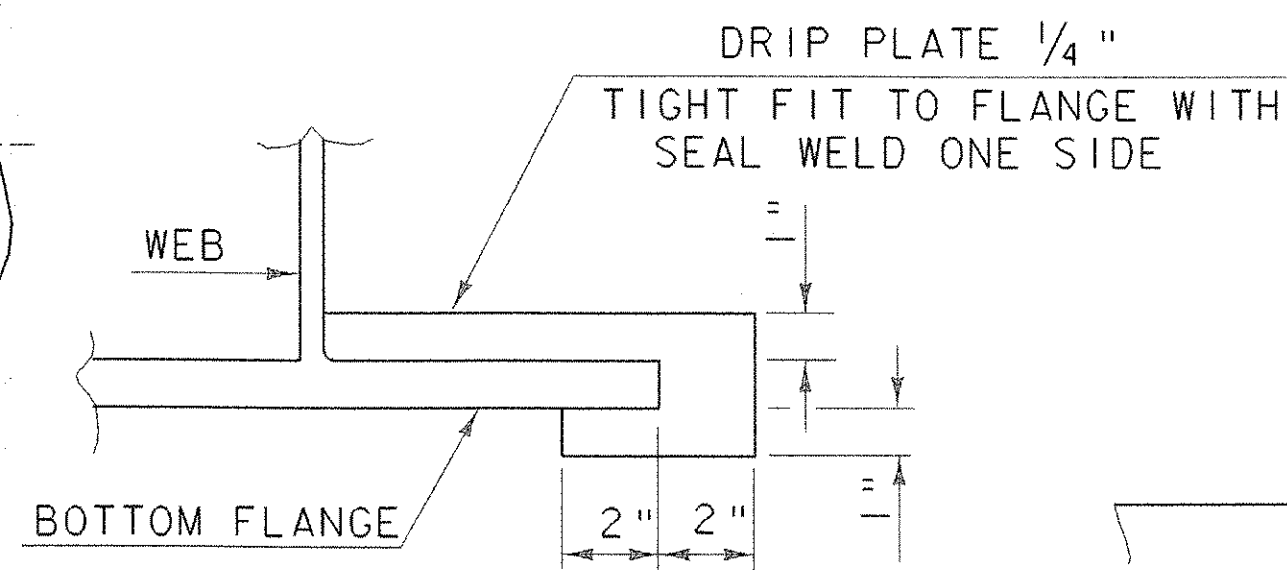

SECTION C - C


NOTE: DRIP PLATES SHALL BE PLACED ON OUTSIDE EDGE OF FASCIA GIRDERS ON THE HIGH SIDE OF ALL PIERS AND ABUTMENTS OR AS INDICATED ON PROJECT PLANS.

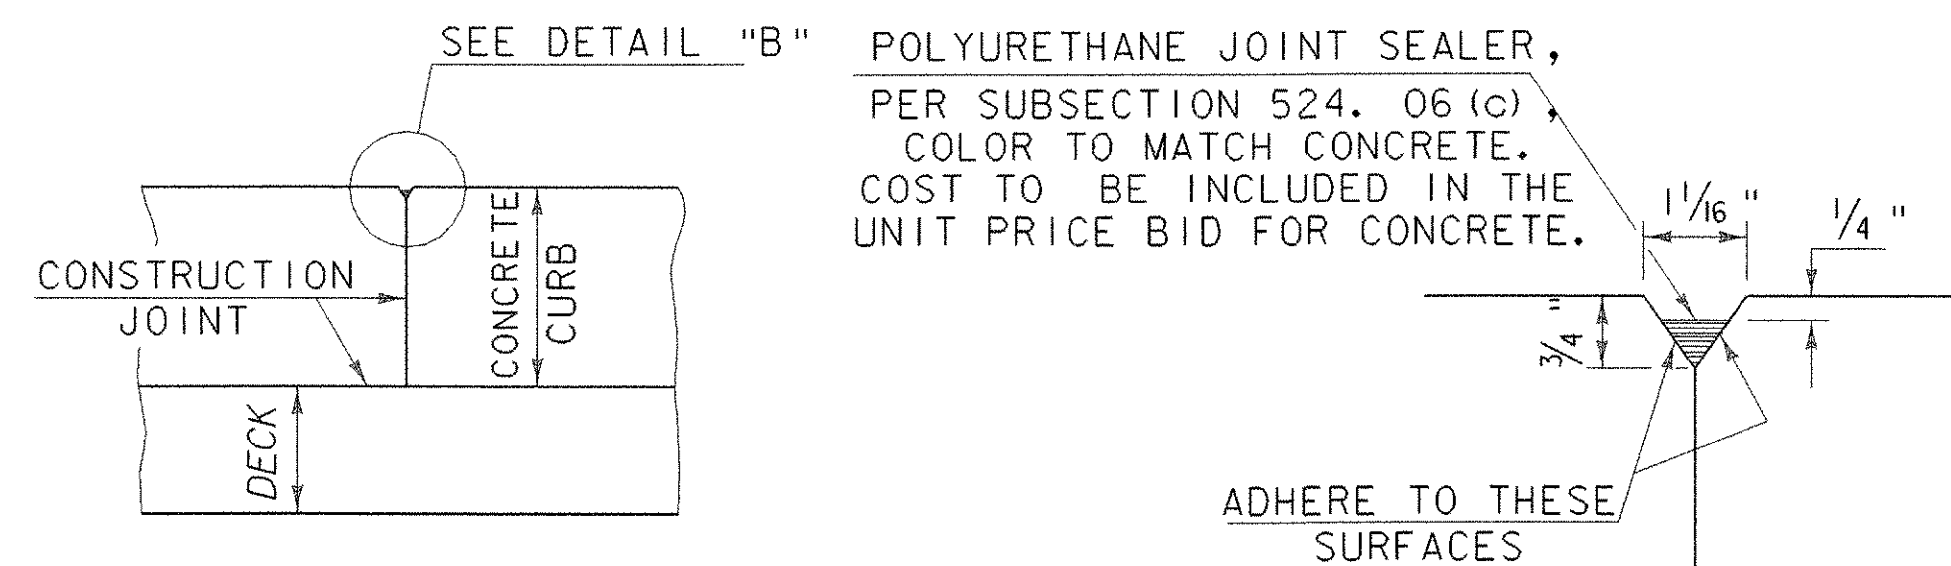


SECTION B - B

ADHERE TO THESE SURFACES


DETAIL "B"

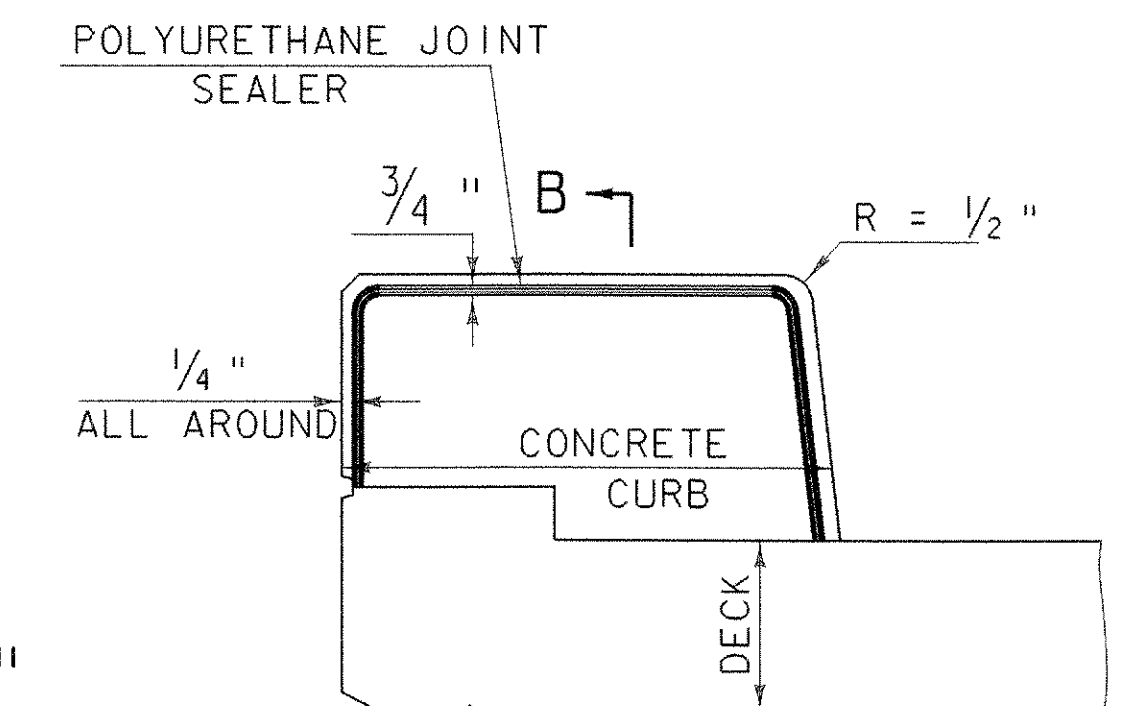

TYPICAL SECTION THROUGH CONCRETE CURB CONSTRUCTION JOINT

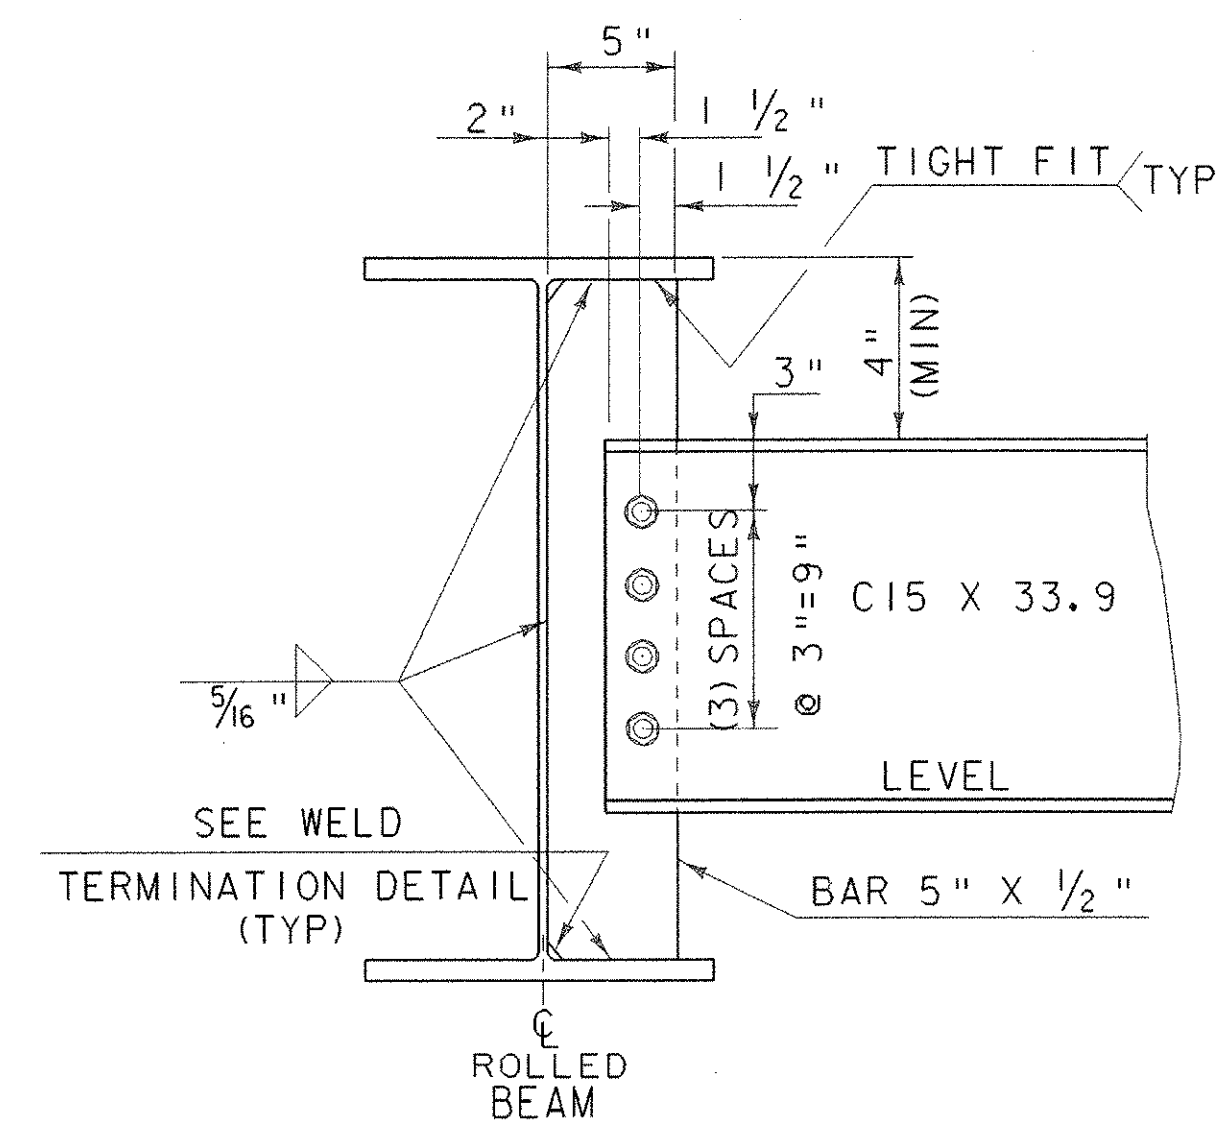


INTERMEDIATE DIAPHRAGMS FOR 24 THRU 30 INCH ROLLED BEAMS

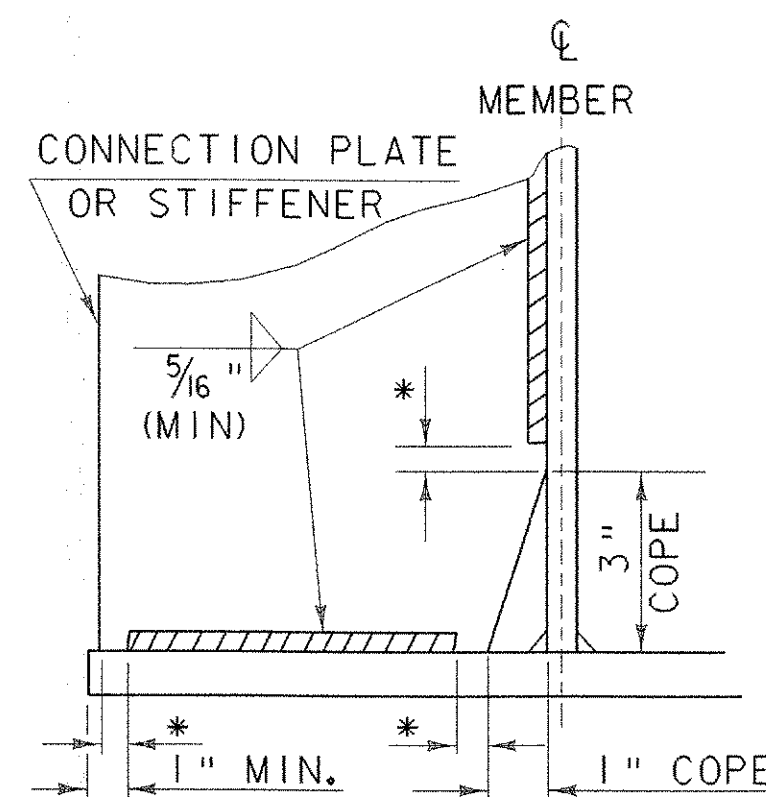

*NO WELD FOR 1/4\"/>

WELD TERMINATION AND COPING DETAILS FOR STEEL MEMBERS

- NOTES:
1. CONCRETE CURBS MAY BE PLACED IN ONE POUR FOR THE FULL LENGTH OF THE BRIDGE. IF THE CONTRACTOR ELECTS TO USE CURB CONSTRUCTION JOINTS, THE JOINTS SHALL BE CONSTRUCTED AS SHOWN IN THESE DETAILS AND NOTES #2 AND #3 SHALL BE APPLICABLE.
 2. CONSTRUCTION JOINTS THROUGH CONCRETE CURBS SHALL BE 1'-6" MINIMUM FROM THE CENTER OF THE NEAREST BRIDGE RAIL POST. CONCRETE SHALL BE PLACED IN ALTERNATING SECTIONS WITH A MINIMUM OF 48 HOURS DELAY BETWEEN ADJACENT POURS.
 3. LONGITUDINAL REINFORCING SHALL PASS THROUGH CONCRETE CURB CONSTRUCTION JOINTS.

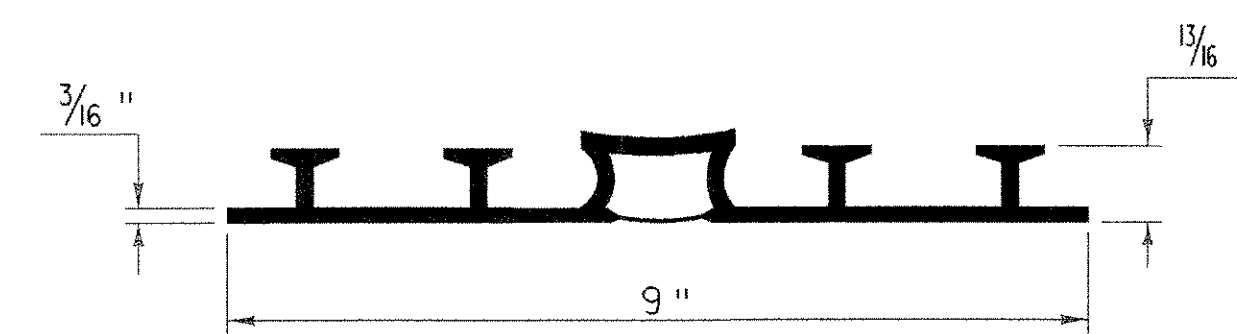

P.V.C. WATERSTOP FOR JOINTS

THE COSTS FOR P.V.C. WATERSTOP SHALL BE INCIDENTAL TO THE UNIT PRICE BID FOR CONCRETE. OTHER CONFIGURATIONS MAY BE USED UPON APPROVAL OF THE STRUCTURES ENGINEER.

STATE OF VERMONT AGENCY OF TRANSPORTATION			
Town Of	READING	Bridge No.	25
Highway No.	TH 8	Log Sta.	
		Rev. Sta.	
MISC. STEEL & CONCRETE DETAILS			
TH 8 OVER MILL BROOK			
Designed By	R. S. YOUNG	Drawn By	R. S. YOUNG
Checked By	Date	Bridge Design Supervisor	
W. B. SYMONDS	10/00	C. P. WILLIAMS	Date 10/00
PROJECT	READING	PROJECT NO.	BRZ 1444 (23)
I.G.C. Info.	M:\Projects\90\058\Structures\j058spr.dgn		
Bridge Sheet No.	sj058mdt.i	Sheet	18 of 49