


NOTE:

NF = NEAR FACE
 FF = FAR FACE
 EF = EACH FACE
 ▲ = CUT TO FIT IN FIELD
 3" CLR. UNLESS OTHERWISE SPECIFIED ON PLANS.
 ALL LAPS NOT OTHERWISE DETAILED SHALL BE 2'-2".

NOTE:


SEE END OF BRIDGE
 DETAIL ON SHEET 15.
 SECTION A-A

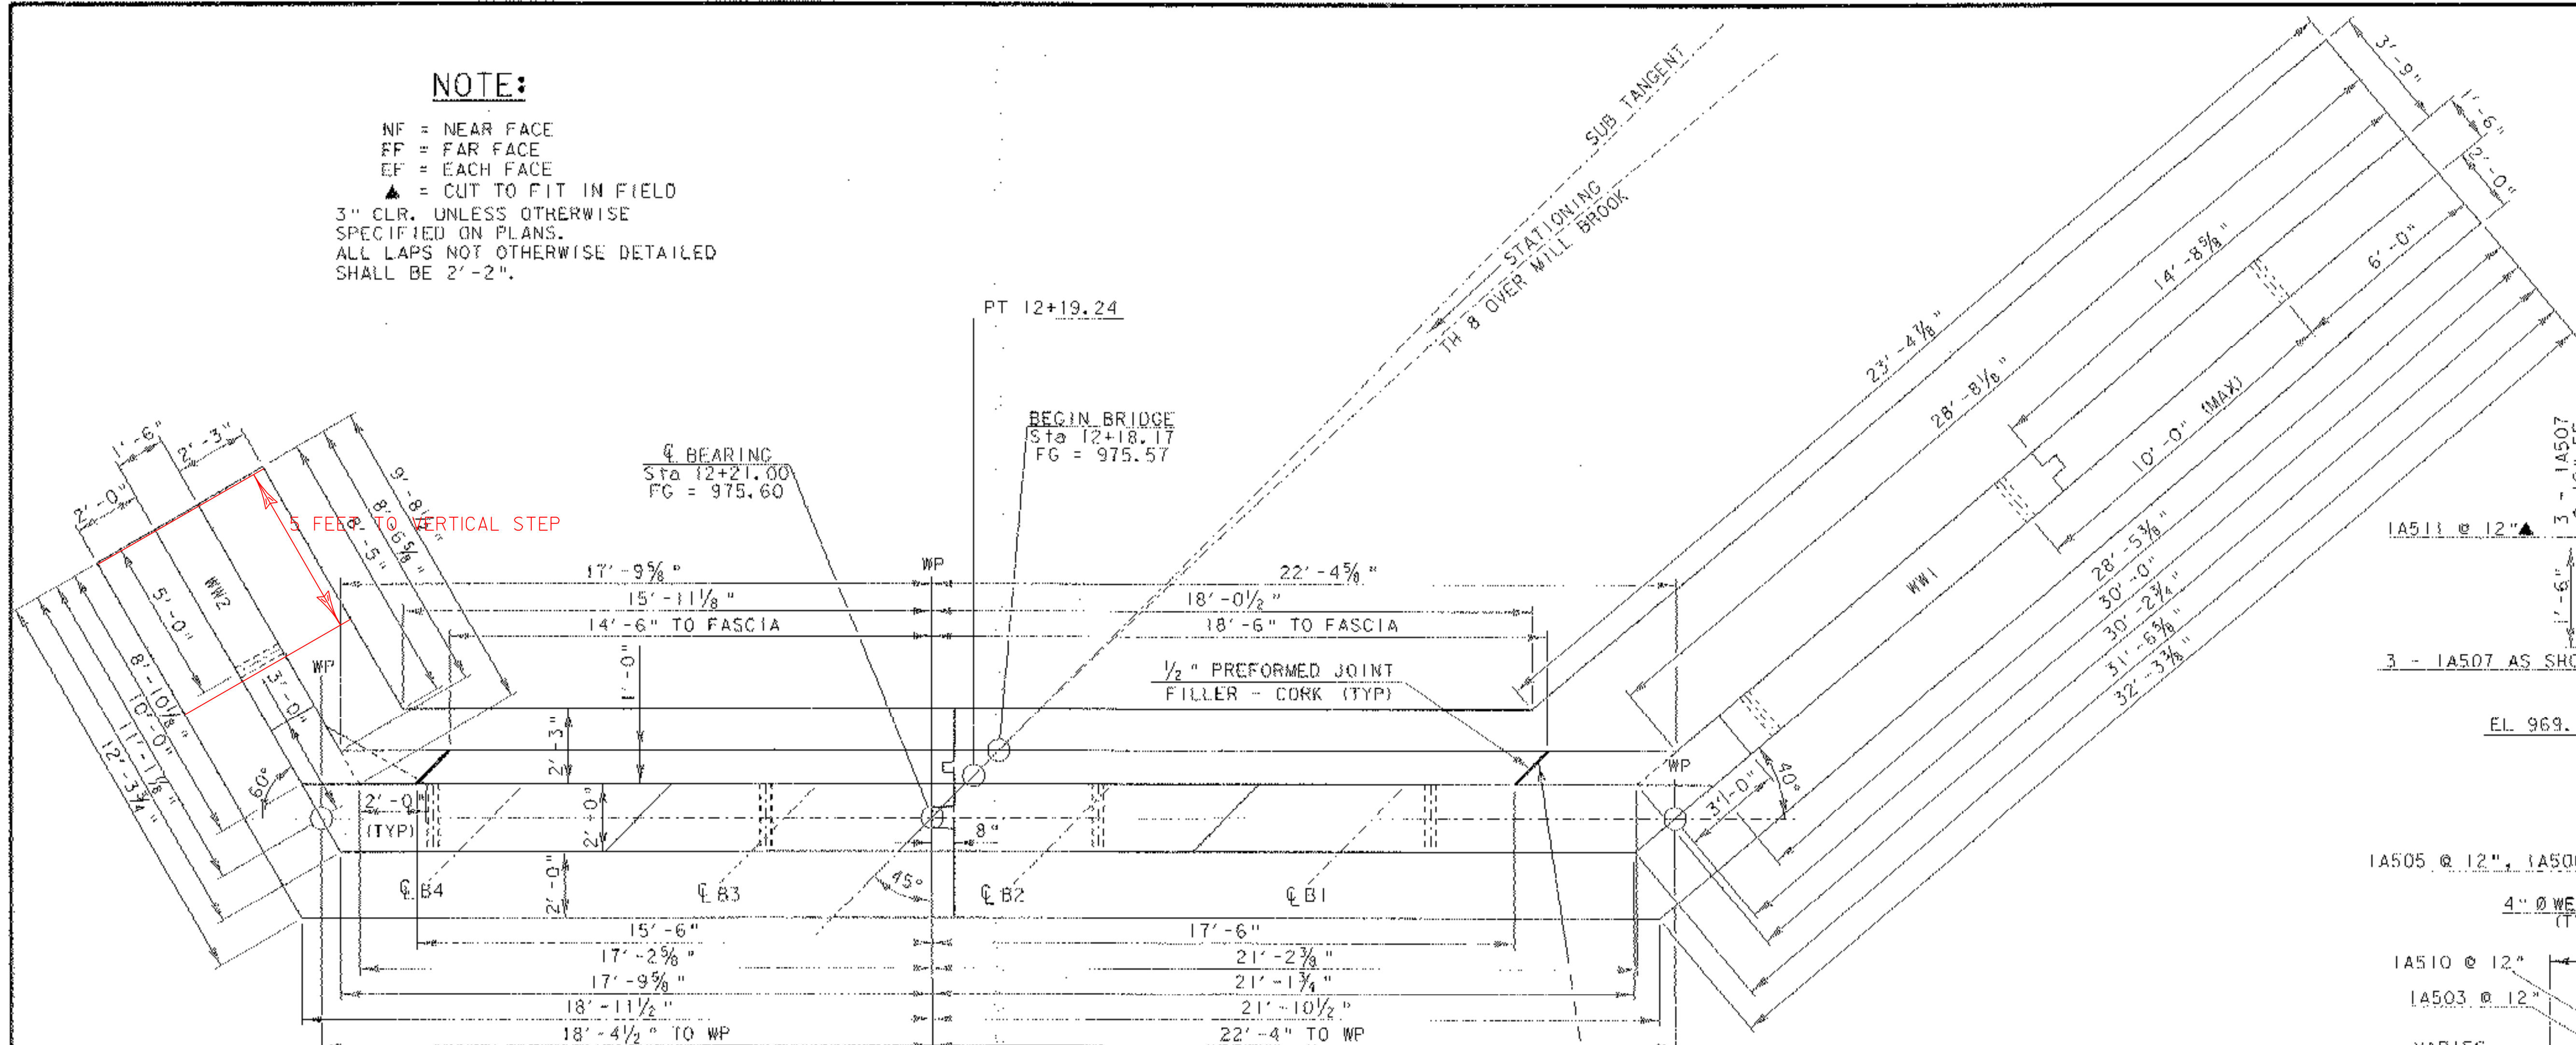

ABUTMENT #1 PLAN


SCALE 3/8" = 1'-0"

FLOW

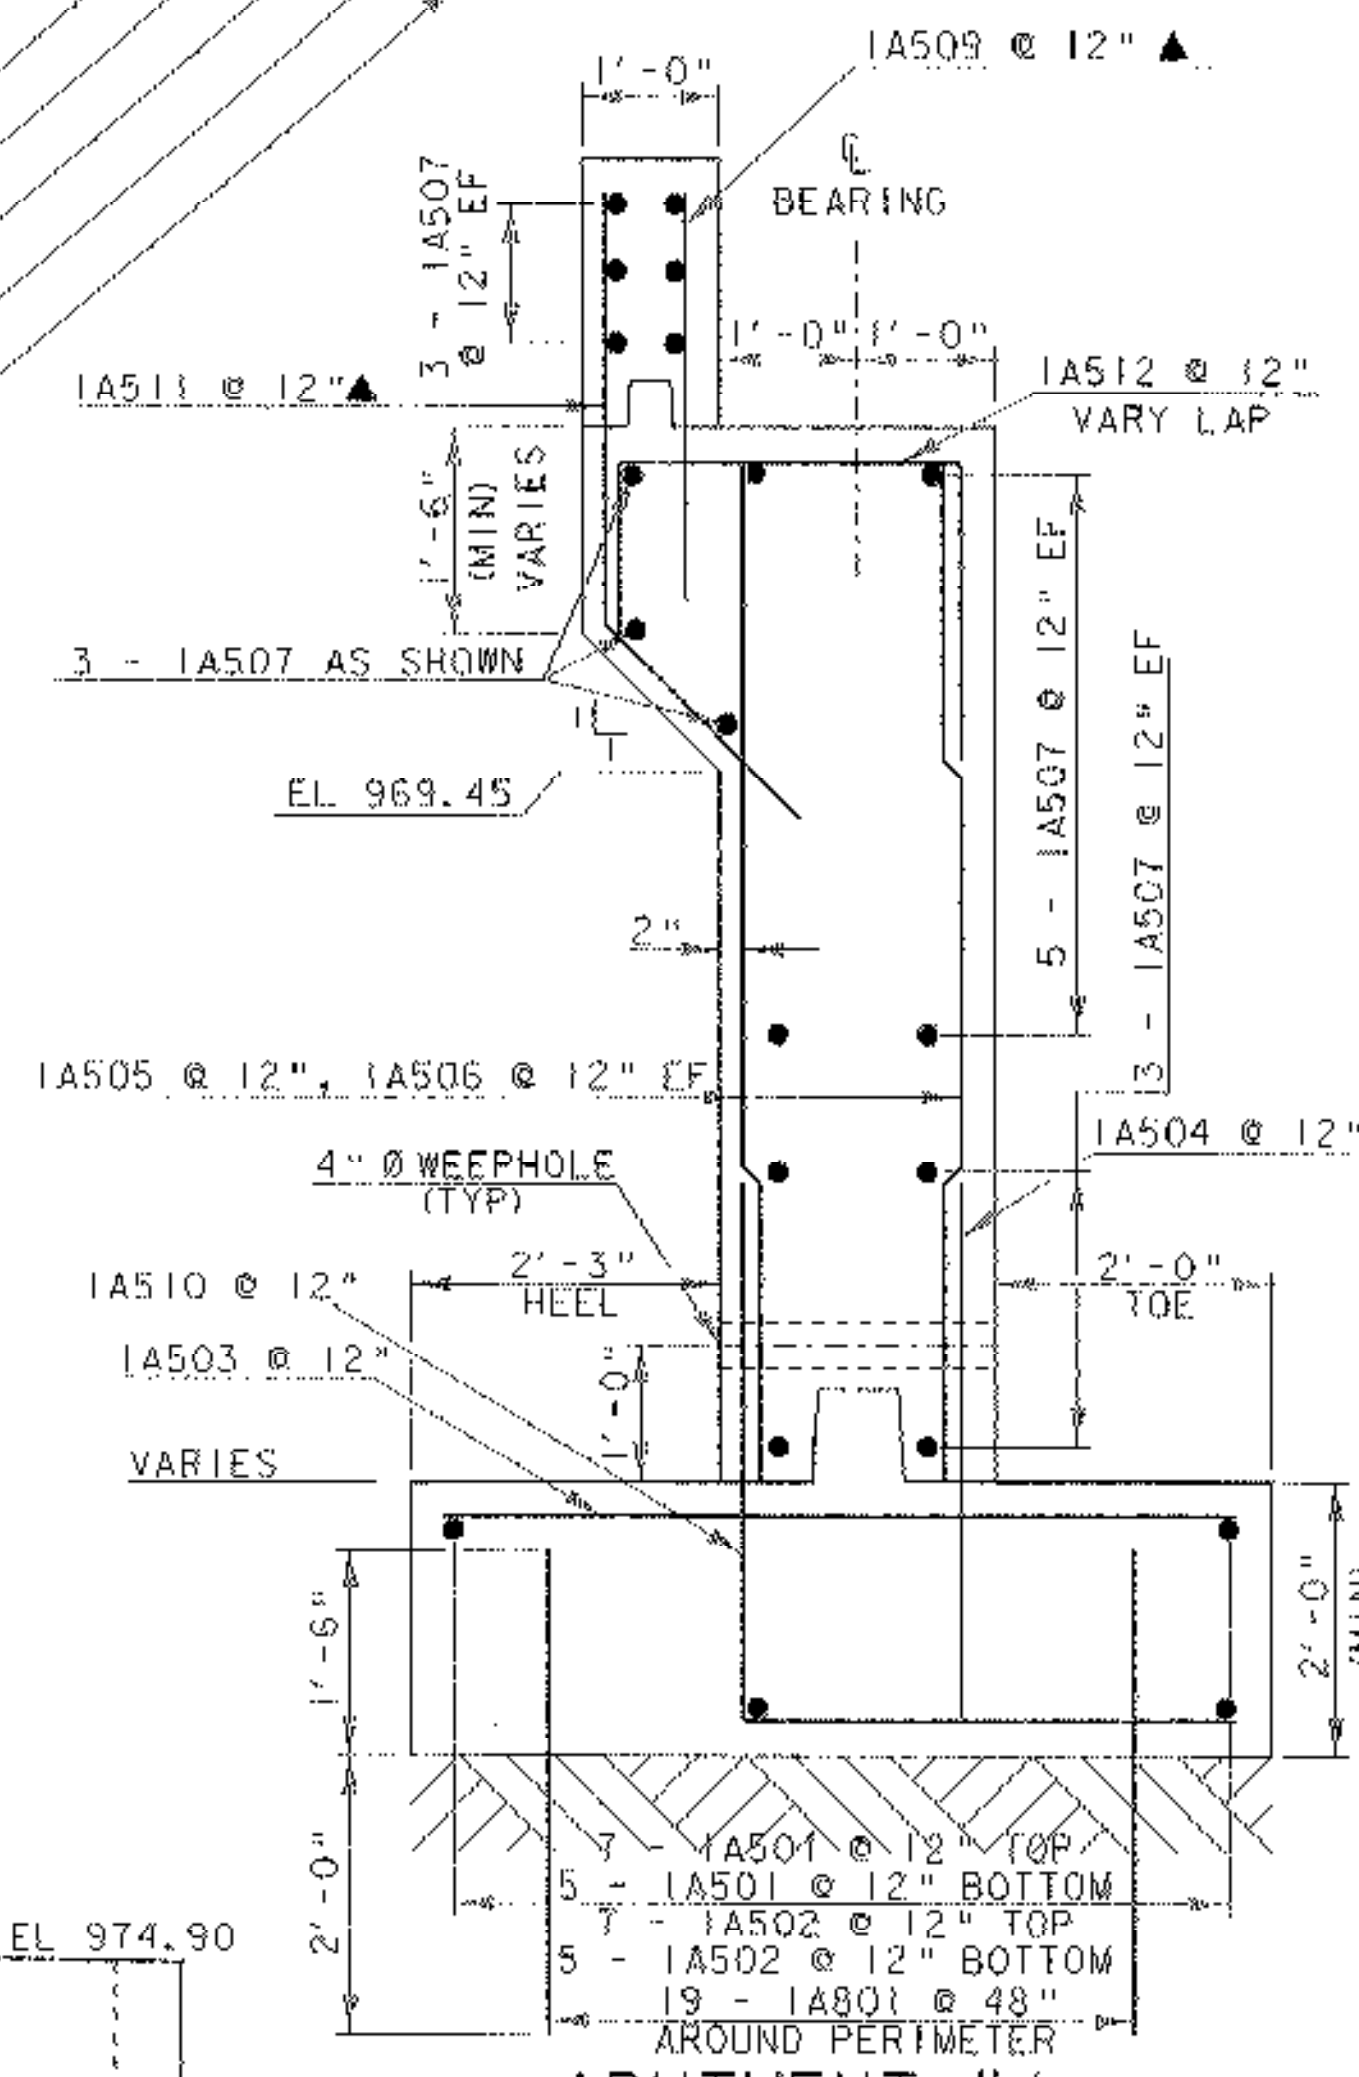

ABUTMENT #1 TYPICAL SECTION

SCALE 3/4" = 1'-0"

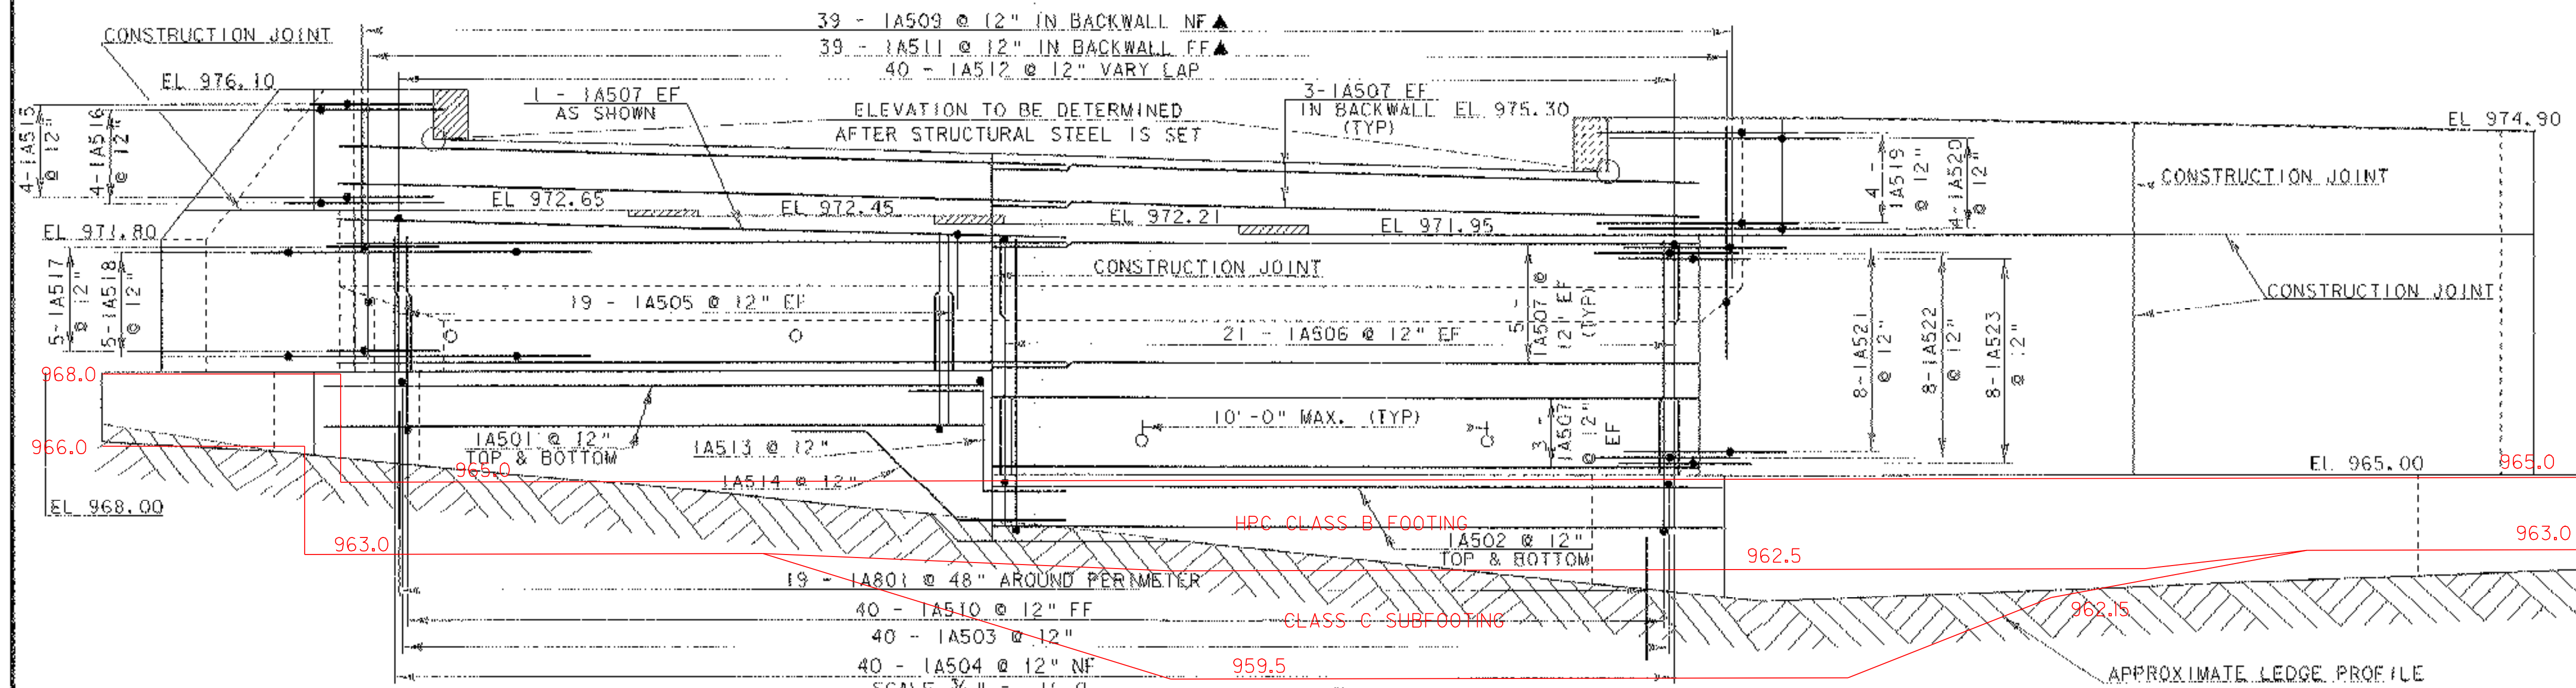

ABUTMENT #1 ELEVATION

SCALE 3/8" = 1'-0"

APPROXIMATE LEDGE PROFILE

STATE OF VERMONT AGENCY OF TRANSPORTATION	
Town of READING	Bridge No. 25
Highway No. TH 8	Log Sta. Surv. Sta.
ABUTMENT #1 DETAILS	
TH 8 OVER MILL BROOK	
Designed By R. S. YOUNG	Drawn By P. G. JARVIS
Checked By R. S. YOUNG	Bridge Design Supervisor C. P. WILLIAMS
Date 10/00	Date 10/00
PROJECT READING	PROJECT NO. BRZ 1444 (23)
I:\G.C. Info. M\Projects\901058\Structure\901058sub.dgn	
Bridge Sheet No. s\058ab1.i	Sheet 20 of 49