


NOTE:

NF = NEAR FACE
 FF = FAR FACE
 EF = EACH FACE
 ▲ = CUT TO FIT IN FIELD
 3" CLR. UNLESS OTHERWISE SPECIFIED ON PLANS.
 ALL LAPS NOT OTHERWISE DETAILED SHALL BE 2'-2".


NOTE:

SEE END OF BRIDGE DETAIL ON SHEET 15. SECTION A-A

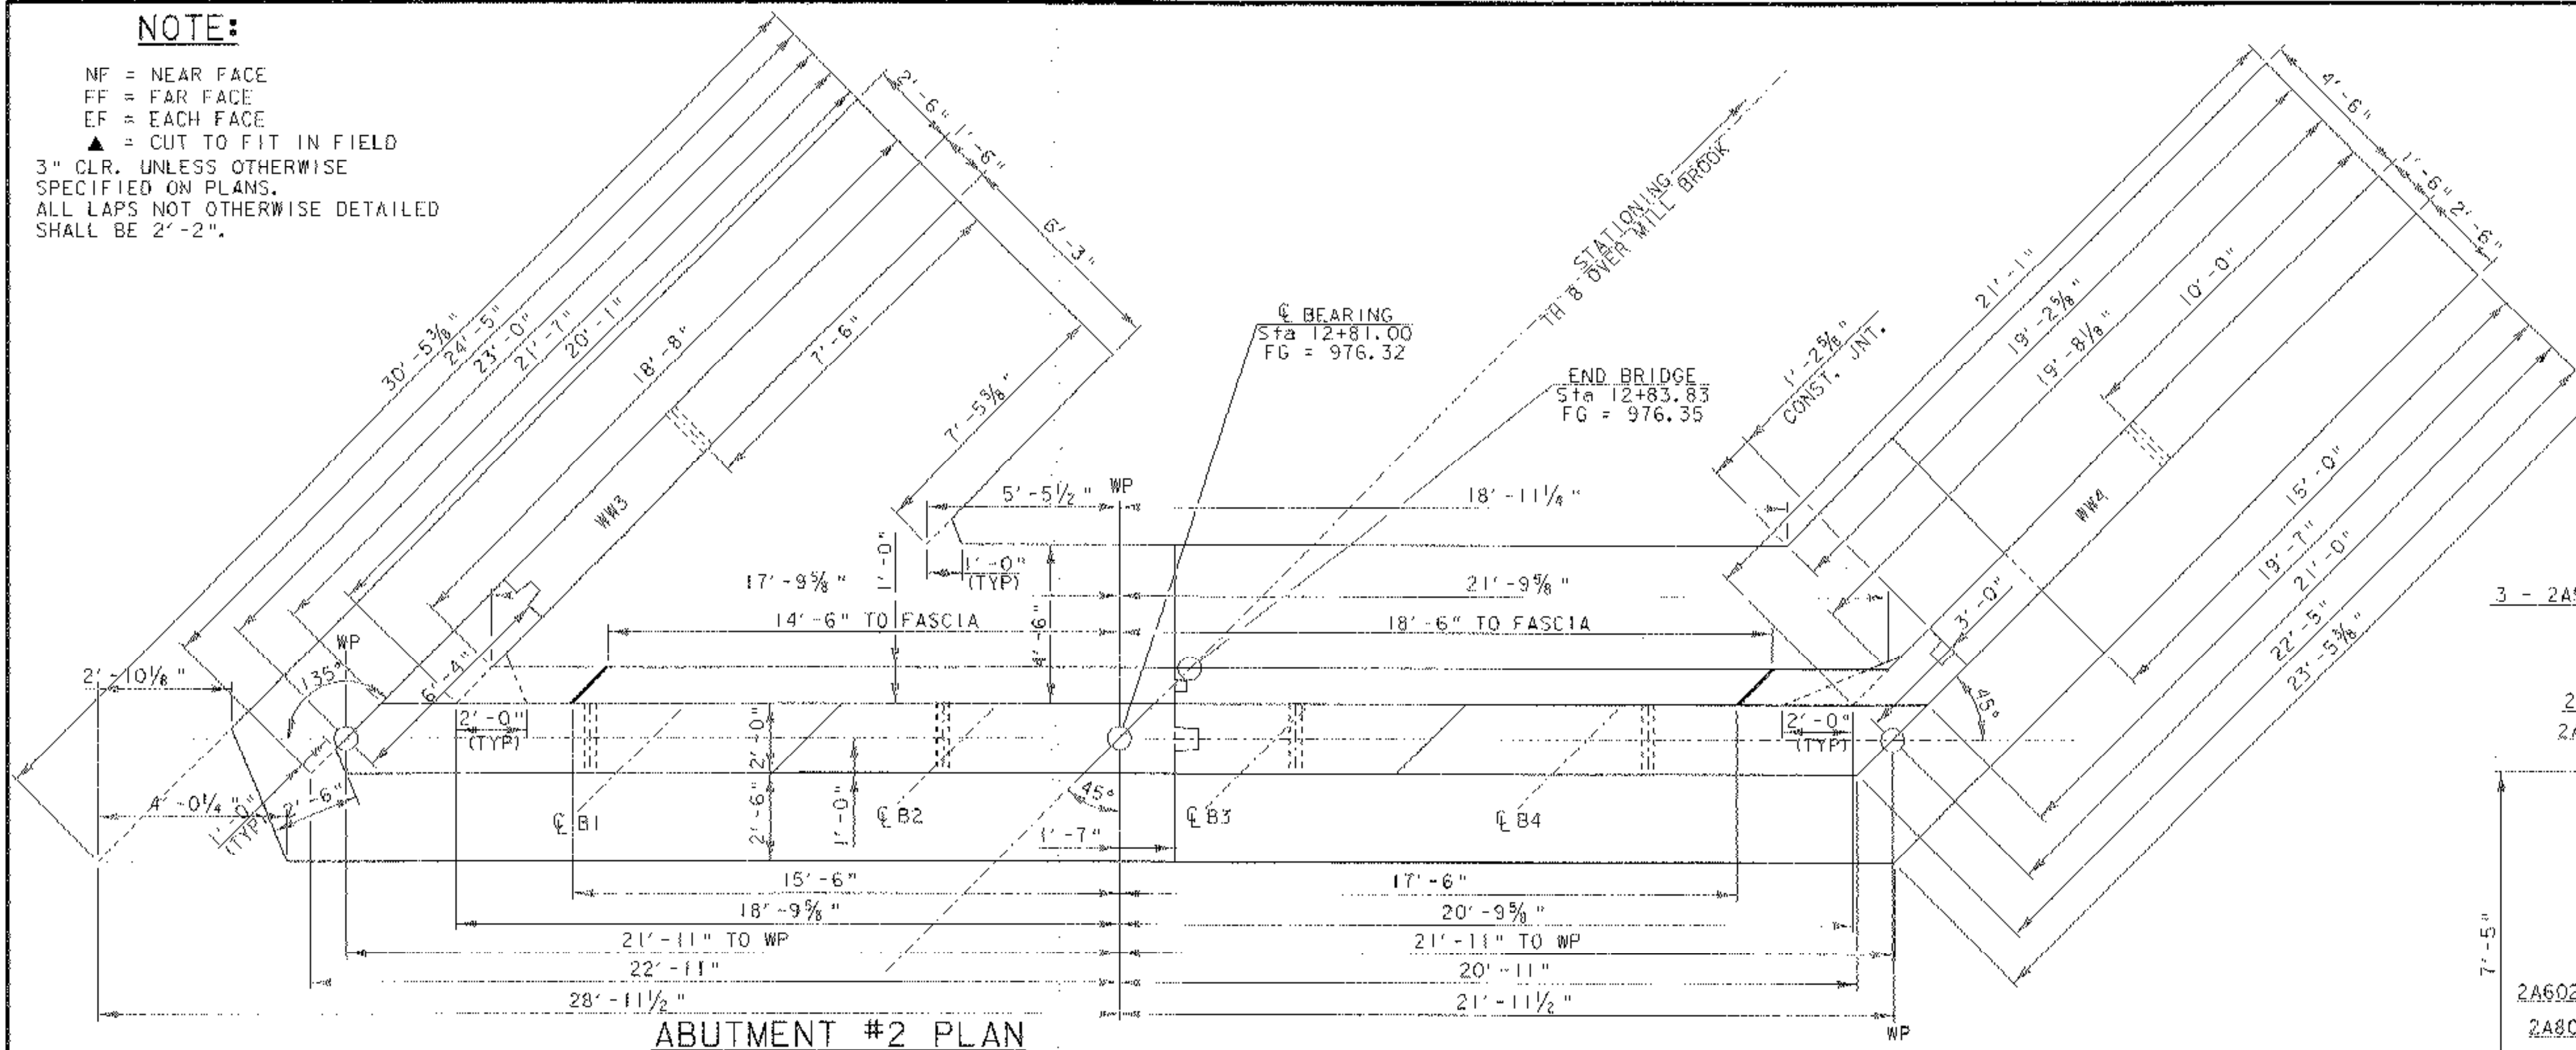


ABUTMENT #2 PLAN

SCALE 3/8" = 1'-0"

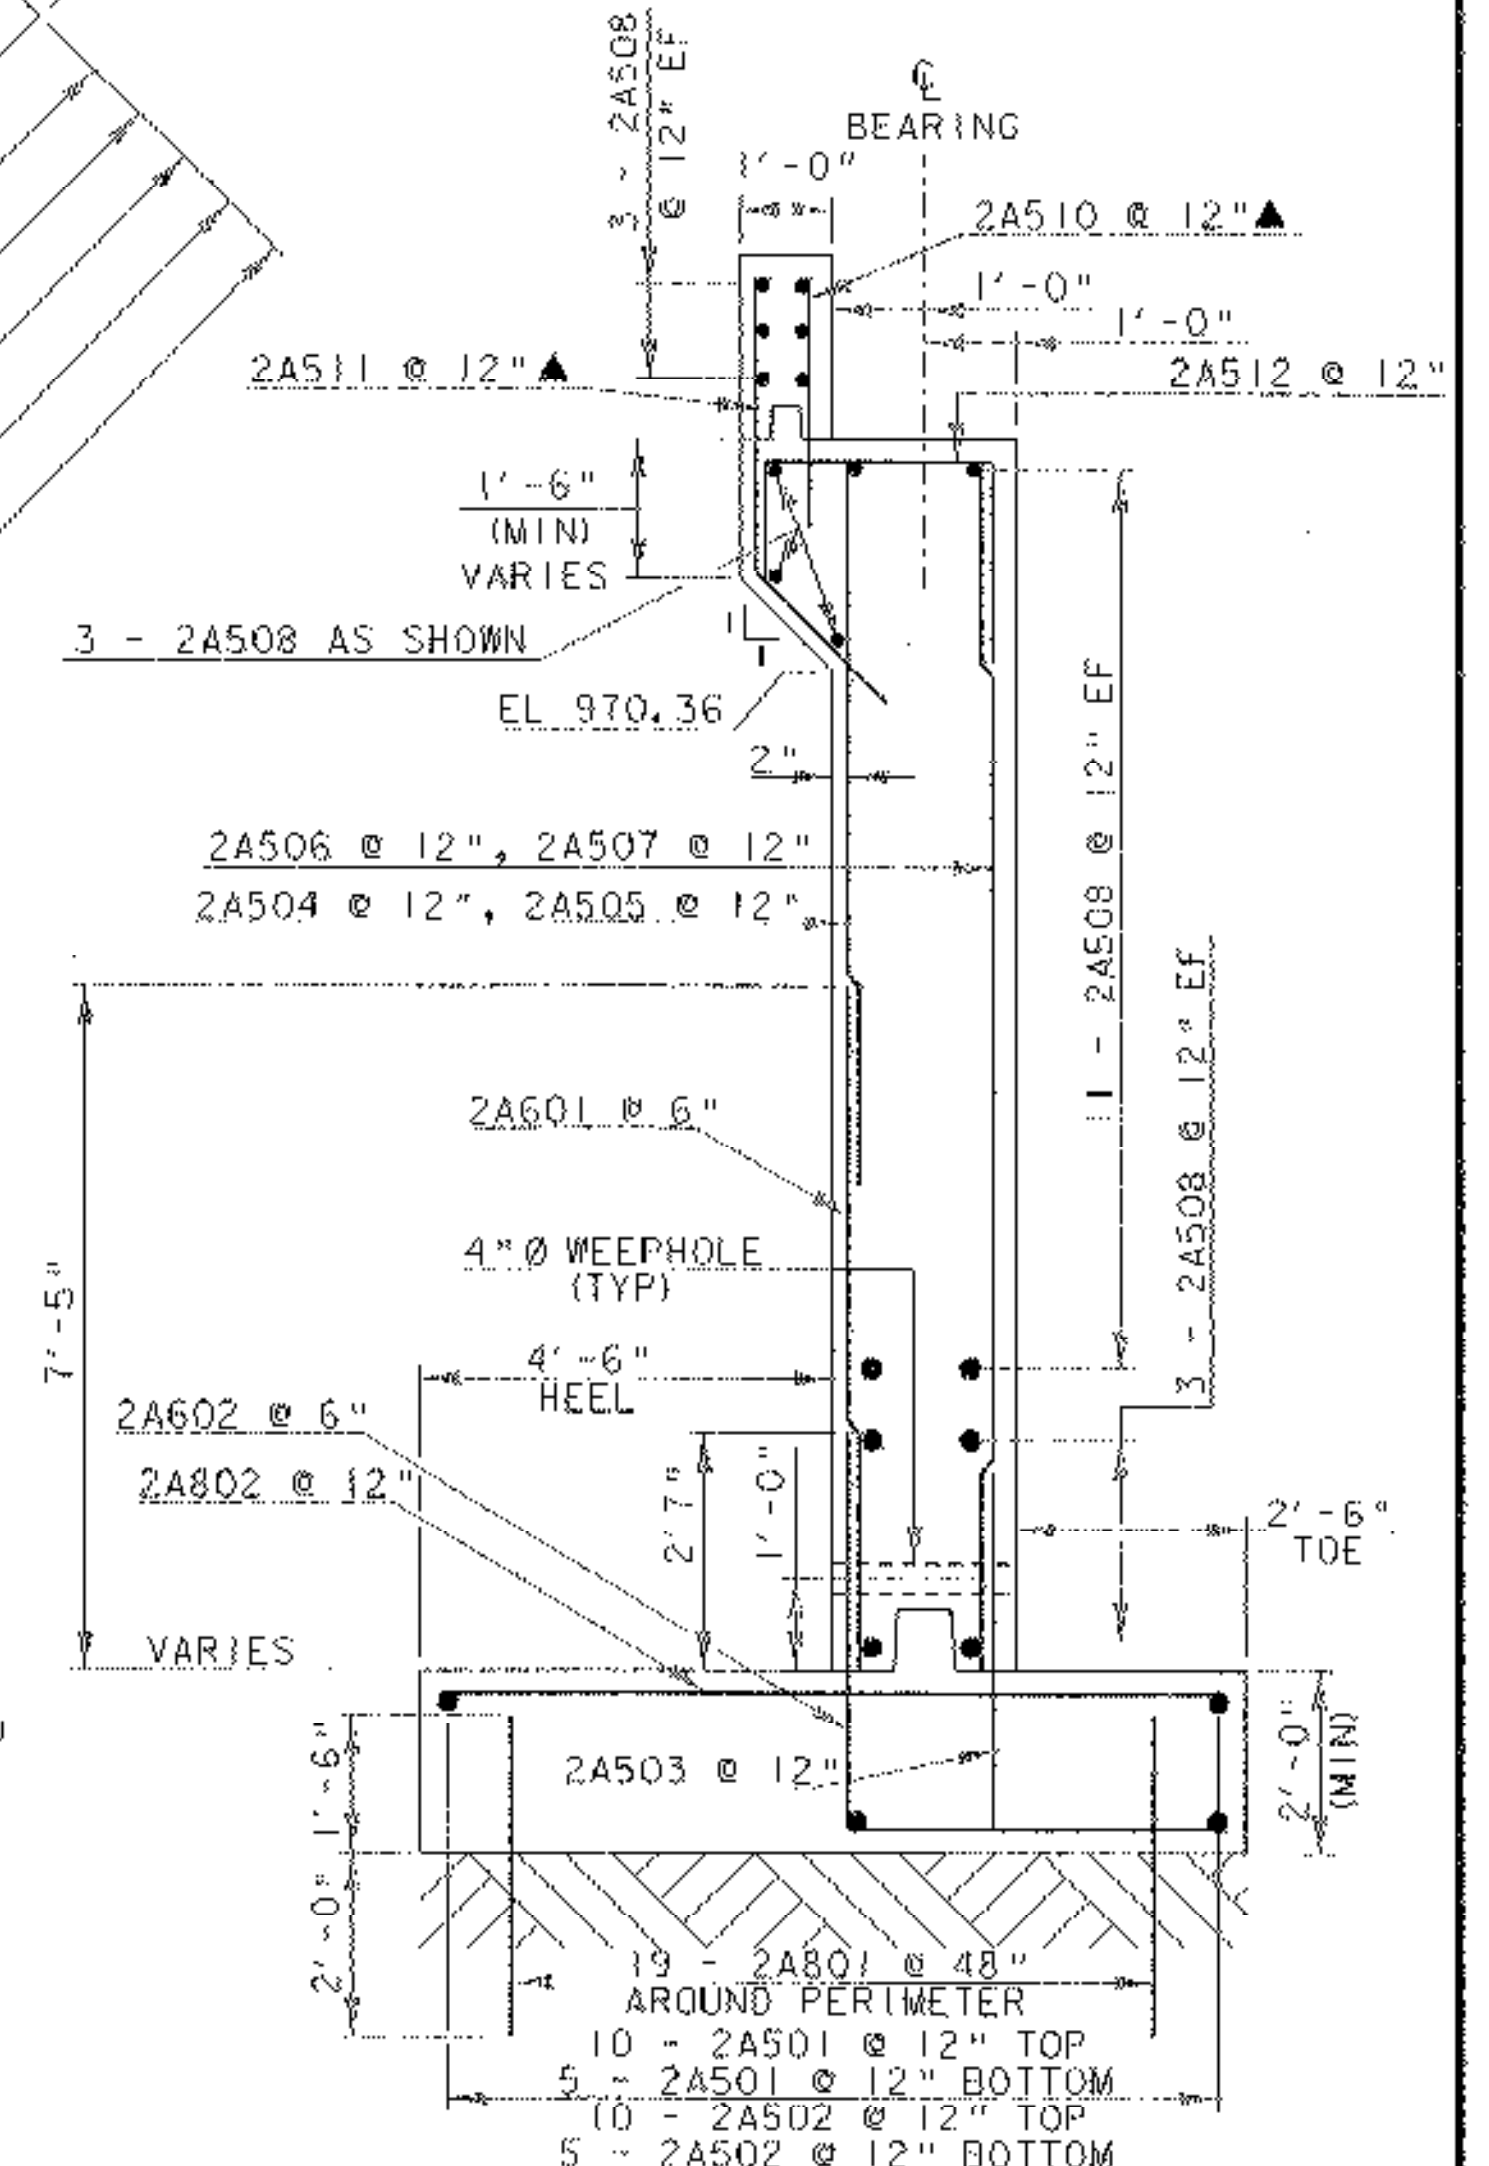

ABUTMENT #2 TYPICAL SECTION

SCALE 1/2" = 1'-0"

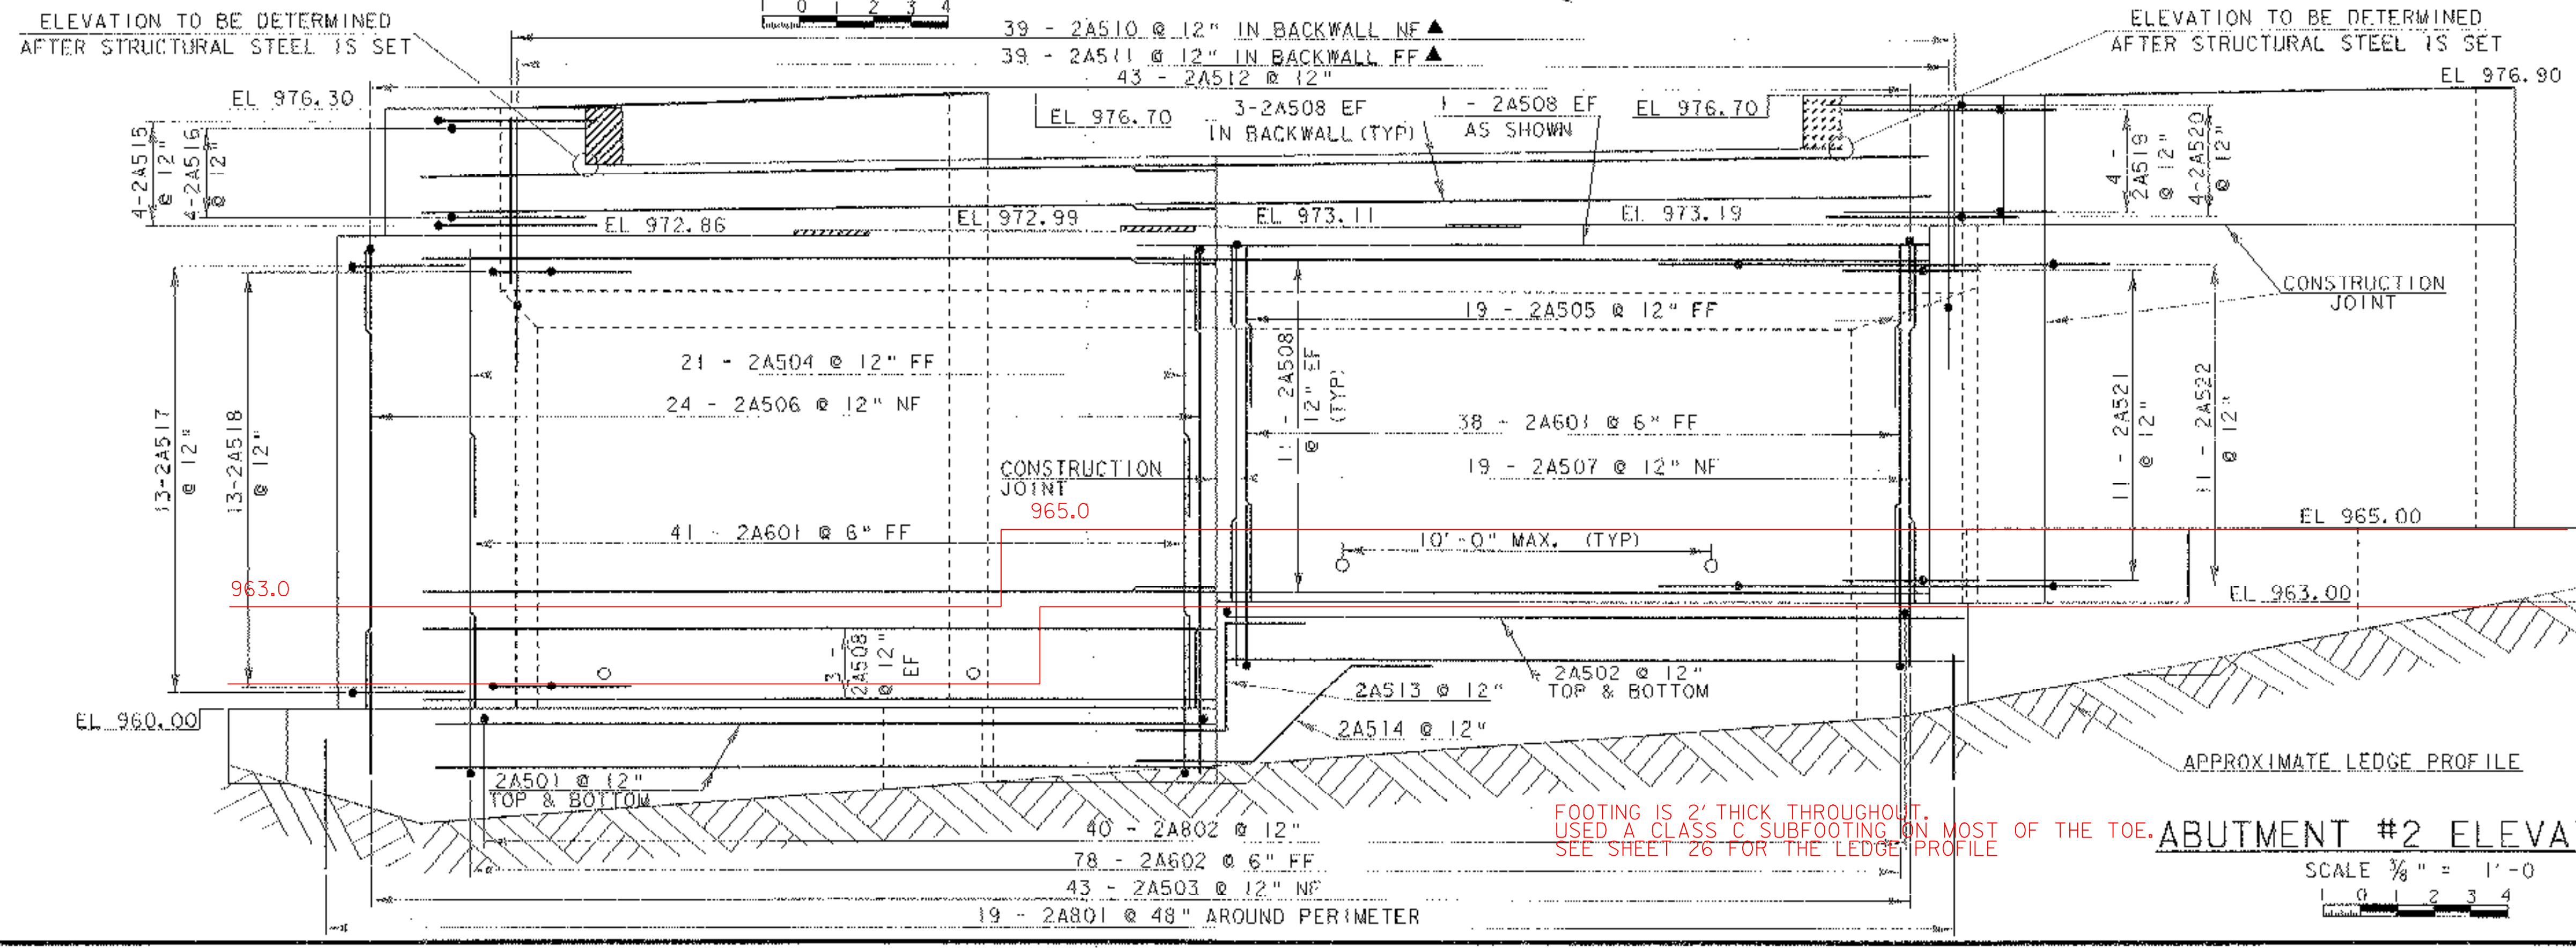

ABUTMENT #2 ELEVATION

SCALE 3/8" = 1'-0"

STATE OF VERMONT AGENCY OF TRANSPORTATION			
Town Of	READING	Bridge No.	25
Highway No.	TH 8	Log Sta.	
		Surv. Sta.	
ABUTMENT #2 DETAILS			
TH 8 OVER MILL BROOK			
Designed By	R. S. YOUNG	Drawn By	P. G. JARVIS
Checked By	Date	Bridge Design Supervisor	
	R. S. YOUNG 10/00	C. P. WILLIAMS	Date 10/00
PROJECT	READING	PROJECT NO.	BRZ 1444 (23)
L.C. Info. M:\Projects\901058\Structures\1058sub.dgn			
Bridge Sheet No.	s\j058ab2.i	Sheet	21 of 49