


ABUTMENT #1 PLAN

SCALE 3/8" = 1'-0"
 1 0 1 2 3 4

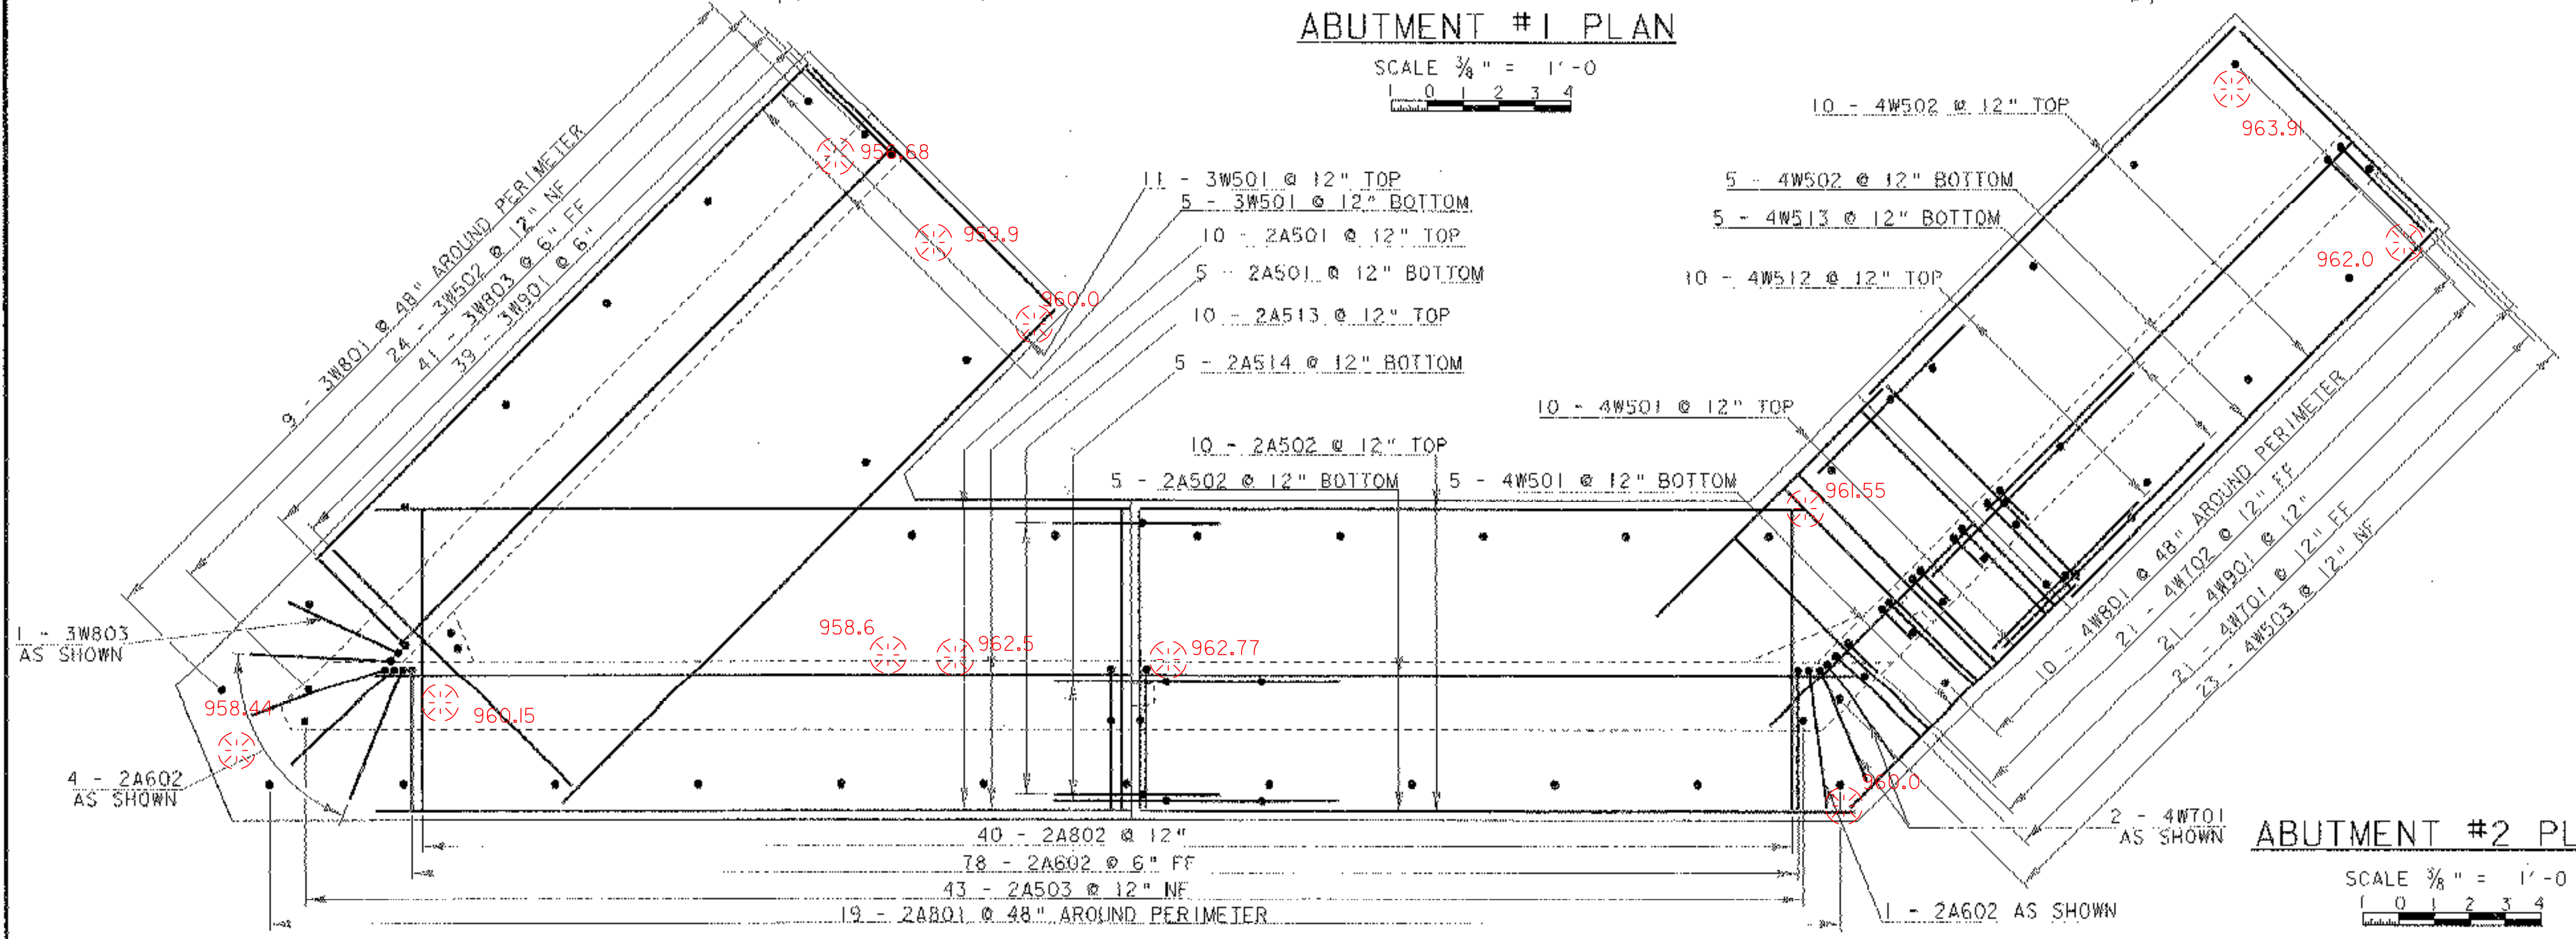

ABUTMENT #2 PLAN

SCALE 3/8" = 1'-0"
 1 0 1 2 3 4

NOTE:

- NF = NEAR FACE
- FF = FAR FACE
- EF = EACH FACE
- ▲ = CUT TO FIT IN FIELD
- 3" CLR. UNLESS OTHERWISE SPECIFIED ON PLANS.
- ALL LAPS NOT OTHERWISE DETAILED SHALL BE 2'-2".

STATE OF VERMONT AGENCY OF TRANSPORTATION			
Town Of	READING	Bridge No.	25
Highway No.	TH 8	Log. Sta.	
		Surv. Sta.	
FOOTING REINFORCING DETAILS			
TH 8 OVER MILL BROOK			
Designed By	R. S. YOUNG	Drawn By	P. G. JARVIS
Checked By	Date	Bridge Design Supervisor	
	R. S. YOUNG 7/99	C. P. WILLIAMS Date 7/99	
PROJECT	READING	PROJECT NO.	BRZ 1444 (23)
I.C.C. Info. M:\Projects\90\058\Structures\058sub.dgn			
Bridge Sheet No.	sj058ftg.i	Sheet	26 of 49