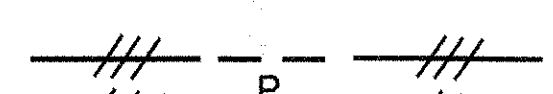
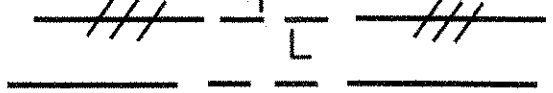
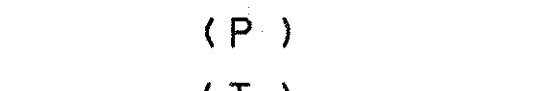



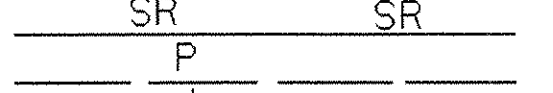





TABLE OF PROJECT PROPERTY ACQUISITION

**STATE OF VERMONT
AGENCY OF TRANSPORTATION
RIGHT OF WAY PLANS
DETAIL SHEET**

PARCEL NO.	GRANTOR	SHEET NO.	BEGINNING STATION	ENDING STATION	TAKING	REM.	RIGHTS	TITLE TAKEN	DATE	TOWN OR CITY RECORDED	BK.	PG.	REMARKS	REVISION NO.	SHEET	DESCRIPTION OF REVISION	DATE	MADE BY	APPROVED BY
1	WALSH, ROBERT P.	8	9+37 LT. 9+37 LT. 9+37 LT. 10+26 LT. 10+80 LT. 12+68 LT. 12+97 LT. 13+05 LT. 13+50 LT. 13+40 LT. 13+83 LT. 10+41 LT. 11+50 LT.	14+28 LT. 11+20 LT. 13+75 LT. 11+75 LT. 12+87 LT. 13+73 LT. 13+30 LT. 13+60 LT. 13+86 LT. 11+50 LT. 11+63 LT.	0.22A±		CUT & TRIM (P) 1480 S.F. ± RESET (T) INSTALL (T) DITCH & DRAINAGE (P) INSTALL (T) INSTALL (T) INSTALL (T) INSTALL (T) DRIVE (T) CULVERT (T) INSTALL (P) SLOPE (T) 660 S.F. ± CHANNEL (P) 18 S.F. ±			READING			POWER LINE BARBWIRE FENCE SILT FENCE SILT FENCE SILT FENCE SEDIMENT BASIN 12' GRAVEL ALSO R.O.W. TO PARCEL #4. GUY WIRE	1	7, 8	PARCEL NO. 2 HEIFFEL. CHANGE TITLE TO: SILVESTER, JOHN H. & LISA A. PER C.O. 9097 ELECTRONIC IPARMS TO STRUCTURES 2-12-01	03-09-00	M. J. R.	L. W. B.
2	SILVESTER, JOHN H. LISA A.	8	12+45 RT. 11+25 RT. 12+10 RT. 12+27 RT. 12+52 RT. 12+71 RT. 12+90 RT. 12+00 RT. 13+00 RT.	13+11 RT. 12+56 RT. 13+28 RT. 12+67 RT. 12+83 RT. 13+00 RT. 12+68 RT. 13+11 RT.	660 S.F. ±		INSTALL (T) CUT & TRIM (P) 1150 S.F. ± INSTALL (P) INSTALL (P) INSTALL (T) INSTALL (T) DRIVE (T)	WDOE	11-14-00	READING	60	270-271	PAVED DRIVE SILT FENCE POWER LINE GUY WIRE GUY WIRE SILT FENCE 10' GRAVEL STONE WALL						
3A	RECH, MARY F. & MELVYN	8	13+60 LT. 13+67 LT. 13+88 LT. 13+98 LT. 14+05 LT.	13+77 LT. 13+94 LT. 14+44 LT. 14+01 LT. 14+15 LT.			SLOPE (T) 50 S.F. ± INSTALL (T) CUT & TRIM (P) 375 S.F. ± INSTALL (P) INSTALL (P)	WDOE	10-25-00	READING	60	141-142	SILT FENCE POWER LINE GUY WIRE GUY WIRE						
3B		8	13+20 RT. 13+25 RT. 13+42 RT.	13+45 RT. 15+25 RT. 15+20 RT.			CUT & TRIM (P) 100 S.F. ± INSTALL (T) CHANNEL (P) 1220 S.F. ±						POWER LINE SILT FENCE						
4	ALLEN, HAROLD D. & GERMAINE M.	8	9+37 LT. 9+37 LT. 13+50 LT.	9+55 LT. 9+55 LT.	18 S.F. ±		ALL R. T. & I. CUT & TRIM (P) 190 S.F. ± DRIVE (T)	WDOE	10-02-00	READING	60	30-31	POWER LINE R.O.W. OVER PARCEL #1						
5	CVPS CORPORATION												UTILITY						
6	BELL-ATLANTIC												UTILITY						

<p>1444023 200 1805 HP</p> <p>ACCT.mccasidy M:\Projects\90J058\RightOfWay\1058cd.dgn DATE PLOTTED 13-FEB-2008</p>	<p>DR. (P)- DRAINAGE RIGHT DIT. (P)- DITCHING RIGHT CH. (P)- CHANNEL RT. DRIVE (T)- DRIVE RIGHT CUL. (P)- CULVERT RIGHT [W]- WATER SOURCES</p>	<p>PRESENT R.O.W.  TAKING WITHOUT ACCESS  TAKING WITHOUT ACCESS ALONG PROPERTY LINE  TAKING WITH ACCESS  PERMANENT EASEMENT  TEMPORARY EASEMENT</p>	<p>LEGEND . . . CZ (P) CLEAR ZONE  CONST. (T) CONSTRUCTION EASEMENT  SR SLOPE RIGHTS  P PROPERTY LINE  TOP OF CUT  TOE OF SLOPE</p>	<p>R. O. W. PLANS</p> <p align="center">READING BRZ 1444 (23)</p> <p>R. O. W. SHEET 7 OF 8 SHEETS SHEET 29 OF 49</p> <p>APPROVED: <u>LAWRENCE W. BLISS</u> DATE: <u>07-07-98</u> AGENT D, PLANS & TITLES</p>
---	--	--	---	--