


NEW 18" OPTION PIPE
AND PIPE END SECTION WITH TOE PLATE
STA. 10+80 16' RT. TO 32' LT

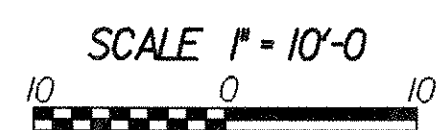

SEE SHEET 43 FOR DRIVE
SECTION AT STA 11+25

PROJECT: READING	PROJECT NO.: BRZ 1444(23)
DESIGN FILE NAME: /usr/str4/90j058/sj058msc.dgn	PLOT DATE: 13-FEB-2008
IPARM FILE NAME: /str4/90j058/sj058mx2.i	
MAINLINE SECTIONS 10+80 THRU 12+00	
SHEET: 39 OF 49	