

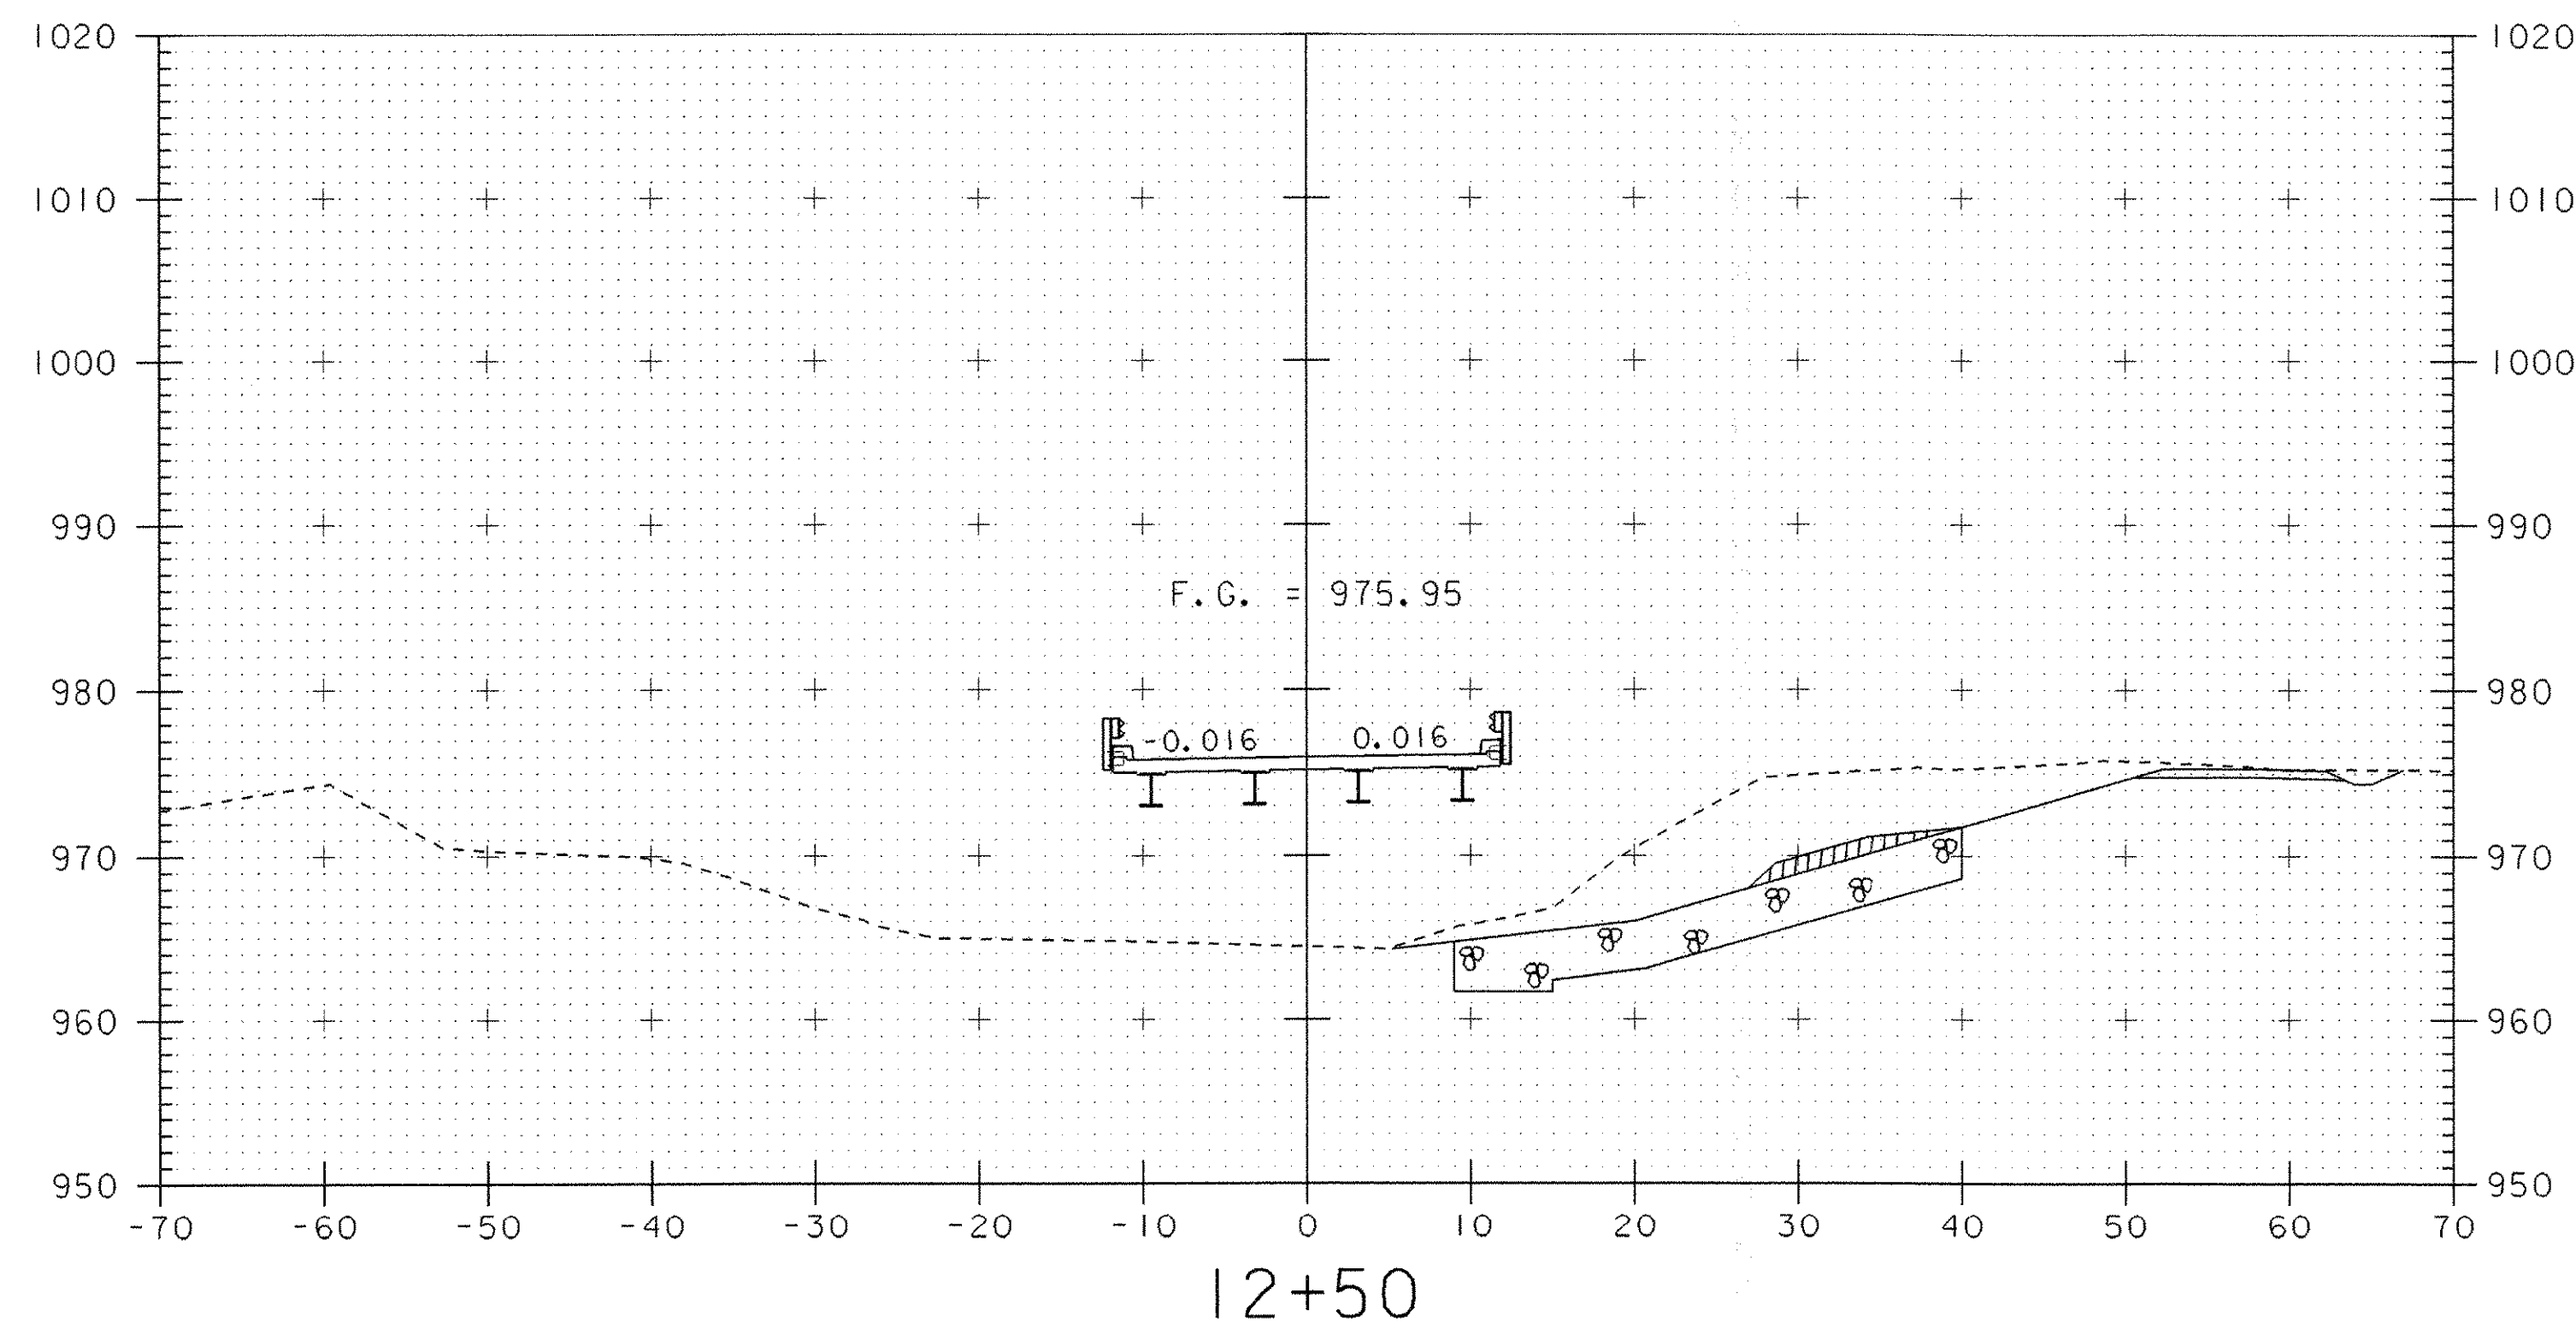
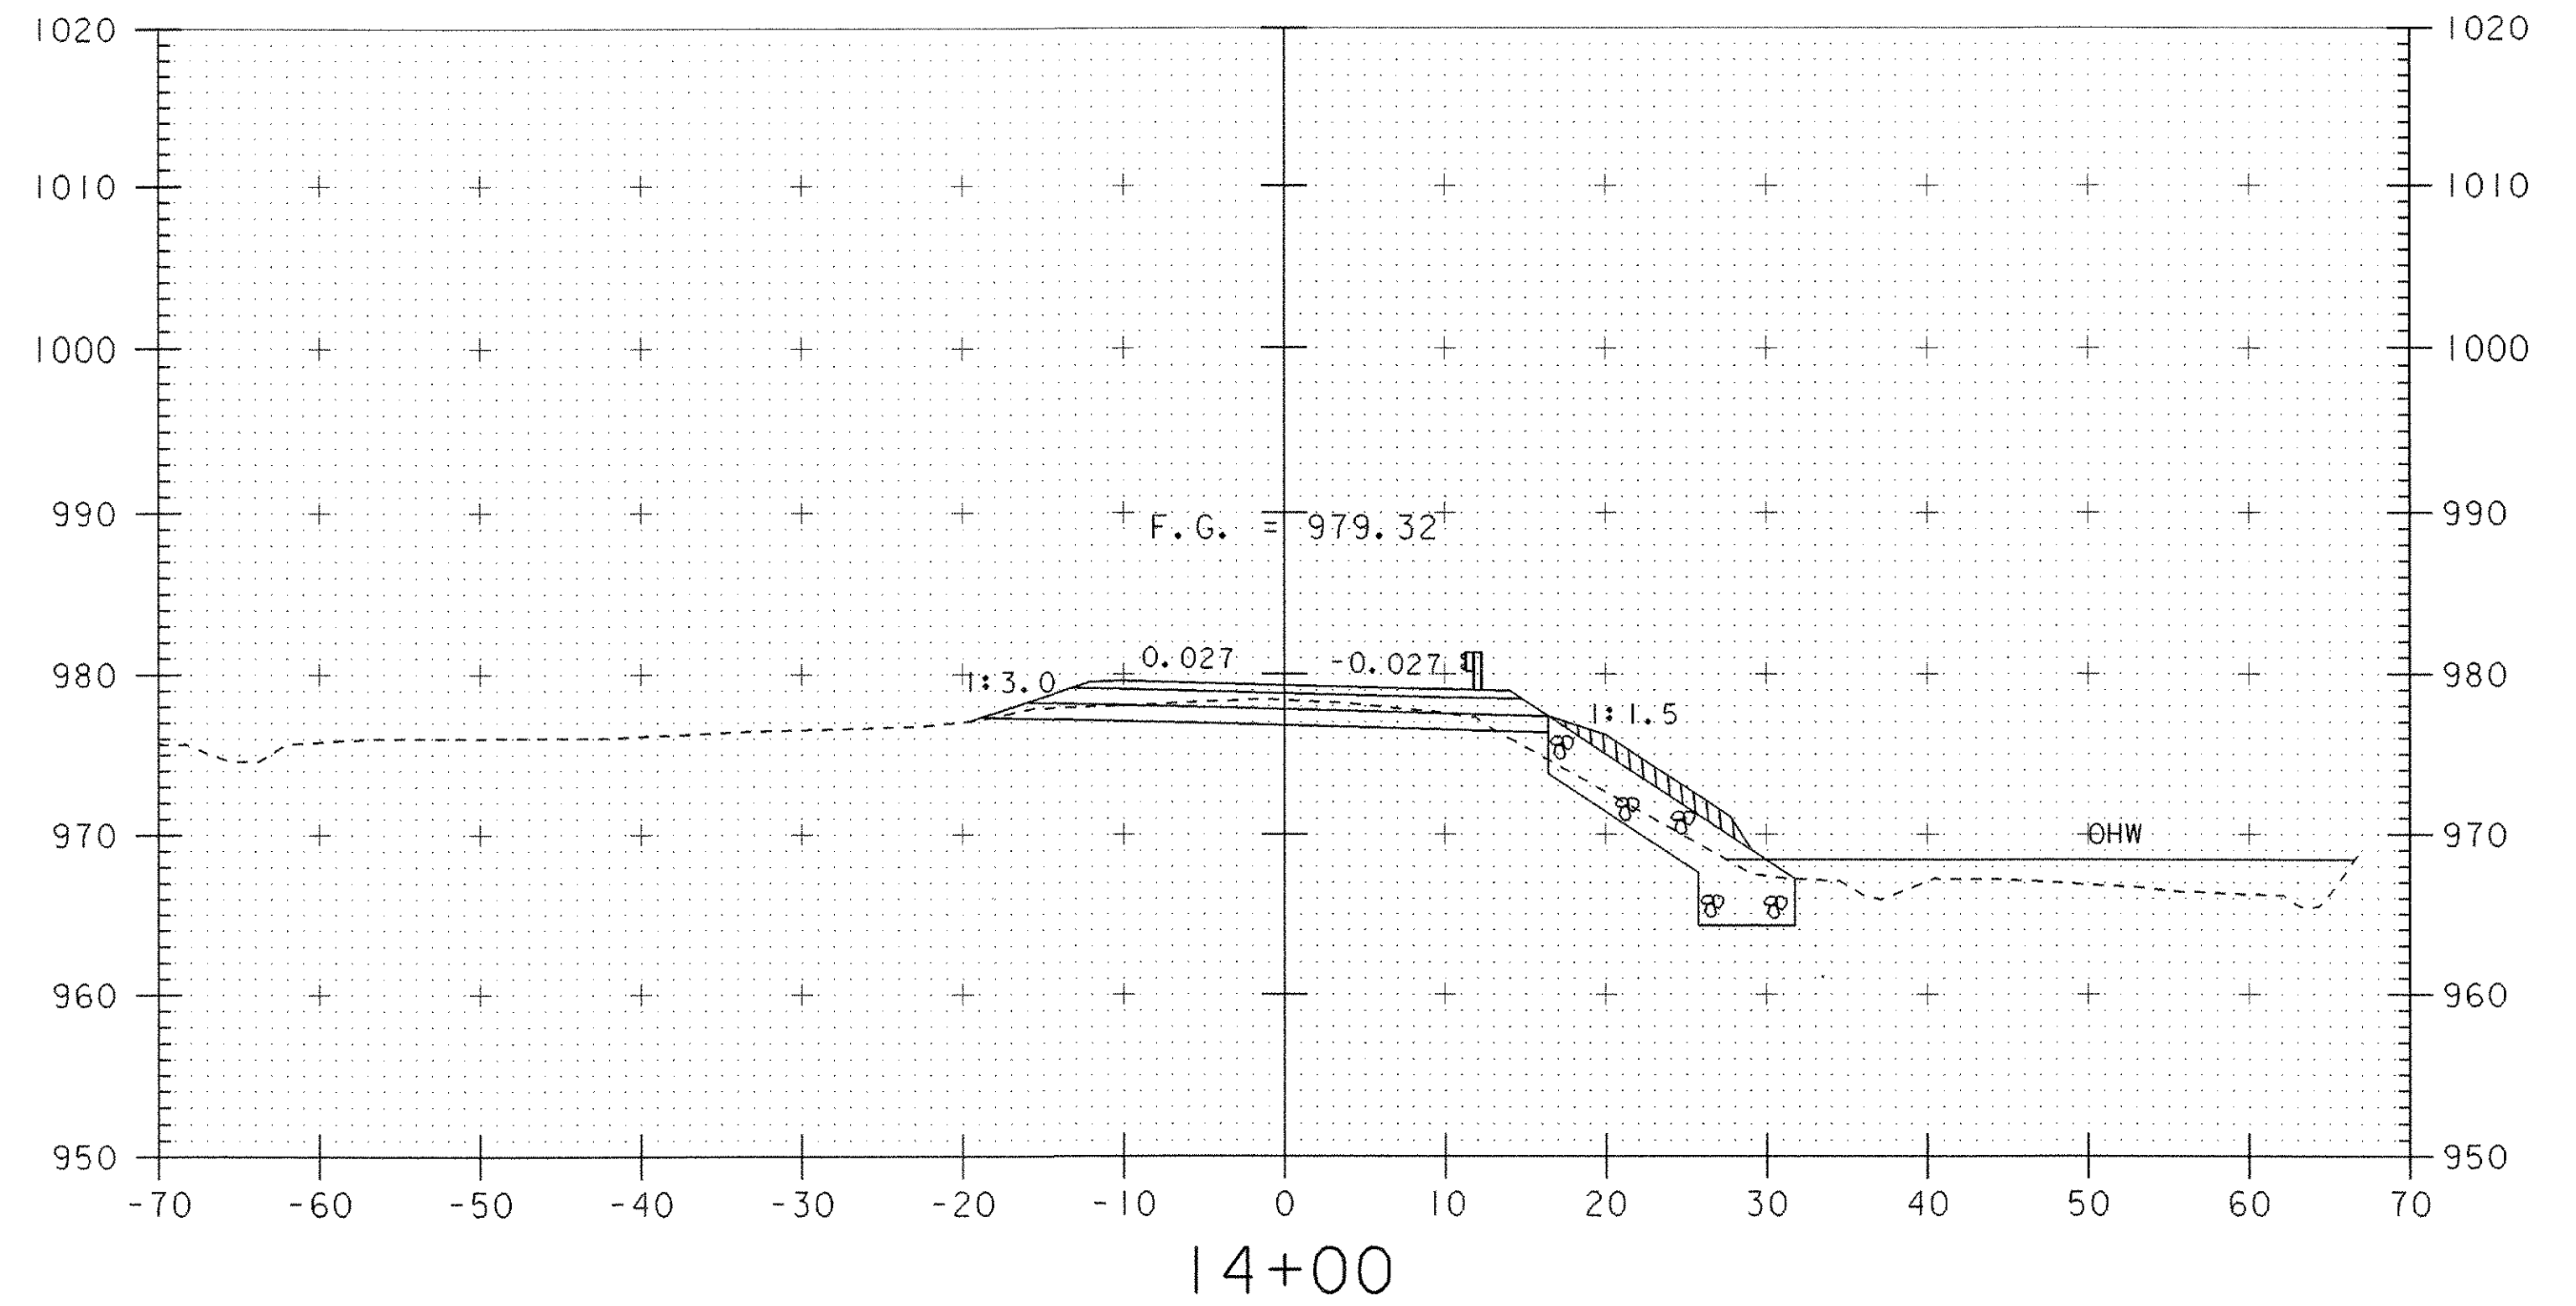


STA. 12+83.83
END BRIDGE

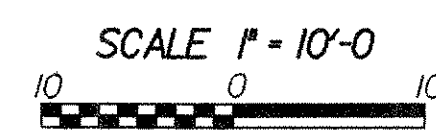

STA. 12+18.17
BEGIN BRIDGE

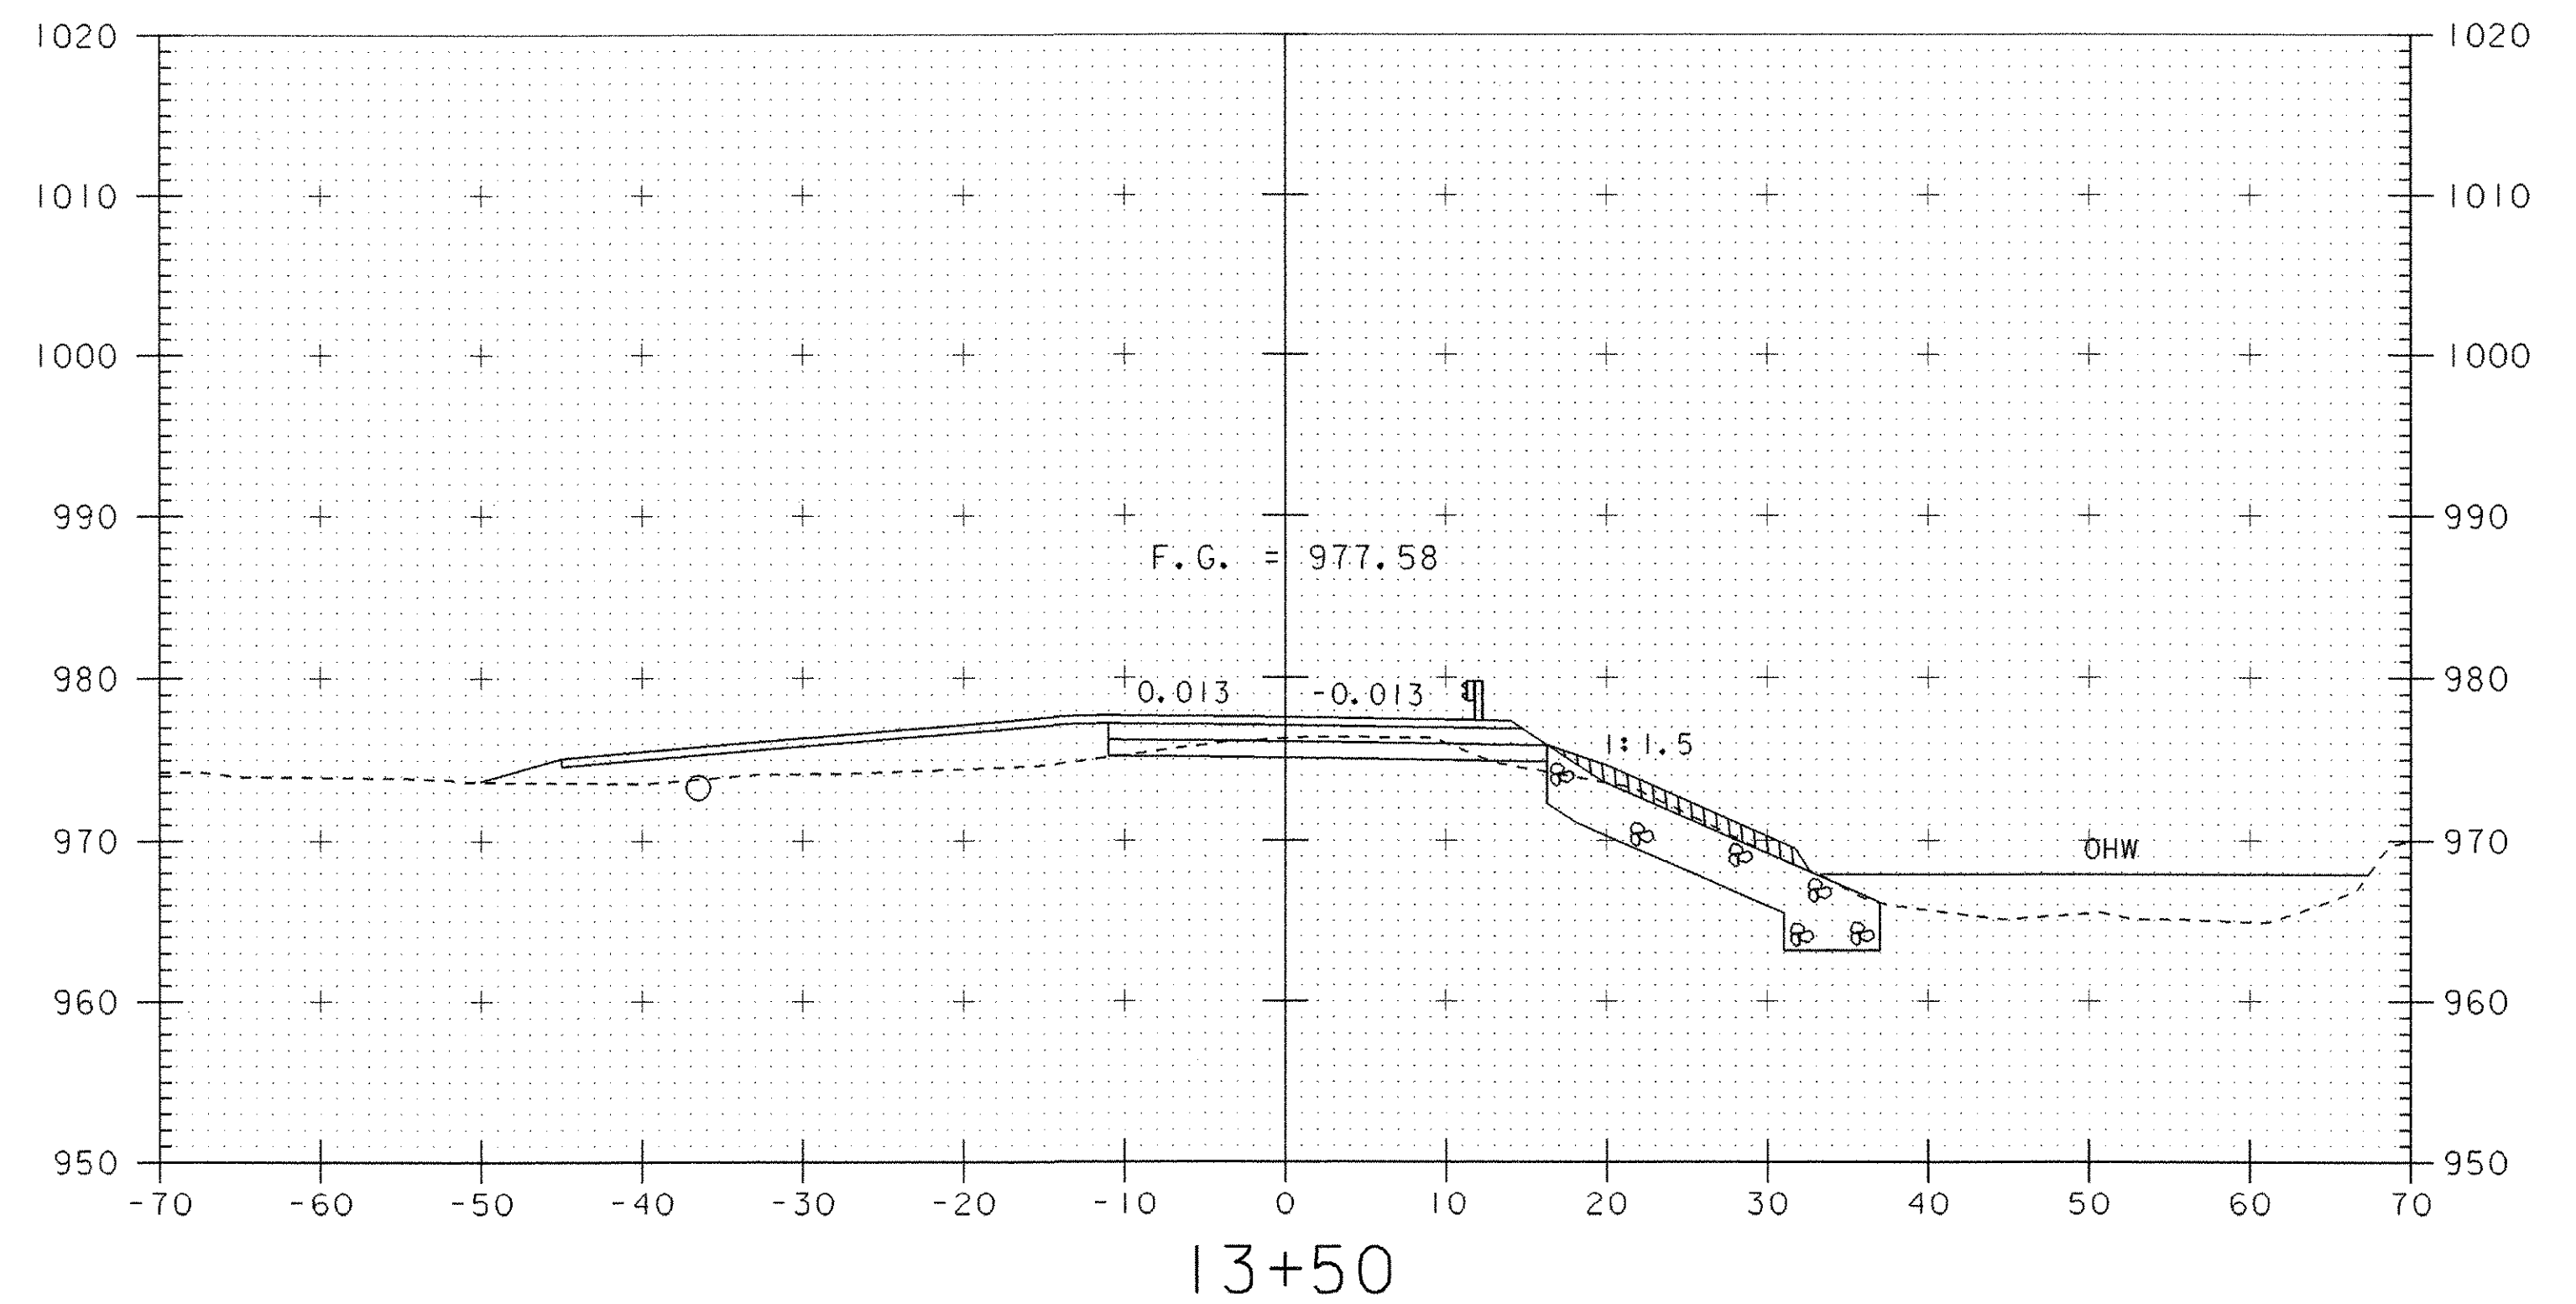

SEE SHEET 42 FOR PIPE
CROSS SECTION @ STA. 13+32

PROJECT: READING	PROJECT NO.: BRZ 1444(23)
DESIGN FILE NAME: /usr/str4/90j058/sj058msc.dgn	PLOT DATE: 13-FEB-2008
IPARM FILE NAME: /str4/90j058/sj058mx3.1	
MAINLINE SECTIONS 12+50 THRU 14+00	
SHEET: 40 OF 49	