



STA. 15+20
 (FROM CHANNEL SECTIONS)
 END STONE FILL
 END GRUBBING MATERIAL
 END GEOTEXTILE UNDER STONE FILL
 END UNCLASSIFIED CHANNEL EXCAVATION

15+00

STA. 15+00
 END 6" AGGREGATE SURFACE COURSE
 USE AGGREGATE SURFACE COURSE TO
 CONSTRUCT GUARD RAIL FLARE TO
 STATION 15+25


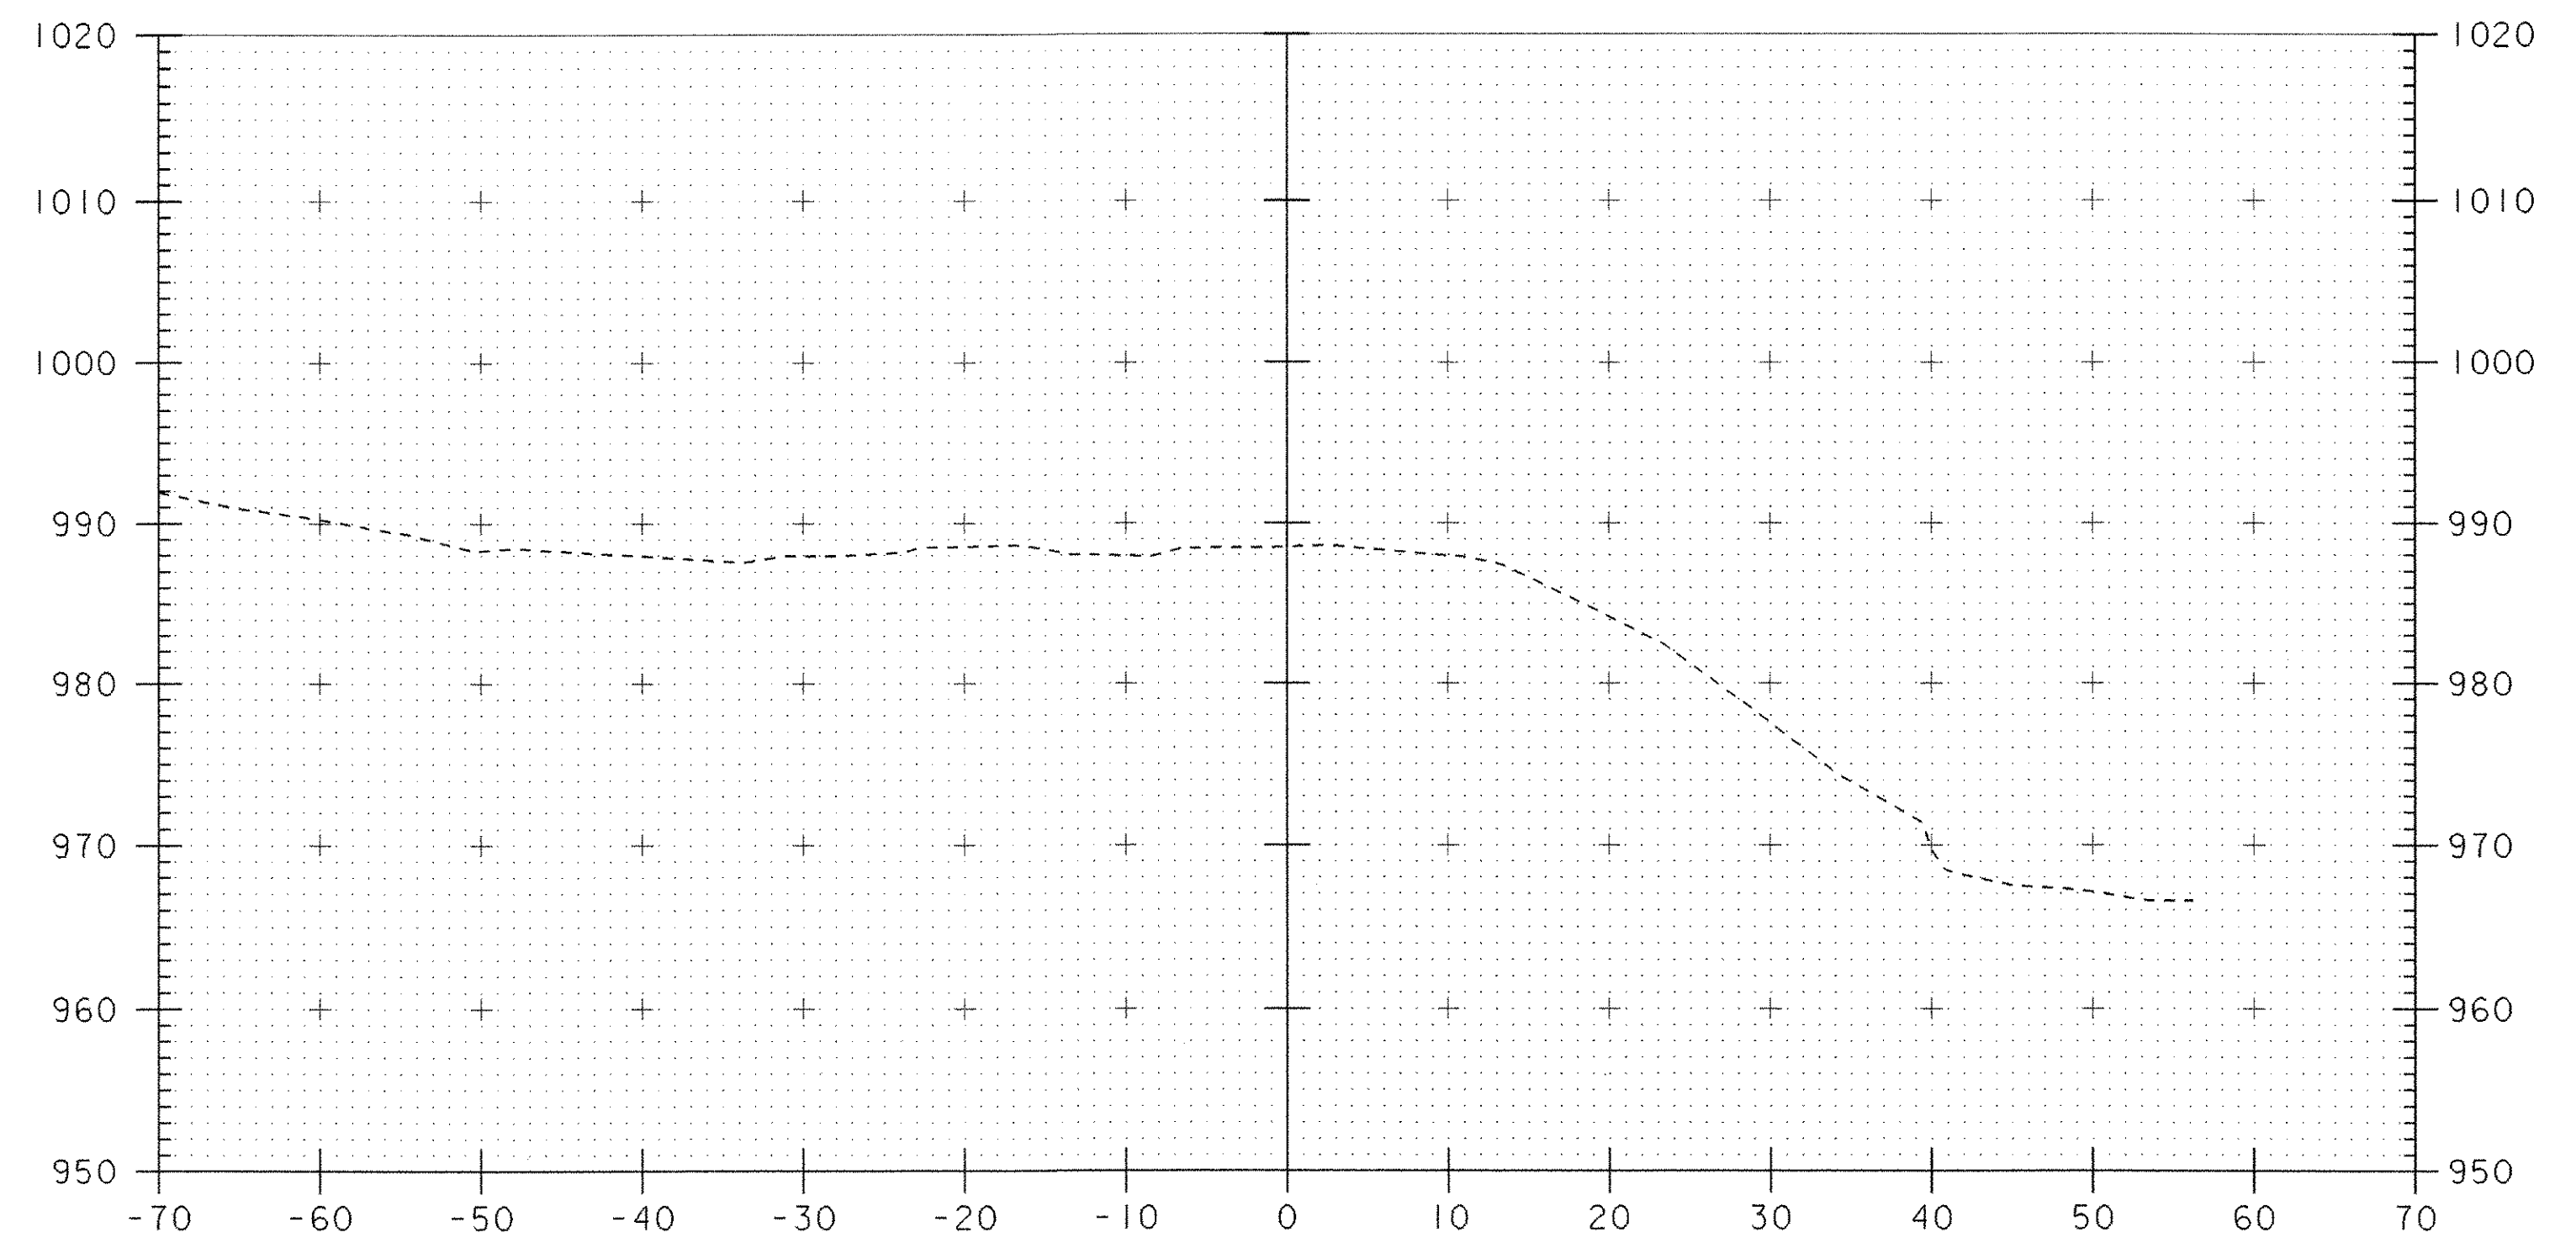


15+50

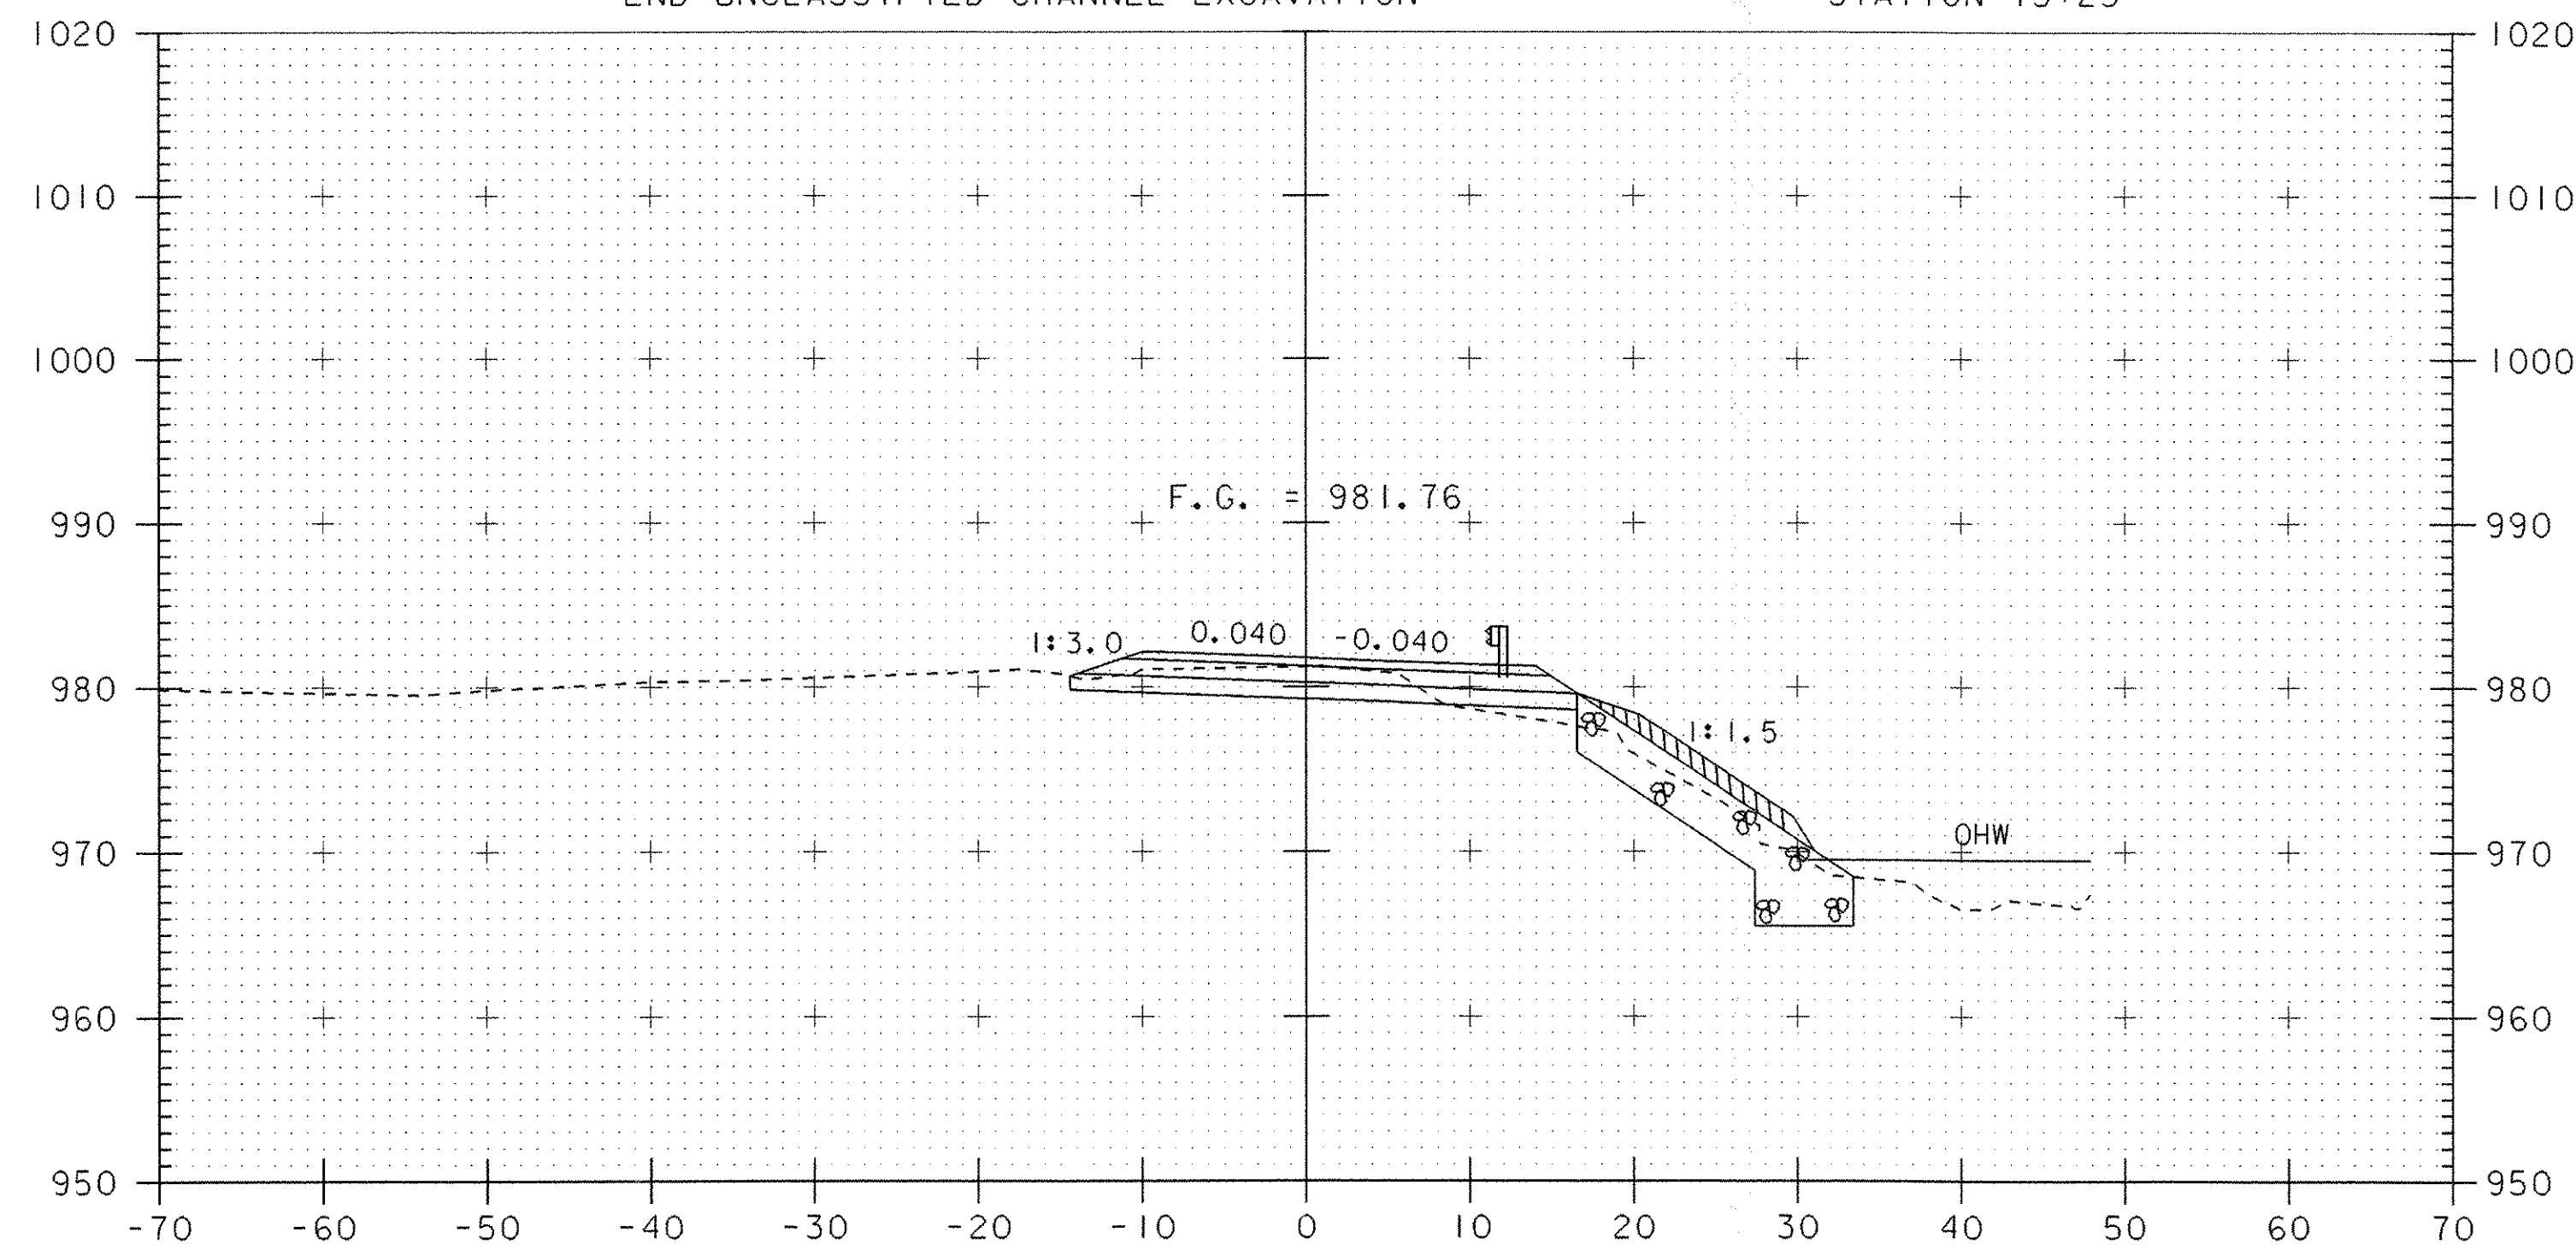

STA. 14+50
 END PROJECT / BEGIN APPROACH
 TAPER AGGREGATE SURFACE COURSE FROM PROPOSED
 TYPICAL TO EXISTING IN 50' WITH 6" MINIMUM DEPTH.
 END SAND (BOX CUT)

14+50

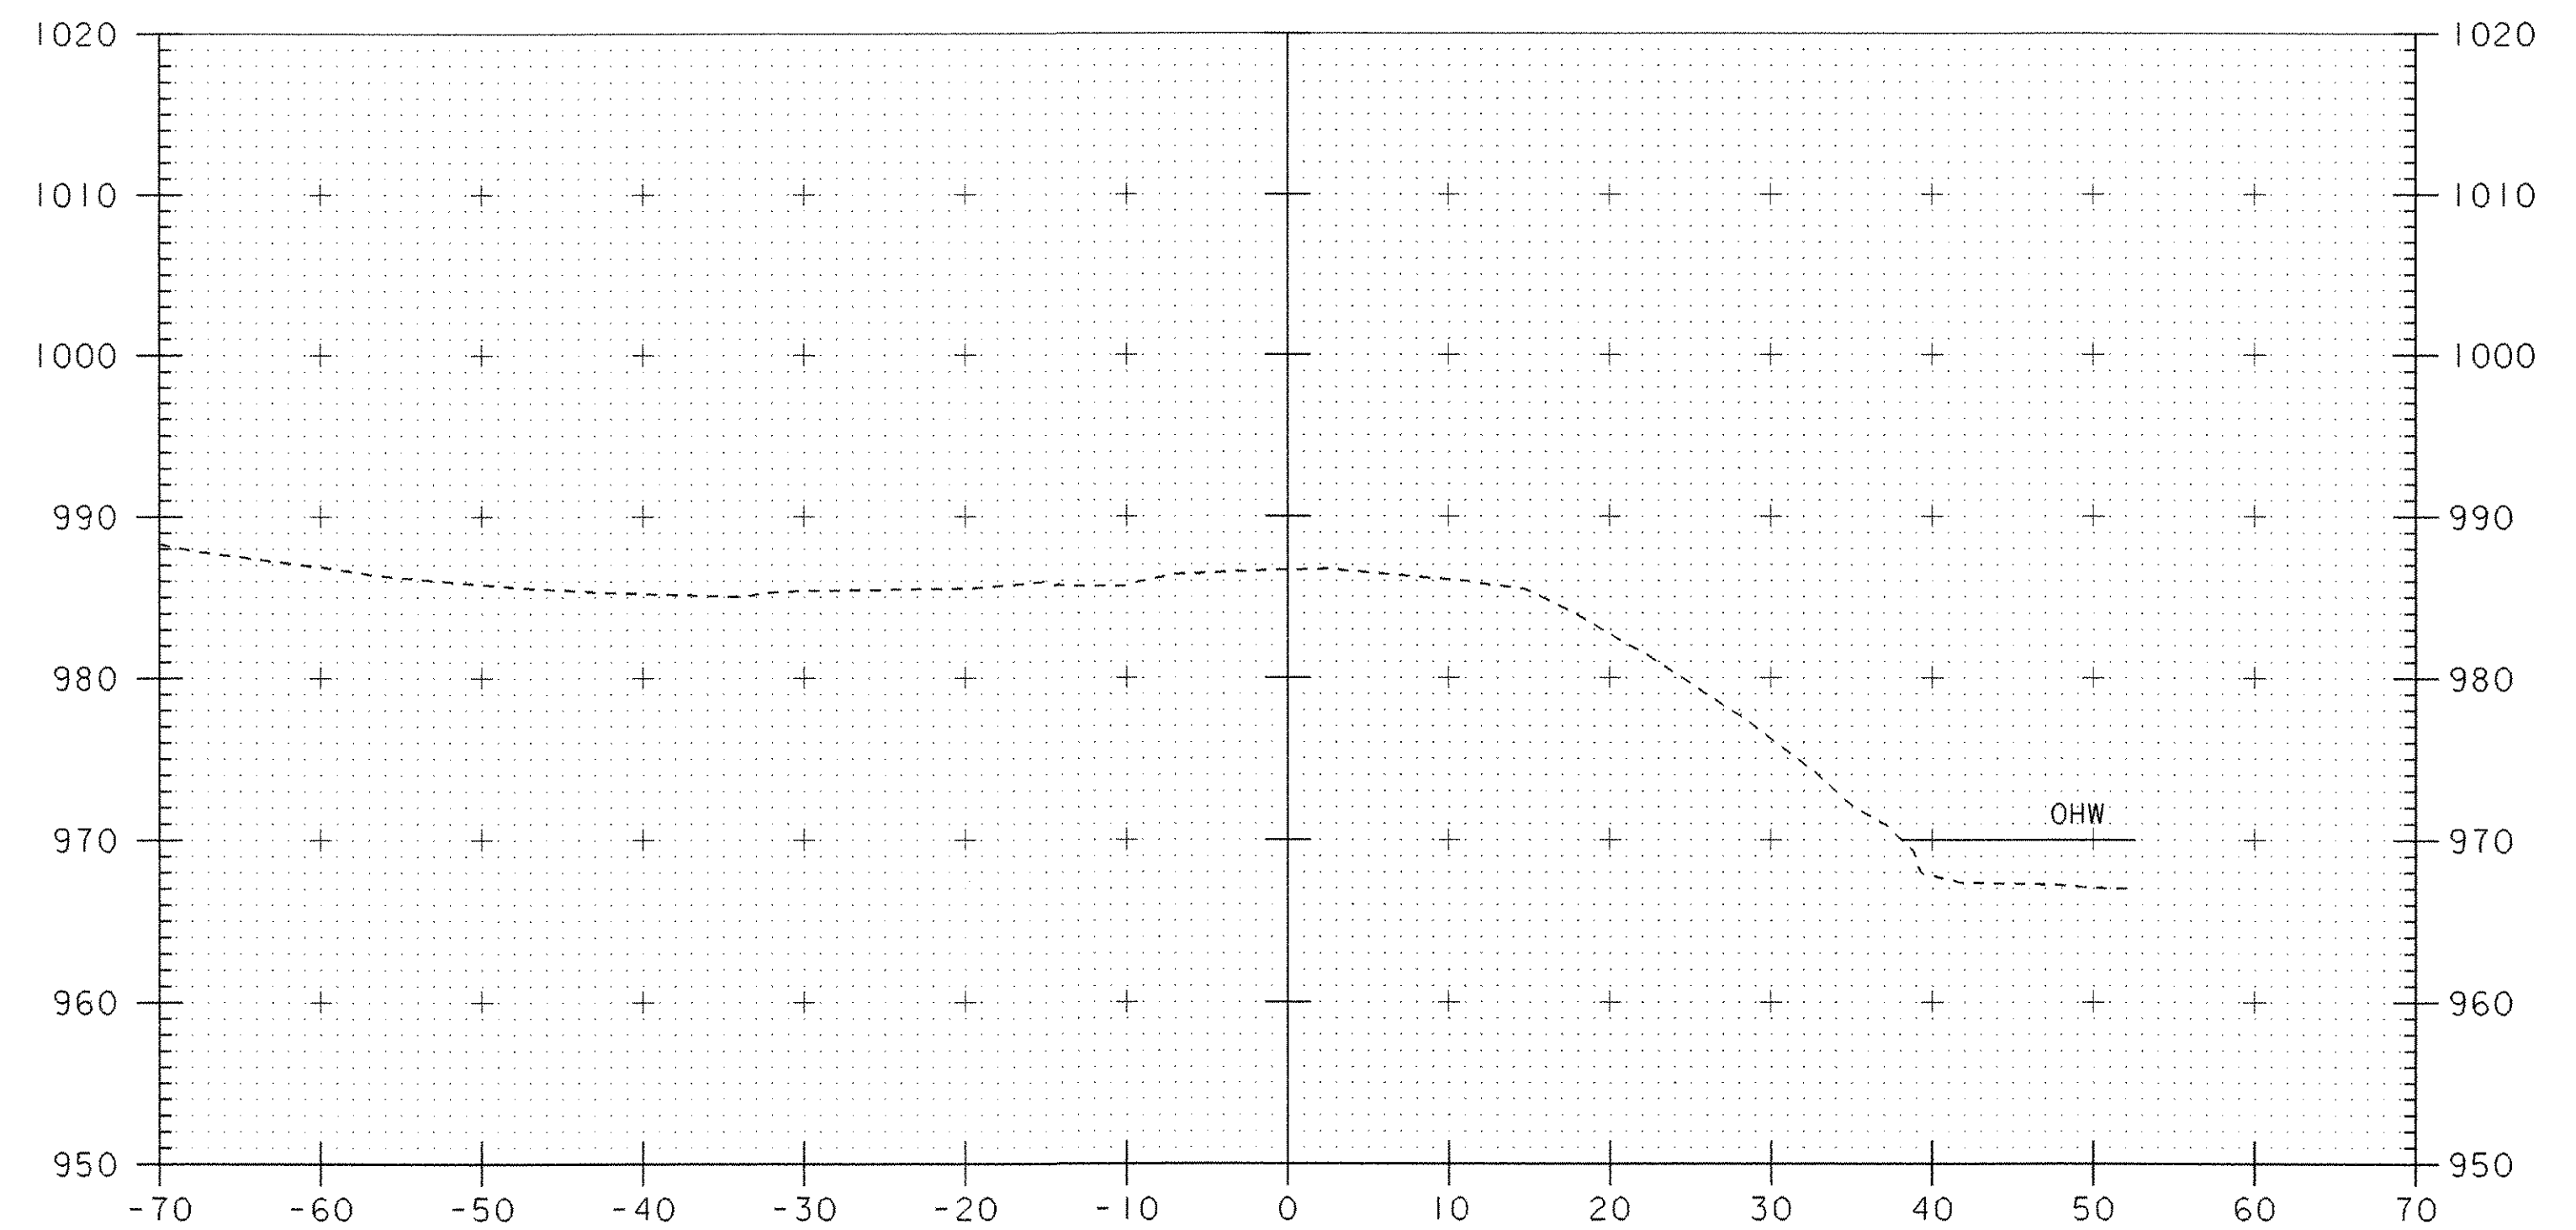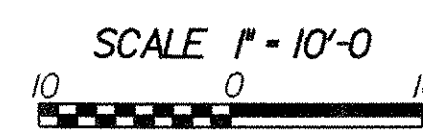

15+25

STA. 15+25
 END APPROACH

PROJECT: READING	PROJECT NO.: BRZ 1444(23)
DESIGN FILE NAME: /usr/str4/90j058/sj058msc.dgn	PLOT DATE: 13-FEB-2008
IPARM FILE NAME: /str4/90j058/sj058mx4.i	
MAINLINE SECTIONS 14+50 THRU 15+50	
SHEET: 41 OF 49	