
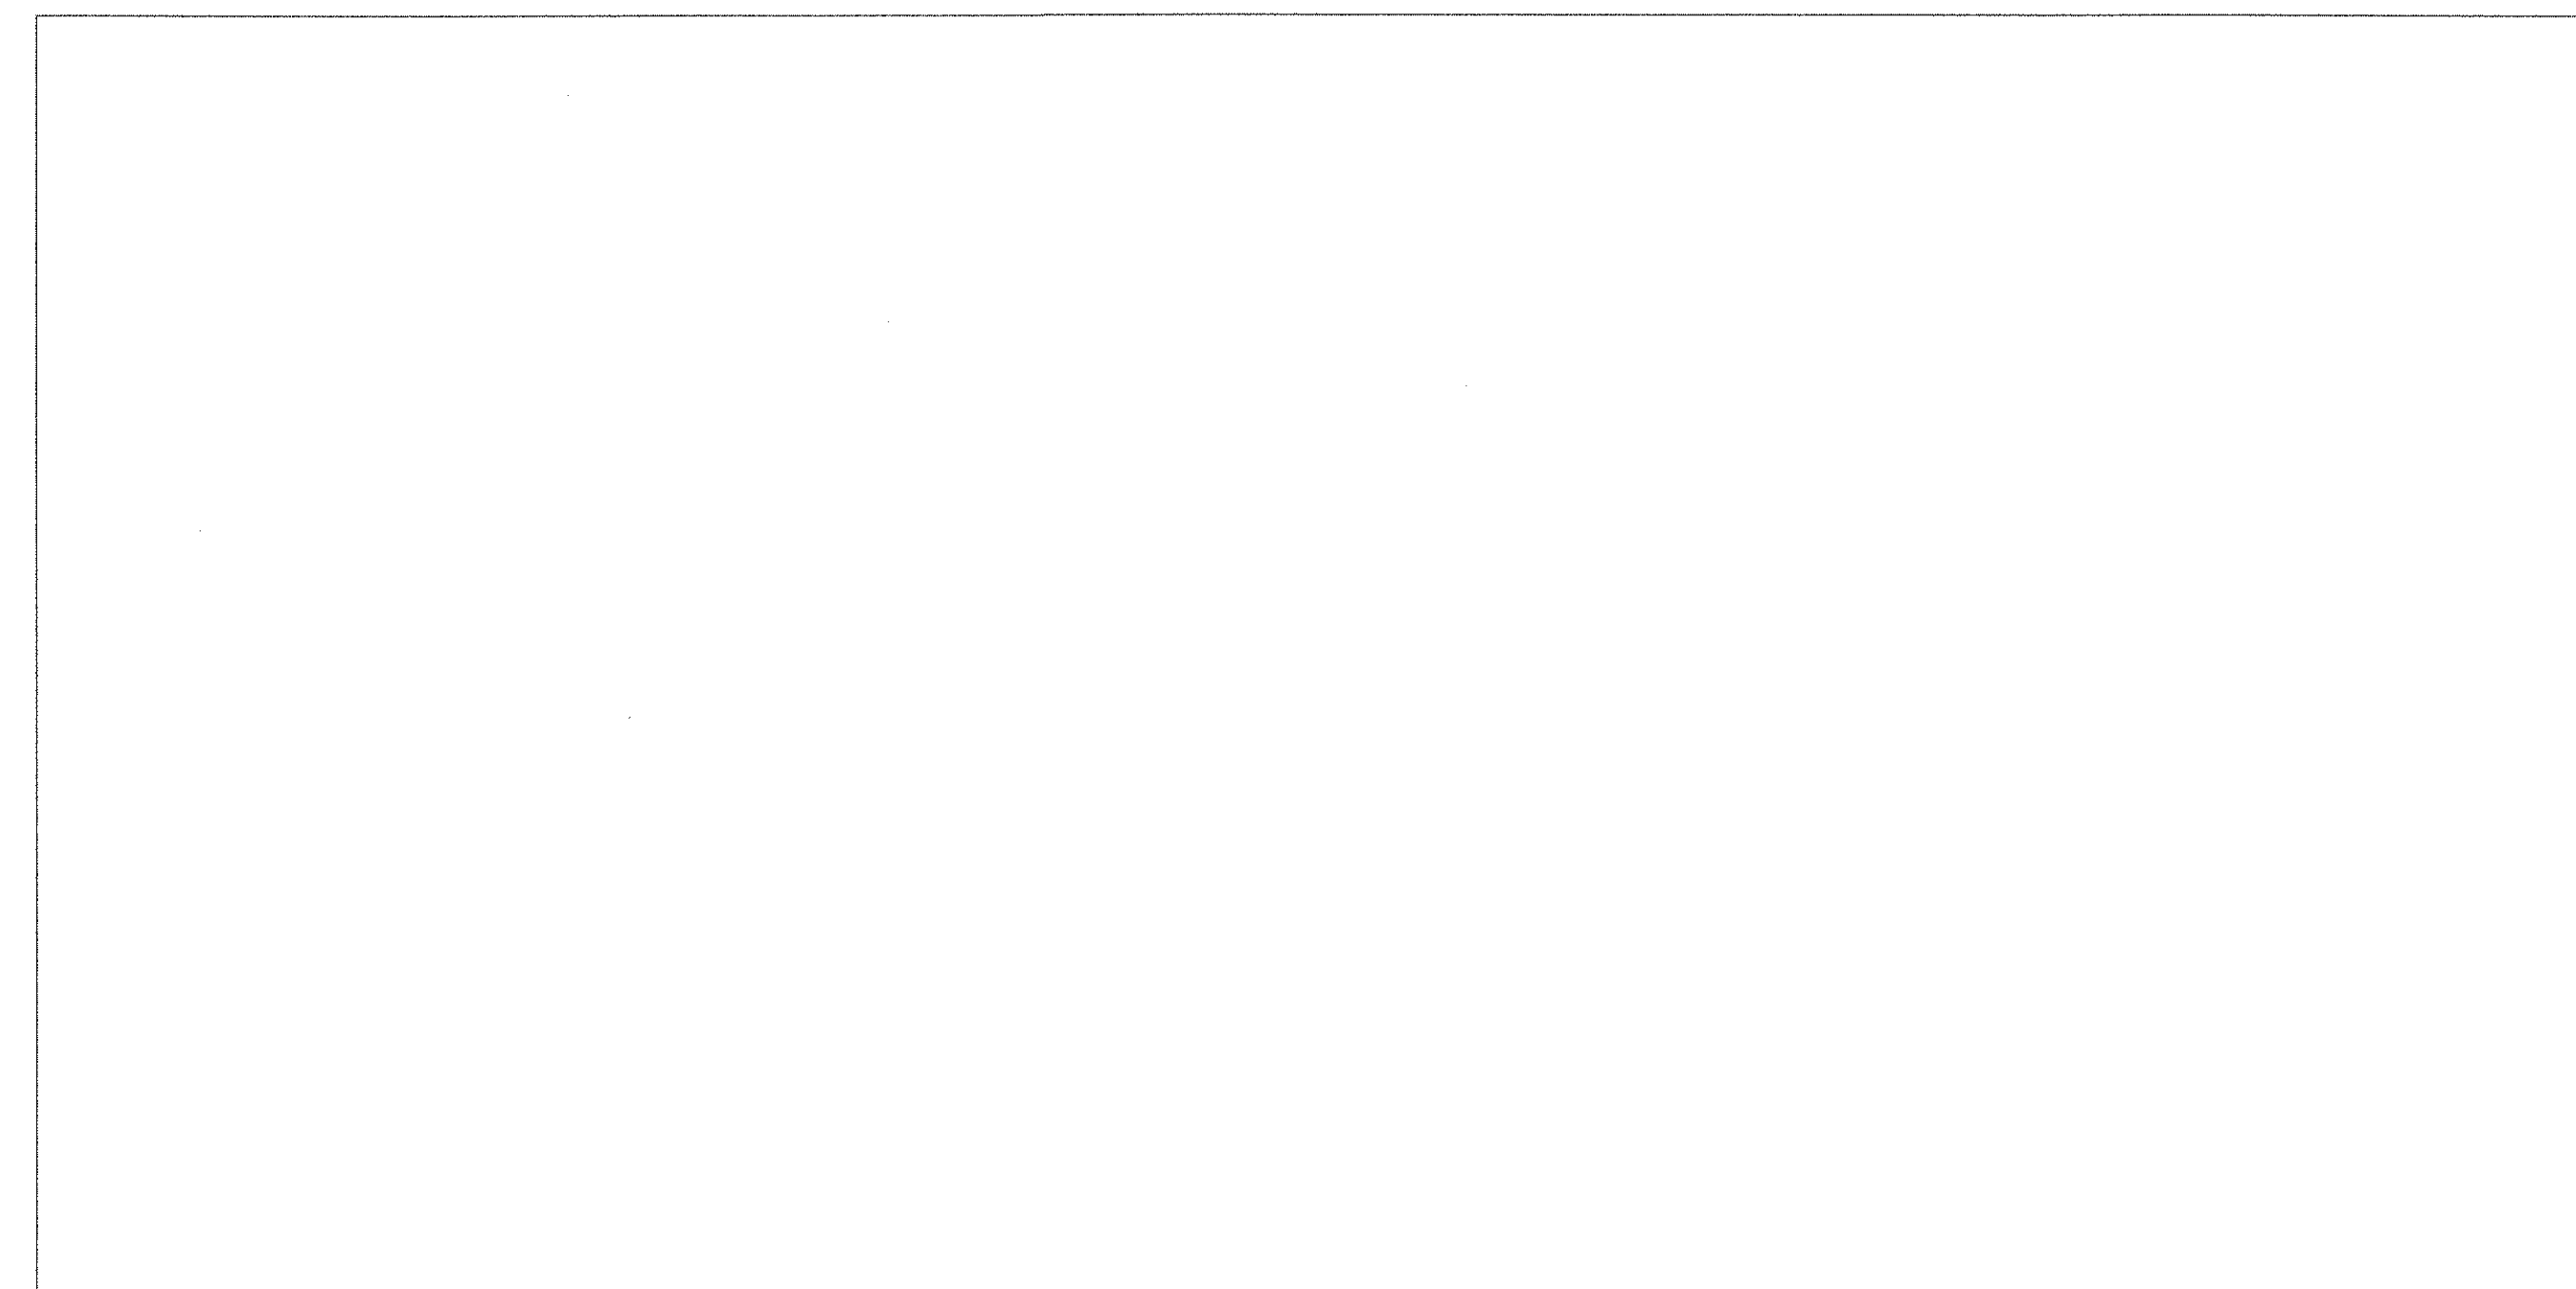
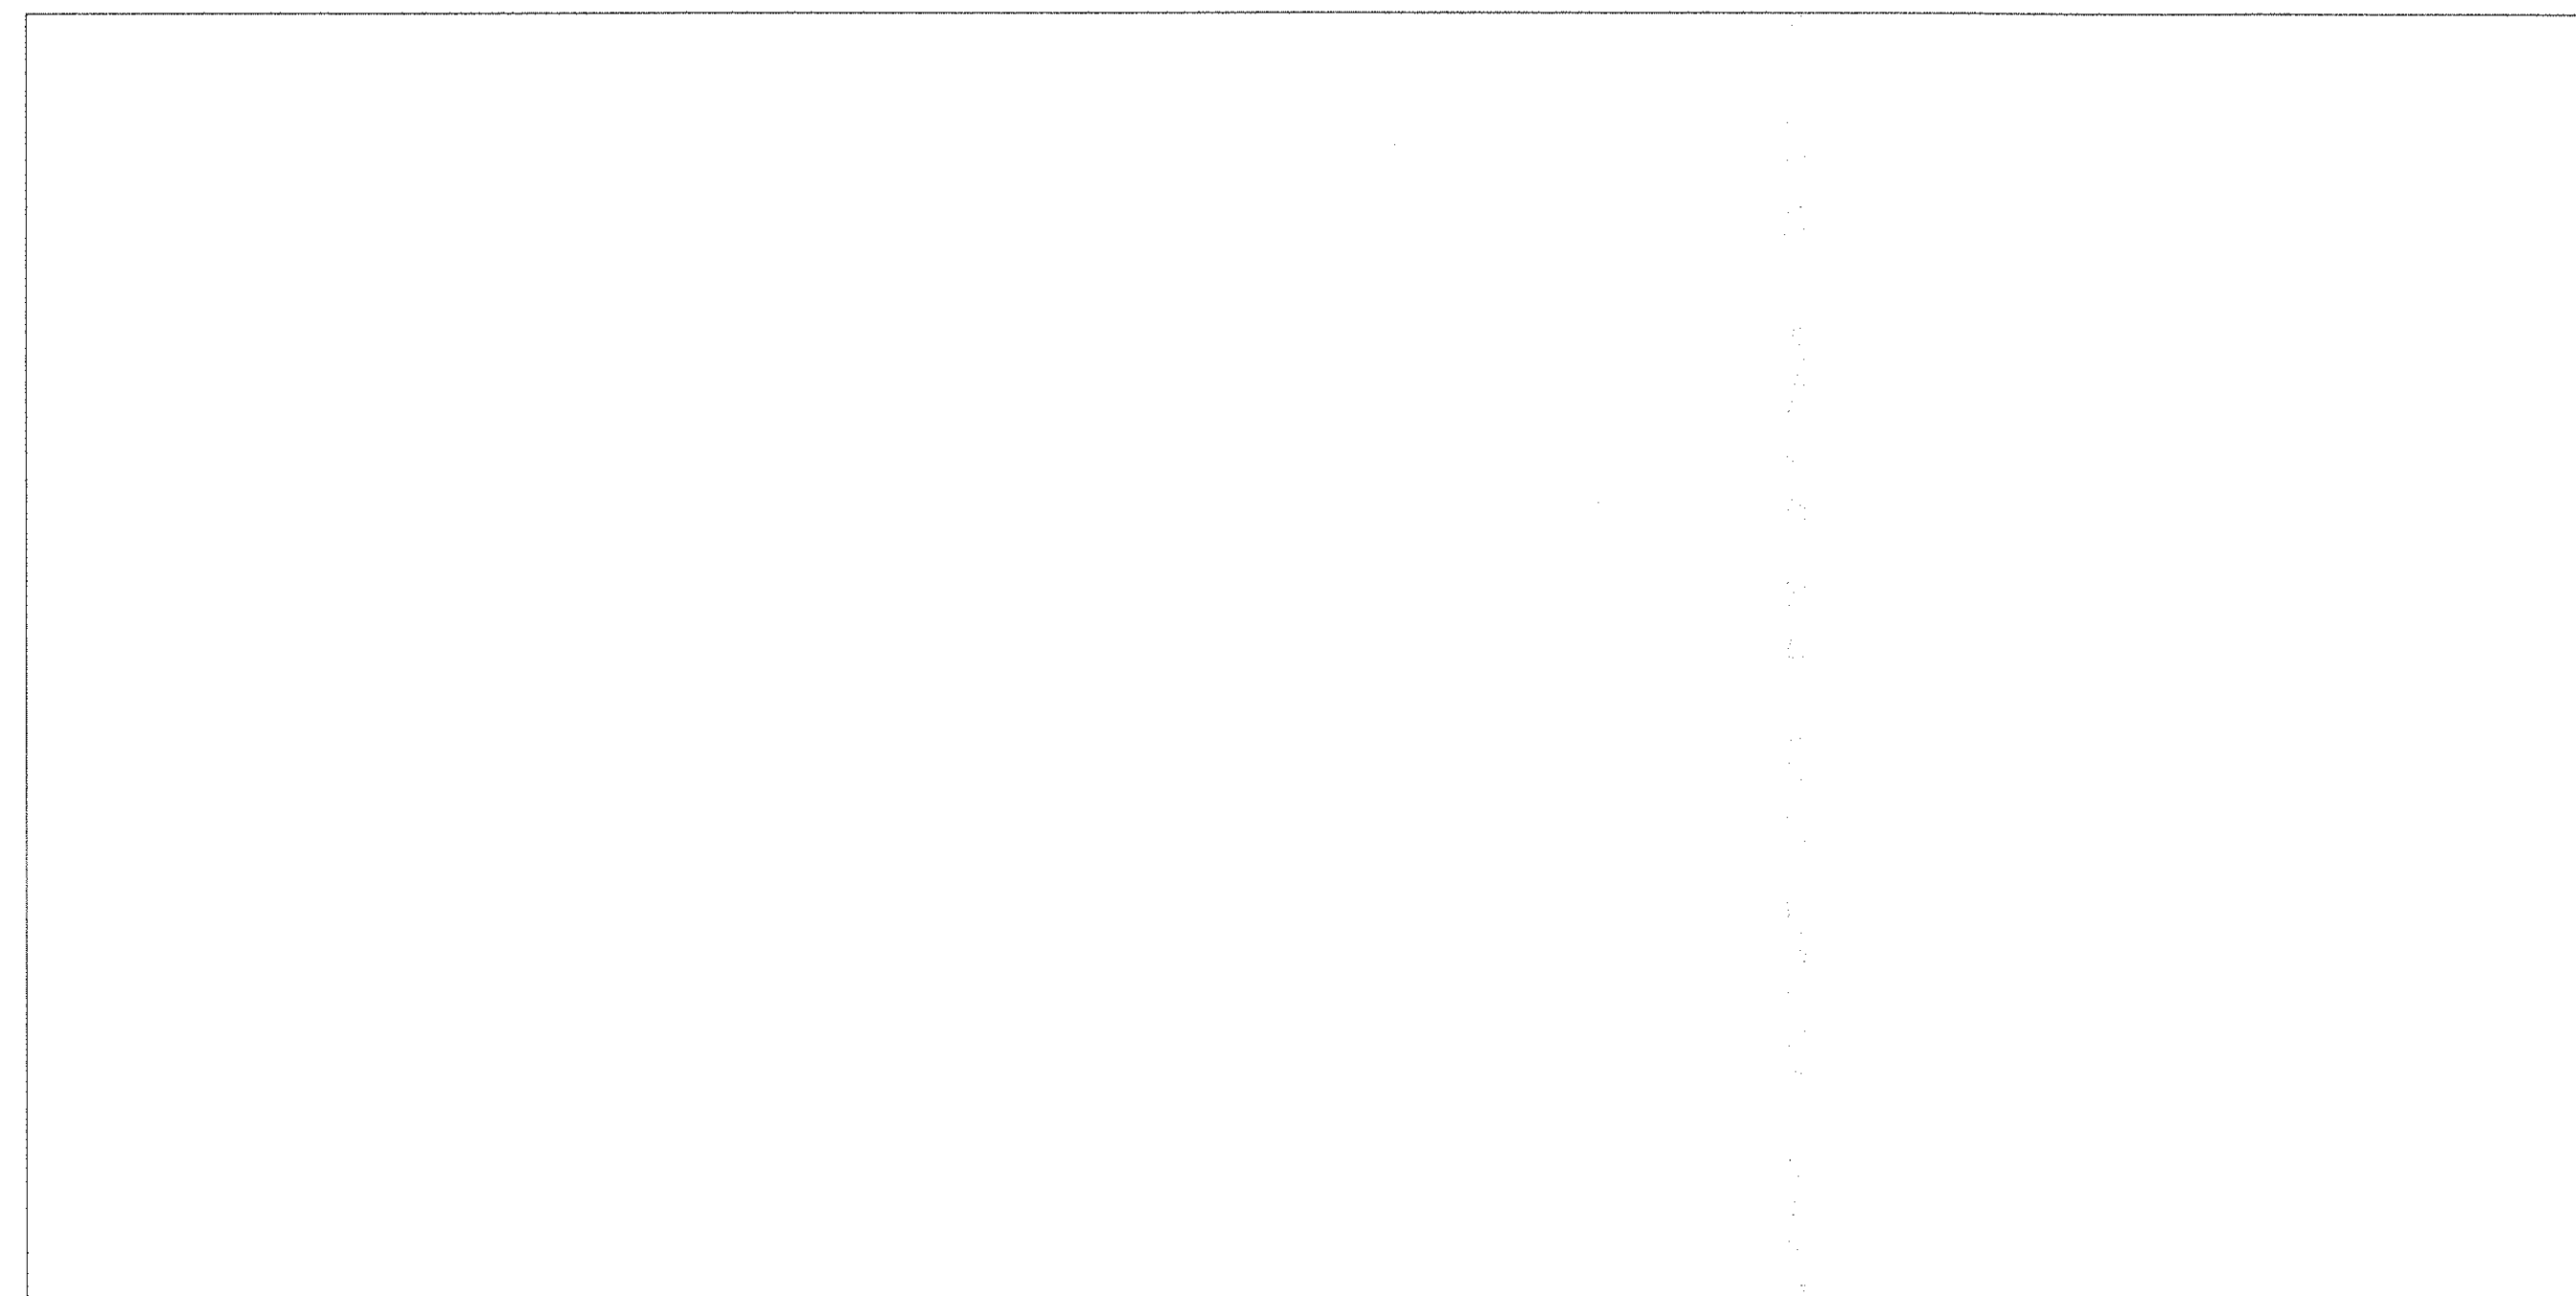
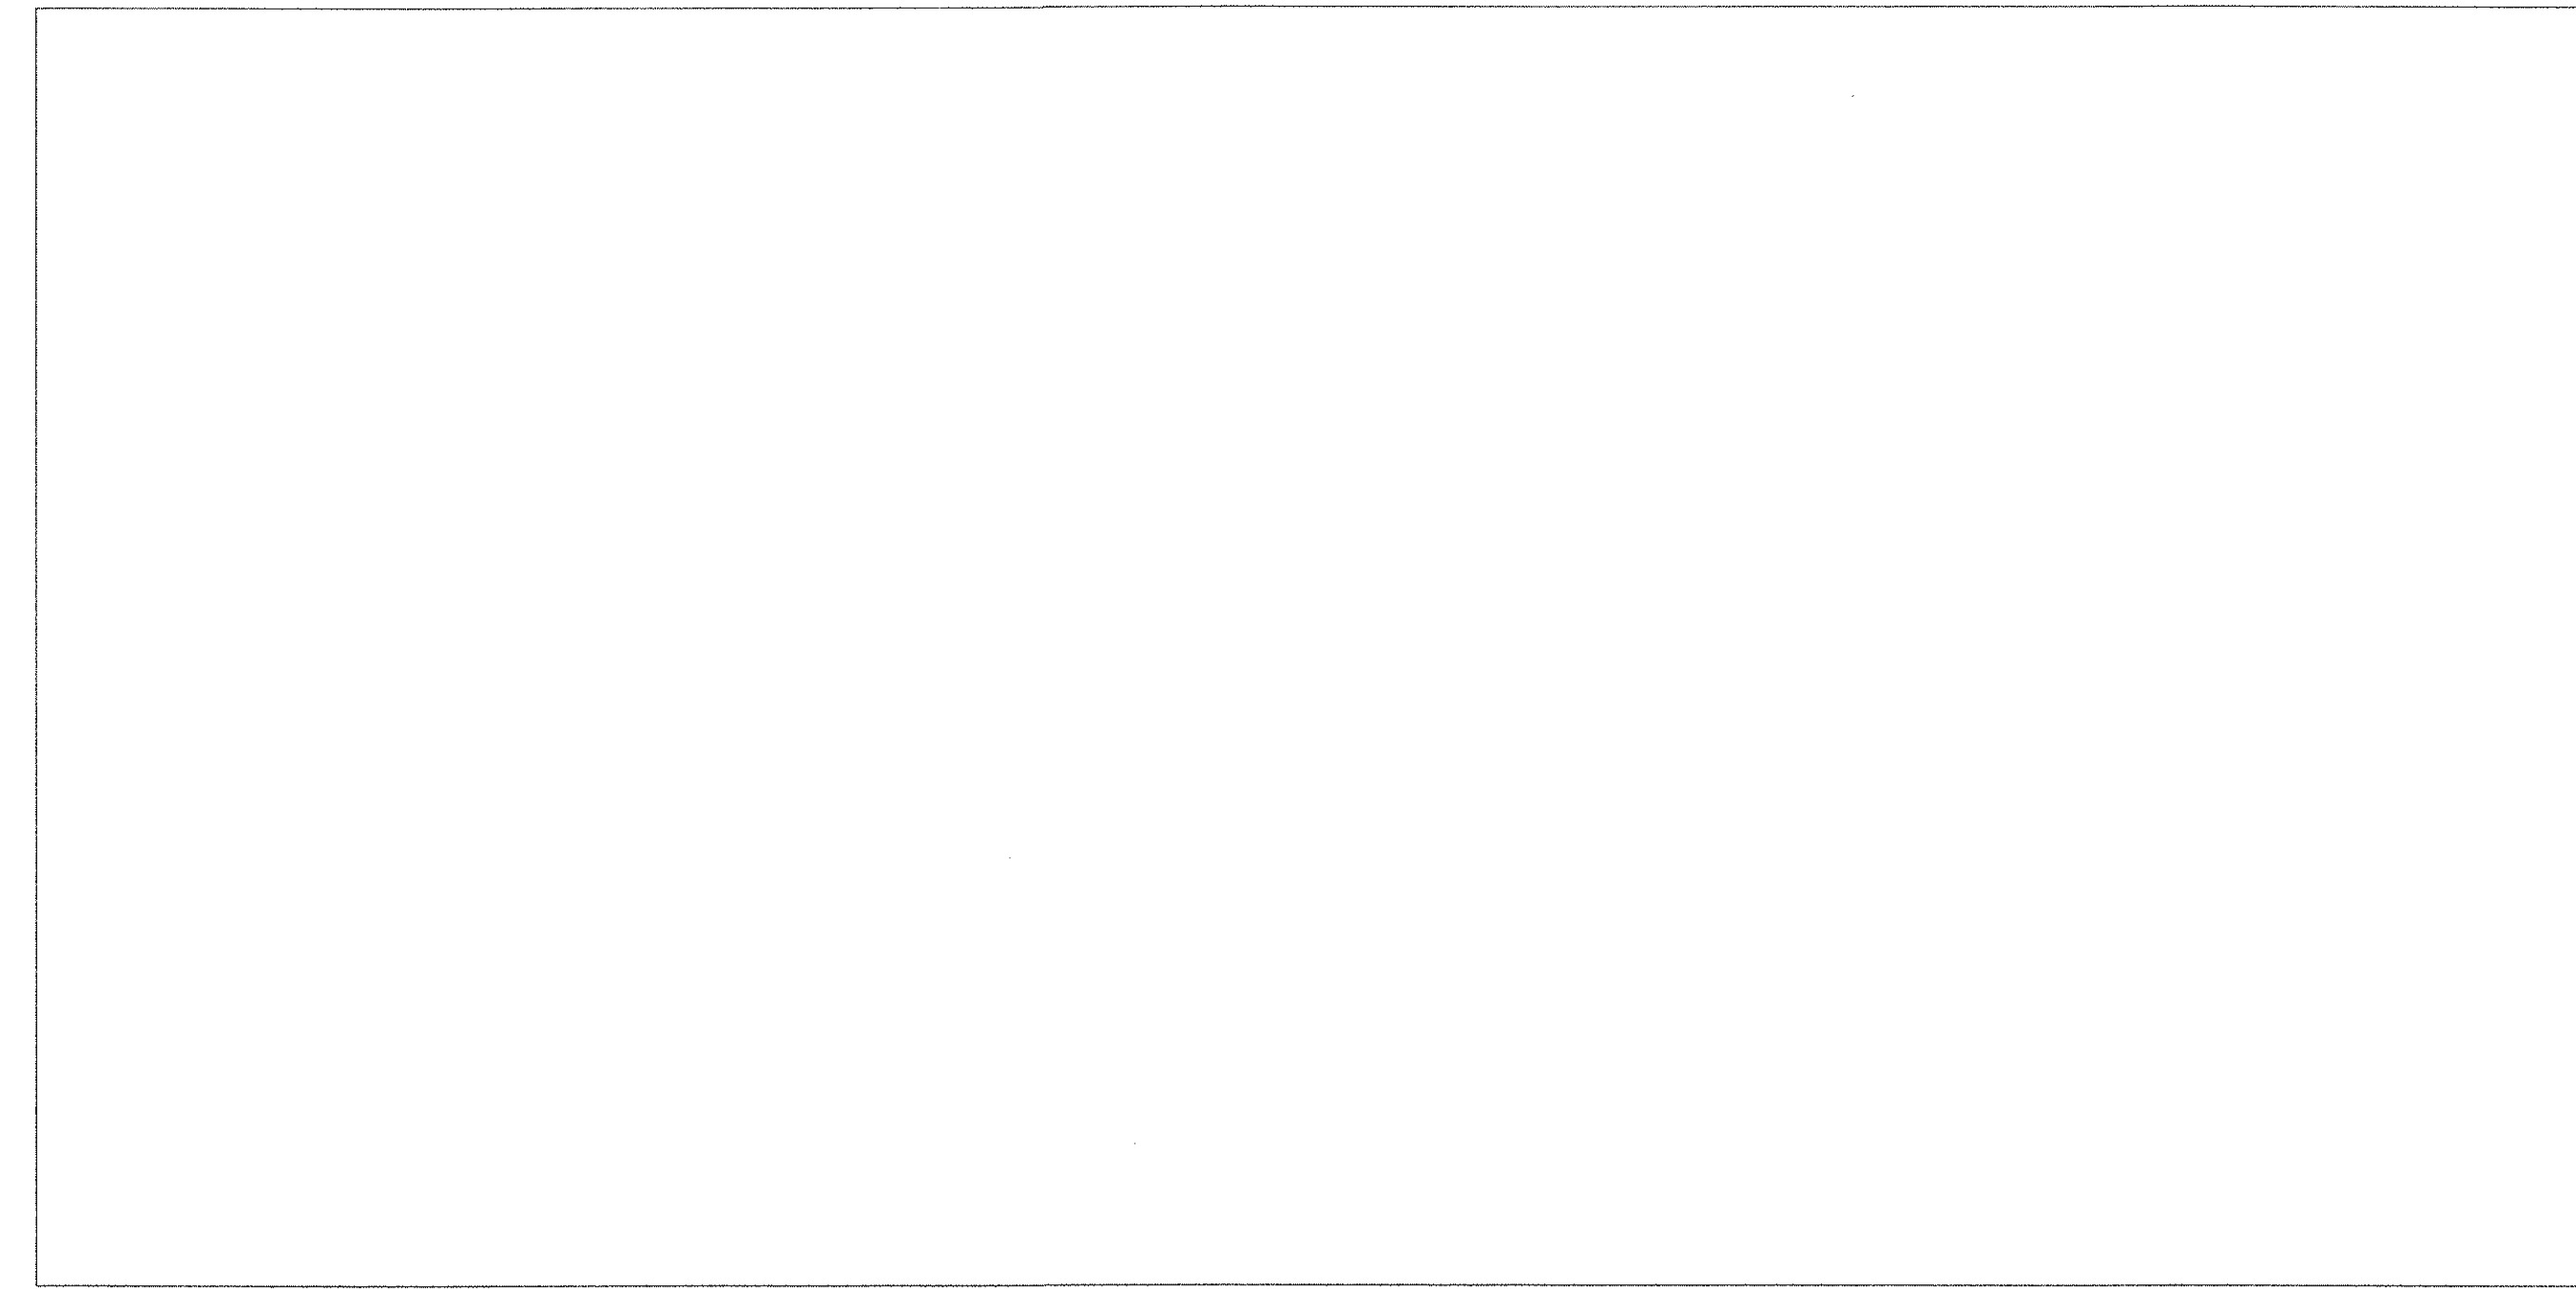


ADDITIONAL CRITICAL SECTION

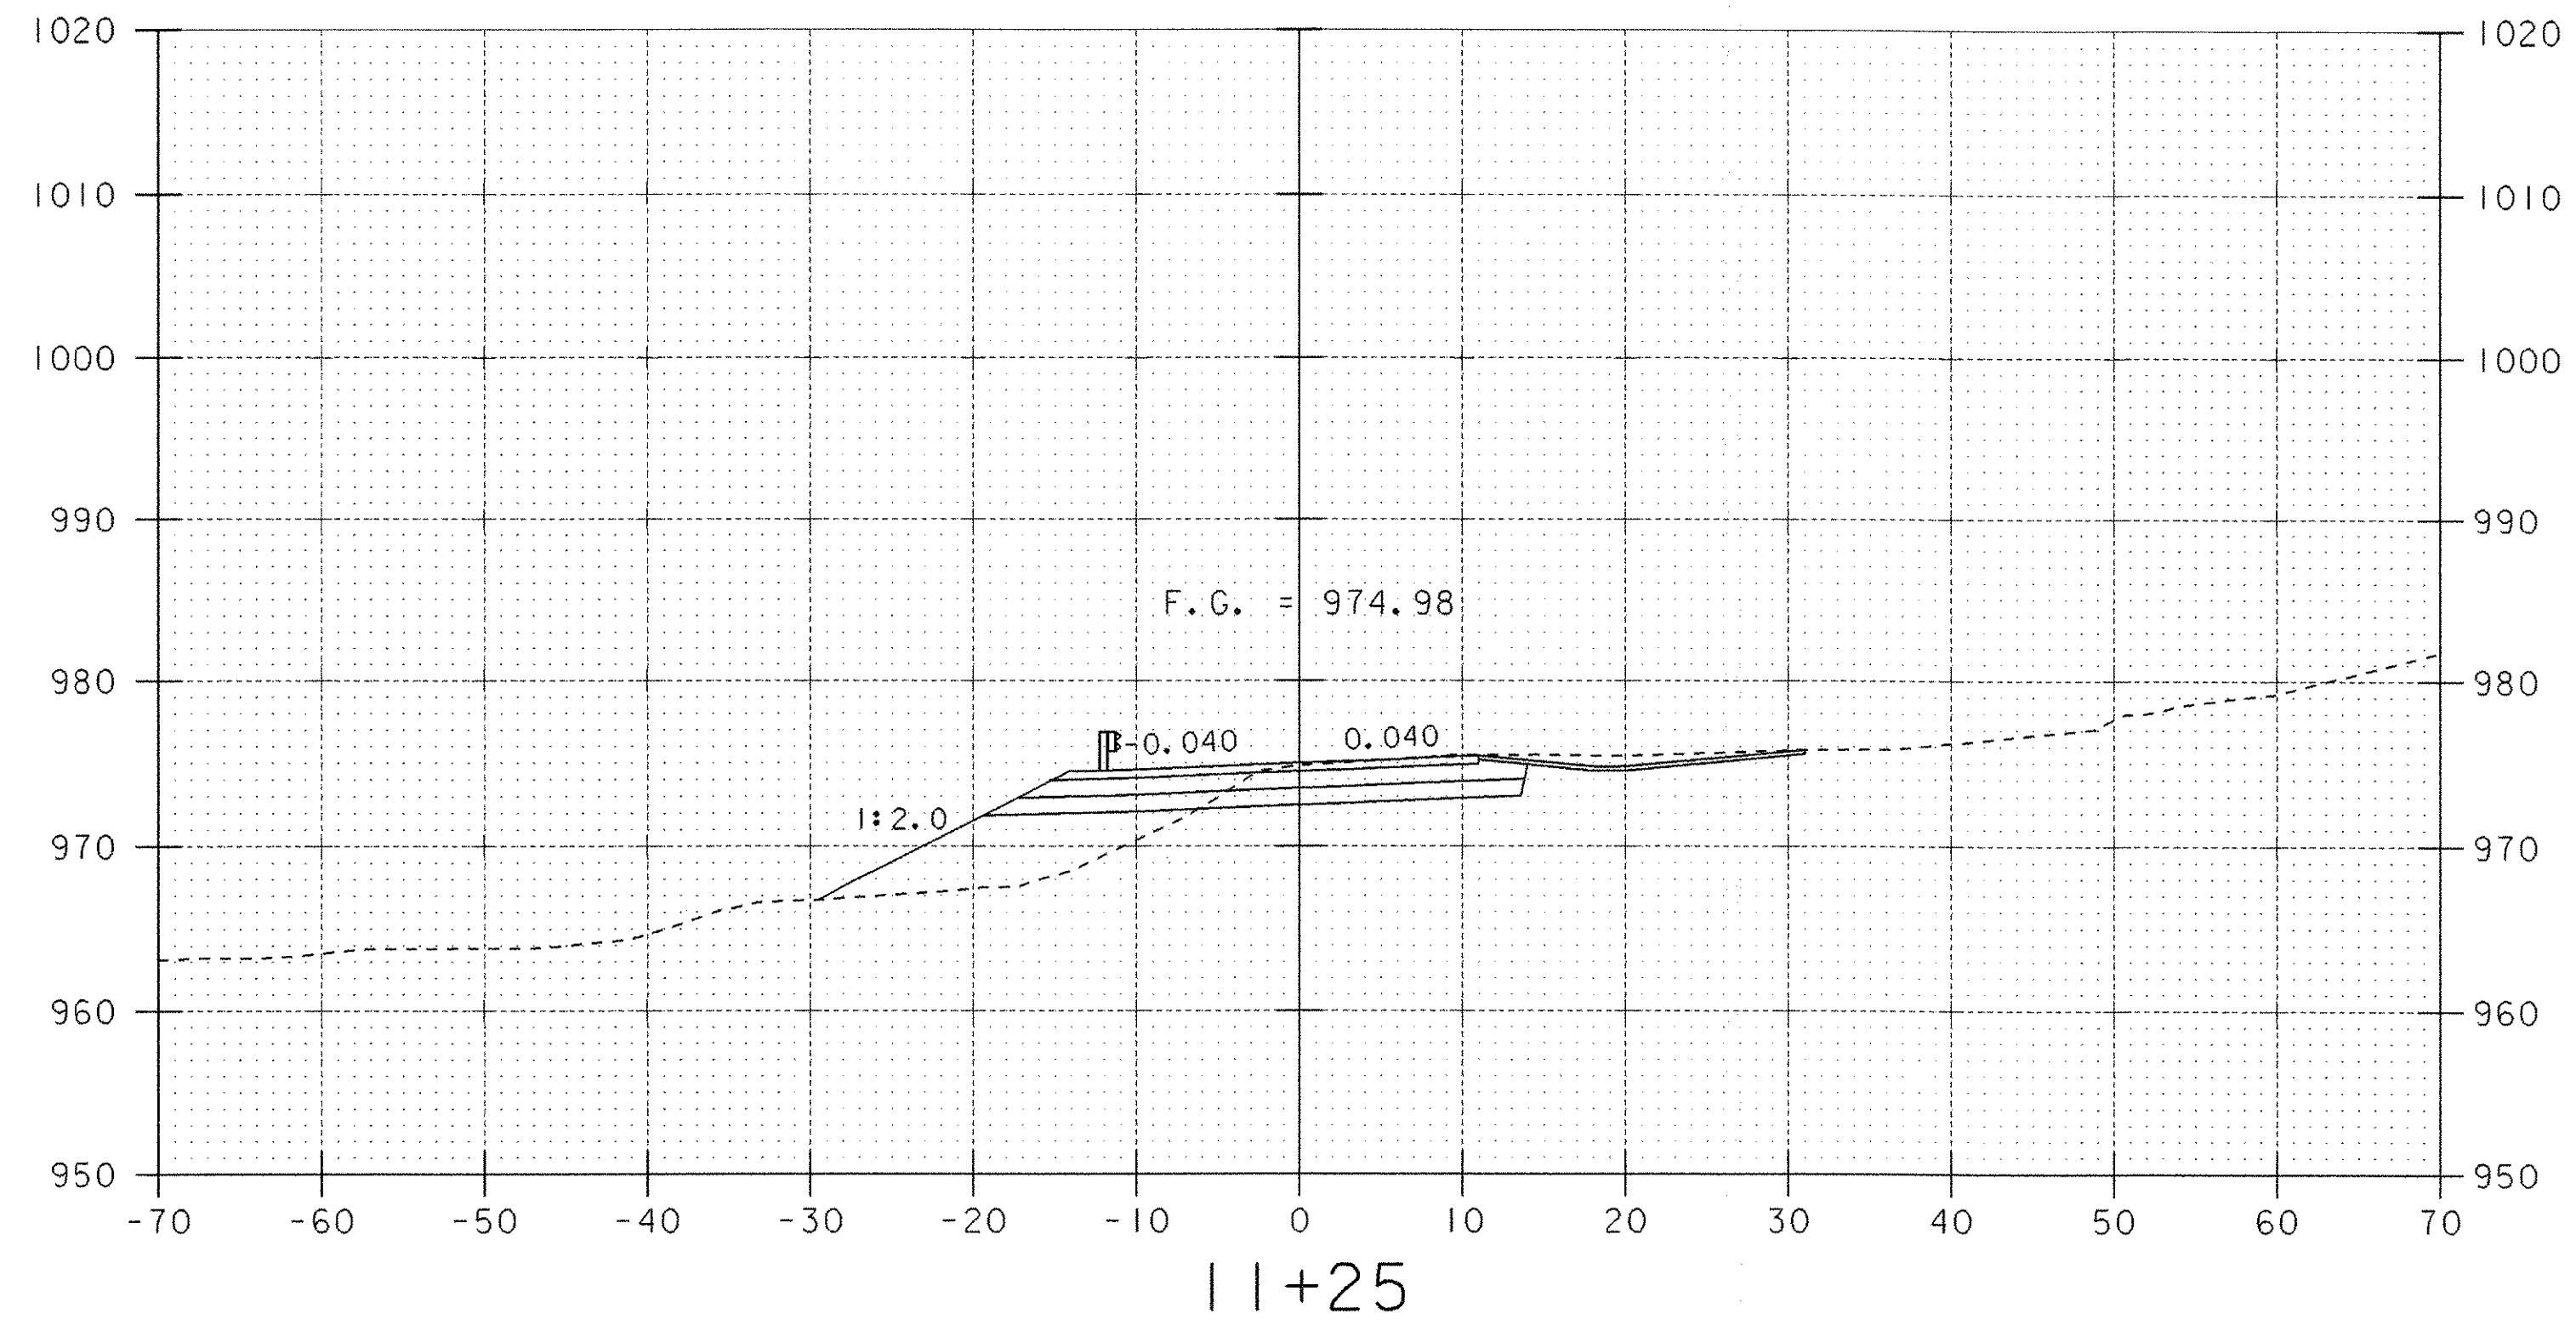

PROJECT: READING	PROJECT NO.: BRZ 1444(23)
DESIGN FILE NAME: /usr/str4/90j058/sj058msc.dgn	
IPARM FILE NAME: /str4/90j058/sj058mx6.l PLOT DATE: 13-FEB-2008	
ADDITIONAL CRITICAL SECTIONS	
SHEET: 43 OF 49	