



STA. 52+09 RT
 BEGIN STONE FILL TYPE III
 BEGIN GRUBBING MATERIAL
 BEGIN GEOTEXTILE UNDER STONE FILL
 BEGIN UNCLASSIFIED CHANNEL EXCAVATION


52+10

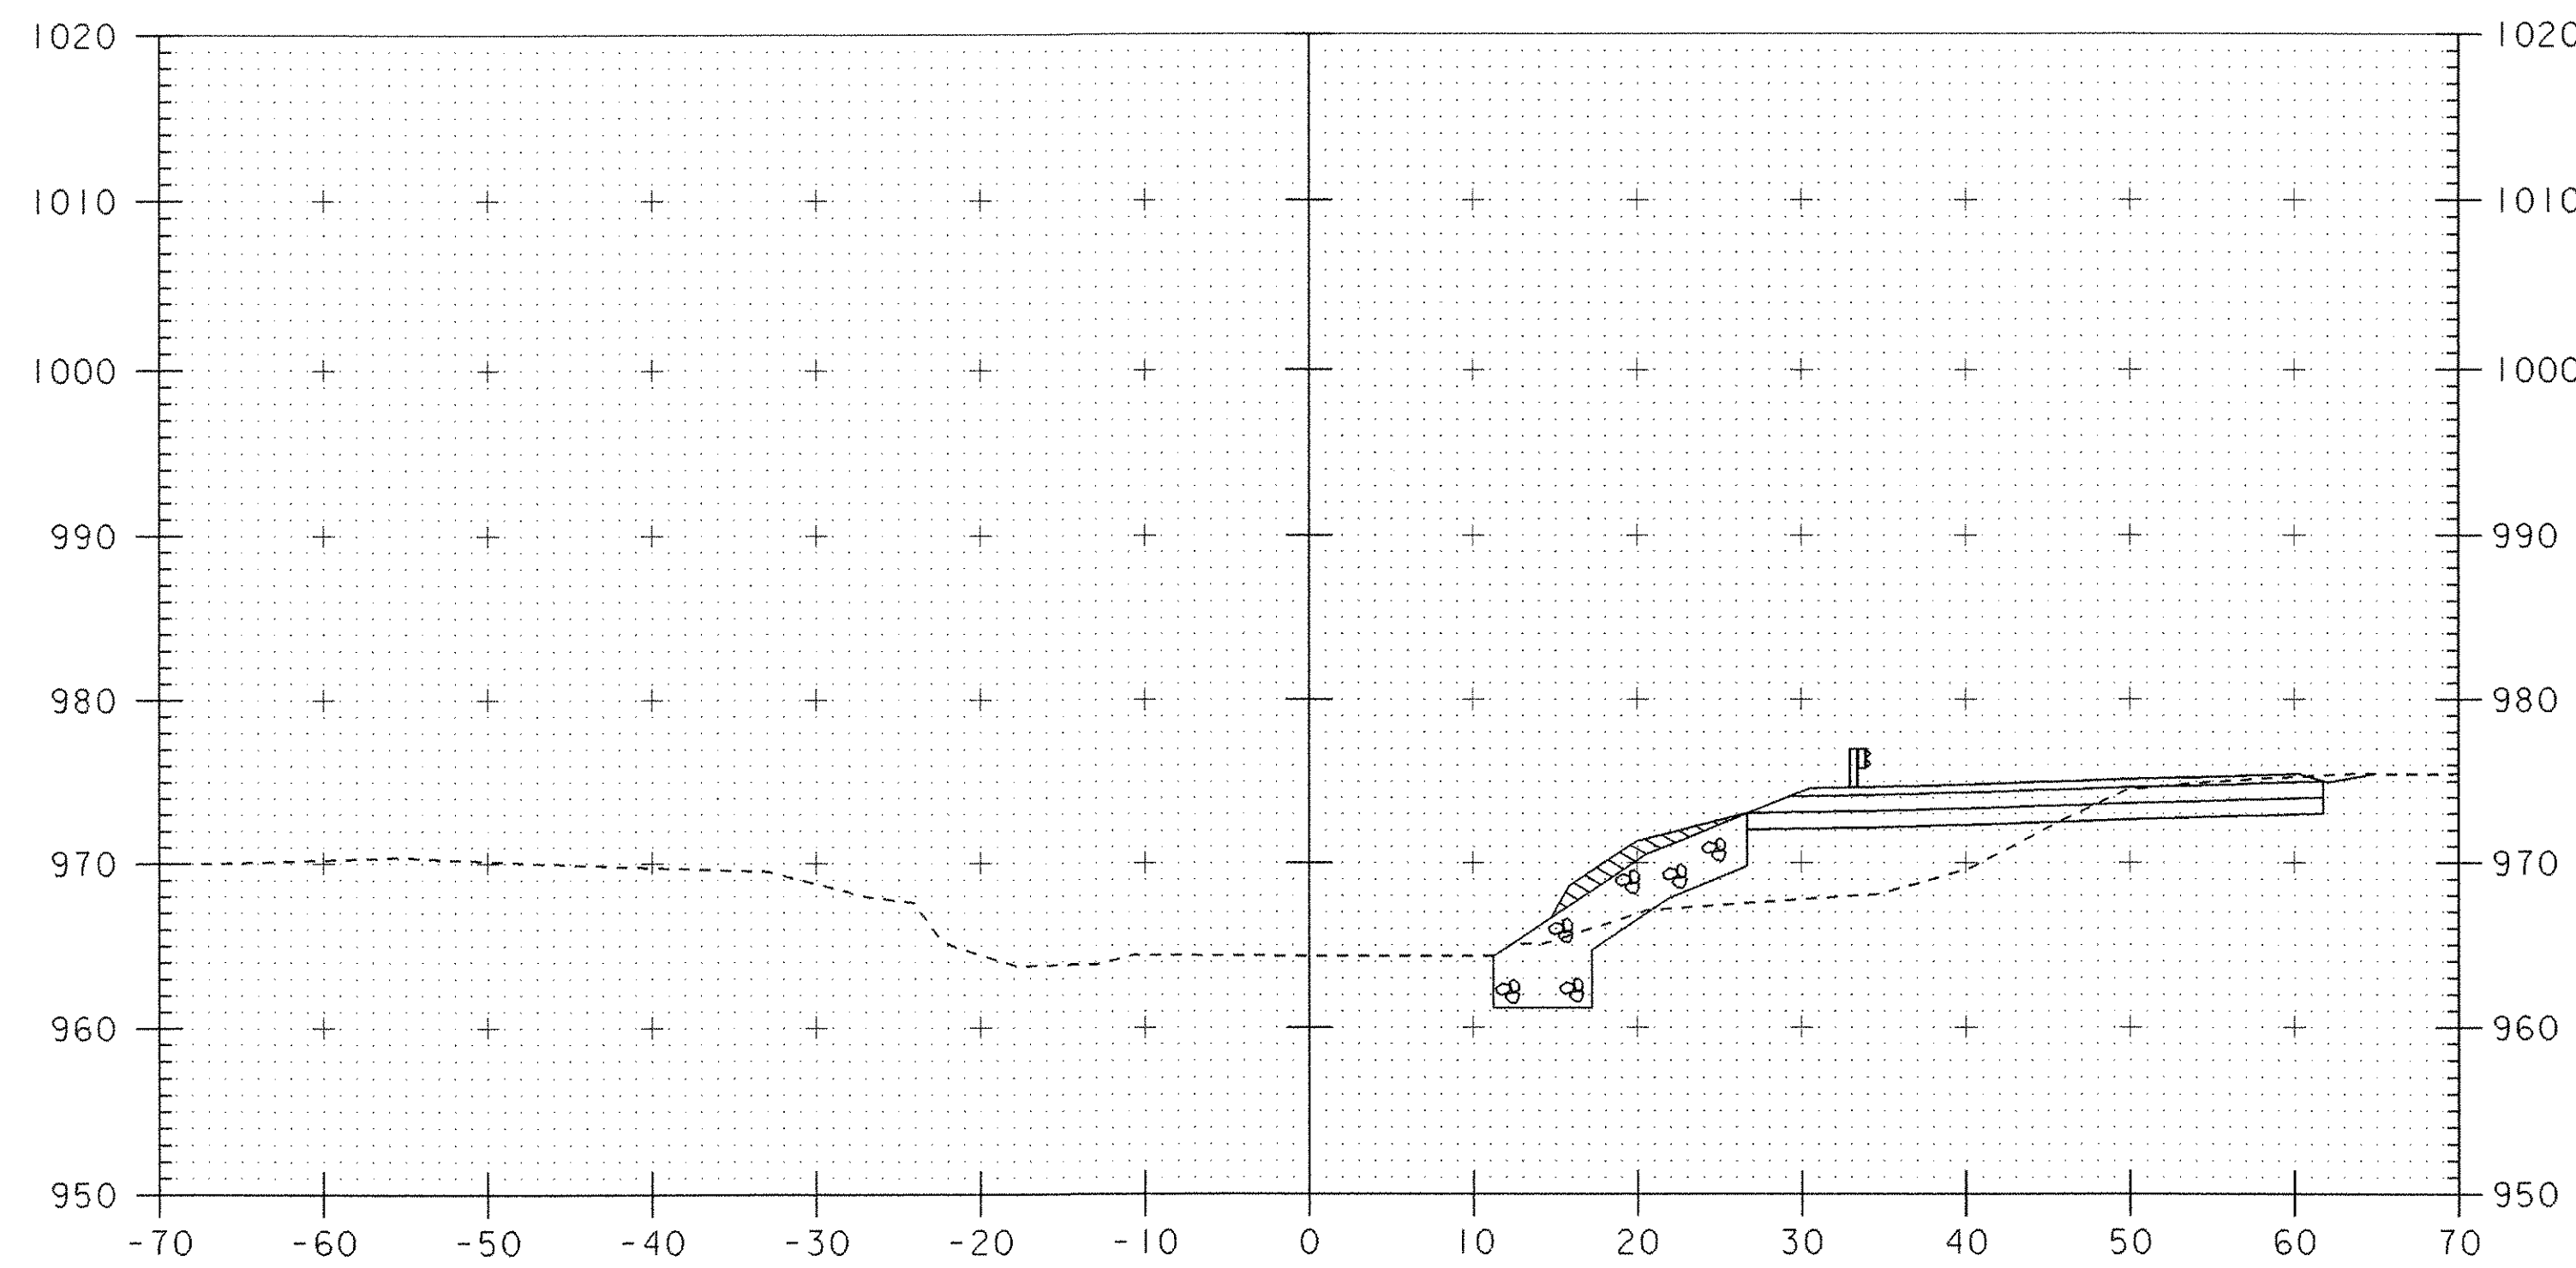

52+30

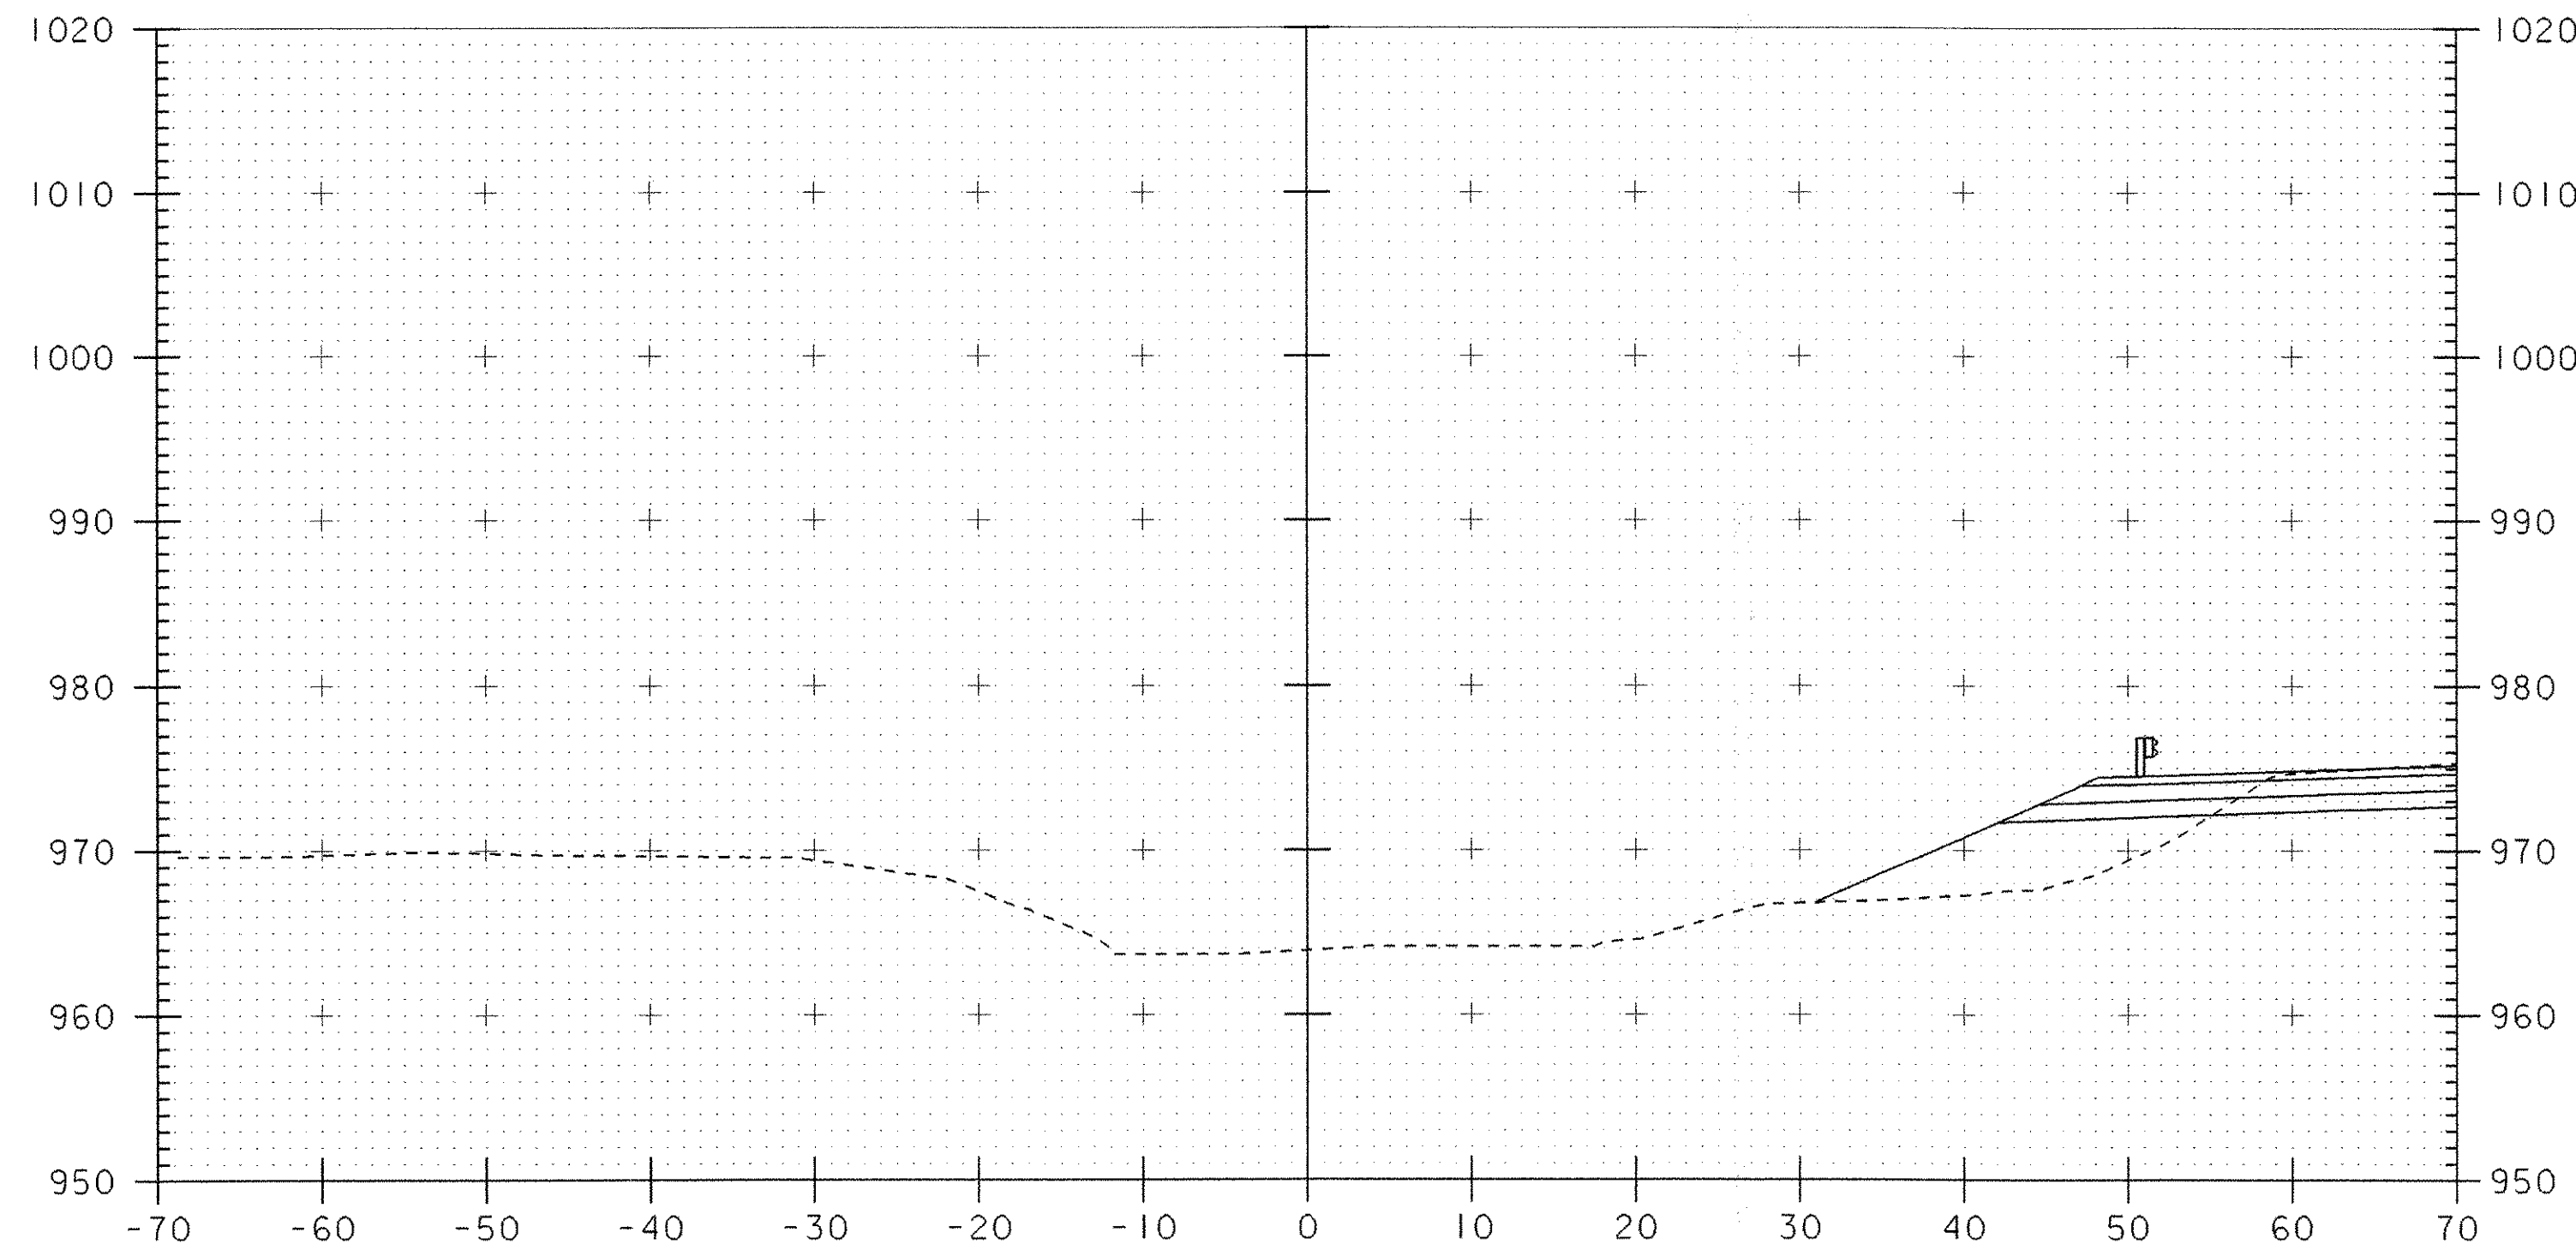

52+00

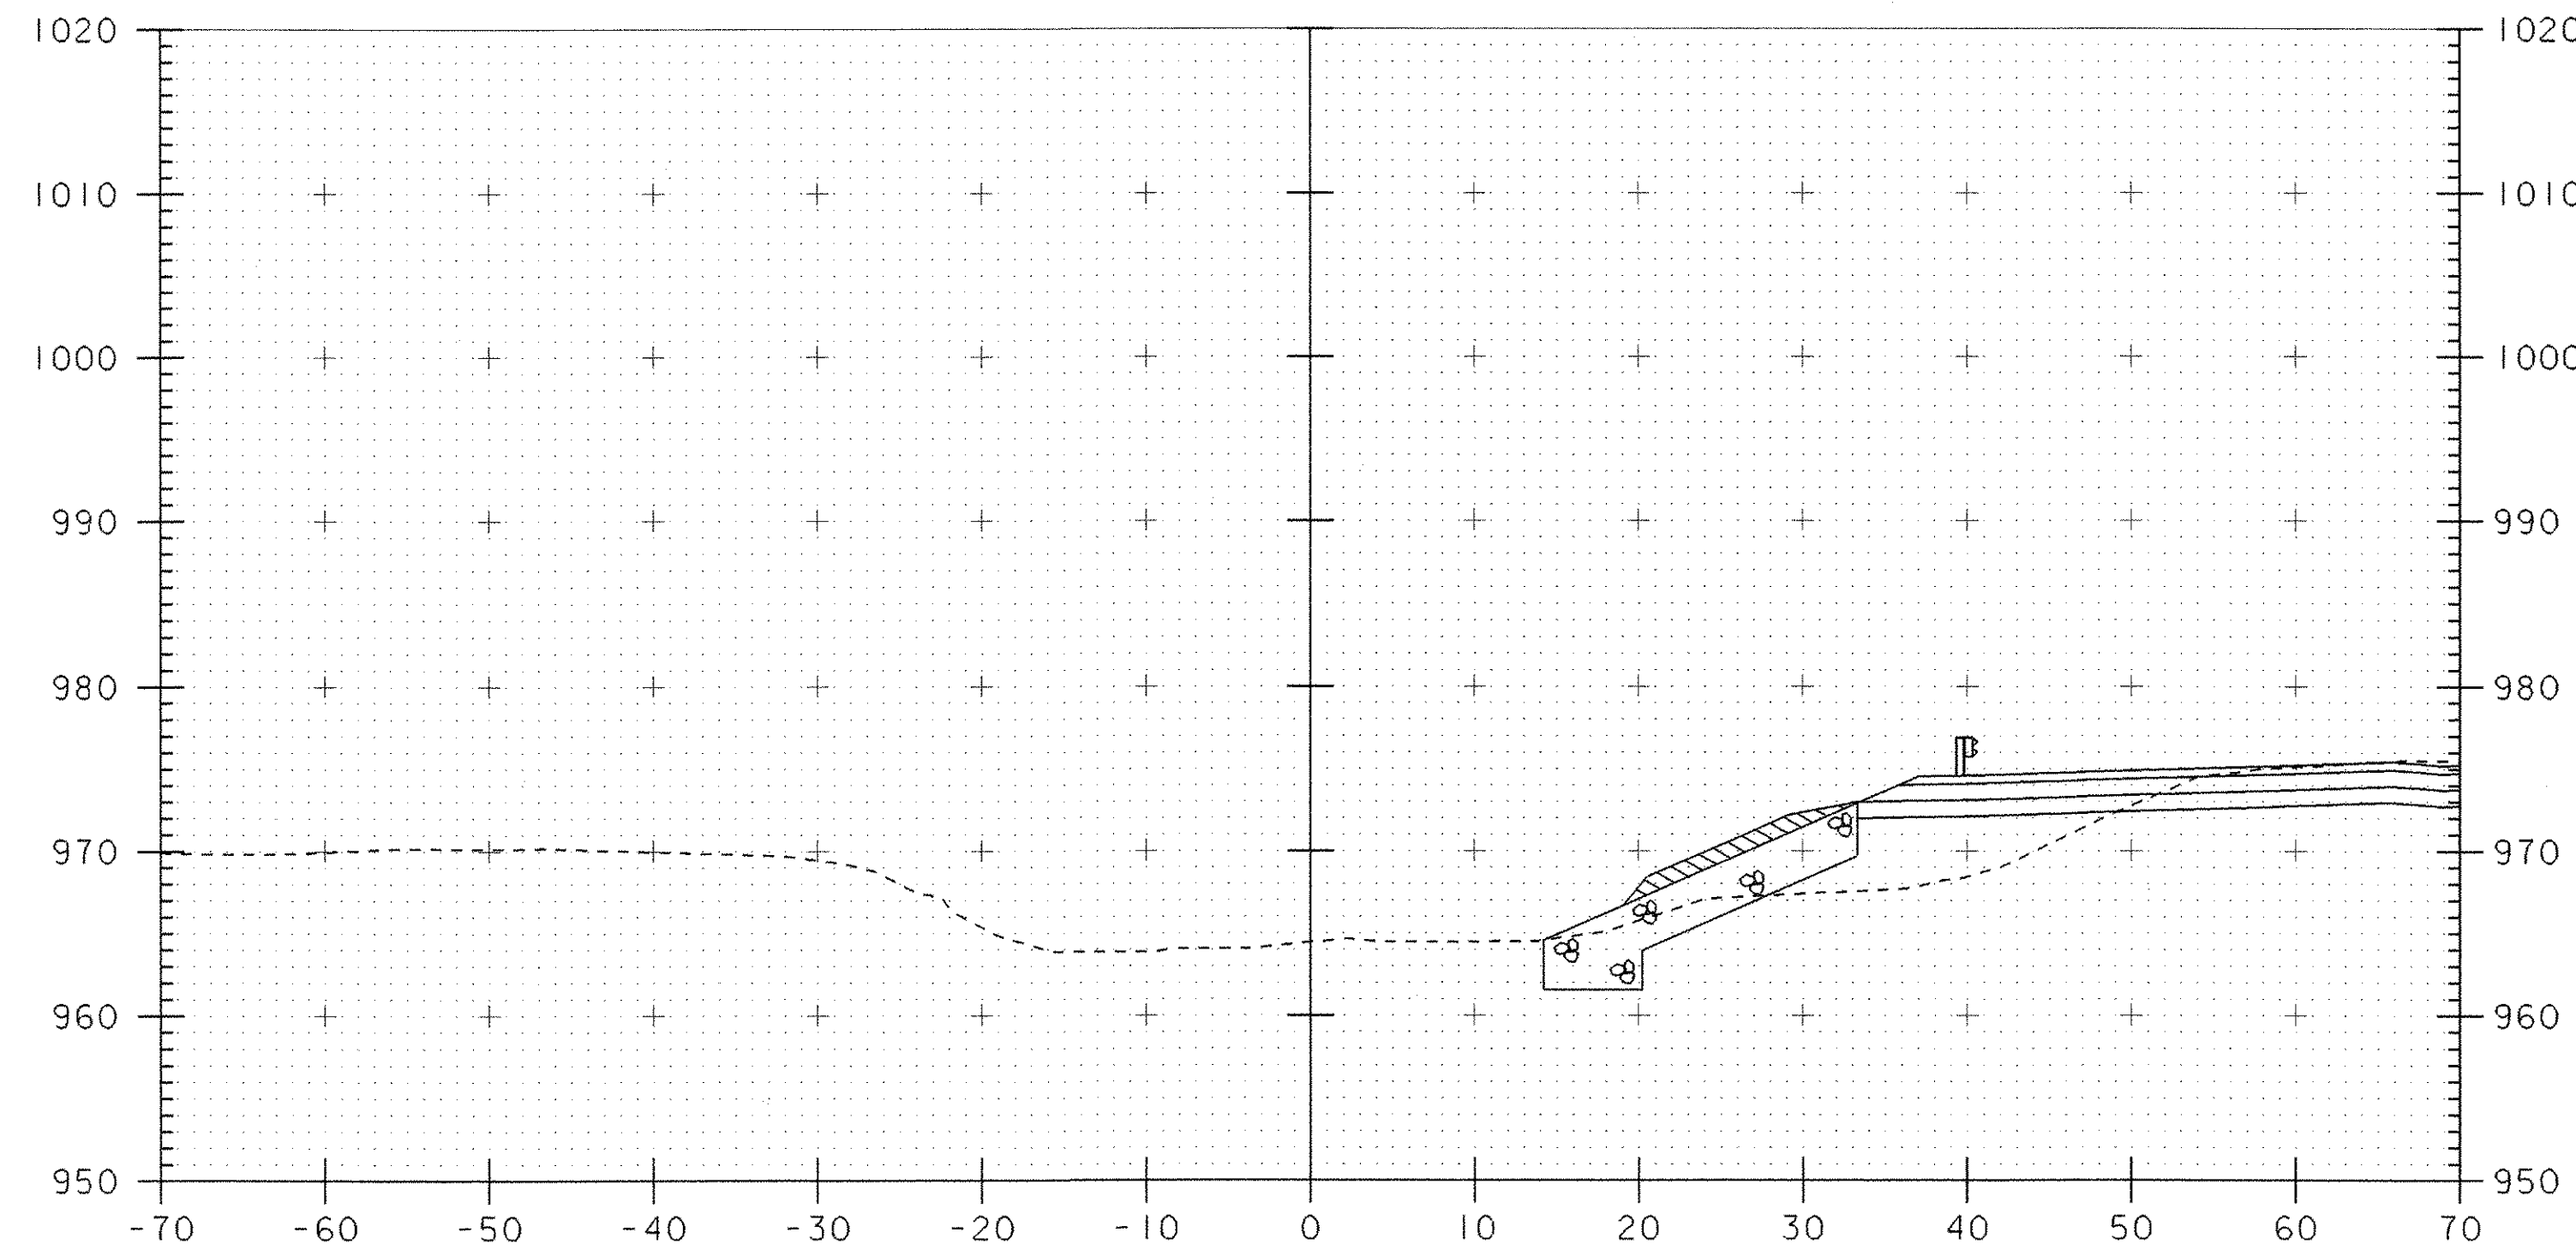

52+20



PROJECT: READING	PROJECT NO. : BRZ 1444(23)
DESIGN FILE NAME: /usr/str4/90j058/sj058csc.dgn	PLOT DATE: 13-FEB-2008
CHANNEL LINE SECTIONS 52+00 THRU 52+30	
SHEET: 44 OF 49	