



OTTER CREEK
ENGINEERING, INC.
102 Court Street
P.O. Box 403
Middlebury, VT 05759
Telephone: 802.362-3722
Fax: 802.362-6640
E-mail: office@ottercreek.com

THESE DRAWINGS SHALL NOT BE ALTERED IN ANY WAY WITHOUT THE WRITTEN APPROVAL OF THE ENGINEER. ANY REVISIONS SHALL BE MADE BY THE ENGINEER AND NOTED IN THE REVISION BLOCK.
OCTOBER 1988
OTTER CREEK ENGINEERING, INC.

STAMP AND SIGNATURE:



**EAST MIDDLEBURY
FIRE DISTRICT NO. 1
GRIST MILL BRIDGE
MIDDLEBURY BRZ 1445(19)
WATER MAIN REPLACEMENT
MIDDLEBURY, VERMONT**

BID

DATE ISSUED: 11/30/99

REVISIONS:

△ REVISION PER AOT LETTER
02-20-01 A

DRAWN BY: JL

CHECKED BY: PD

SCALE: AS SHOWN

PROJECT NO.: 072-001

CADD FILE: 072-001


TITLE:

**WATER MAIN
PROFILE**

DRAWING NO.

2

SHEET: 16 OF 55

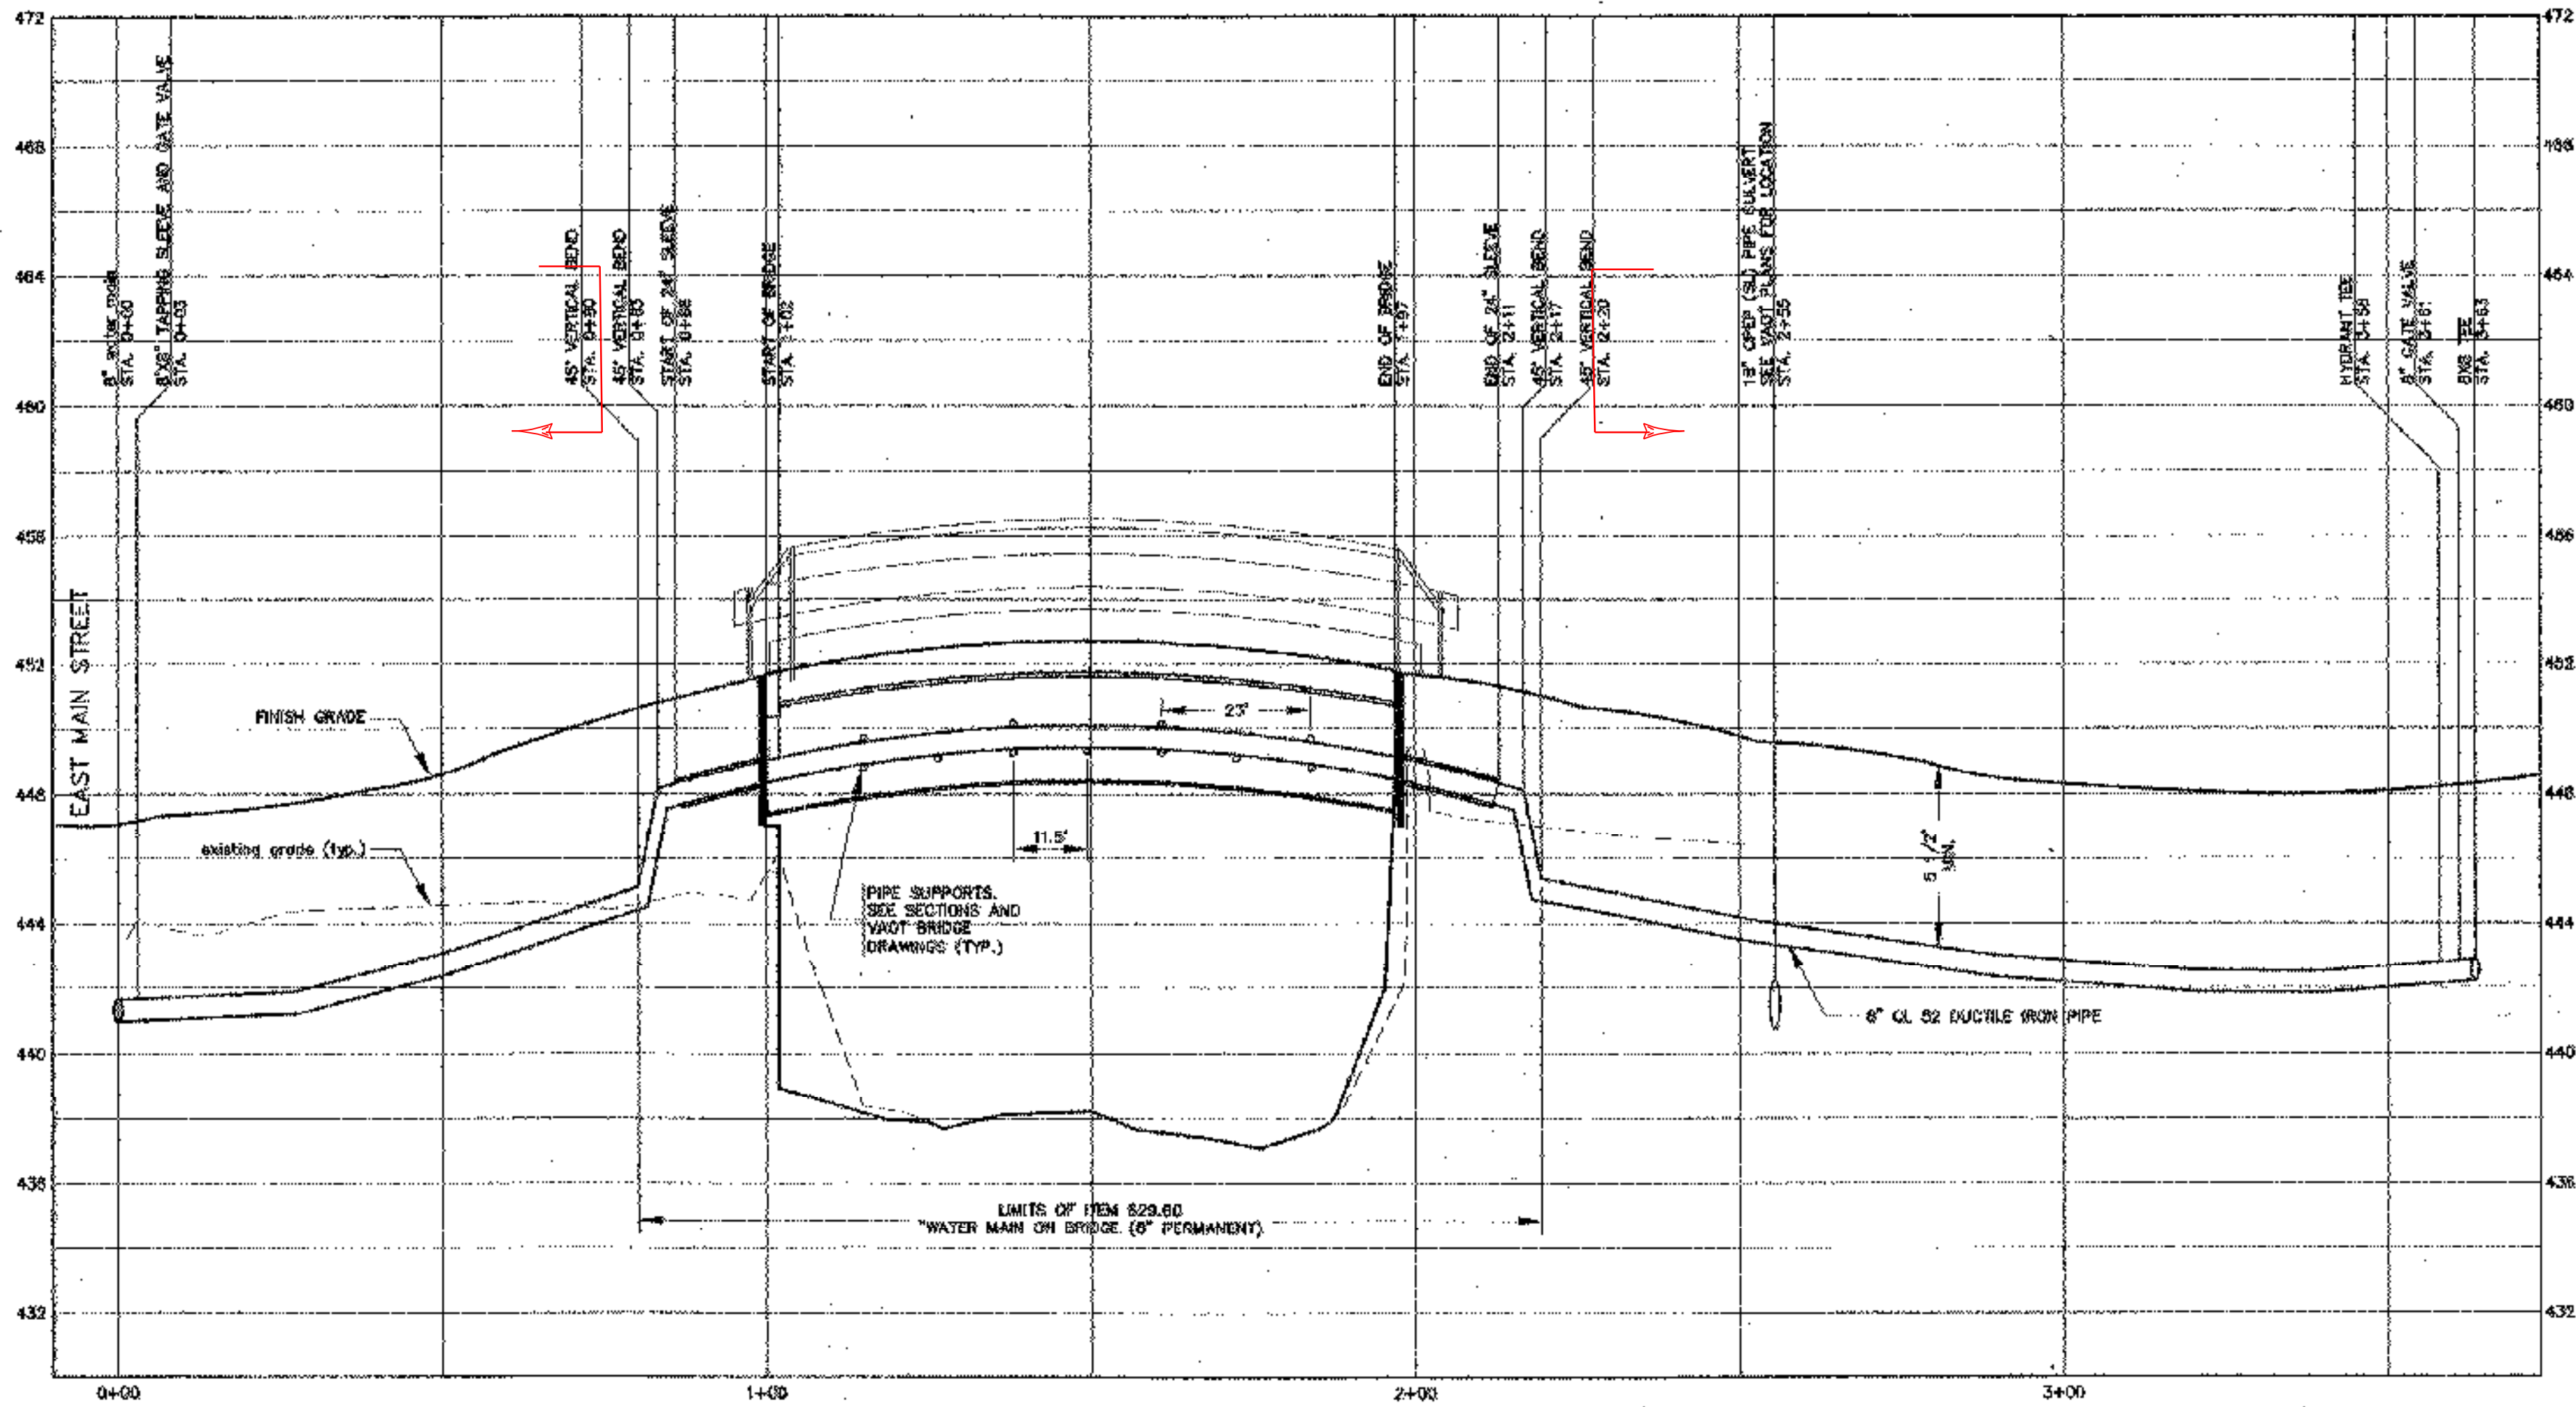

WATER MAIN PROFILE
SCALE: 1" = 20' HORIZONTAL
1" = 4' VERTICAL