


STATE OF VERMONT AGENCY OF TRANSPORTATION

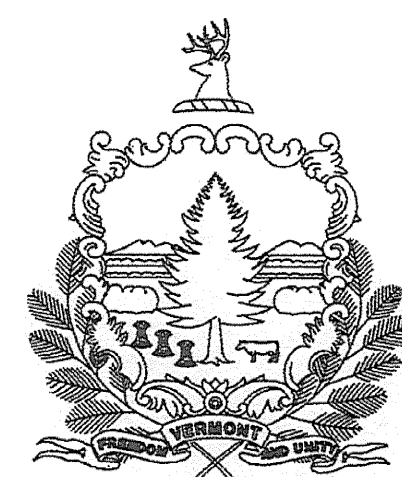

PROPOSED IMPROVEMENT

BRIDGE PROJECT

TOWN OF JOHNSON





COUNTY OF LAMOILLE

ROUTE NO.: TH2 (RAILROAD ST.), CLASS 2, BRIDGE NO.: 6

PROJECT LOCATION : BEGINNING AT THE INTERSECTION OF TH2 AND TH45 AND PROCEEDING
EASTERLY APPROXIMATELY 0.06 MILES.

PROJECT DESCRIPTION : REHABILITATION OF EXISTING BRIDGE
WITH APPROACH WORK.

LENGTH OF ROADWAY : 180.5 FEET
LENGTH OF STRUCTURE : 144.5 FEET
LENGTH OF PROJECT : 325 FEET

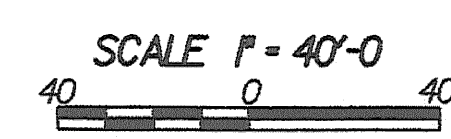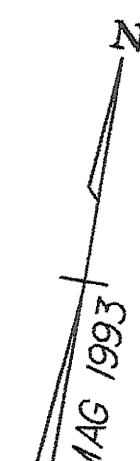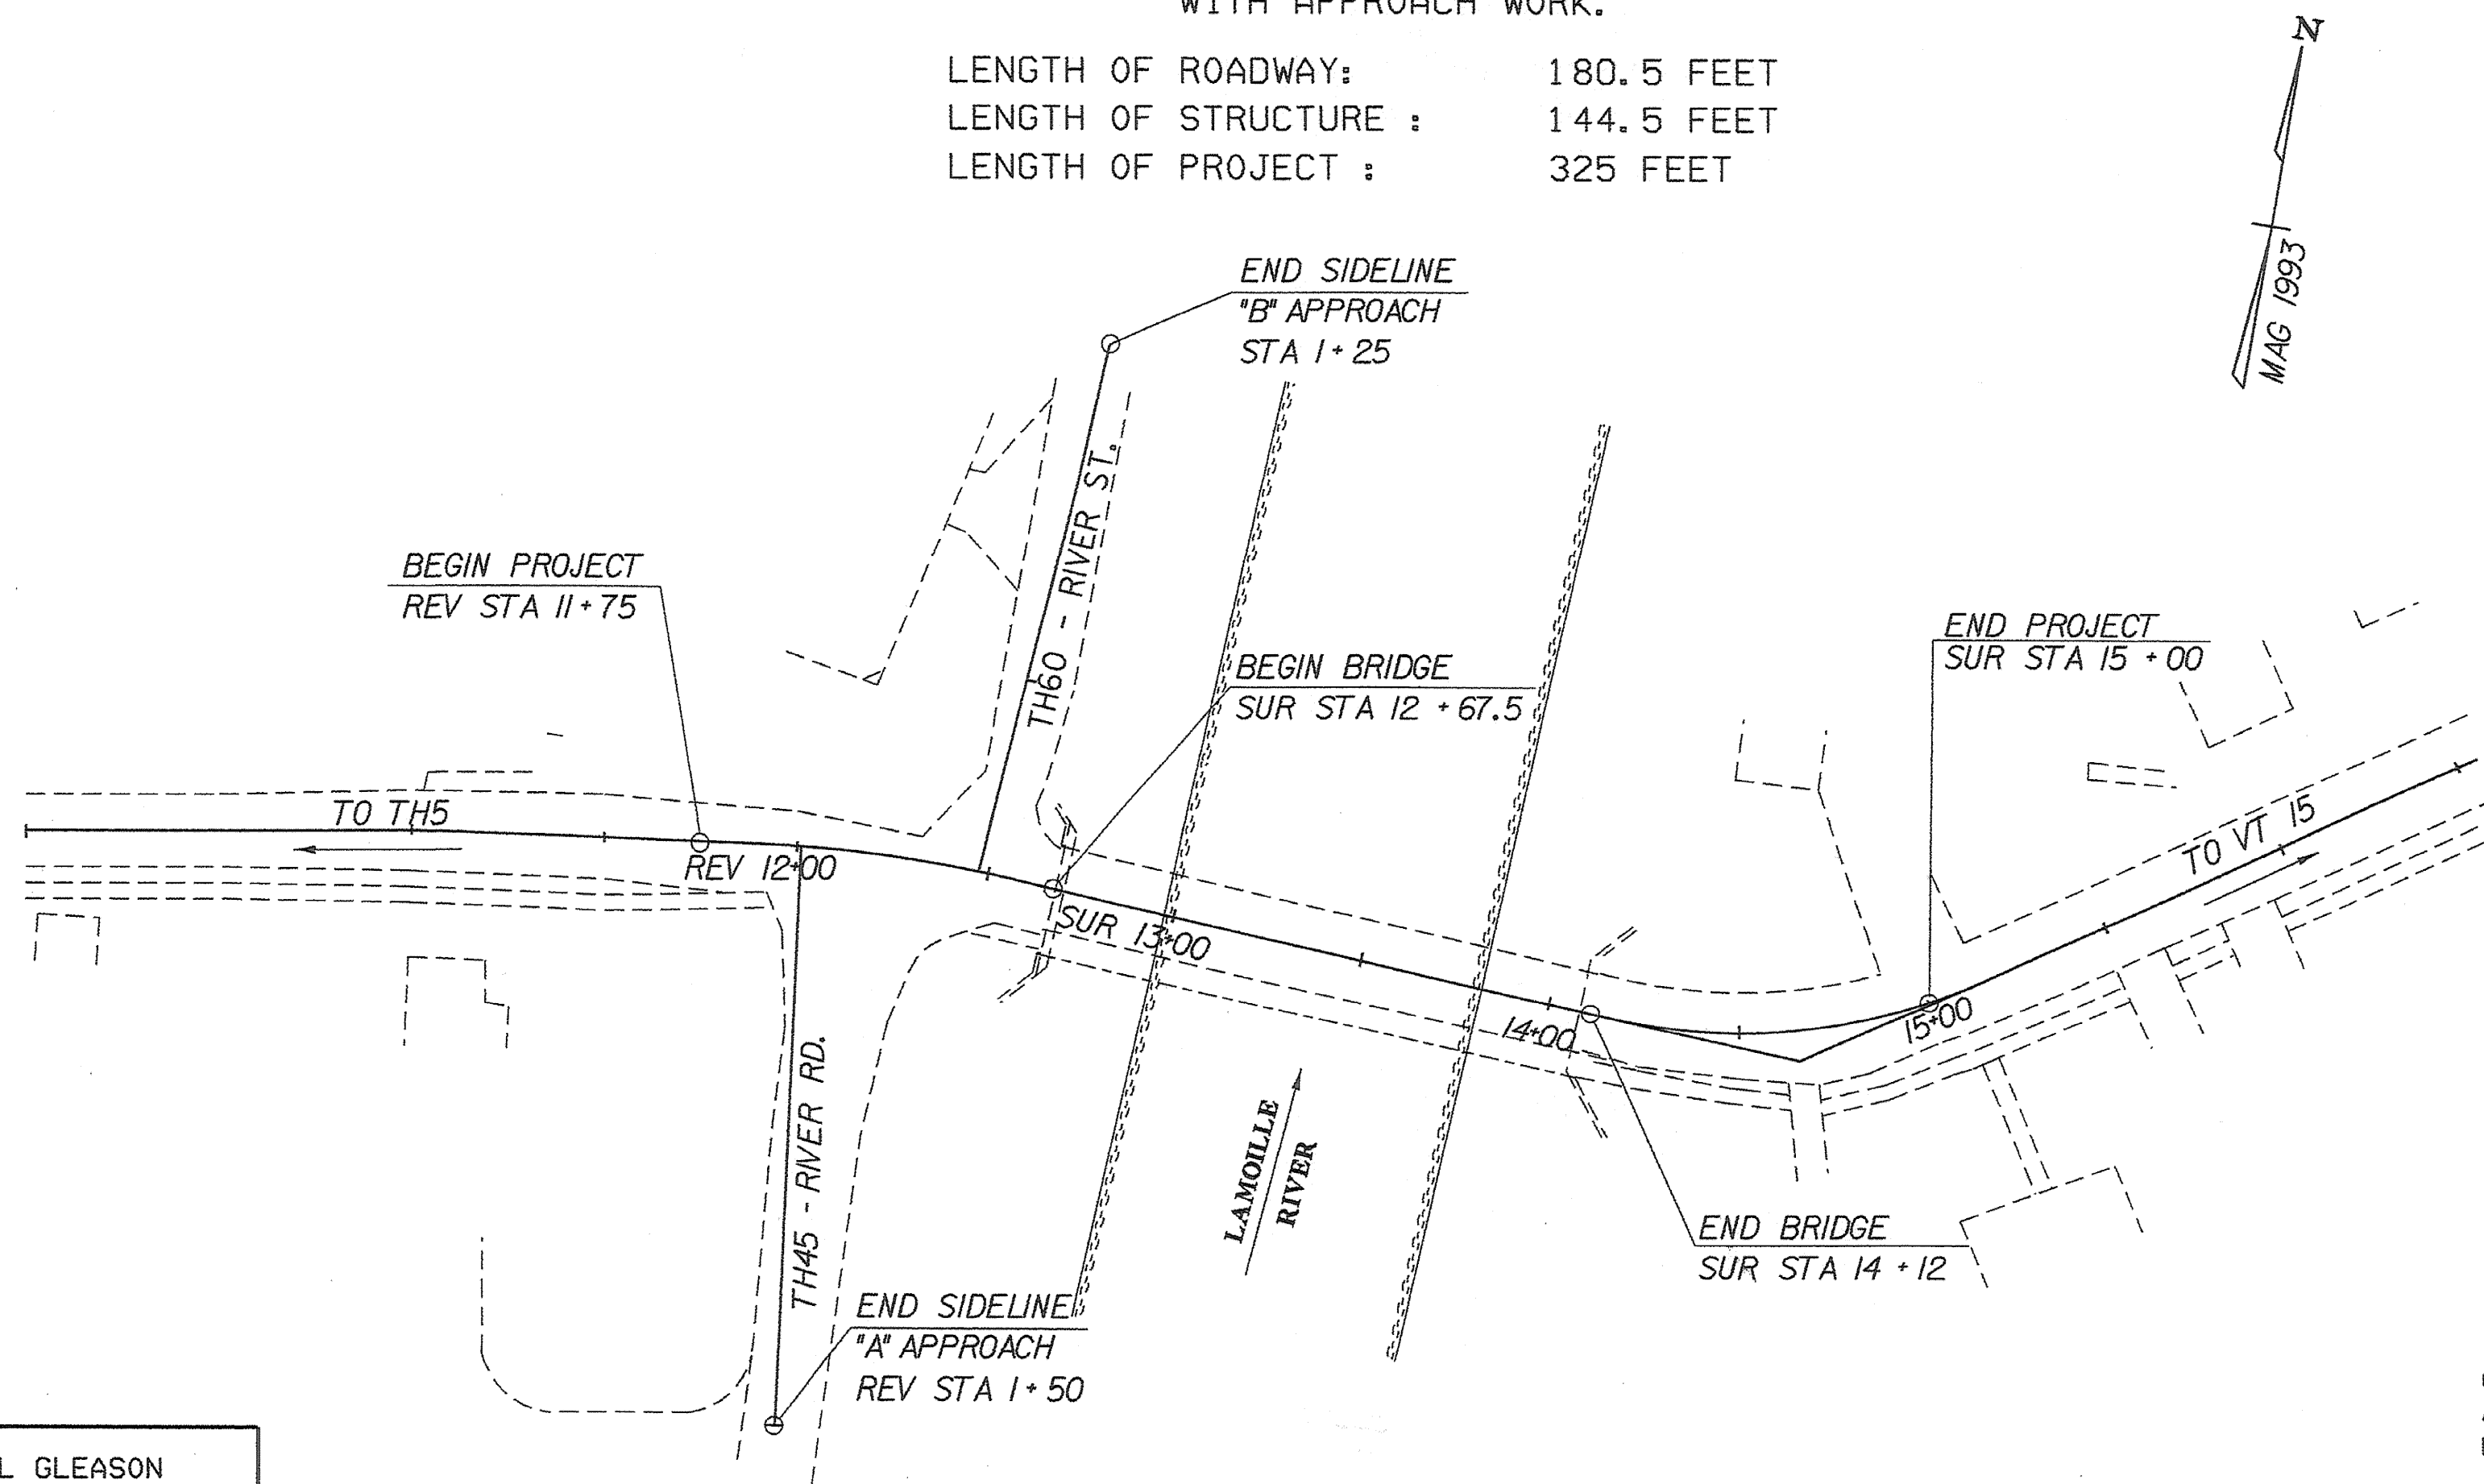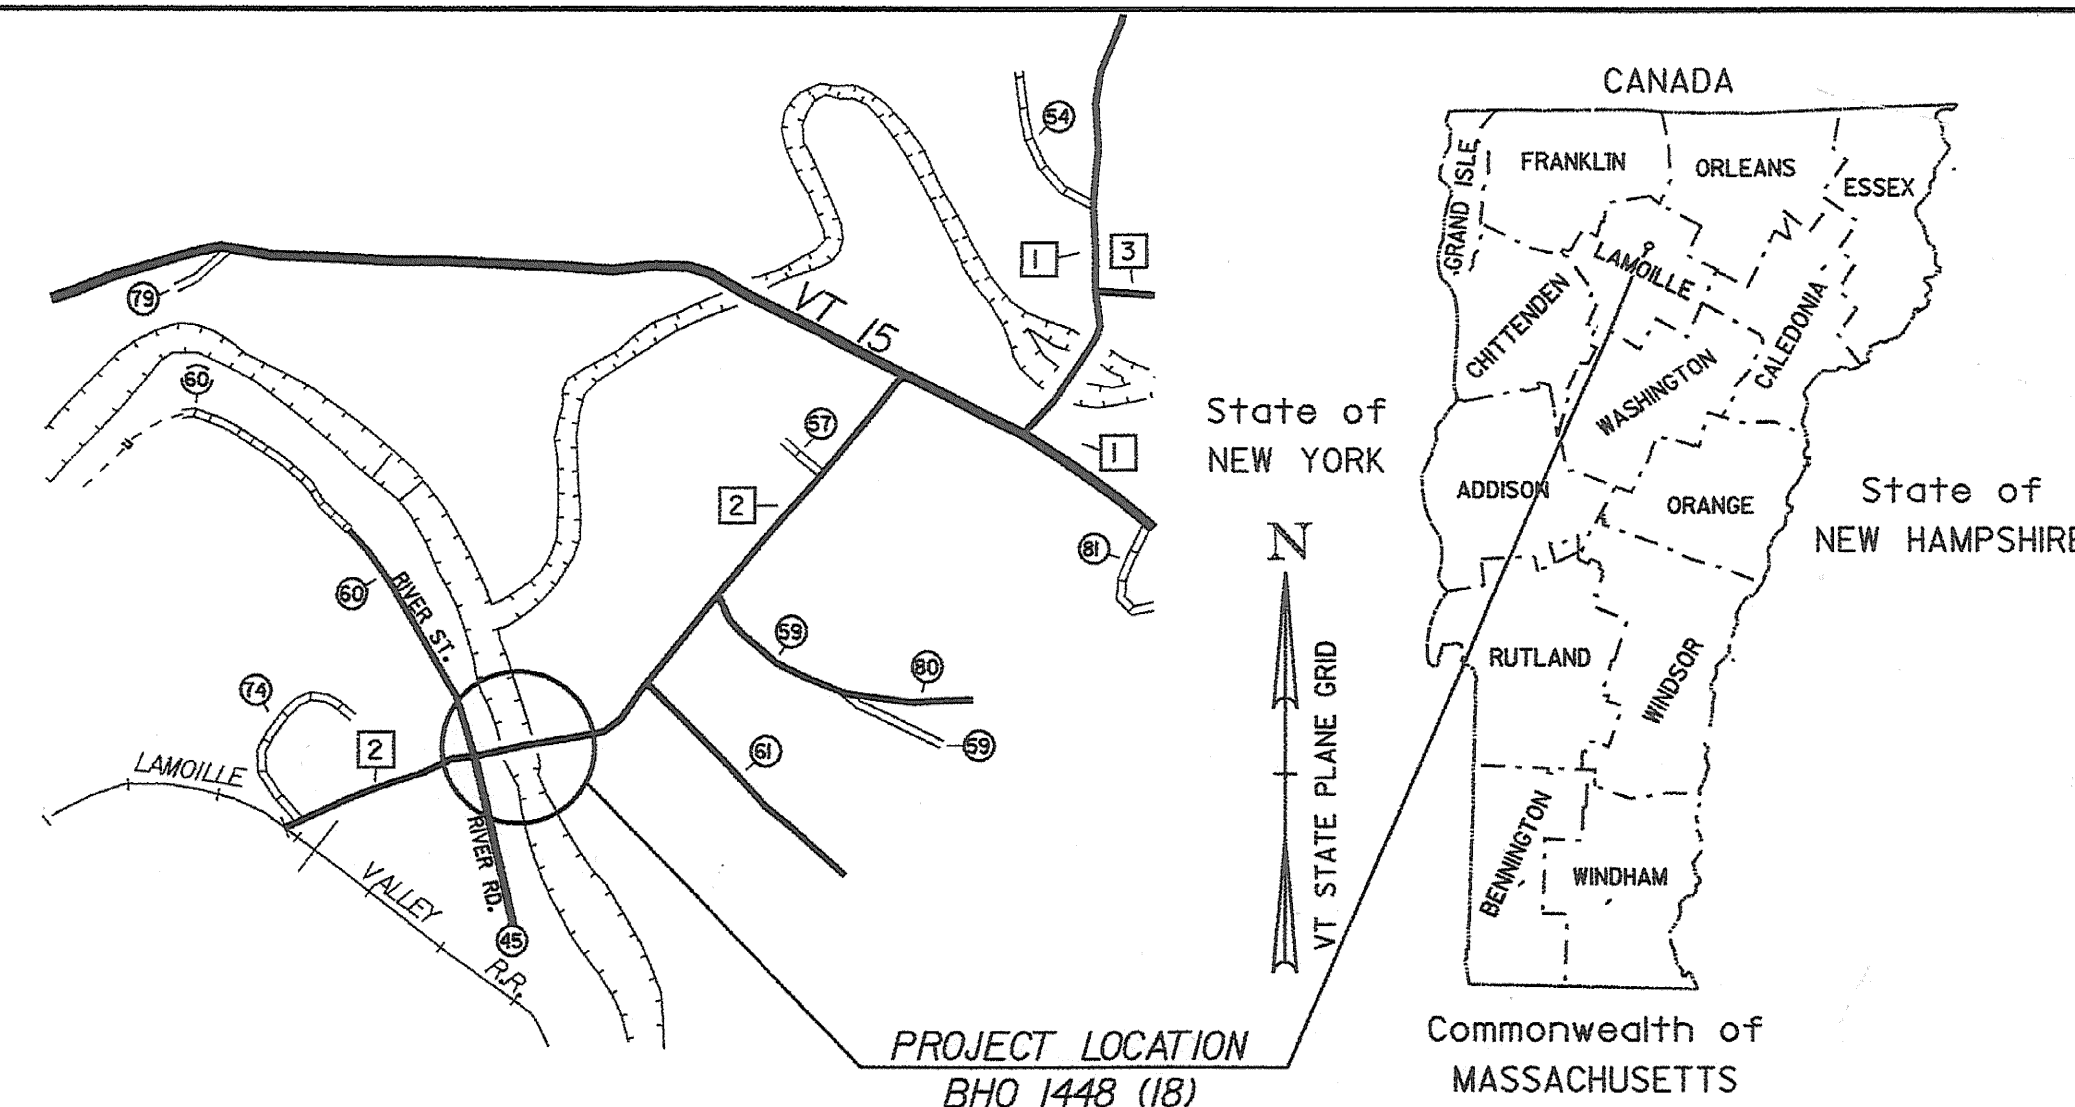

RECORD PLANS	
CONTRACTOR:	CCS CONSTRUCTORS LLC - MORRISVILLE, VT
RESIDENT ENGINEER:	JEFF COTA
CONSTRUCTION BEGAN:	APRIL 3, 2006
CONSTRUCTION COMPLETE:	MAY 19, 2008
RECORD PLANS BY:	J. COTA & C. PIERCE
I HEREBY CERTIFY THAT ALL THE CONSTRUCTION REQUIRED BY THIS SET OF DRAWINGS HAS BEEN ACCOMPLISHED AS INDICATED HEREIN.	
BY:	RESIDENT ENGINEER
DATE:	1/29/10
NOTE: Any further information concerning final quantities, amounts or other details relative to this project may be found at Central Files in the electronic archives.	

CONVENTIONAL SYMBOLS	
COUNTY LINE	
TOWN LINE	
LIMITS OF ACCESS	
POINT OF ACCESS	
FENCE LINE	
STONE WALL	
TRAVELED WAY	
GUARD RAIL	
RAILROAD	
SURVEY LINE	
CULVERT	
POWER POLE	
TELEPHONE POLE	
TREES	
CONTROL OF ACCESS	
PROPERTY LINE	
R.O.W. TAKING LINE	
SLOPE RIGHTS	
TOP OF CUT	
TOE OF SLOPE	

SURVEYED BY : CARL GLEASON
 SURVEYED DATE : APRIL 1993

DATUM
 VERTICAL USGS
 HORIZONTAL N/A

THESE PLANS ARE SUBJECT TO SUCH ENGINEERING CHANGES AS MAY BE REQUIRED BY THE FEDERAL HIGHWAY ADMINISTRATION OR THE DIRECTOR OF PROGRAM DEVELOPMENT.
 CONSTRUCTION IS TO BE CARRIED ON IN ACCORDANCE WITH THESE PLANS AND THE STANDARD SPECIFICATIONS FOR CONSTRUCTION DATED 2001, AS APPROVED BY THE FEDERAL HIGHWAY ADMINISTRATION ON JANUARY 4, 2001 FOR USE ON THIS PROJECT, INCLUDING ALL SUBSEQUENT REVISIONS AND SUCH REVISED SPECIFICATIONS AND SPECIAL PROVISIONS AS ARE INCORPORATED IN THESE PLANS.
 PLOTTED: 28-JUL-2005
 /PW/90J067/sj067bdr.dgn sj067h.lj

DIRECTOR OF PROGRAM DEVELOPMENT
 APPROVED: *Richard Jehanek* DATE 8-1-05
 PROJECT MANAGER : R. WHITCOMB

PROJECT NAME : JOHNSON
 PROJECT NUMBER : AC BHO 1448(18) READVERTISED
 SHEET 1 OF 73 SHEETS