


**DOWNSTREAM ELEVATION**

STATIONING →

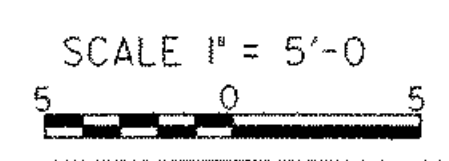

<b>SHEET NAME: BRIDGE RAILING LAYOUT</b>	
PROJECT NAME: JOHNSON	HIGHWAY NO.: TH 2
PROJECT NUMBER: BHO 1448(18)	BRIDGE NO.: 6
	OVER: THE LAMOILLE RIVER
FILE NAME: /str1/90j067/sj067ral.dgn	PLOT DATE: 02-SEP-2005
PROJECT MANAGER: R. WHITCOMB	DRAWN BY: J.GILMORE
DESIGNED BY: C. MEUNIER	IPARM NAME: sc067vtp.i
BRIDGE SHEET NUMBER:	SHEET 39 OF 73