



12+50 =
REV STA 12+49.39

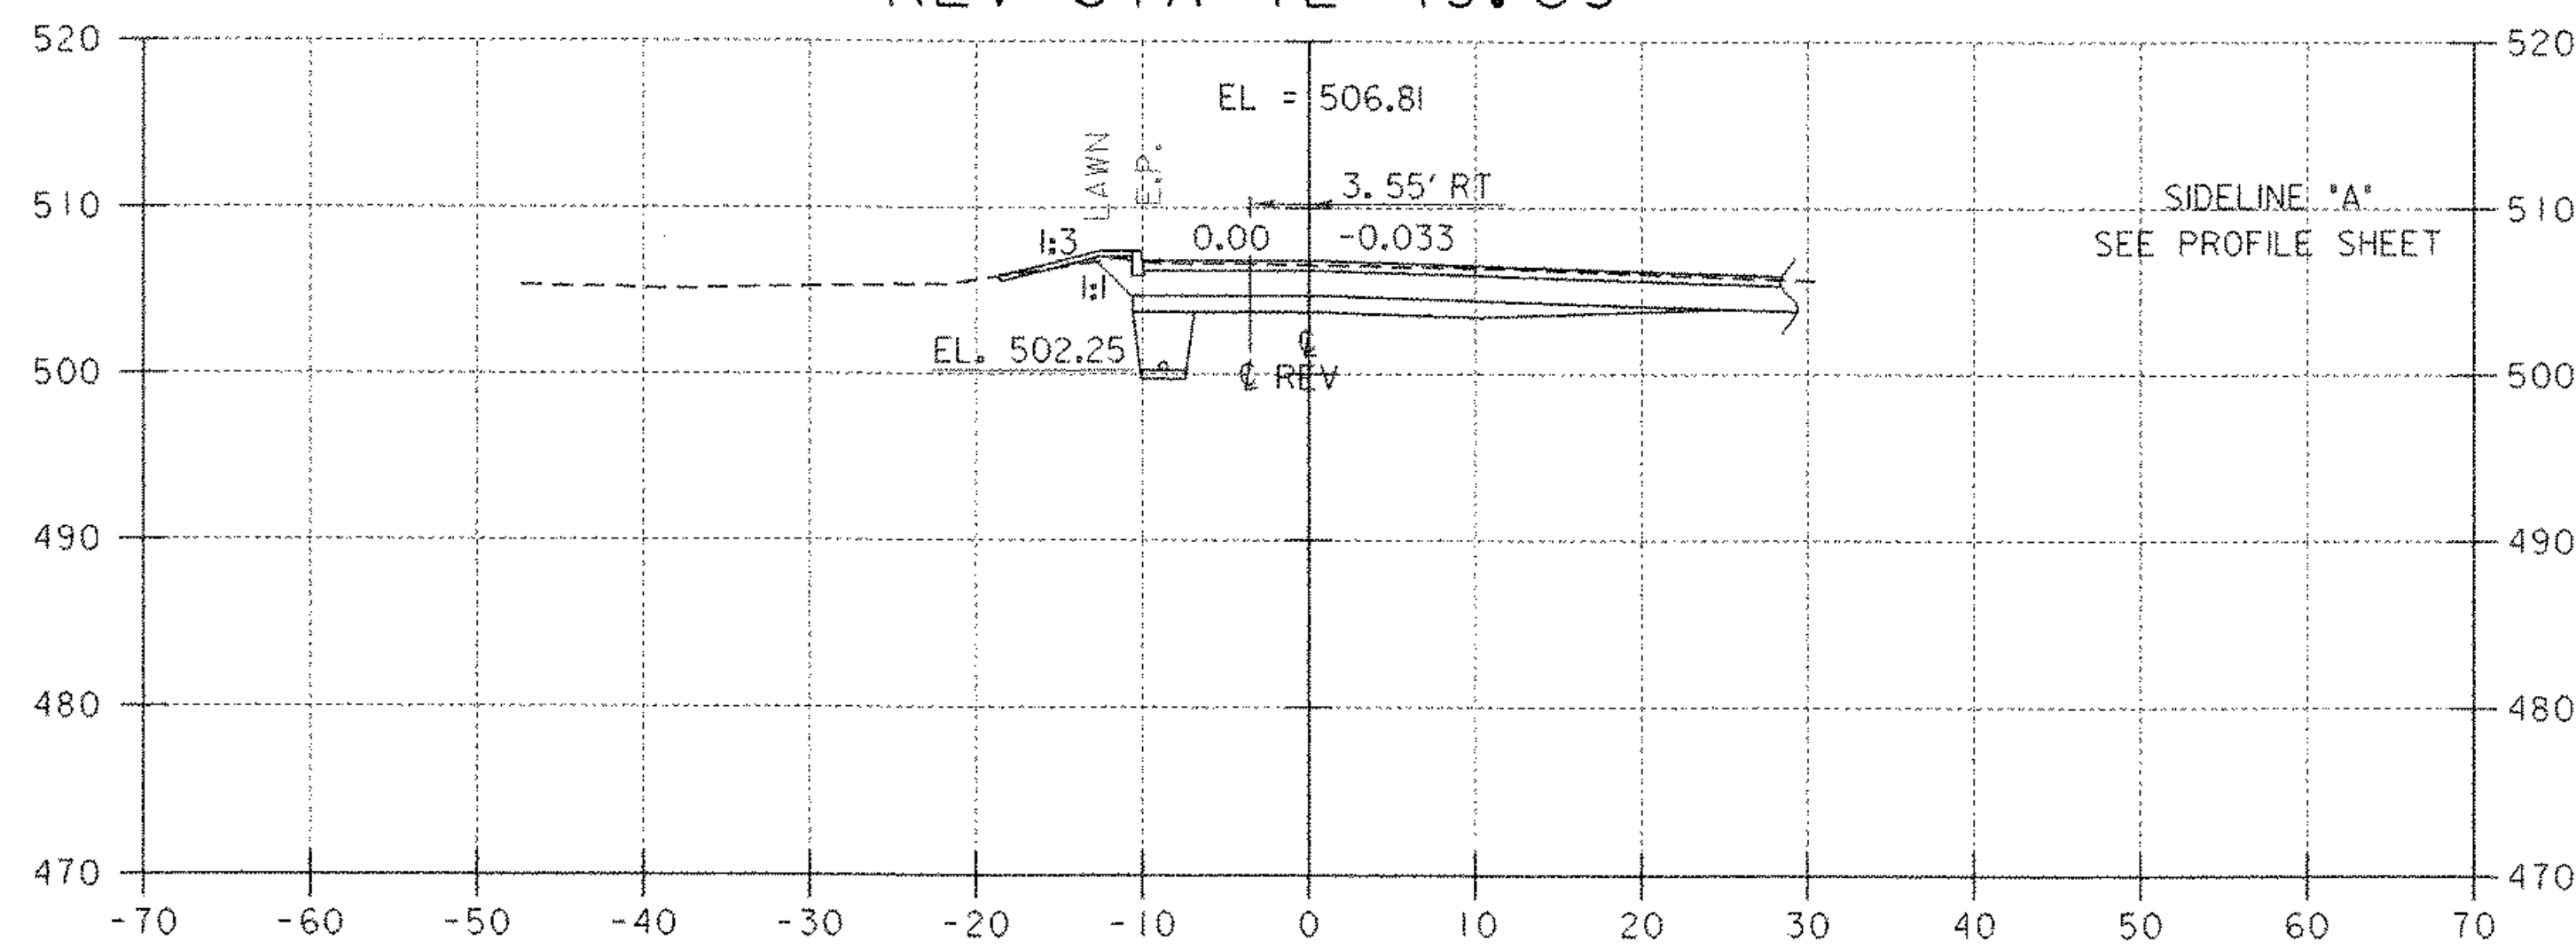

12+00
REV STA 12+00.07

PIPE AT REV STA 11+86
FOR SECTION
SEE SHEET 62

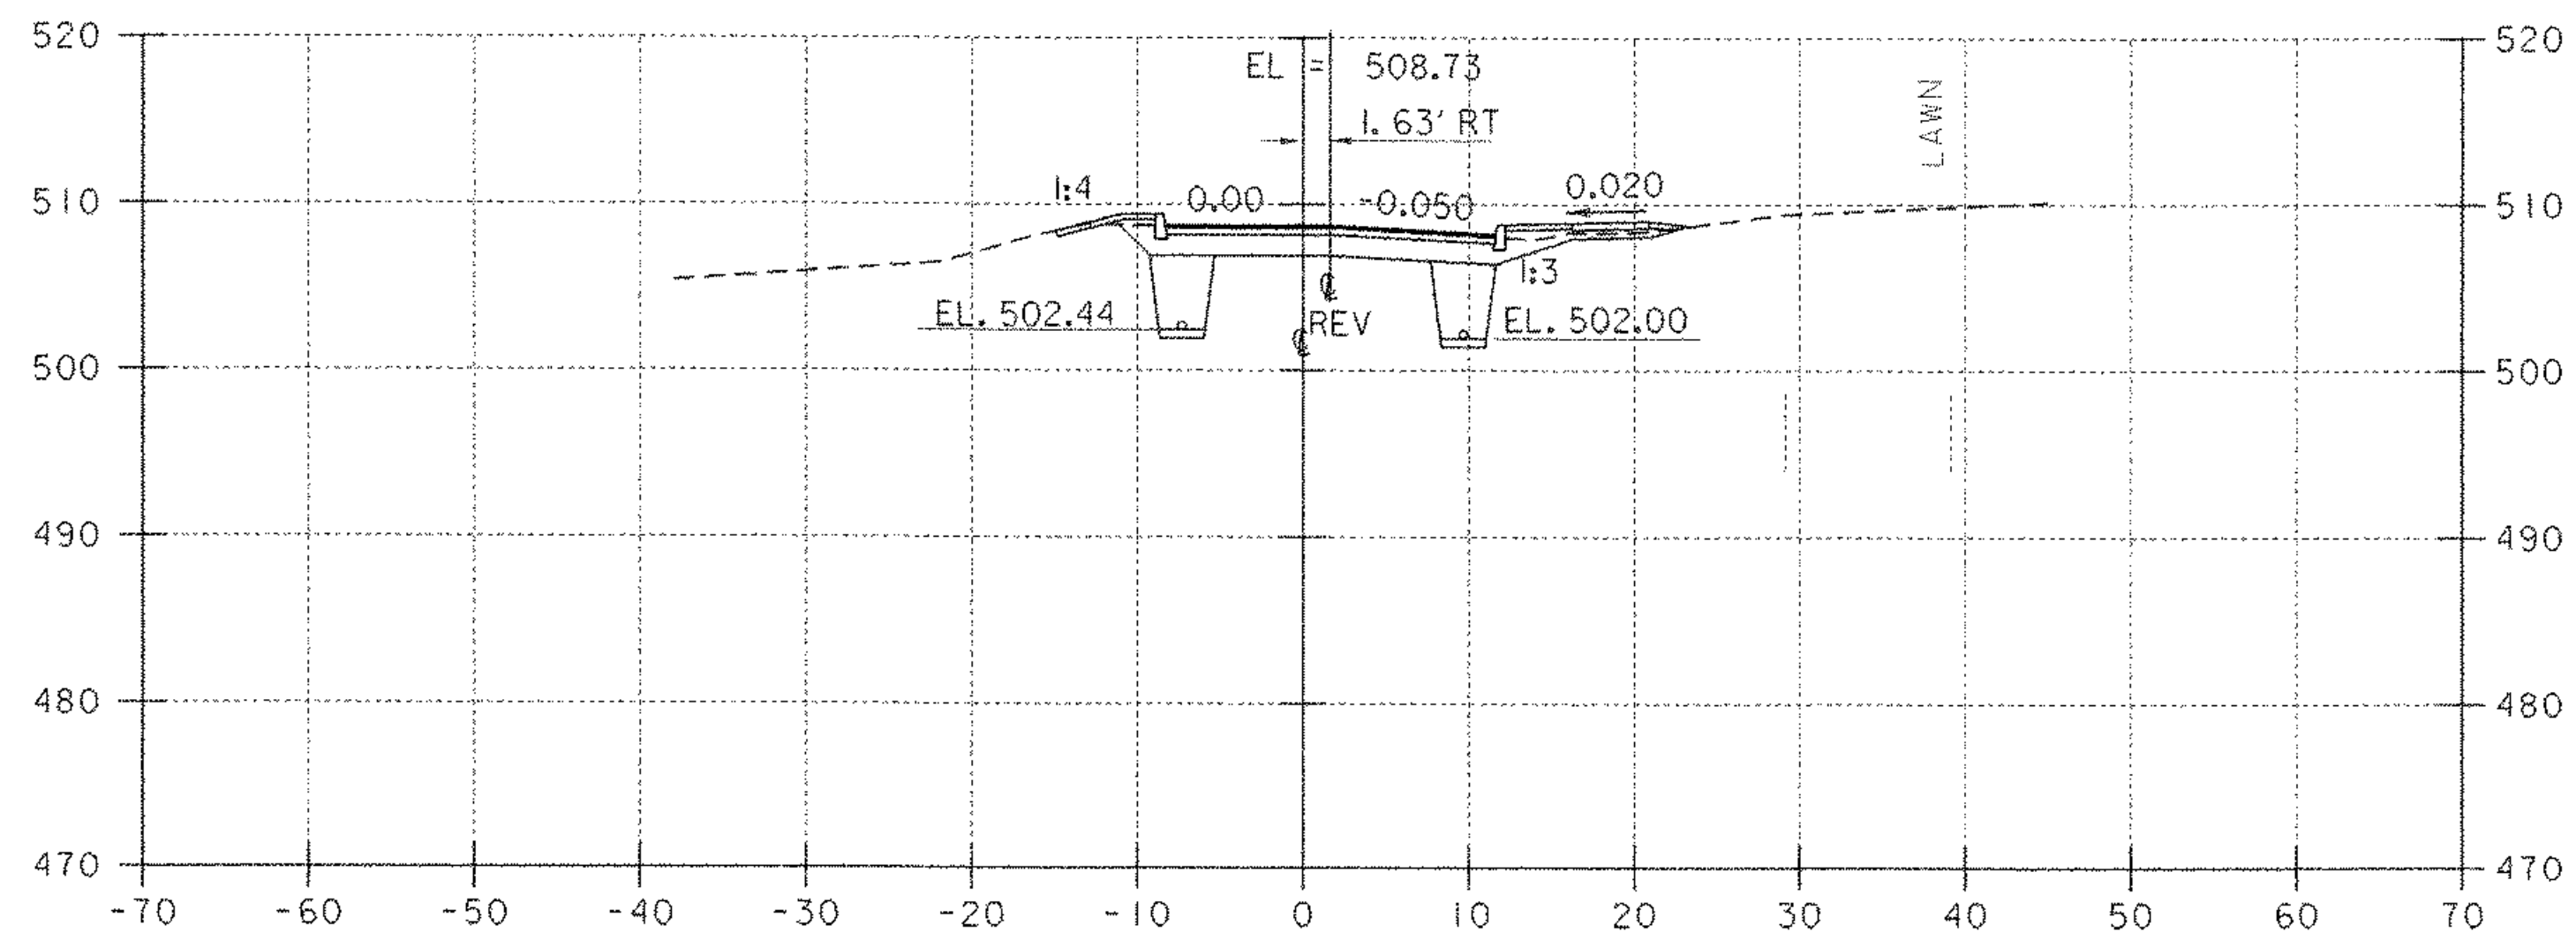

11+50 =
REV STA 11+50.03



REV STA 11+75
END APPROACH
BEGIN PROJECT

RAILROAD STREET

SHEET NAME: MAINLINE CROSS SECTIONS	
PROJECT NAME: JOHNSON	HIGHWAY NO.: TH 2
PROJECT NUMBER: BHO 1448(18)	BRIDGE NO.: 6
	OVER: THE LAMOILLE RIVER
FILE NAME: /s/tr1/90j067/sj067xs.dgn	PLOT DATE: 02-SEP-2005
PROJECT MANAGER: R. WHITCOMB	DRAWN BY: S. MAGNAN
DESIGNED BY: C. MEUNIER	IPARM NAME: sc067x02.1
BRIDGE SHEET NUMBER:	SHEET 55 OF 73