
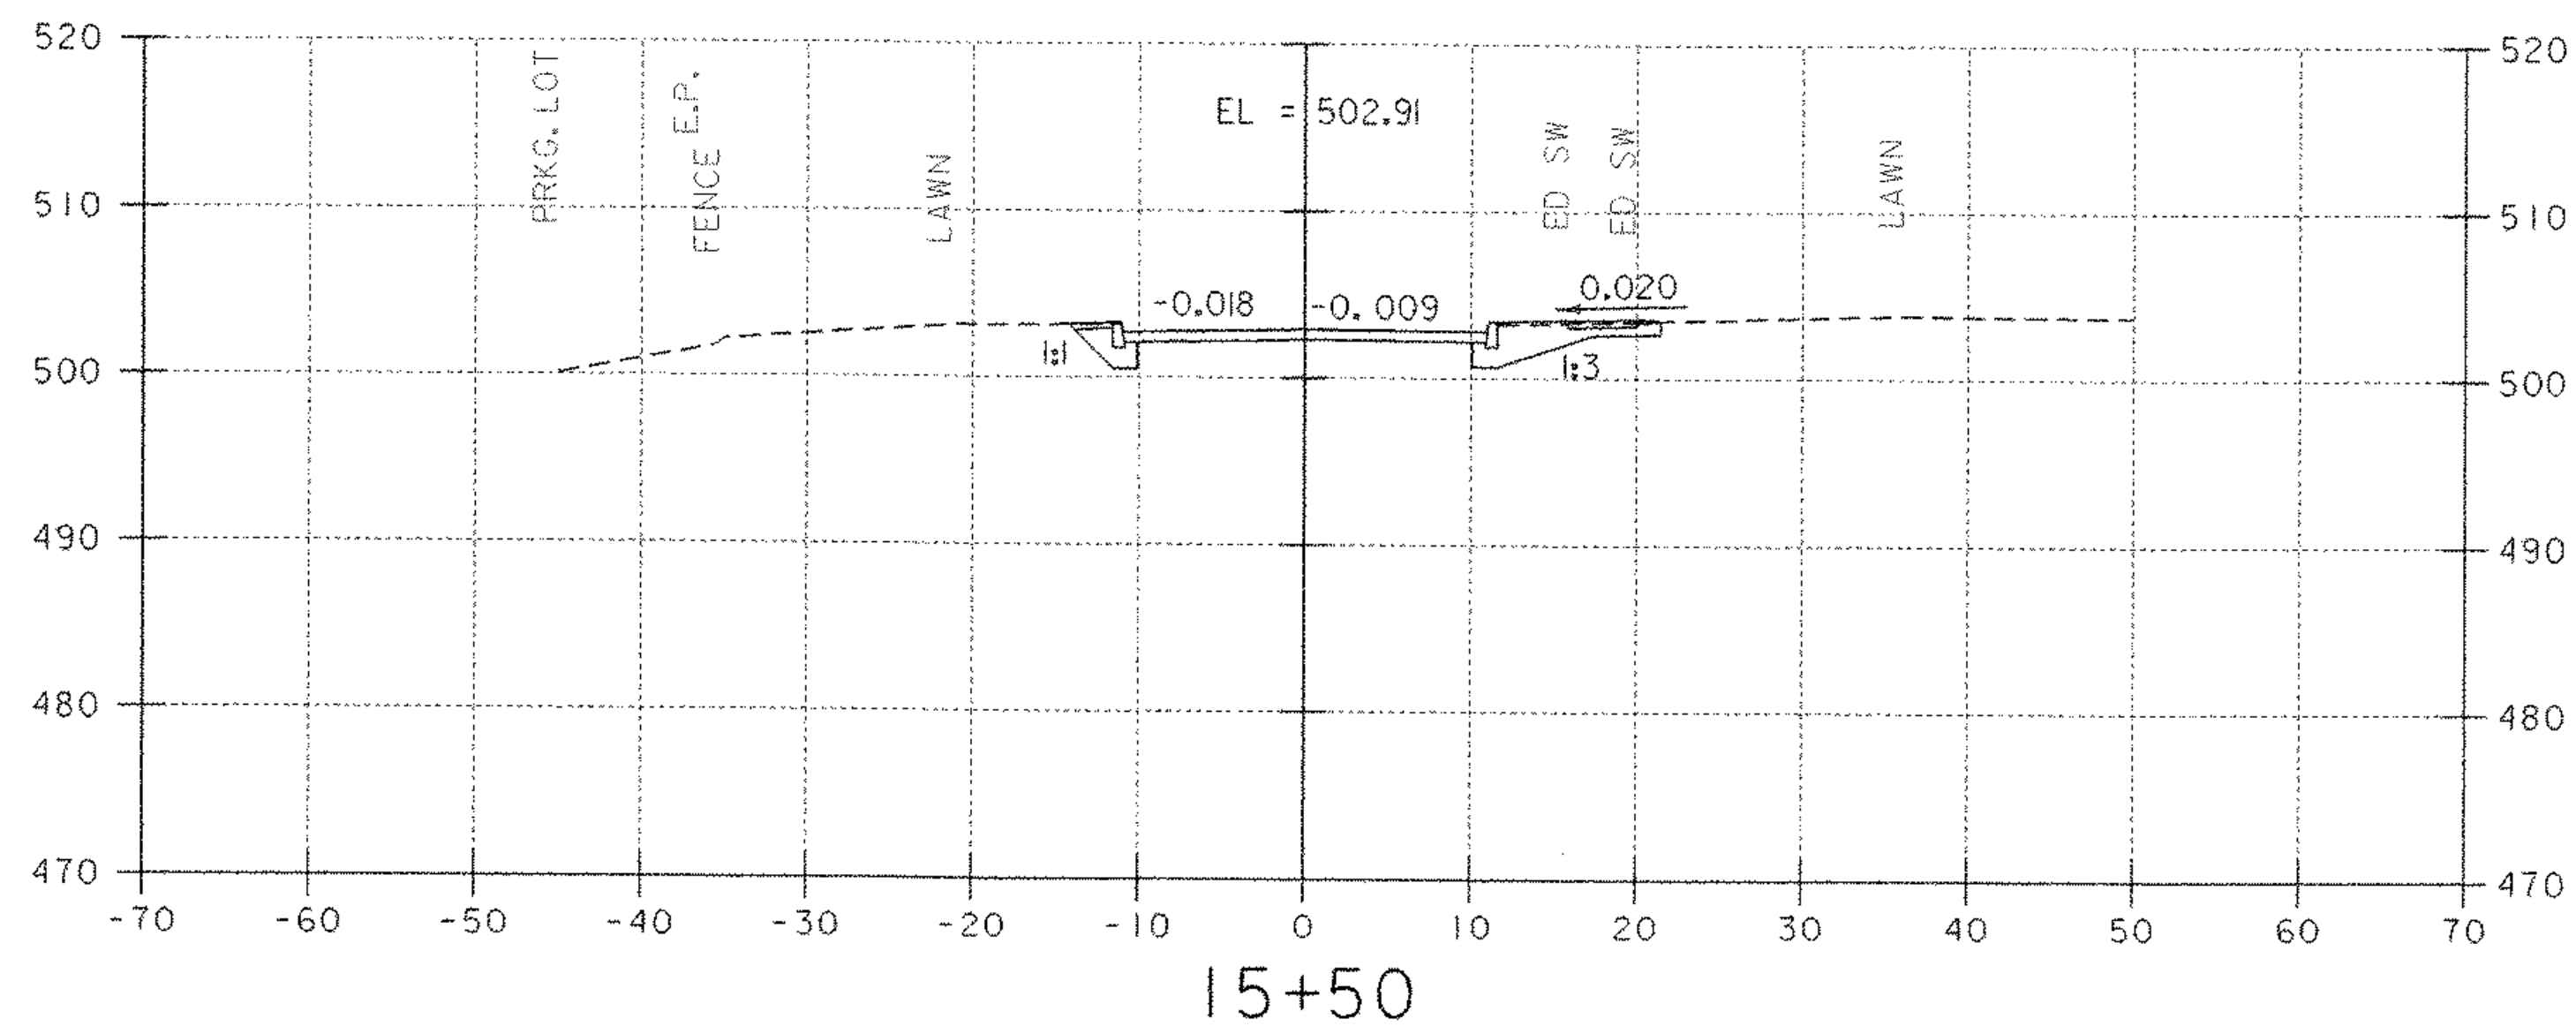


STA 16 + 00
END APPROACH

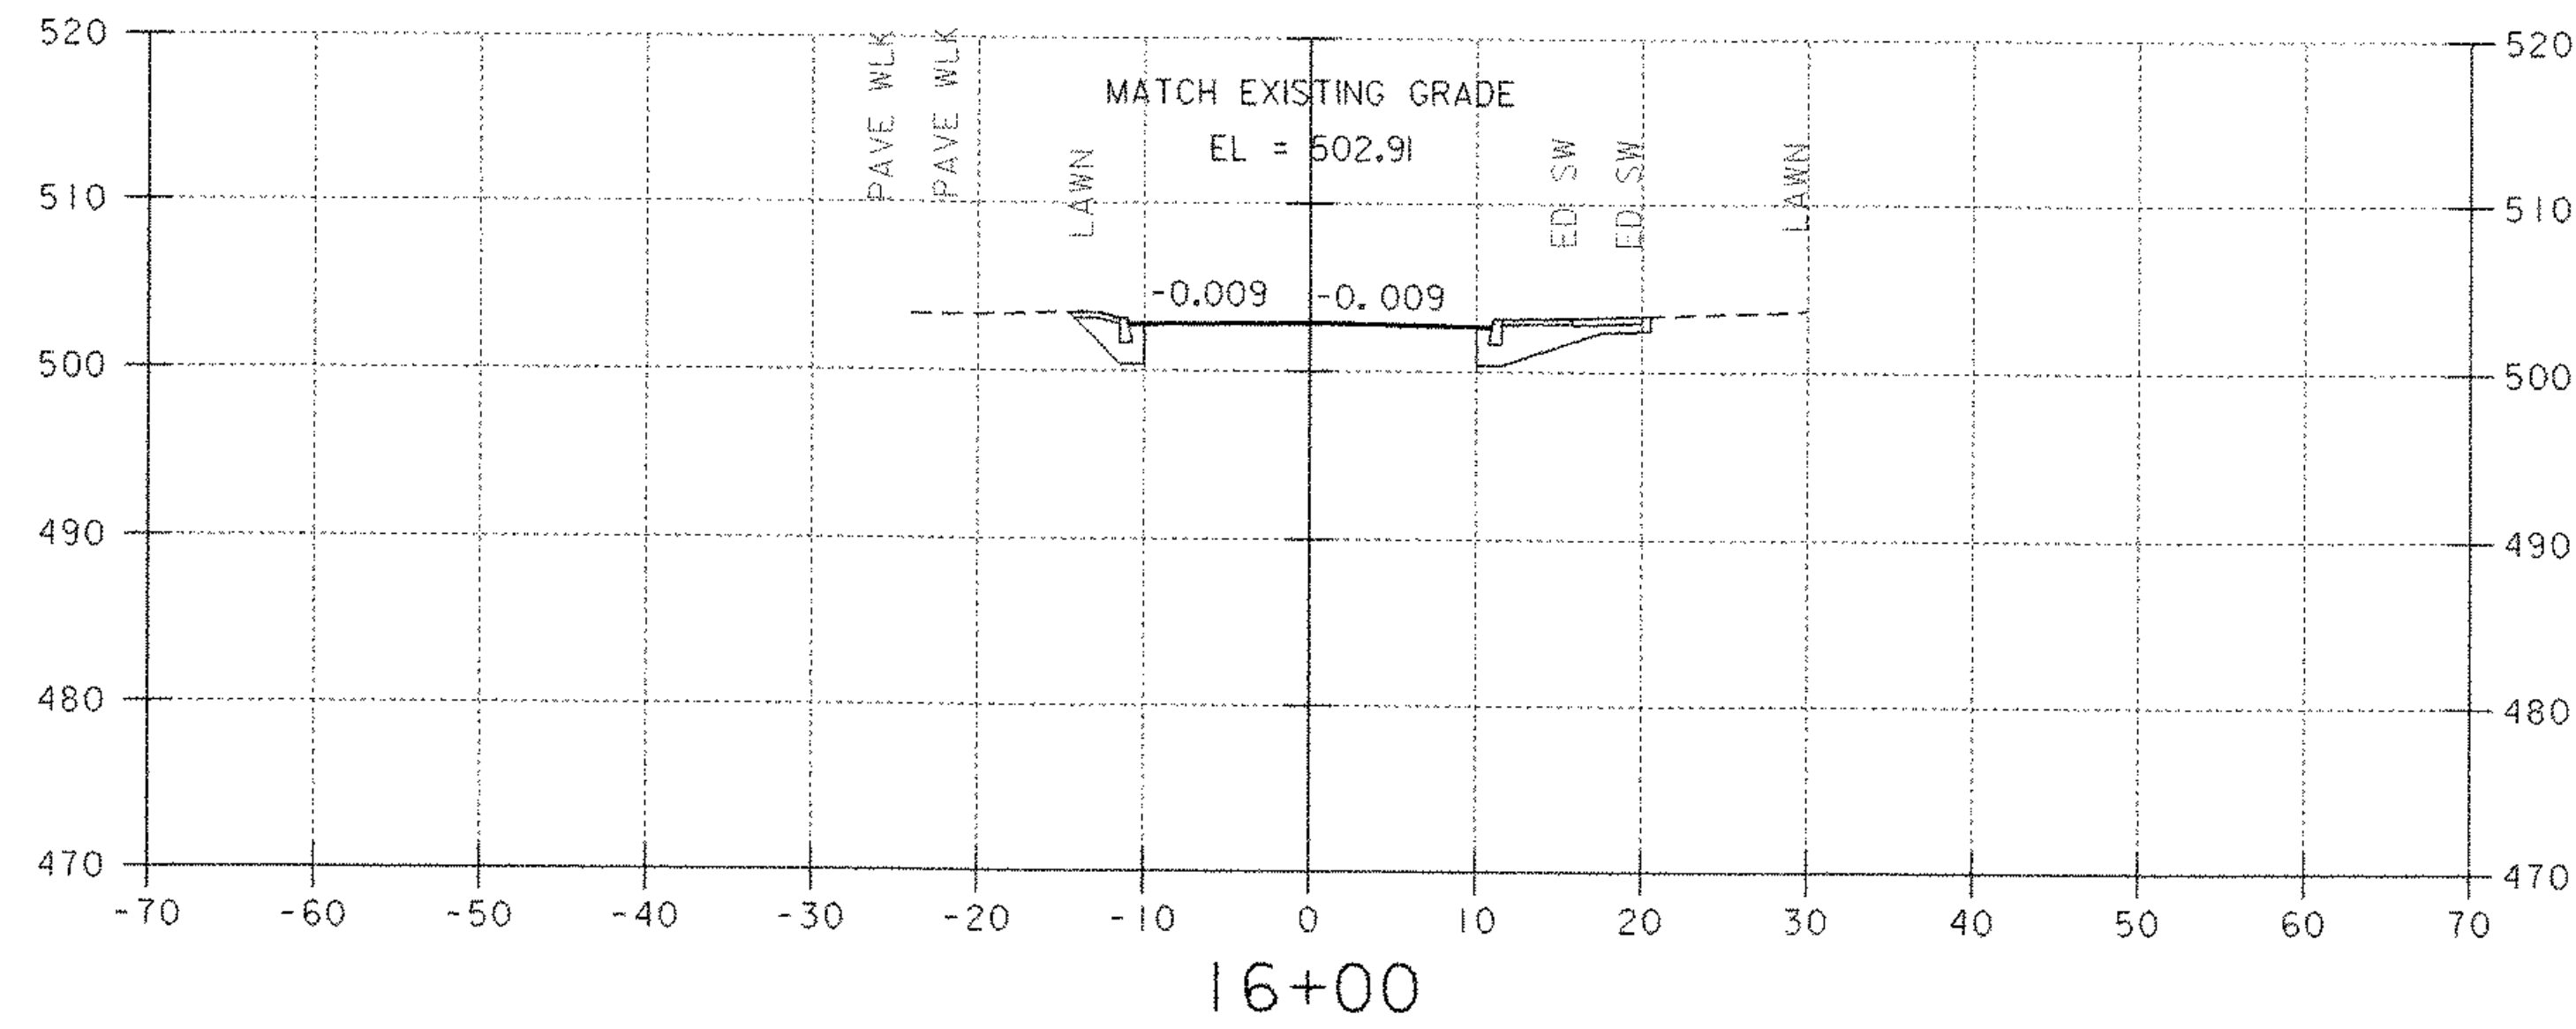

SCALE 1" = 10'-0"
10 0 10

RAILROAD STREET

SHEET NAME: MAINLINE CROSS SECTIONS	
PROJECT NAME: JOHNSON	HIGHWAY NO.: TH 2
PROJECT NUMBER: BHO 1448(18)	BRIDGE NO.: 6
	OVER: THE LAMOILLE RIVER
FILE NAME: /str1/90j067/sj067xs.dgn	PLOT DATE: 02-SEP-2005
PROJECT MANAGER: R. WHITCOMB	DRAWN BY: S. MAGNAN
DESIGNED BY: C. MEUNIER	IPARM NAME: sc067x06.1
BRIDGE SHEET NUMBER:	SHEET 59 OF 73