


STATION 50+17
 BEGIN STONE FILL, TYPE II & IV, GRUBBING MATERIAL
 AND GEOTEXTILE UNDER STONE FILL

DATUM
 VERTICAL USGS
 HORIZONTAL N/A

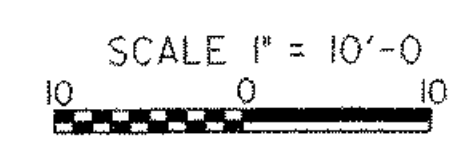

SEE SHEET 64 FOR STONE FILL TYPICAL

SHEET NAME: CHANNEL CROSS SECTIONS	
PROJECT NAME: JOHNSON	HIGHWAY NO.: TH 2
PROJECT NUMBER: BHO 1448(18)	BRIDGE NO.: 6
	OVER: THE LAMOILLE RIVER
FILE NAME: /str1/90j067/sj067xs.dgn	PLOT DATE: 02-SEP-2005
PROJECT MANAGER: R. WHITCOMB	DRAWN BY: S. MAGNAN
DESIGNED BY: C. MEUNIER	IPARM NAME: sc067cx1.i
BRIDGE SHEET NUMBER:	SHEET 63 OF 73