


STATION 50+75  
 END STONE FILL, TYPE II & IV, GRUBBING MATERIAL  
 AND GEOTEXTILE UNDER STONE FILL

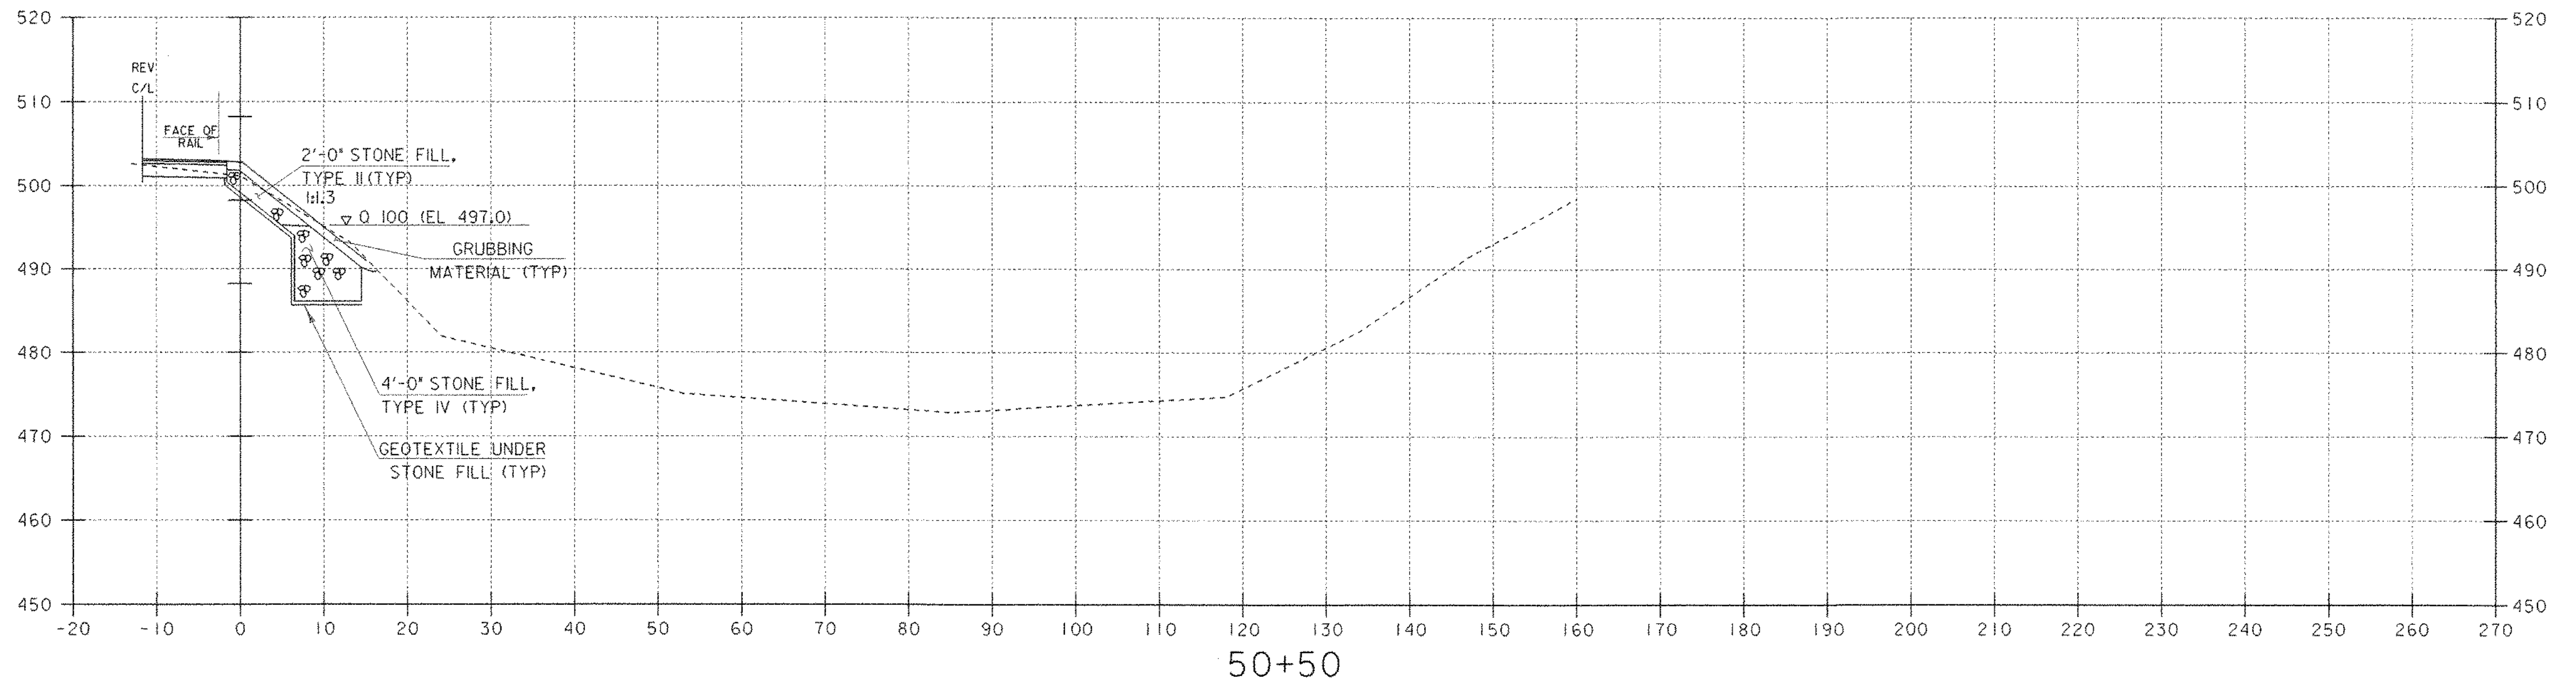

DATUM  
 VERTICAL USGS  
 HORIZONTAL N/A

SCALE 1" = 10'-0"

SHEET NAME: CHANNEL CROSS SECTIONS	
PROJECT NAME: JOHNSON	HIGHWAY NO.: TH 2
PROJECT NUMBER: BHO 1448(18)	BRIDGE NO.: 6
	OVER: THE LAMOILLE RIVER
FILE NAME: /str1/90j067/sj067xs.dgn	PLOT DATE: 02-SEP-2005
PROJECT MANAGER: R. WHITCOMB	DRAWN BY: S. MAGNAN
DESIGNED BY: C. MEUNIER	IPARM NAME: sc067cx2.i
BRIDGE SHEET NUMBER:	SHEET 64 OF 73