


- List of Drawings
- E1- Erection Diagram
 - 1- Cast Shoes & Rockers
 - 2- Truss Members
 - 3- " "
 - 4- Floor System
 - 5- Portal & Top Laterals
 - 6- Handrailing
 - 7- Sidewalk System.

FOR RAILING DIAGRAM SEE DWG. 6

W M

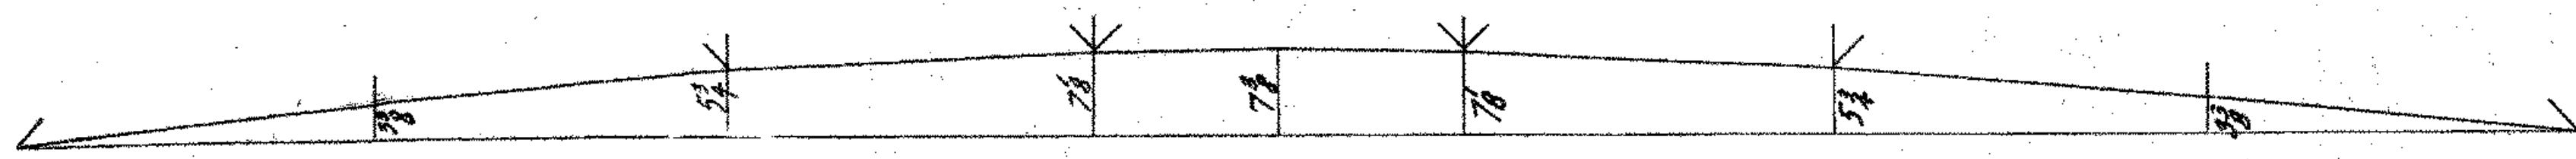

- CAMBER DIAGRAM -

Notes--
 Field Paint- Two Coats.
 One coat of approved Red Lead and Oil.
 One coat of approved Graphite Paint.
 Field Paint to be furnished by the Bethlehem Steel Co. and applied by others.

BETHLEHEM STEEL COMPANY	
Fabrication and Erection Dept. BETHLEHEM, PA.	
DETAIL OF ERECTION DIAGRAM	
STRUCTURE RAILROAD STR. BRIDGE LAMOILLE RIVER JOHNSON, VA.	
CUSTOMER RING CONSTRUCTION CO.	
SHOP PAINT _____	
RIVETS _____	OPEN HOLES _____ UNLESS NOTED
DRAWN BY W.F.	CHECKED BY W.A.T. DATE 3-15-28 SQUAD Croll
REVISIONS	NO. DATE BY DESCRIPTION
PROJECT NAME: JOHNSON	
PROJECT NUMBER: BHO 1448(18)	
HIGHWAY NO.: TH 2	
BRIDGE NO.: 6	
OVER: THE LAMOILLE RIVER	
FOR INFORMATIONAL PURPOSES ONLY	
FILE NO. F7297	CONT. EE2884 DWG. E1
SHEET 66 OF 73	