


SEE SHEET 14 FOR
CONSTRUCTION NOTES

**DRAINAGE NOTES FOR
SHEETS 13 & 14**

- ① STA 22+63
NEW 18" X 29' CPEP (SL)
W/ NEW PRECAST RCDI @ INLET
- ② STA 22+71
EXISTING 4' X 4'
RCDI - REMOVE
- ③ STA 22+93
CUT EXISTING 24" PIPE
REMOVE OUTLET END
- ④ STA 22+93 - 23+37 LT
NEW 24" X 44' CPEP (SL)
W/ NEW 4' X 6' PRECAST RCCB @ INLET
- ⑤ STA 22+84
NEW 18" X 29' CPEP (SL)
W/ NEW PRECAST RCDI @ INLET
- ⑥ STA 24+74 - END APPROACH
RETAIN EXISTING
12" PIPE
- ⑦ BEGIN APPROACH - STA. 22+93
RETAIN EXISTING
24" PIPE

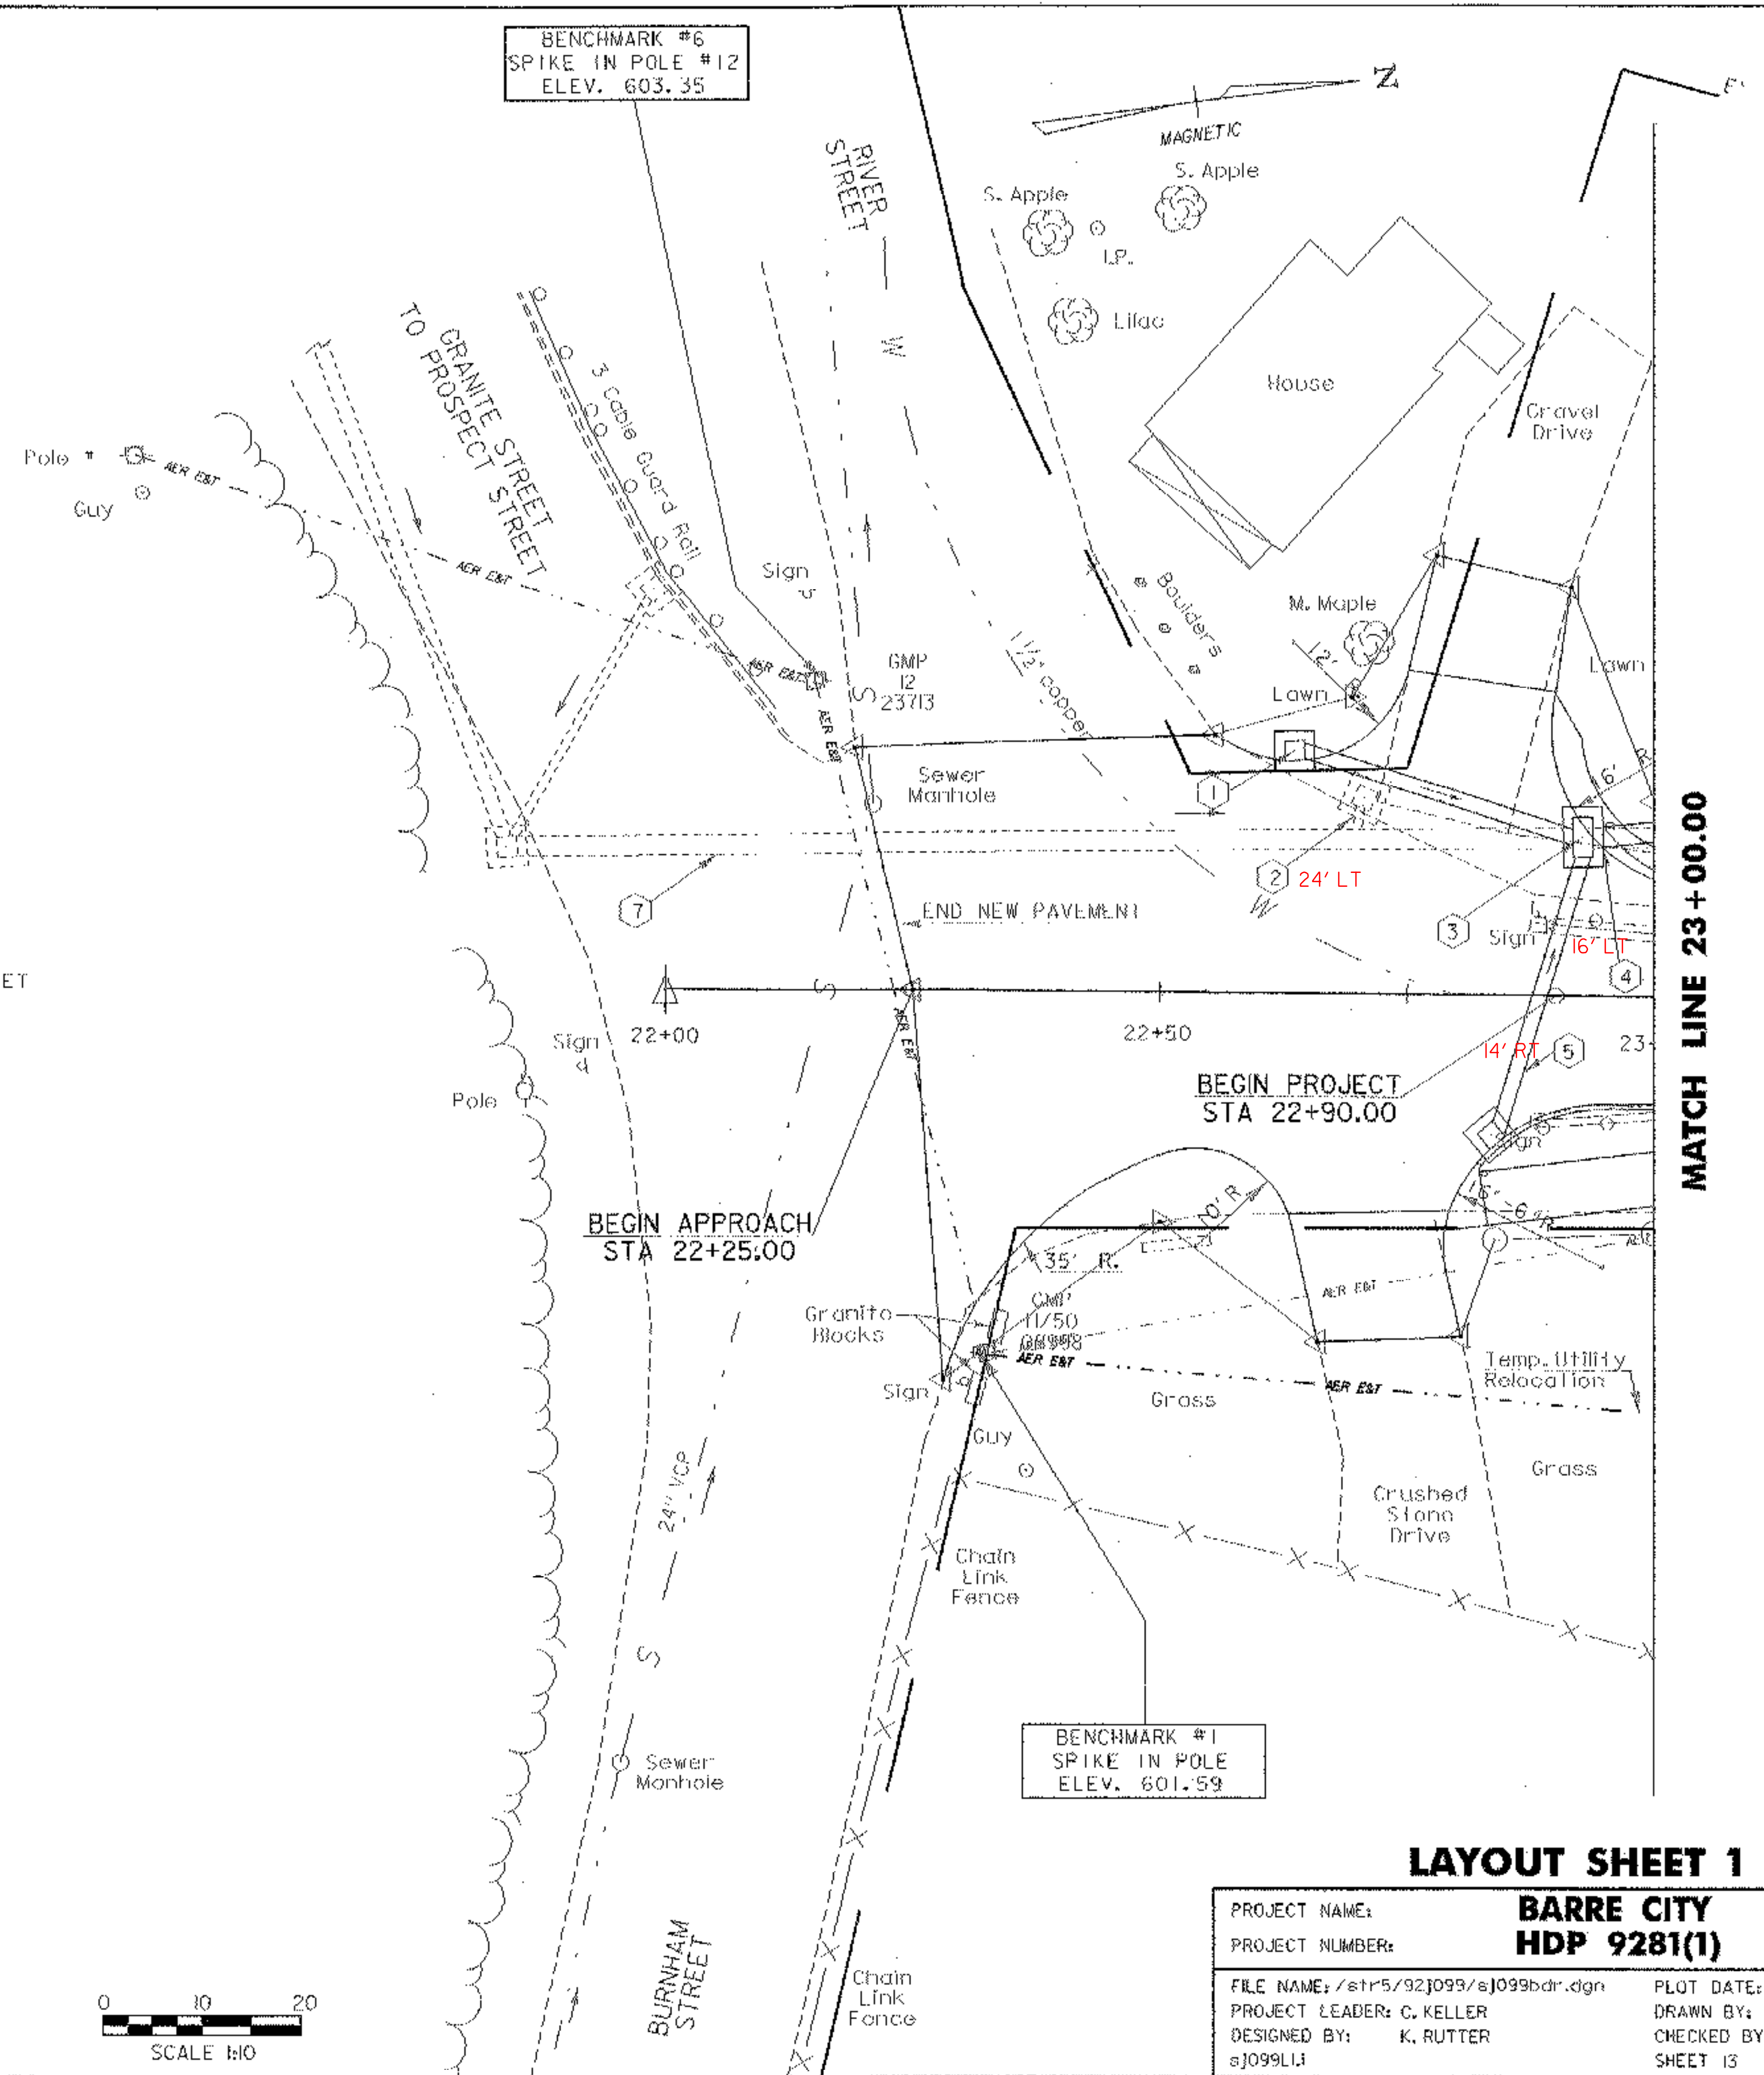

LAYOUT SHEET 1

PROJECT NAME:	BARRE CITY
PROJECT NUMBER:	HDP 9281(1)
FILE NAME: /str5/92j099/sj099bdr.dgn	PLOT DATE: 16-JUN-2004
PROJECT LEADER: C. KELLER	DRAWN BY: K. RUTTER
DESIGNED BY: K. RUTTER	CHECKED BY: T.A. SUMNER
sj099LI1	SHEET 13 OF 58