

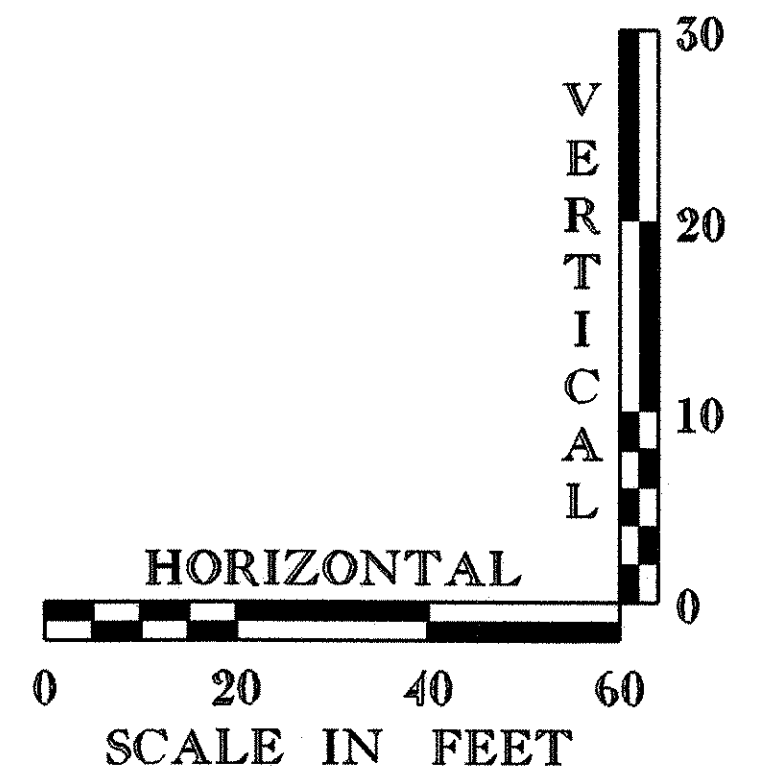


# Profile

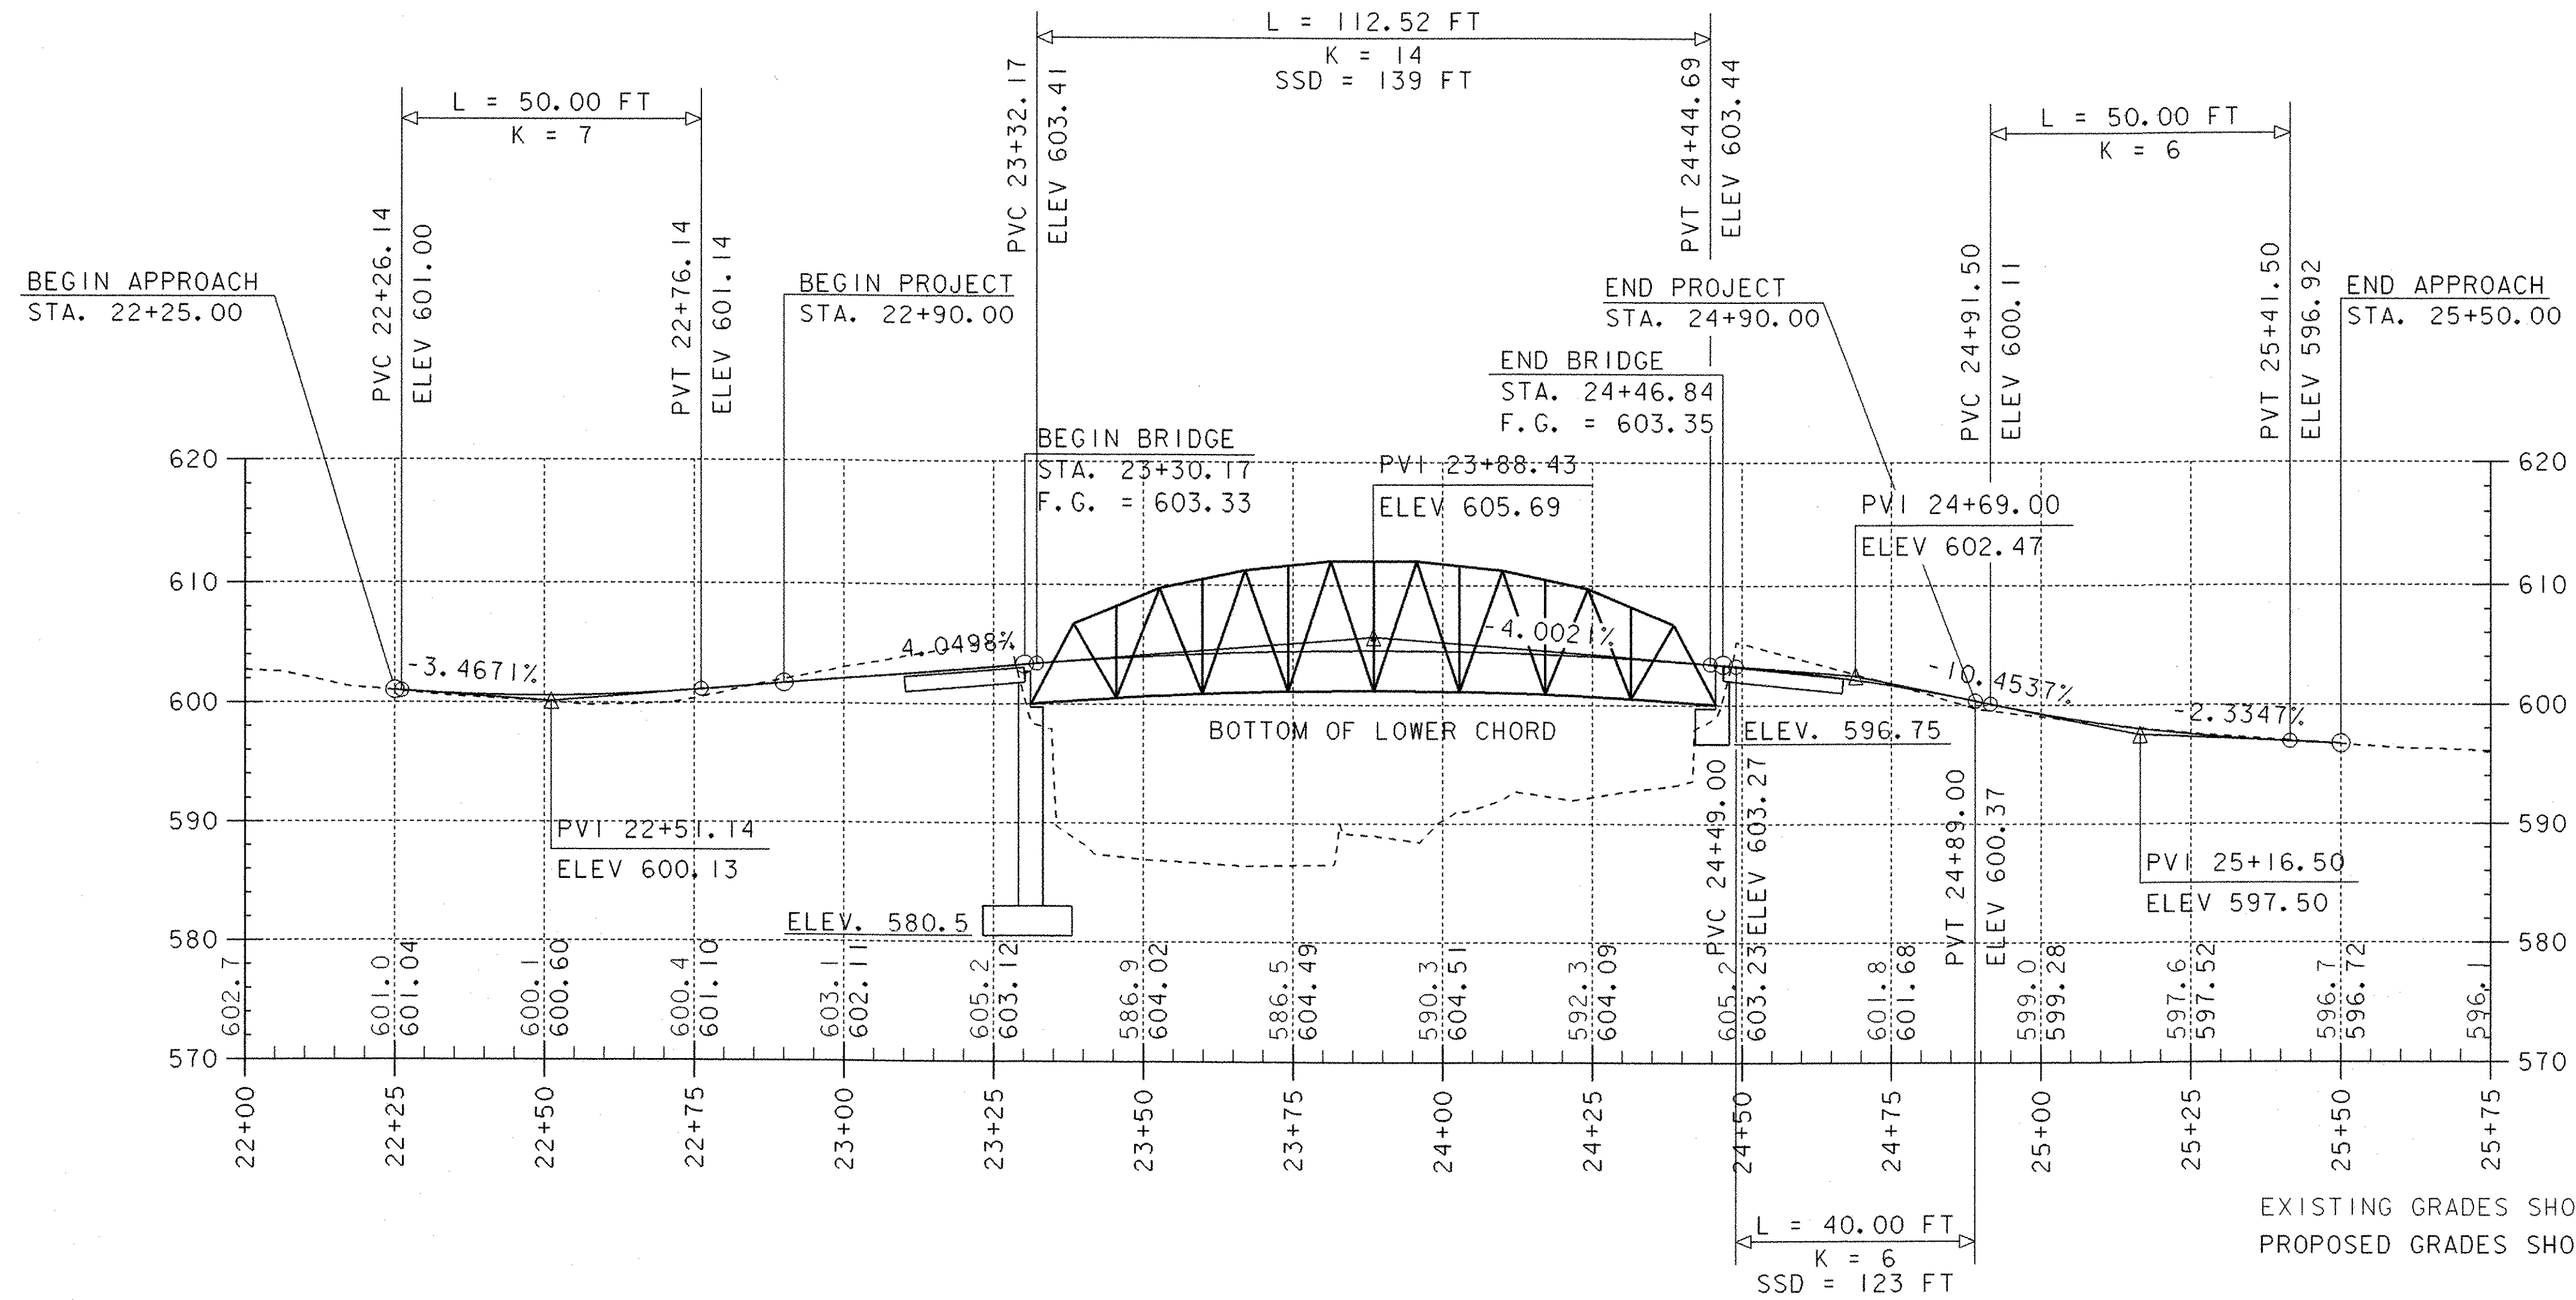

EXISTING GRADES SHOWN TO ONE DECIMAL PLACE.  
 PROPOSED GRADES SHOWN TO TWO DECIMAL PLACES.

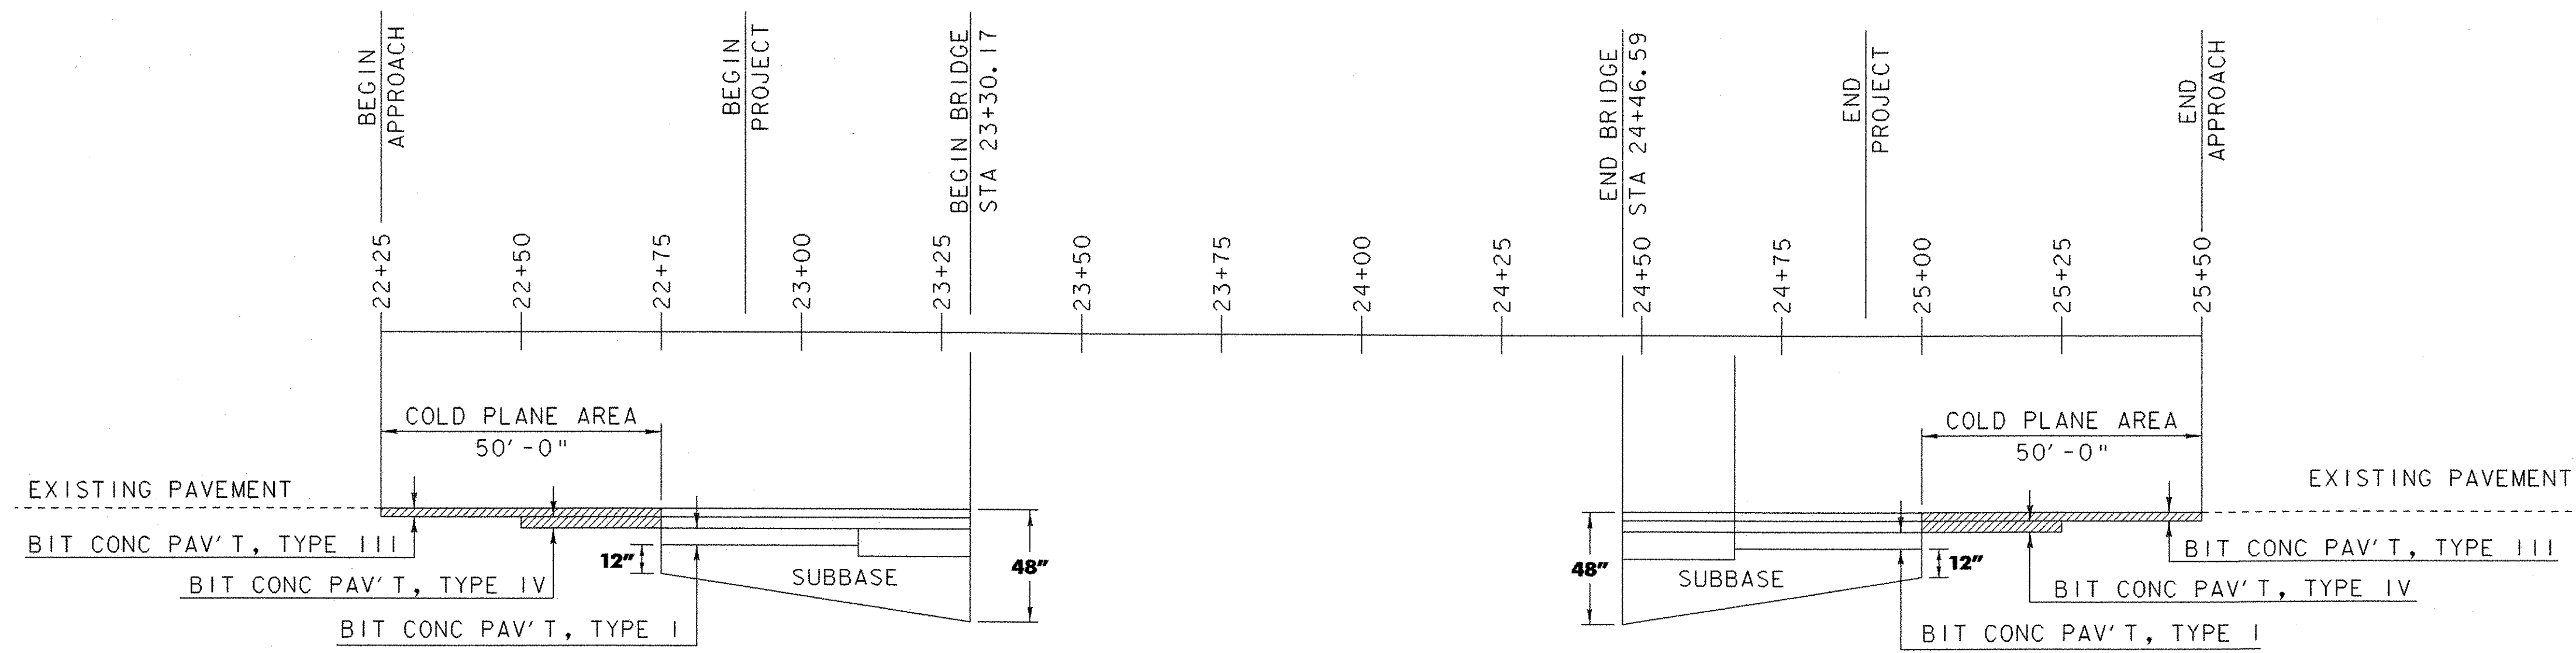

## PROFILE SHEET

PROJECT NAME: BARRE CITY  
 PROJECT NUMBER: HDP 9281(1)  
 FILE NAME: /str5/92j099/sj099wrk2.dgn PLOT DATE: 16-JUN-2004  
 PROJECT LEADER: C. KELLER DRAWN BY: P. BEYOR  
 DESIGNED BY: P. BEYOR CHECKED BY: T. SUMNER  
 sj099pro.1 SHEET 15 OF 58