


APPROACH SLAB #1 PLAN


SCALE 1/2" = 1'-0"
 1 0 1 2

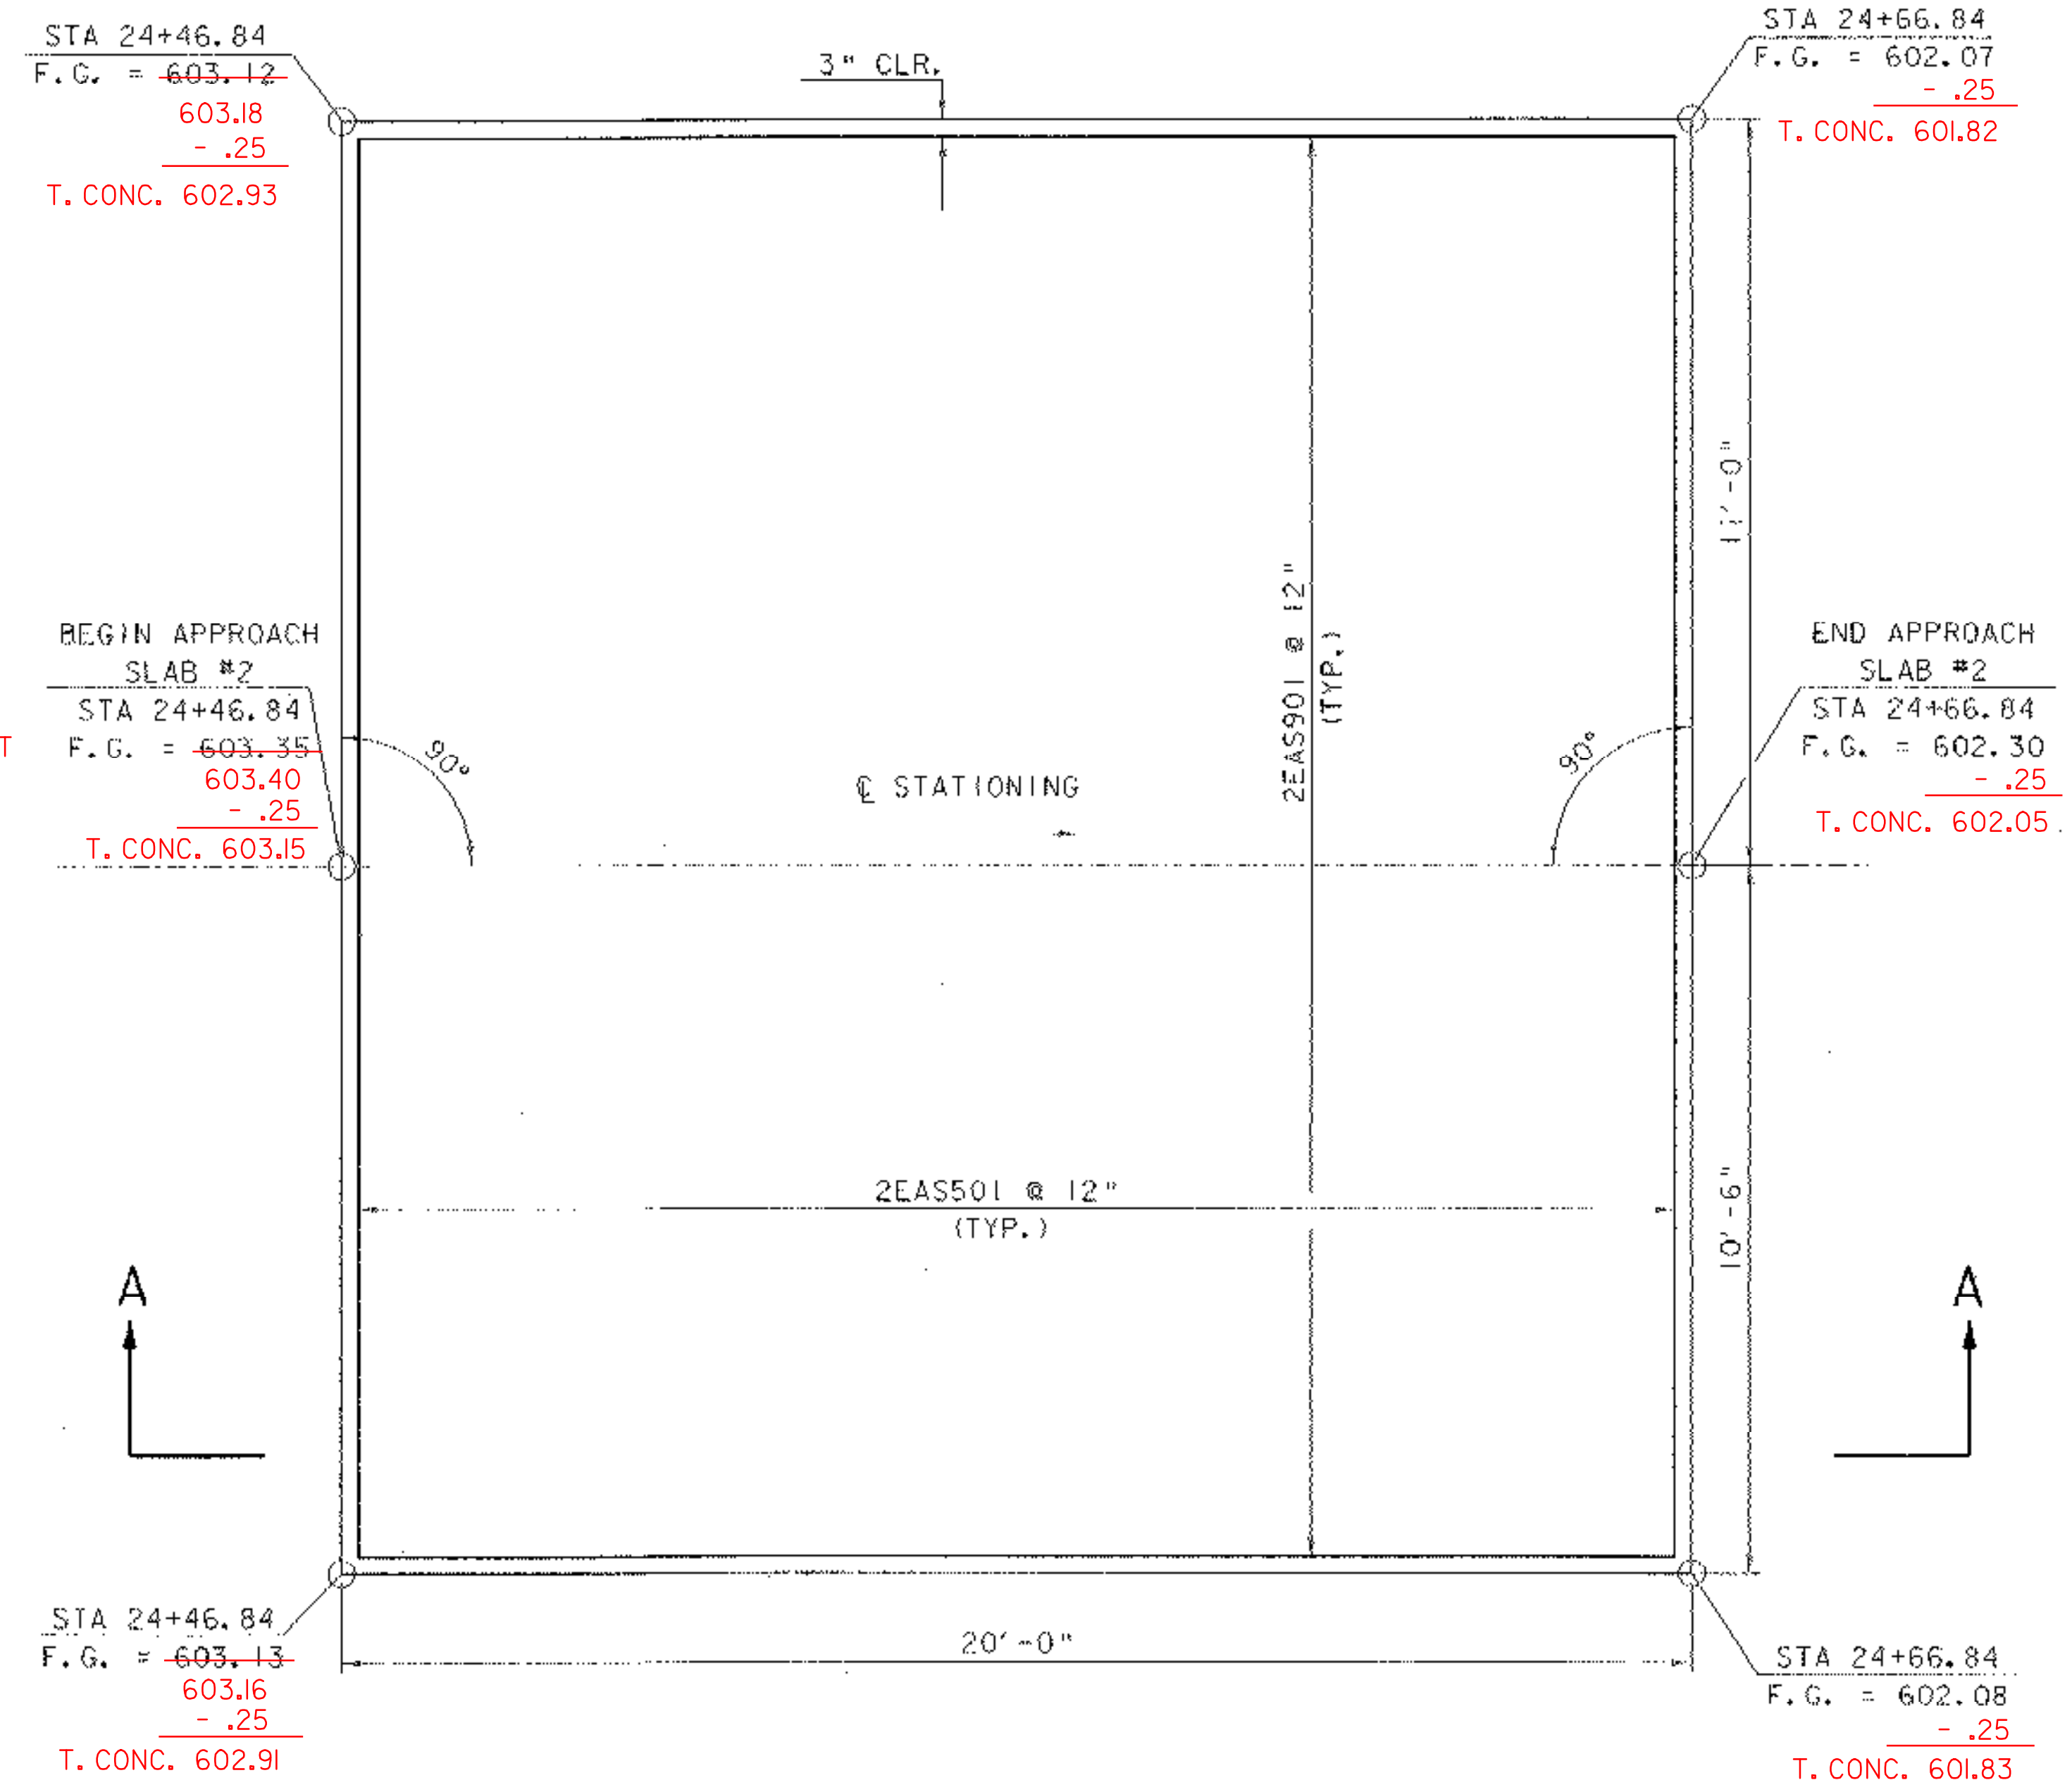

APPROACH SLAB #2 PLAN

SCALE 1/2" = 1'-0"
 1 0 1 2

NOTE: APPROACH SLAB GRADES SHALL BE PARALLEL TO FINISH GRADE.

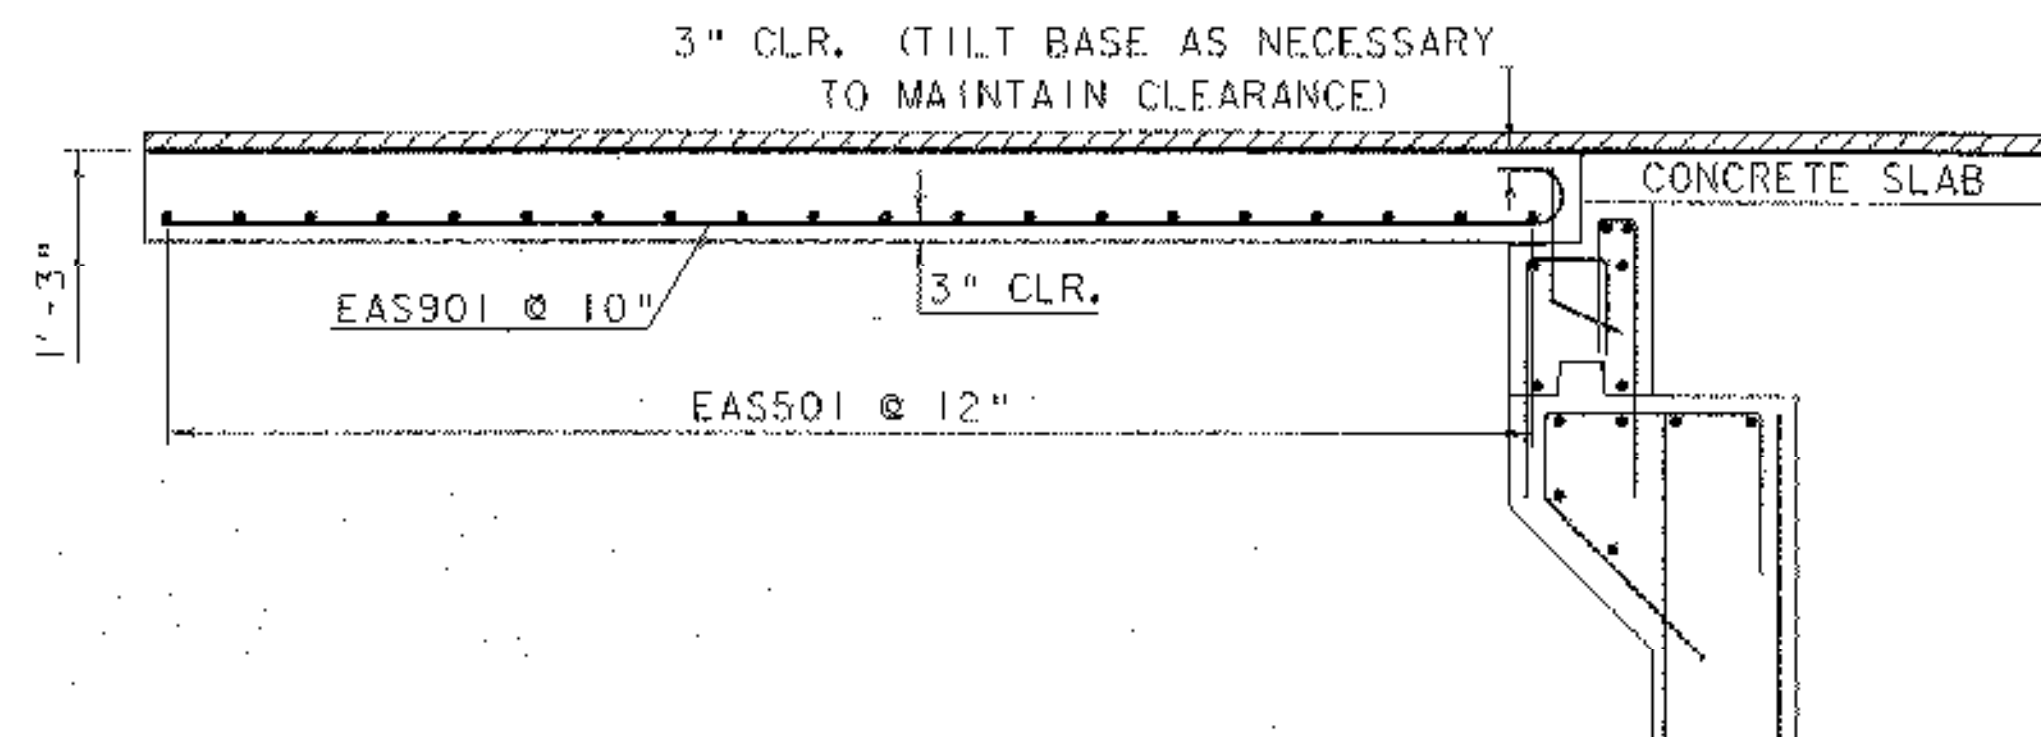

SECTION A-A

ALSO TYPICAL FOR APPROACH SLAB #1
 (EXCEPT SEE SHEET 23 FOR END DETAIL)

SCALE 3/8" = 1'-0"
 1 0 1 2 3 4

APPROACH SLAB DETAILS

PROJECT NAME: BARRE CITY	PLOT DATE: 16-JUN-2004
PROJECT NUMBER: HDP 9281(1)	DRAWN BY: K. RUTTER
FILE NAME: /str5/92j099/sj099sup.dgn	CHECKED BY: T.A. SUMNER
PROJECT LEADER: C. KELLER	SHEET 23 OF 58
DESIGNED BY: K. RUTTER	
sj099apslab.i	