


48+50

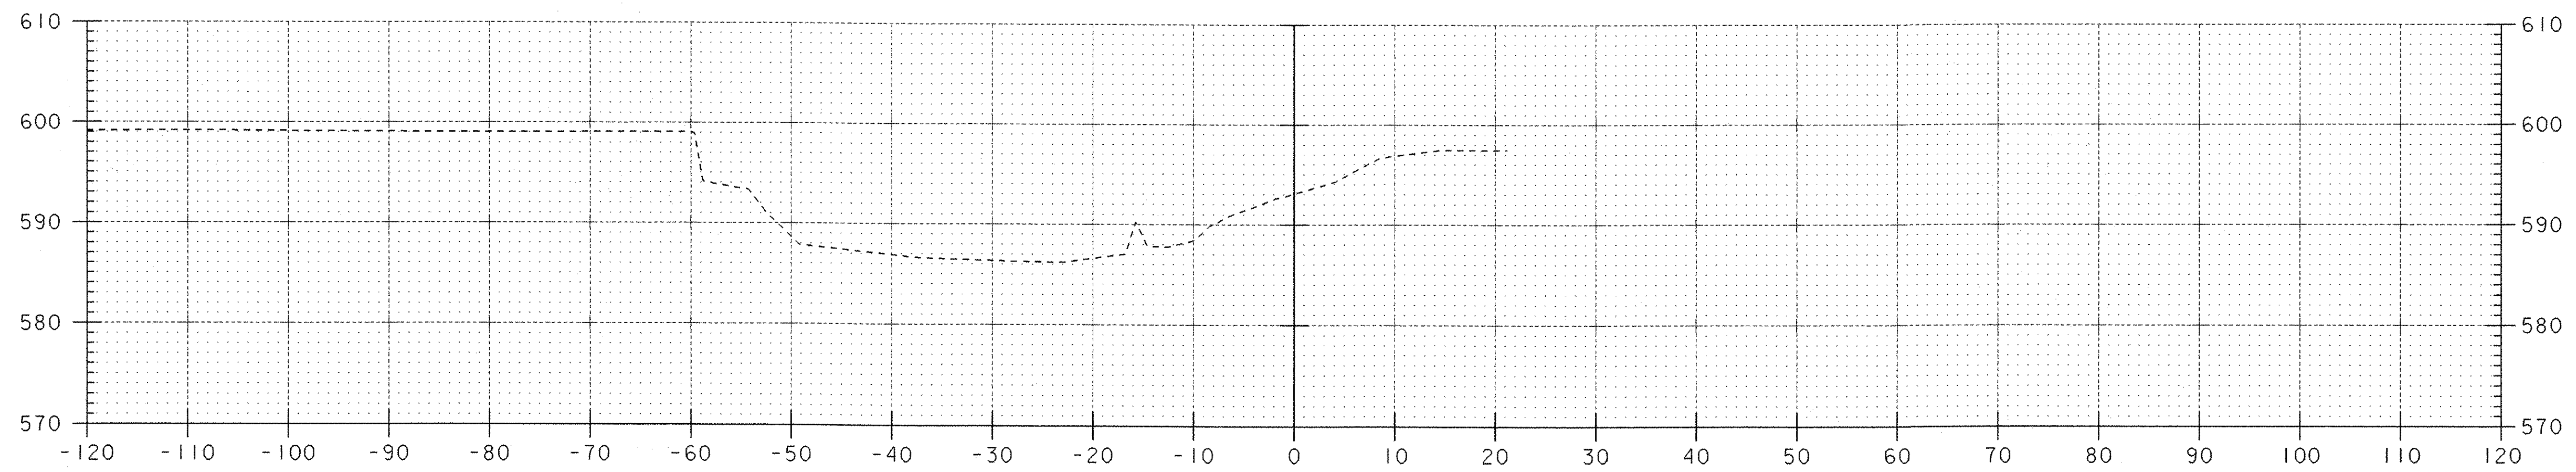

48+00

**CHANNEL SECTIONS  
48+00 - 48+50**

PROJECT NAME: BARRE CITY	PLOT DATE: 16-JUN-2004
PROJECT NUMBER: HDP 9281(I)	DRAWN BY: K. RUTTER
FILE NAME: /str5/92j099/sj099wrk2.dgn	CHECKED BY: T.A. SUMNER
DESIGNED BY: P. BEYOR	SHEET 52 OF 58
sj099ch01j	