


RAIL B 1 - 2 REQ'D

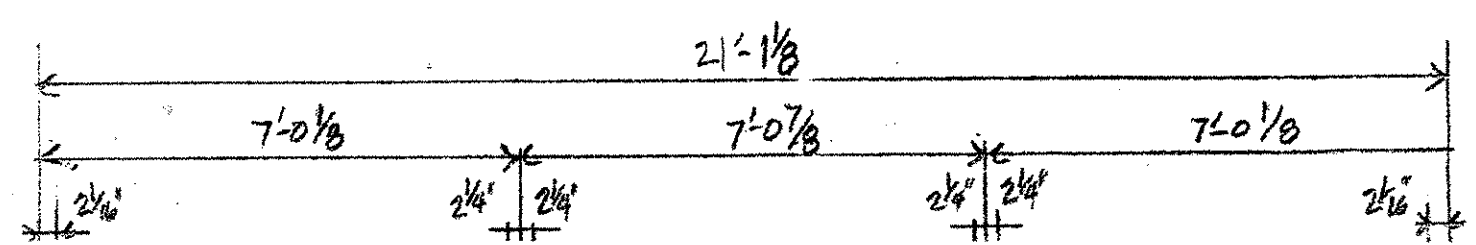

091 BR