


- 621.20 STEEL BEAM GUARDRAIL (GALVANIZED) (MOD. W/8.0 FT POSTS)
STA. 100+00.00 - STA. 101+75.00 (174.1 LF)
100+01.00
- 621.52 MANUFACTURED TERMINAL SECTION (FLARED)
STA. 100+00.00 LT
99+64 ~ 100+01.17
- 621.80 REMOVAL AND DISPOSAL OF GUARDRAIL
STA. 99+67.00 - STA. 101+75.00 LT (208.0 LF)

CURVE R1	
P. C.	STA. 103+73.21
P. T.	STA. 105+89.60
Δ	14° 35' 09"
R	850.00'
T	108.78'
E	216.39'
E	6.93'
D_c	06° 44' 26"
BANK	0.050 FT/FT

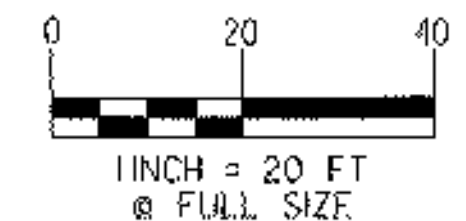

DATUM	NAVD 88
VERTICAL	N/A
HORIZONTAL	N/A

PLAN			
SURVEYED BY	W. DEYETTE	DATE	10/93
DRAWN BY	C. KAHLBAUGH	DATE	7/06
SQUAD LEADER	J. P. HALSTEAD		
DESIGN FILE NO.	/3797/FINAL/BLTIES.DGN		
IPARM FILE		DATE PLOTTED	12/20/2006
PROJ. NAME	ST. JOHNSBURY, BRIDGE NO. 29		
PROJ. NO.	BR0 144709		
SHEET 13 OF 72 SHEETS			