

646.40 DURABLE 4" WHITE LINE (EPOXY)
 (ALL LINES WILL INCLUDE EDGE LINE BREAKS AND RADIUS FOR TOWN HIGHWAYS)

STA. 100+75 - STA. 101+75 LT & RT
 STA. 104+50 - STA. 105+00 LT & RT

646.60 TEMPORARY 4" WHITE LINE (PAINT)
 (ALL LINES WILL INCLUDE EDGE LINE BREAKS AND RADIUS FOR TOWN HIGHWAYS)

STA. 100+75 - STA. 101+75 LT & RT
 STA. 104+50 - STA. 105+00 LT & RT


646.41 DURABLE 4" YELLOW LINE (EPOXY)
 (ALL LINES WILL INCLUDE C/L BREAKS FOR TOWN HIGHWAYS) S=SOLID, D=DASHED

STA. 100+75 - STA. 101+75 LT S RT S
 STA. 104+50 - STA. 105+00 LT S RT S

646.61 TEMPORARY 4" YELLOW LINE (PAINT)
 (ALL LINES WILL INCLUDE C/L BREAKS FOR TOWN HIGHWAYS) S=SOLID, D=DASHED

STA. 100+75 - STA. 101+75 LT S RT S
 STA. 104+50 - STA. 105+00 LT S RT S

DATUM	NAVD 88
VERTICAL	N/A
HORIZONTAL	N/A

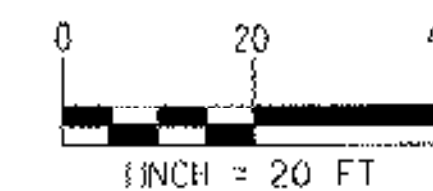

SIGNING AND STRIPING PLAN

SURVEYED BY	W. DEYETTE	DATE	10/93
DRAWN BY	C. KAHLBAUGH	DATE	7/06
SQUAD LEADER	J. P. HALSTEAD		
DESIGN FILE NO.	/3797/FINAL/SSP-2.DGN		
IPARM FILE		DATE PLOTTED	12/20/2006
PROJ. NAME	ST. JOHNSBURY, BRIDGE NO. 29		
PROJ. NO.	BR0 1447(19)		
SHEET	18	OF	72 SHEETS