


FILE NAME = us:\3797\mstn\03\final\fc02.dgn
 USER = 2467

DATUM	NAVD 88
VERTICAL	N/A
HORIZONTAL	N/A

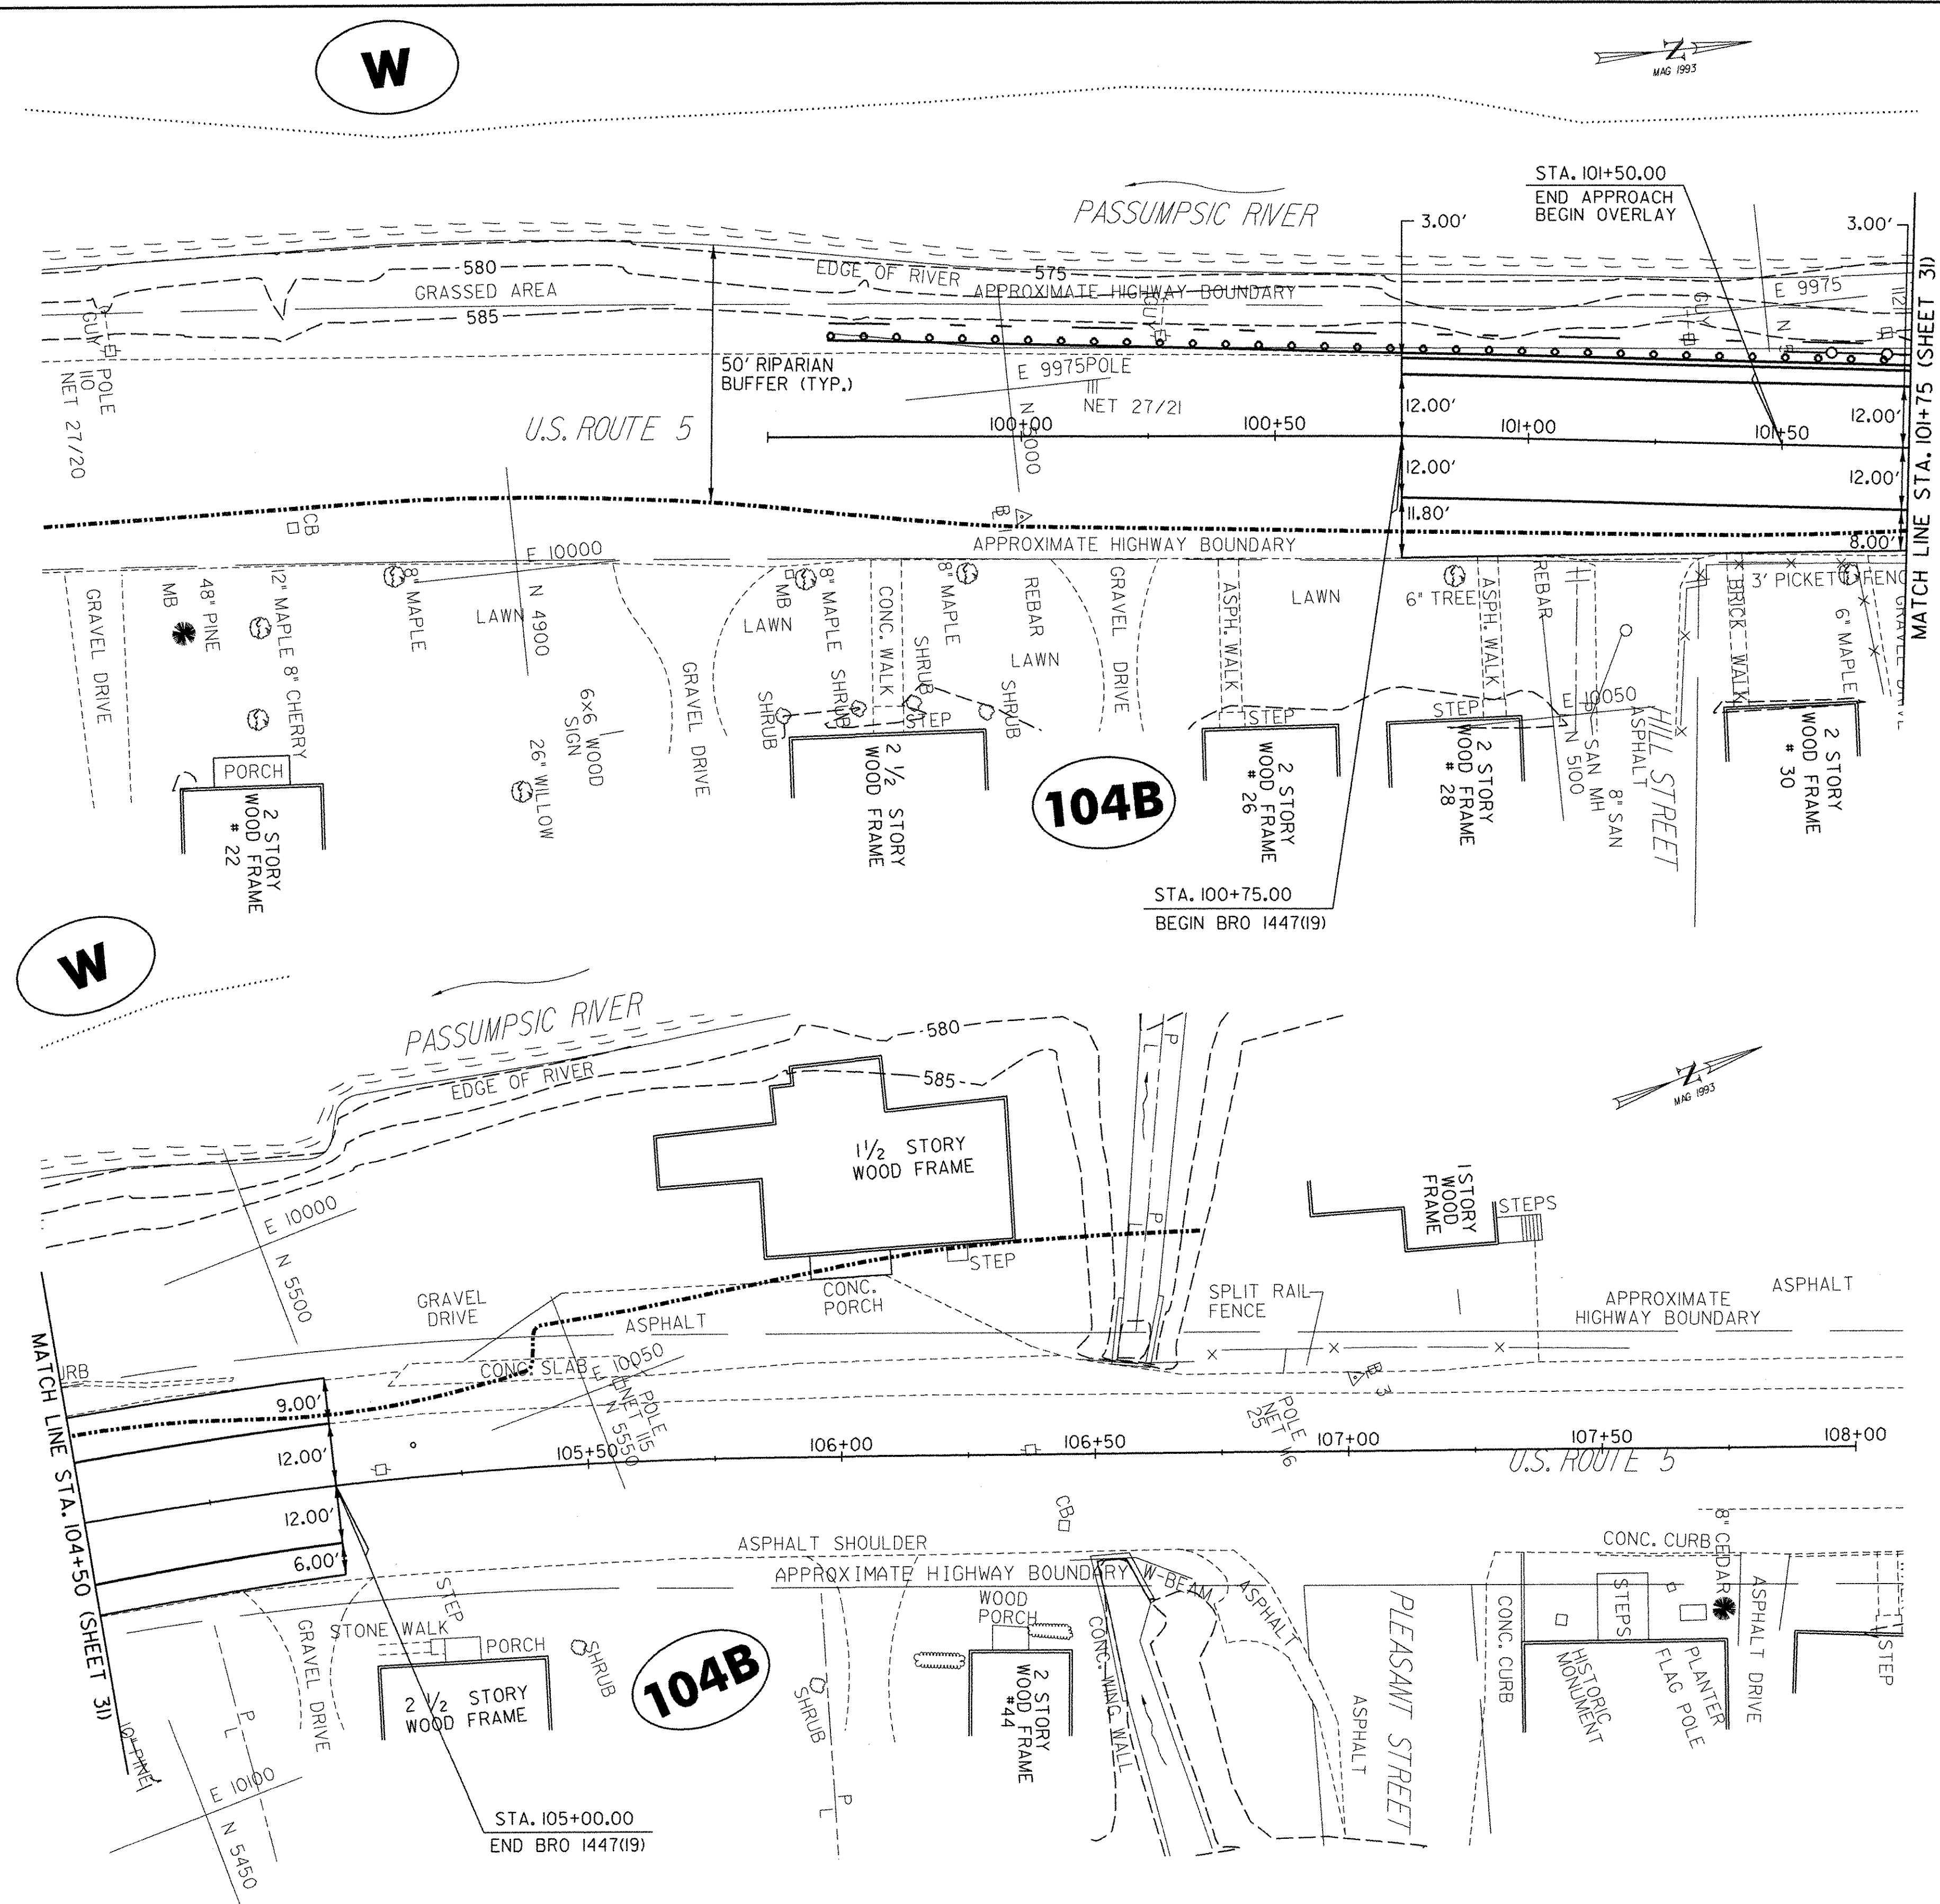

RESOURCES LEGEND	
XXX	SOIL MAP UNIT TYPE (SEE SHEET 21 FOR DETAILS)
.....	SOIL LINE BOUNDARY
-----	RIPARIAN BOUNDARY
-----	RIPARIAN BUFFER

FINAL CONDITIONS PLAN #2	SURVEYED BY	W. DEYETTE	DATE	10/93
	DRAWN BY	C. KAHLBAUGH	DATE	7/06
	SQUAD LEADER	J. P. HALSTEAD		
	DESIGN FILE NO.	/3797/FINAL/SSP-2.DGN		
	PARM FILE		DATE PLOTTED	12/20/2006
	PROJ. NAME	ST. JOHNSBURY, BRIDGE NO. 29		
PROJ. NO.	BRO 1447(19)			
SHEET	32 OF 72 SHEETS			

