


NOTE:

THE CONTRACTOR SHALL TAKE CARE NOT TO DAMAGE THE EXISTING BOX CULVERT, OR CULVERT HEADWALL DURING CONSTRUCTION OPERATIONS. ANY DAMAGE TO THE EXISTING STRUCTURE SHALL BE REPAIRED IMMEDIATELY AS DIRECTED BY THE RESIDENT ENGINEER AT THE CONTRACTOR'S OWN EXPENSE.

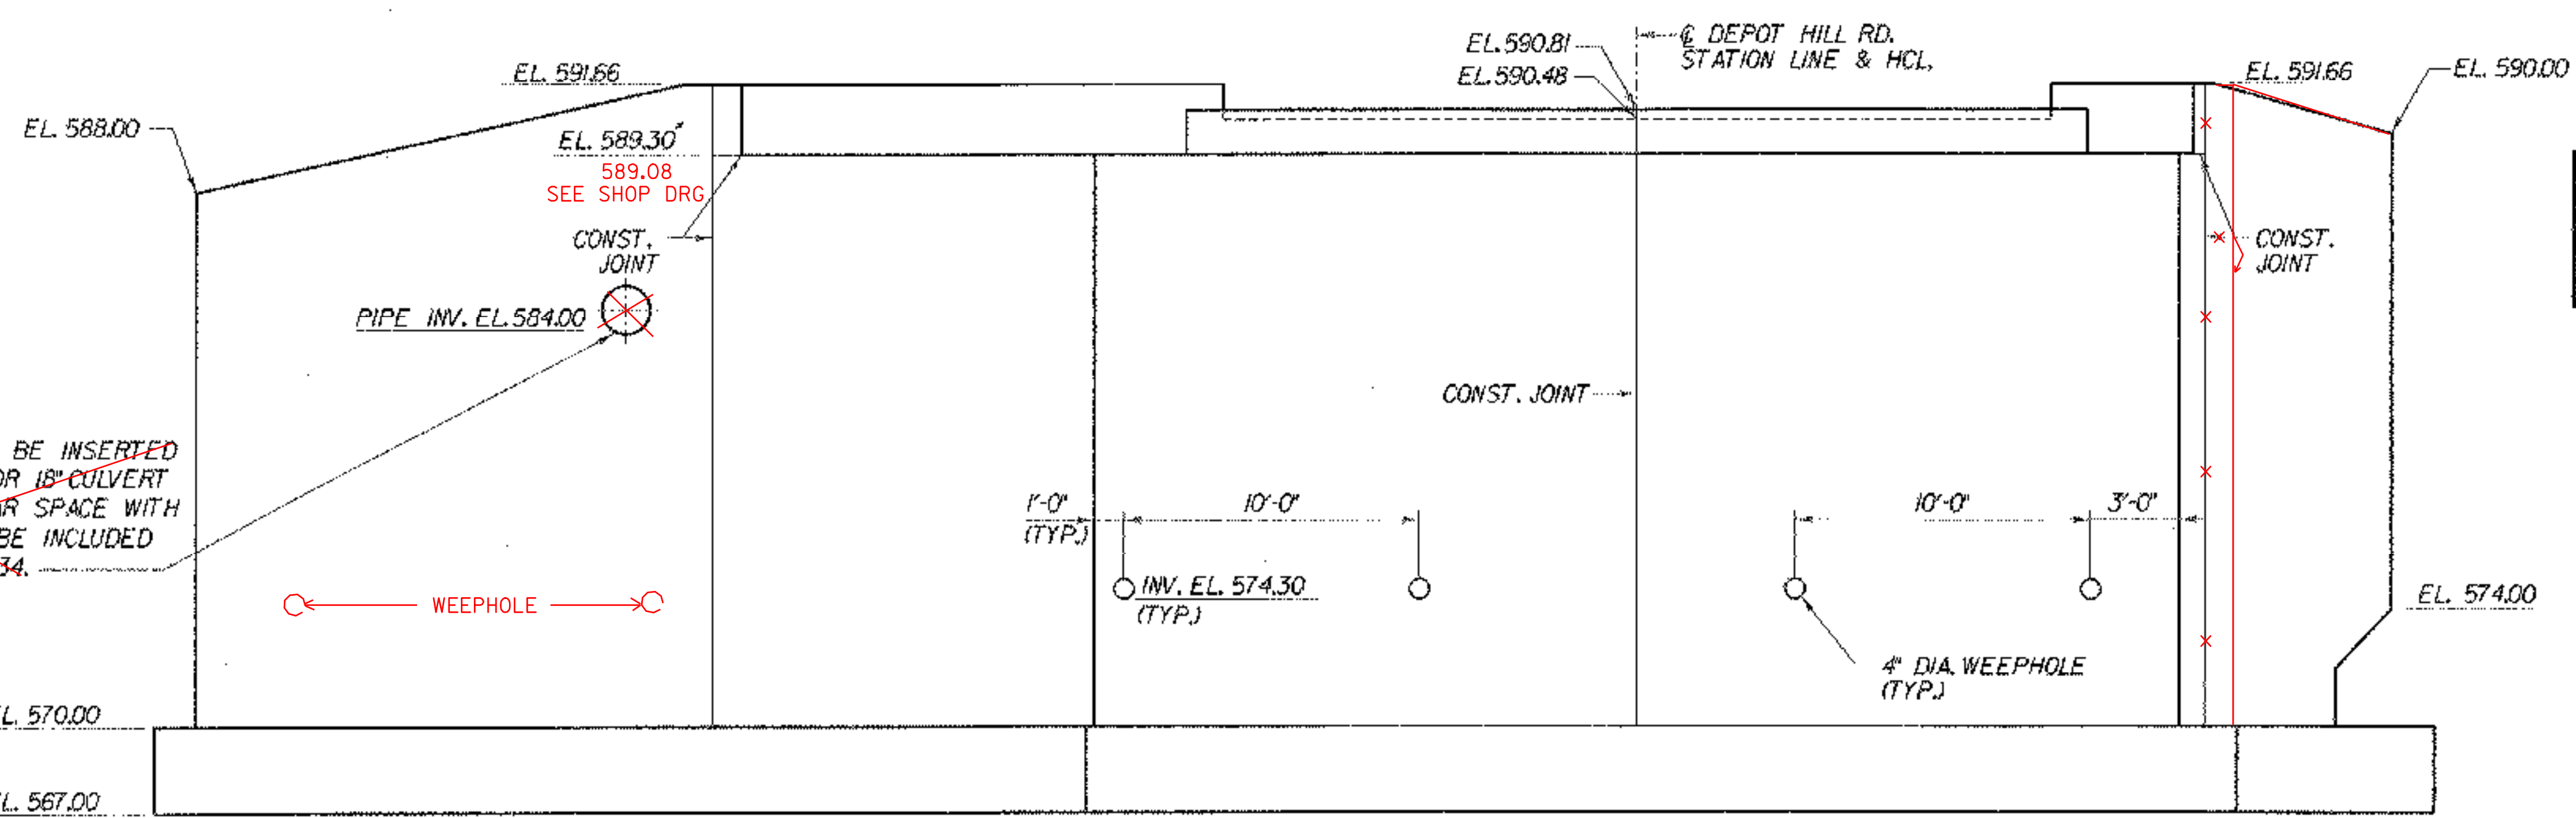

\* THE BRIDGE SEAT ELEVATION IS BASED ON AN ASSUMED TOTAL BEARING HEIGHT OF 4". THE CONTRACTOR SHALL ADJUST THE BRIDGE SEAT ELEVATION AS NECESSARY IF THE ACTUAL BEARING HEIGHT DIFFERS FROM THE ASSUMED 4".

STATE OF VERMONT  
AGENCY OF TRANSPORTATION

Town Of	ST. JOHNSBURY	Bridge No.	29
Highway No.	T.H. 85	Log Sta.	
		Surv. Sta.	
DEPOT HILL ROAD OVER THE PASSUMPSIC RIVER			
ABUTMENT 1 PLAN AND ELEVATION			
Designed By	M. SMULLEN	Drawn by	Wm WEATHERBY
Checked By	M. OLSTAD	Bridge Design Supervisor	P. HALSTEAD
Date	7/2003	Date	9/2006
PROJECT	ST. JOHNSBURY	PROJECT NO.	BRO 144709
I.G.C. Info.			
Bridge Sheet No.	BR11	Sheet	44 OF 72



FILE NAME: P:\3397\assn\15\br-27\147ab1.dwg  
 DATE: 08/27/2006 12:42