


FILE NAME =us\3797\mstr\03\final\3797sect.dgn  
 USER =2467

DATUM	
VERTICAL	NAVD 88
HORIZONTAL	N/A

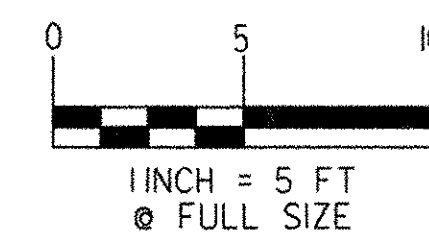

*SECTION BUILT AS DESIGNED*

<b>CROSS SECTIONS</b>	
<b>T.H. 85</b>	
SURVEYED BY	W. DEYETTE DATE 10/93
DRAWN BY	C. KAHLBAUGH DATE 7/06
SQUAD LEADER	J. P. HALSTEAD
DESIGN FILE NO.	3797SECT.DGN
IPARM FILE	DATE PLOTTED 12/20/2006
PROJ. NAME	ST. JOHNSBURY, BRIDGE NO. 29
PROJ. NO.	BRO 1447(19)
SHEET	58 OF 72 SHEETS