


14+00  
T.H. 85  
(ON BRIDGE)

C=0.0  
F=0.0

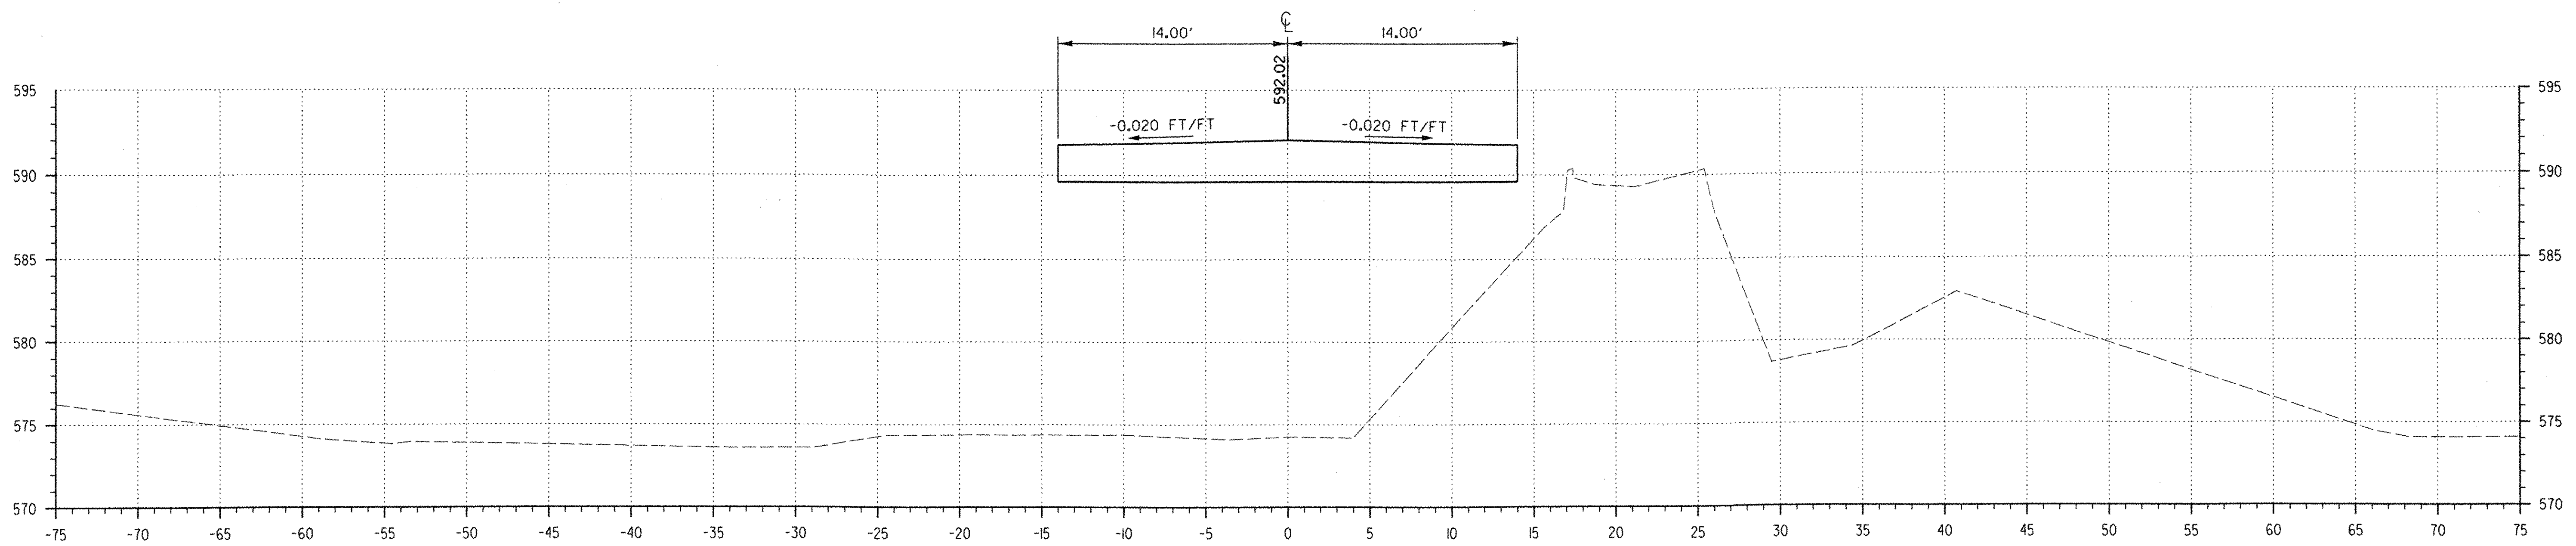


13+50  
T.H. 85  
(ON BRIDGE)

C=0.0  
F=0.0

FILE NAME = ut\3797\mstr\03\final\3797sect.dgn  
USER = 2467

DATUM  
VERTICAL NAVD 88  
HORIZONTAL N/A

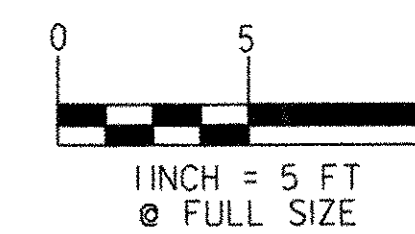

**CROSS SECTIONS**  
**T.H. 85**

SURVEYED BY W. DEYETTE DATE 10/93  
 DRAWN BY C. KAHLBAUGH DATE 7/06  
 SQUAD LEADER J. P. HALSTEAD  
 DESIGN FILE NO. 3797SECT.DGN  
 IPARM FILE \_\_\_\_\_ DATE PLOTTED 12/20/2006  
 PROJ. NAME ST. JOHNSBURY, BRIDGE NO. 29  
 PROJ. NO. BRO 1447(19)  
 SHEET 61 OF 72 SHEETS