

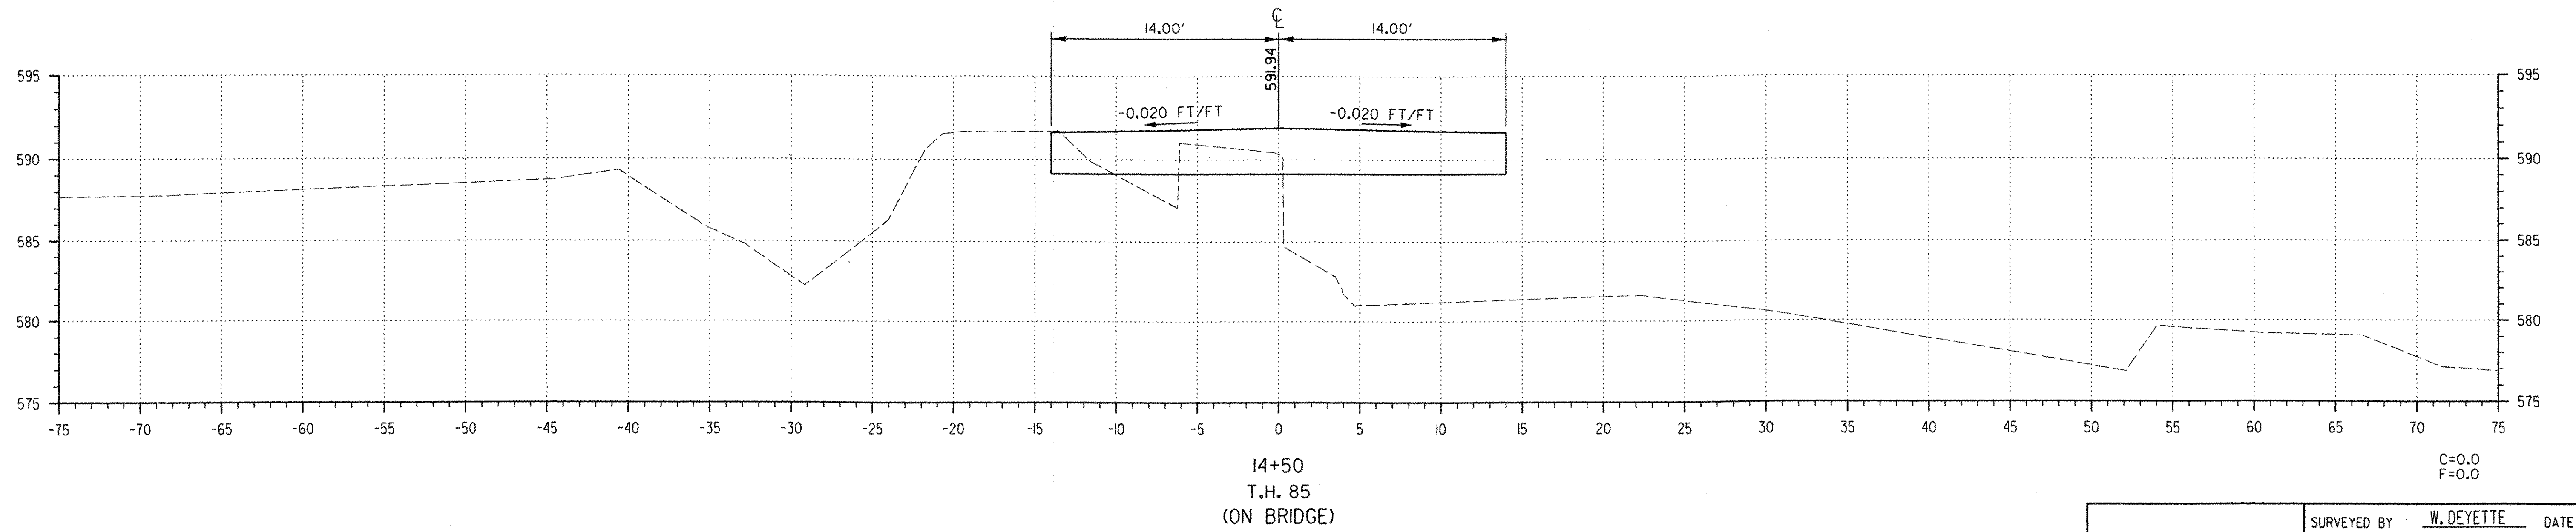


FILE NAME = ut\3797\mstr\03\final\3797sect.dgn
 USER = 2467

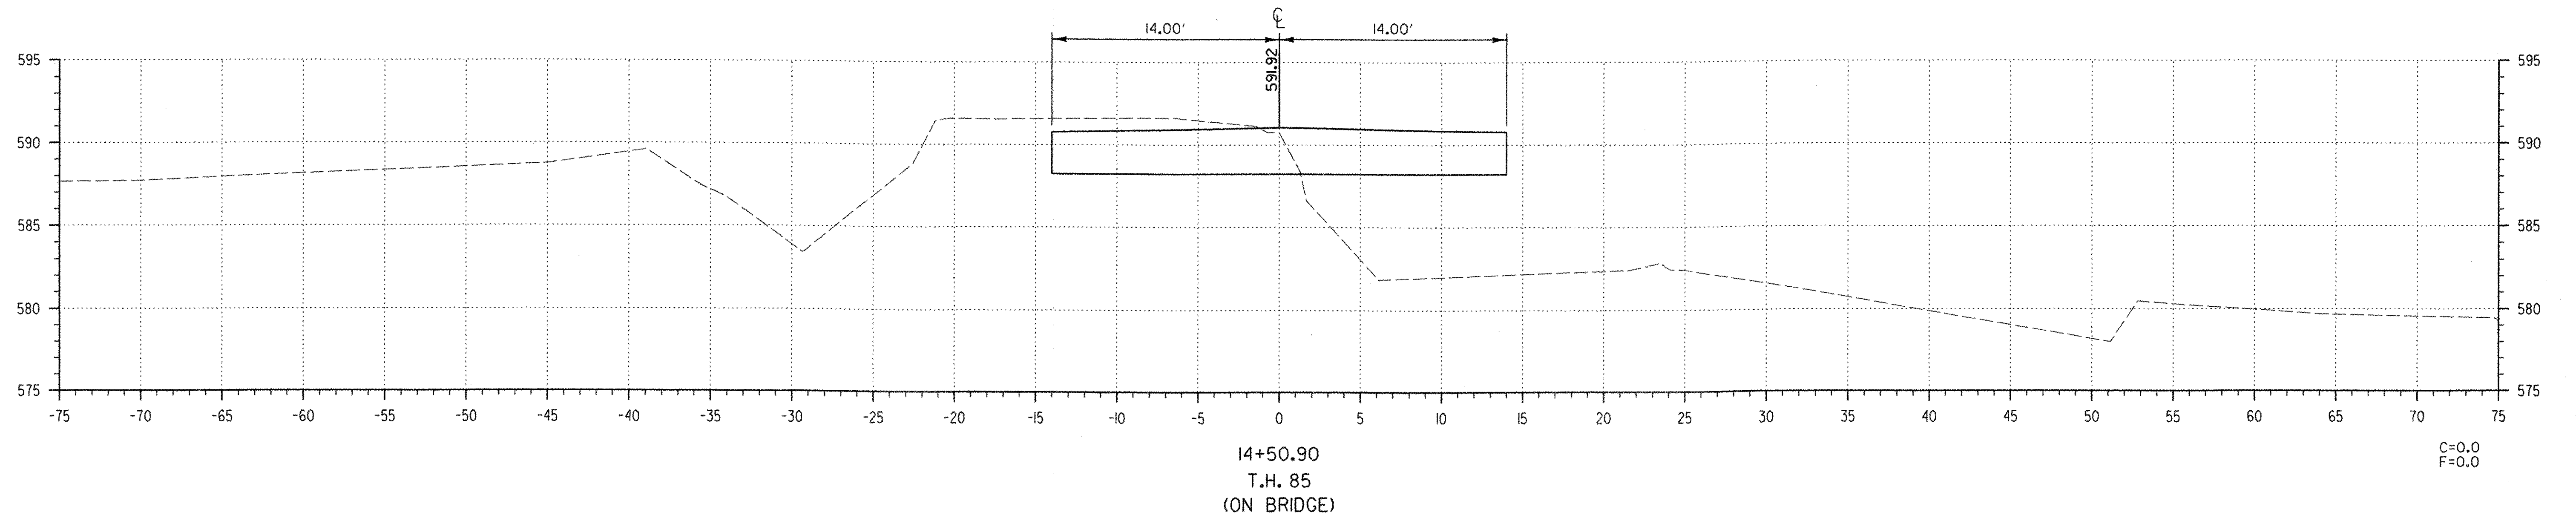

DATUM
 VERTICAL NAVD 88
 HORIZONTAL N/A

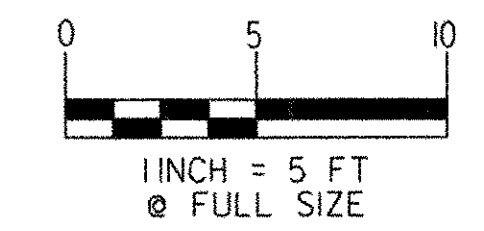

CROSS SECTIONS	
T.H. 85	
SURVEYED BY	W. DEYETTE DATE 10/93
DRAWN BY	C. KAHLBAUGH DATE 7/06
SQUAD LEADER	J. P. HALSTEAD
DESIGN FILE NO.	3797SECT.DGN
IPARM FILE	DATE PLOTTED 12/20/2006
PROJ. NAME	ST. JOHNSBURY BRIDGE NO. 29
PROJ. NO.	BRO 1447(19)
SHEET 62 OF 72 SHEETS	