


FILE NAME =u:\3797\instr\03\final\3797sect.dgn  
USER =2467

DATUM  
 VERTICAL NAVD 88  
 HORIZONTAL N/A

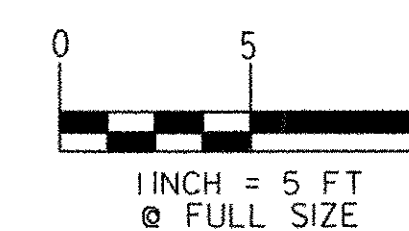

**CROSS SECTIONS  
 PASSUMPSIC  
 RIVER**

SURVEYED BY W. DEYETTE DATE 10/93  
 DRAWN BY C. KAHLBAUGH DATE 7/06  
 SQUAD LEADER J. P. HALSTEAD  
 DESIGN FILE NO. 3797SECT.DGN  
 IPARM FILE \_\_\_\_\_ DATE PLOTTED 12/20/2006  
 PROJ. NAME ST. JOHNSBURY, BRIDGE NO. 29  
 PROJ. NO. BRO 1447(19)  
 SHEET 70 OF 72 SHEETS